



JORDAN VALLEY WATER CONSERVANCY DISTRICT


JORDAN VALLEY WATER CONSERVANCY DISTRICT
WEST JORDAN, UTAH

JORDAN VALLEY WATER TREATMENT PLANT
FILTER AND CHEMICAL FEED UPGRADES

JVWCD PROJECT #4289

ADDENDUM NO. 1
TO THE
CONTRACT DOCUMENTS

APRIL 2025

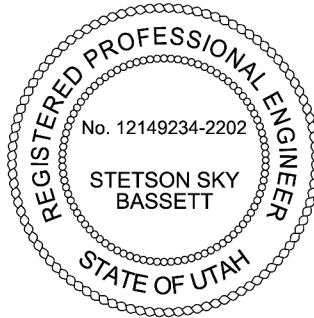

Bidders on the above-named project are hereby notified that the Bidding Documents are modified as indicated below. Bidders are required to acknowledge receipt of this Addendum in the space provided on the Document C-1 Bid Form.

This addendum consists of the following items:

ADDENDUM ITEM	NO. OF PAGES
This document (including cover page)	8
ATTACHMENTS:	
Division 0 – Page C-5 – BID ALTERNATE SCHEDULE	1
Specification 01230 – ALTERNATES	1
DRAWINGS	40
Responses to Contractor Questions	2
Excel Version of Conduit Schedules – FOR REFERENCE ONLY	10 files

This Addendum shall become part of the Contract and provisions of the Contract apply.

The bid date and time remains the same at 2:00 pm on May 15, 2025.

SPECIFICATIONS

The following sections are modified as indicated below.

1. DIVISION 0:
 - a. **ADD** the following paragraph AFTER the paragraph titled “AWARD OF CONTRACT”:

In evaluating Bids, the Owner will consider compliance with the prescribed requirements, including the alternates and other data as requested in the Bid Form. The evaluation of bids will be based on the total bid price, including any owner selected bid alternates.
 - b. On page C-3 **REPLACE** the word “electric” with “pneumatic” as shown in the following paragraph in the POWDER ACTIVATED CARBON DUST HAZARD MITIGATION ALLOWANCE SCHEDULE, row 5:

Knife Gate Controls: **Pneumatic** actuator on knife gate valve with a sensor to automatically close the knife gate when filled.
 - c. **ADD** the attached page C-5 after page C-4, providing a new BID ALTERNATE SCHEDULE, which shall be included in Bid.
2. SECTION 01230 – ALTERNATES:
 - a. **ADD** the attached section, in it’s entirety.
3. SECTION 01140 WORK RESTRICTIONS

- a. **ADD** the following paragraphs as sub-paragraphs to 1.04.A:
 - 1. Contractor access to the site is not permitted from the north (via 15000 S or 3200 W).
 - 2. See 01500 – Temporary Facilities and Controls for additional requirements on site access.
- 4. SECTION 01500 TEMPORARY FACILITIES AND CONTROLS
 - a. **ADD** the following paragraphs after 1.06.A:
 - B. Contractor shall provide a gate attendant to facilitate secure access to the site any time more than ten (10) entries through the plant gates per day anticipated within a rolling 8 hour period.
 - 1. Gate attendant shall be located outside the south entry gate, providing controlled access to the site from Mountain View Corridor. See 01140 – Work Restrictions, for additional plant access constraints.
 - 2. The Owner will provide the Gate attendant with a Contractor specific remote gate operator and/or keycard to allow entry of authorized construction personnel.
 - 3. Gate attendant shall log all project associated construction traffic through the gate, recording the name of entrant(s), entry time/date, reason for entry, and exit time.
- 5. SECTION 09960 – HIGH PERFORMANCE COATINGS:
 - a. **REPLACE** the following paragraph in Section 3.12.C:
 - C. Galvanized structural steel framing, non-exposed portions of galvanized roof decking, galvanized pipe supports.
 - b. Attachment A - Schedules of Surfaces to be Coated:
 - 1) ADD the following to the VE-C-1 row in the table in section A:
 - “All concrete surfaces inside the caustic chemical containment areas and tank offloading/fill sump, as shown on the structural drawings, including inside of containment wall surfaces (up to 3 ft above finished floor where indicated), top of containment wall surfaces, sump area, equipment pads, and tank pads.”
 - 2) ADD the following to the Notes, Item 1 in the table in section A:
 - “m. Exposed (underside) of galvanized roof decking.”
- 6. SECTION 13207 – STRAND WOUND CIRCULAR PRESTRESSED CONCRETE TANK:
 - a. **ADD** the following paragraphs to 2.01.I.7:
 - c. roof access hatches shall have the following features, per the requirements of Utah Administrative Code section R309-545-14:
 - 1) Framed a minimum of 4” above the roof surface
 - 2) A shoebox type lid with 2” overhang around frame, gasket
 - 3) No surface penetrations
 - 4) Designed with a lock
 - b. **AMMEND** paragraph 2.01.I.10.b.5 for the roof ventilator as follows:
 - 5) Insect screens with non-corrodible No.14 (or finer) mesh screen. Vents 6” or greater in diameter shall have an additional heavy gage screen to protect the fine mesh screen.

7. SECTION 13270 – PAC STORAGE AND HANDLING SYSTEM:

a. **REMOVE** “, and booster pump” from the following paragraph in section 2.05.K.2:

- 1) The eductor shall be equipped with a motive water line assembly complete with a manually operated isolation ball valve, a pressure reducing valve with integral strainer, a low-pressure switch, a pressure gauge, and booster pump.

b. **REMOVE** “booster pump” from the following paragraph in section 2.05.N:

- 1) The Contractor is responsible for the interconnected piping, wiring, and conduit to connect the booster pump, air compressor, and panels to the respective tie-in points within the silo system.

8. SECTION 15112 BUTTERFLY VALVES

a. **ADD** the following paragraphs after 2.03:

2.04 DOUBLE ECCENTRIC/OFFSET BUTTERFLY VALVES

A. Manufacturers: One of the following or equal:

1. VAG; EKN (Double Eccentric Rubber Seated).
2. AV-Tek; DEX Double Eccentric Butterfly Valve.

B. Butterfly Valve Water Works Service 3 Inches to 72 Inches:

1. Design and Operating Requirements:

- a. Valves shall be rated to 250 psi, with ANSI B16.5 and B16.47, Class 150 Series A raised face flanges. Each valve shall be drip tight in both directions.

2. Elastomeric Seal:

- a. Valve seats shall be EPDM mounted on the valve disc with Type 316 stainless steel fasteners. It shall be one continuous 360-degree elastomeric ring. It shall not be penetrated by fasteners. The seat shall be field replaceable and adjustable in line. It shall not require special tools or skill sets to replace the seat. Seat removal, replacement and readiness for service must be able to be accomplished in a maximum of 8 hours. Seat methods which do not comply or which use hardened epoxy or grout in a dovetailed groove are not acceptable.

3. Body:

- a. Valve bodies shall be ductile iron ductile iron, ASTM A536 65-45-12 or ASTM A536 60-40-18. Shear stress vulnerable cast iron is not allowed. Valve body shall include a stainless steel stamped or engraved tag indicating manufacturer and reference build data. Valve build data shall be made available upon request by the Owner and shall be retained by the manufacturer for no less than 2 times the expected valve life.

4. Disc:

- a. For valves sizes 3 inches to 20 inches disc shall be ductile iron. For valve sizes 24 inches and larger, disc shall be ductile iron, ASTM A536 65-45-12 or ASTM A536 60-40-18. Disc elastomeric seal retainer shall be Type 316 stainless steel. Disc shall be mechanically fastened to valve shaft using Type 316 (or higher quality alloy) stainless steel tangential shaft pins. Where disc pins extend completely through valve, disc pins shall be mechanically retained or fastened.

5. Shaft:
 - a. Shafts shall be stainless steel ASTM A276 Type 316. Valve shaft material shall be suitable for the application, pressure and velocity.
6. Metallic Seat:
 - a. The metallic valve seat shall be located in the valve body. It shall be stainless steel alloy. There shall be no gap between the valve body and metallic body seat and consequently no potential for corrosion or lifting of seat. The seat shall be applied through a high alloy weld overlay process.
7. Shaft Seals:
 - a. Shaft seals shall not need periodic manual adjustment. They shall be multi-O-ring seals protecting both the outside and inside diameter of the shaft bearings. They shall prevent pressurized system water from entering the uncoated valve disc hub and valve body shaft bore. The valve shaft shall remain nonwetted and unpressurized. The nonwetted shaft shall allow the actuator to be removed without dewatering the pipeline. It shall prevent debris and system pressurized water from entering into the uncoated valve body shaft bore. It shall prevent waters or contaminated media, external to the valve, from entering through the valve shaft under vacuum/negative pressure conditions in the pipeline such as at line break. It shall additionally prevent an ingress breach where external hydrostatic forces exceed pipeline pressures such as in dewatered pipelines. Neither manual pulldown packing glands nor braided packing are allowed. Outer shaft seals shall be replaceable cartridge type, bolted to the valve body and shall not be held in place with an adapter plate or by the valve actuator.
8. Shaft Bearings:
 - a. Valve shaft bearings shall be corrosion resistant, self-lubricating sleeve type made of bronze, stainless steel or stainless steel backed PTFE. Bearing choice and consequent bearing friction shall be correctly added to valve input torque requirements.
9. Strength:
 - a. The proportion and dimensions of all parts of the valve and actuator shall be designed to withstand, without failure, the stresses occurring under the testing and operating conditions. The maximum allowable stress in any material shall not exceed 1/5 of the ultimate tensile strength or 1/3 of the minimum yield strength.
10. Hardware:
 - a. All fasteners and hardware shall be Type 316 stainless steel.
11. Paint and Coatings:
 - a. Fusion bond line and coat valves 24 inches and smaller. If coatings are damaged in shipping or installation valve shall be totally recoated in the field.
 - b. Line and coat valves larger than 24 Inches with 10 mils of NSF 61 approved 2-part liquid epoxy. All sharp edges to be coated shall be beveled/radiused to assure consistent coating thickness. Include in coating inspection report at least six locations where edges are most sharp for the complete circumference of sharp edge to assure proper coating and compliance. Compliance of proper beveling of all sharp edges with proper coating of carbon steel valves will be strictly enforced as a condition of providing a proper continuous water service valve.

9. SECTION 15936 – INSTRUMENTATION AND CONTROL DEVICES FOR HVAC:

- a. **REPLACE** “the unit will send a “smoke” alarm to the SCADA system. Upon smoke detection SCADA will shut down the HVAC units within the space.” with **“it will shut down the unit and send a “smoke” alarm to the PLC.”** in each place it appears in paragraph 2.08 for HVAC Control Descriptions:
- b. **REPLACE** “be interlocked” with **“operate”** in paragraphs 2.08.B.5.a.5, B.5.b, B.5.c, B.5.e.1 for Chlorine Storage and Chlorinator Room Control Sequences.
- c. **REPLACE** “be interlocked” with **“operate”** in paragraphs 2.08.C.2.b.4, C.2.c, C.2.e, for Caustic Storage Control Strategies.
- d. **ADD “hardwired”** in front of “duct mounted smoke detector” in each place it appears in paragraph 2.08 for HVAC Control Descriptions.

10. SECTION 16235 – SINGLE SPARK-IGNITED GENERATOR SET:

- a. **DELETE** paragraph 2.02.E.3 and 2.02.E.3.a.

11. SECTION 16990A – CONDUIT SCHEDULE – AREA 01:

- a. **REPLACE** conduits L-01-061, L-01-062, L-01-063, L-01-064, N-01-502, N-01-503, N-01-504, N-01-521, and N-01-931 with the following:

L-01-061	01E02	2"	2	#8	XHHW-2	1	#8	XHHW-2	FR: PNL-CELL TO: PB-18 2 #8 >> PNL-CELL POWER	L-01-062
L-01-062	02E03	2"	2	#8	XHHW-2	1	#8	XHHW-2	FR: PB-18 TO: PB-15 2 #8 >> PNL-CELL POWER	L-01-063 L-01-061
L-01-063	02E01	2"	2	#8	XHHW-2	1	#8	XHHW-2	FR: PB-15 TO: PB-14 2 #8 >> PNL-CELL POWER	L-01-064 L-01-062
L-01-064	02E01	2"	2	#8	XHHW-2	1	#8	XHHW-2	FR: PB-14 TO: RTU-CS 2 #8 >> PNL-CELL POWER	L-01-063
N-01-502	01E02	2"	4 1	2/C-#14 3/CS-#16		1	#14	XHHW-2	FR: CALLBOX TO: WEST GATE OPERATOR 2 2/C-#14 >> CALLBOX NETWORK (TEMP) 2 2/C-#14 >> CALLBOX NETWORK (PERMANENT) 1 3/CS-#16 >> GATE CARD READER NETWORK	N-01-503
N-01-503	02E03	2.5"	4 1 1 1	2/C-#14 CAT6 12/FO 3/CS-#16		1	#14	XHHW-2	FR: WEST GATE OPERATOR TO: PB-15 1 CAT6 >> S SECURITY GATE CAMERA NETWORK 2 2/C-#14 >> CALLBOX NETWORK (TEMP) 2 2/C-#14 >> CALLBOX NETWORK (PERMANENT) 1 3/CS-#16 >> GATE CARD READER NETWORK 1 12/FO >> S SECURITY GATE NETWORK	N-01-504 N-01-501 N-01-502 N-01-502
N-01-504	02E03	2"	2 1 1 1	2/C-#14 CAT6 12/FO 3/CS-#16		1	#14	XHHW-2	FR: PB-15 TO: PB-18 1 CAT6 >> S SECURITY GATE CAMERA NETWORK 2 2/C-#14 >> CALLBOX NETWORK (TEMP) 1 3/CS-#16 >> GATE CARD READER NETWORK 1 12/FO >> S SECURITY GATE NETWORK	N-01-521 N-01-503 N-01-503 N-01-503 N-01-503
N-01-521	01E02	2.5"	2 1 2 1	2/C-#14 CAT6 12/FO 3/CS-#16		1	#14	XHHW-2	FR: PB-18 (INTERCEPTED FIBER OPTIC TO CULINARY RESERVOIR) TO: ELECTRONICS ENCLOSURE 1 CAT6 >> S SECURITY GATE CAMERA NETWORK 2 2/C-#14 >> CALLBOX NETWORK (TEMP) 1 12/FO >> S SECURITY GATE NETWORK 1 3/CS-#16 >> GATE CARD READER NETWORK 1 12/FO >> CULINARY RESERVOIR NETWORK	N-01-504 N-01-504 N-01-504 N-01-504
N-01-931	30E19 69E01	1.5"	1	PULL ROPE					FR: EXISTING PULLBOX TO: MCC-B1 ROOM CABLE TRAY 1 PULL >> SPARE	

- b. **DELETE** conduits N-01-511, N-01-932.

12. SECTION 16990B – CONDUIT SCHEDULE – AREA 30:

- a. **REPLACE** conduits N-30-010, N-30-695 with the following:

N-30-010	30E03	0.75"	1		CAT5E	1	#14	XHHW-2	FR:	MCC-BL	
									TO:	RTU-BL	
									1	CAT5E	>> MCC-BL POWER MONITOR NETWORK
N-30-695	30E19	1"	1		CAT6	1	#14	XHHW-2	FR:	LOI-FB	
									TO:	LEVEL 2 NETWORK ROOM PATCH PANEL	
									1	CAT6	>> LOI-FB NETWORK

13. SECTION 16990D – CONDUIT SCHEDULE – AREA 55:

- a. **REPLACE** conduits P-55-101 and P-55-102 with the following:

P-55-101	02E02	4"	1	500	XHHW-2	1	#1	XHHW-2	FR:	GEN-5501	
									TO:	SWBD-CPS	
									1	500	>> GEN-5501 POWER
P-55-102	02E02	4"	1	PULL	ROPE		#1		FR:	GEN-5501	
									TO:	SWBD-CPS	
									1	PULL	>> SPARE

14. SECTION 17050:

- a. **ADD** the following to paragraph 2.02 K:

The owner will design the back panel of the control panels and provide the sizes required to the contractor for purchase.

15. SECTION 17720 – PROGRAMMABLE LOGIC CONTROLLERS:

- a. **REPLACE** the words in paragraph 1.10.A.3 "for every power supply" with "for each type of power supply".

DRAWINGS

Note to Bidders on addenda drawings: The addenda drawings make use of color coding to show revisions made by addendum. The following color codes are used, for clarity:

- Red is used to highlight additions, corrections, or changes that are incorporated into the drawing.
- Green is used to indicate items that shall be removed or deleted from the drawing.
- Blue is used for comments, notes, clarifications, or instructions that may not be physically added to the drawing itself.

The following drawings are modified as indicated below.

1. REPLACE the following drawings in their entirety with the drawings attached:

- | | |
|-----------|------------|
| a. 00G11 | u. 03E22 |
| b. 00G12 | v. 30E03 |
| c. 00G14 | w. 30E19 |
| d. 01DE01 | x. 63E04 |
| e. 55DE01 | y. 63E14 |
| f. 30D07 | z. 65E04 |
| g. 01C01 | aa. 69E01 |
| h. 00GA01 | bb. 71E02 |
| i. 63A01 | cc. 00GN07 |
| j. 63A06 | dd. 03N03 |
| k. 30S01 | ee. 03N04 |
| l. 65S02 | ff. 03N05 |
| m. 41M02 | gg. 03N06 |
| n. 63M04 | hh. 05N02 |
| o. 01E02 | ii. 05N03 |
| p. 01E03 | jj. 06N14 |
| q. 01E04 | kk. 06N16 |
| r. 03E02 | ll. 62N02 |
| s. 03E03 | mm. 65N01 |
| t. 03E20 | nn. 71N01 |

BID

BID ALTERNATE SCHEDULE

Alternate	Description	Price (\$)
A	High Performance Butterfly Valves	\$
B	NOT USED	\$
C	NOT USED	\$
D	NOT USED	\$
E	NOT USED	\$

NOTES:

- (1) See specification section 01230 - Alternates for a description of bid alternates.
-

SECTION 01230

ALTERNATES

PART 1 GENERAL

1.01 SUMMARY

- A. Section includes: Identification and description of Alternates.

1.02 PROCEDURES

- A. Alternates will be exercised at Owner's option.
- B. Coordinate related work and modify surrounding work as required to complete the Work, including changes under Alternates accepted by Owner in Notice of Award.

1.03 ALTERNATES

- A. Alternate A – Butterfly Valves:
 - 1. Base Bid: Provide butterfly valves in accordance with specification 15122 paragraph 2.02. All butterfly valves shall be general purpose AWWA butterfly valves (BFFV00) unless specifically indicated otherwise.
 - 2. Alternate: Provide butterfly valves in accordance with specification 15122 paragraph 2.04. All butterfly valves shall be high performance butterfly valves unless specifically indicated otherwise.

PART 2 PRODUCTS (NOT USED)

PART 3 EXECUTION (NOT USED)

END OF SECTION

Plot Date: 10-FEB-2025 8:39:48 AM User: svcPW Model: Layout1 ColorTable: gshade.ctb DesignScript: Carollo_Std_Pen_v0905.pen PlotScale: 1:1 LAST SAVED BY: RBhatia

1				2				3				4				5				6				7				8				9				10				11				12				13			
ABBREVIATIONS																				PIPE SCHEDULE																															
A	ABBREVIATIONS TO DESIGNATE TEST PRESSURE/METHOD PER SPECIFICATION SECTION 15956:																																																		
	AM		AIR METHOD																																																
	GR		GRAVITY METHOD																																																
	HH		HIGH HEAD METHOD																																																
	LH		LOW HEAD METHOD																																																
	SC		SPECIAL CASE																																																
	ABBREVIATIONS TO DESIGNATE PIPE MATERIAL:																																																		
	BSP		BLACK STEEL PIPE																																																
	CI		CAST IRON																																																
	CISP		CAST IRON SOIL PIPE																																																
B	CPVC		CHLORINATED POLYVINYL CHLORIDE																																																
	DIP		DUCTILE IRON PIPING																																																
	FRP		FIBERGLASS REINFORCED PIPE																																																
	GSP		GALVANIZED STEEL PIPE																																																
	HDPE		HIGH DENSITY POLYETHYLENE																																																
	PVC		POLYVINYL CHLORIDE																																																
	RGRCP		RUBBER GASKETED REINFORCED CONCRETE PIPE																																																
	SST		STAINLESS STEEL																																																
	VCP		VITRIFIED CLAY PIPING																																																
	ABBREVIATIONS TO DESIGNATE CLASS, SCHEDULE, OR THICKNESS:																																																		
C	CL		CLASS, FOLLOWED BY THE DESIGNATION																																																
	GA		GAUGE, PRECEDED BY THE DESIGNATION																																																
	SCH		SCHEDULE, FOLLOWED BY THE DESIGNATION																																																
	SDR		STANDARD DIMENSION RATIO																																																
	ABBREVIATIONS TO DESIGNATE PIPING JOINTS/FITTINGS:																																																		
	B&SP		BELL & SPIGOT																																																
	BFW		BUTT FUSION WELD																																																
	BW		BUTT-WRAPPED																																																
	BZD		BRAZED																																																
	CF		COMPRESSION FITTING																																																
D	FL		FLANGED																																																
	FLR		FLARED																																																
	GE		GROOVED END JOINT																																																
	MJ		MECHANICAL JOINT																																																
	NH		NO HUB																																																
	PO		PUSH ON																																																
	PRF		PRESS FIT																																																
	RMJ		RESTRAINED MECHANICAL JOINT																																																
	RPO		RESTRAINED PUSH ON																																																
	SCRD		SCREWED																																																
E	SFW		SOCKET FUSION WELD																																																
	SLD		SOLDERED																																																
	SW		SOLVENT WELD																																																
	WLD		WELDED																																																
	ABBREVIATIONS TO DESIGNATE LINING AND COATINGS:																																																		
	CEP		CERAMIC EPOXY																																																
	CTP		COAL TAR PITCH																																																
	CM		CEMENT MORTAR																																																
	EPU		EPOXY AND POLYURETHANE COATING SYSTEM PER SECTION 09960																																																
	FBE		FUSION BONDED EPOXY																																																
F	GL		GLASS LINING																																																
	PCP		PLURAL COMPONENT POLYURETHANE																																																
	PEN		POLYETHYLENE ENCASED																																																
	PTW		POLYETHYLENE TAPE WRAP																																																
	WAE		WATERBORNE ACRYLIC EMULSION																																																
	NOTE: BOND ALL JOINTS ON BURIED AND ENCASED DIP AND STEEL PIPING AS DIRECTED ON CATHODIC PROTECTION DRAWINGS.																																																		

PROJECT NO. 202001-100000 FILE NAME: 20200100G12.dgn

Plot Date: 4/11/2024 3:35:40 PM

A

B

C

D

E

F

G

A

B

C

D

E

F

G

VALVE AND ACTUATOR SCHEDULE CONTINUED													
VALVE TAG	VALVE TYPE	DESCRIPTION	SIZE, INCHES	OPERATOR	VALVE ENDS	VALVE SPEC	ACTUATOR TAG	OPERATOR TYPE	VOLTAGE	PHASE	HP	OPERATING TIME	ACTUATOR SPEC
VAL-3157	VALVE - BUTTERFLY	FILTER 15 WASTE WASHWATER VALVE	42	MOTOR	FLANGED; CLASS 150B	15112	FV-3157	OPEN/CLOSE	480	3	1/2	2 TO 3 MINUTES	13447
VAL-3161	VALVE - BUTTERFLY	FILTER 16 INLET VALVE	36	MOTOR	FLANGED; CLASS 150B	15112	FV-3161	POSITION	480	3	1/2	2 TO 3 MINUTES	13447
VAL-3162	VALVE - BUTTERFLY	FILTER 16 EFFLUENT VALVE	30	MOTOR	FLANGED; CLASS 150B	15112	FV-3162	POSITION	480	3	1/2	1 TO 2 MINUTES	13447
VAL-3163	VALVE - BUTTERFLY	FILTER 16 FILTER TO WASTE VALVE	24	MOTOR	FLANGED; CLASS 150B	15112	FV-3163	POSITION	480	3	1/2	1 TO 2 MINUTES	13447
VAL-3164	VALVE - BUTTERFLY	FILTER 16 BACKWASH VALVE	36	MOTOR	FLANGED; CLASS 150B	15112	FV-3164	OPEN/CLOSE	480	3	1/2	2 TO 3 MINUTES	13447
VAL-3166 ⁽¹⁾	VALVE - BUTTERFLY	FILTER 16 VENT VALVE	6	MOTOR	FLANGED; CLASS 150B	15112	FV-3166	OPEN/CLOSE	480	3	1/2	30 SECONDS	13447
VAL-3167	VALVE - BUTTERFLY	FILTER 16 WASTE WASHWATER VALVE	42	MOTOR	FLANGED; CLASS 150B	15112	FV-3167	OPEN/CLOSE	480	3	1/2	2 TO 3 MINUTES	13447
VAL-4041 ⁽²⁾	VALVE - BUTTERFLY	MASTER BWS VALVE	30	MOTOR	FLANGED; CLASS 150B	15112	FV-4041	POSITION	480	3	1/2	1 TO 2 MINUTES	13447
VAL-4051 ⁽²⁾	VALVE - BUTTERFLY	BWS NORTH (ODD) CONTROL VALVE	36	MOTOR	FLANGED; CLASS 150B	15112	FV-4051	POSITION	480	3	1/2	1 TO 2 MINUTES	13447
VAL-4061 ⁽²⁾	VALVE - BUTTERFLY	BWS SOUTH (EVE) CONTROL VALVE	36	MOTOR	FLANGED; CLASS 150B	15112	FV-4061	POSITION	480	3	1/2	1 TO 2 MINUTES	13447
VAL-4112	VALVE - BUTTERFLY	BW TANK 1 EFFLUENT VALVE	36	MOTOR	FLANGED; CLASS 150B	15112	FV-4112	OPEN/CLOSE	480	3	1/2	1 TO 2 MINUTES	13447
VAL-4122	VALVE - BUTTERFLY	BW TANK 2 EFFLUENT VALVE	36	MOTOR	FLANGED; CLASS 150B	15112	FV-4122	OPEN/CLOSE	480	3	1/2	1 TO 2 MINUTES	13447
VAL-4131	VALVE - BUTTERFLY	BW STORAGE ISOLATION VALVE	36	MOTOR	FLANGED; CLASS 150B	15112	FV-4131	OPEN/CLOSE	480	3	1/2	1 TO 2 MINUTES	13447
VAL-4411	VALVE - BUTTERFLY	MASTER FILTER TO WASTE VALVE	24	MOTOR	FLANGED; CLASS 150B	15112	FV-4411	OPEN/CLOSE	480	3	1/2	1 MINUTE	13447

NOTES:
(1) EXISTING VALVE, ACTUATOR REPLACEMENT ONLY.
(2) MODBUS TCP COMMUNICATIONS

GENERAL NOTES:

- NOT ALL VALVES ARE SHOWN IN THE SCHEDULE. VALVES SMALLER THAN 6-INCH SIZE ARE NOT SHOWN. MANUAL VALVES ARE NOT SHOWN. CONTRACTOR SHALL REFER TO MECHANICAL DRAWINGS AND P&ID'S FOR ADDITIONAL VALVE REQUIREMENTS.
- NEMA RATING OF 4X FOR ALL ACTUATORS.
- MODULATING ACTUATORS WILL HAVE ~1200 STARTS/HR. OPEN/CLOSE ACTUATORS WILL BE IN THE RANGE OF 0-60 STARTS/HR.

EQUIPMENT TAG	TANK SCHEDULE							
	P&ID DWG.	DESCRIPTION	TYPE	CAPACITY (GAL)	DIAMETER (FT)	HEIGHT (FT)	SPECIFICATION	COMMENTS
TNK-4121	30N20	BACKWASH TANK NO. 2	PRESTRESSED CONCRETE	1,000,000	72	36	13207	
TNK-6211	62N02	PC DAY TANK	POLYETHYLENE	900	5.5	7	13208	
TNK-6501	65N01	CAUSTIC SODA TANK 1	FRP	18,000	12	22	13206A	
TNK-6502	65N01	CAUSTIC SODA TANK 2	FRP	18,000	12	22	13206A	
TNK-6503	65N01	CAUSTIC SODA TANK 3	FRP	18,000	12	22	13206A	
TNK-6531	65N02	CS DAY TANK	FRP	1,500	6	7	13206A	
TNK-6901	69N01	PEA AGING TANK 1	FRP	2,000	8	6	11256	PROVIDED BY VENDOR
TNK-6911	69N02	PEA AGING TANK 2	FRP	2,000	8	6	11256	PROVIDED BY VENDOR
TNK-7101	71N01	PEC TANK 1	POLYETHYLENE	4,600	10	10	13208	
TNK-7102	71N01	PEC TANK 2	POLYETHYLENE	4,600	10	10	13208	
TNK-7105	71N02	PEC DAY TANK	POLYETHYLENE	550	4	7	13208	

CHEMICAL FEEDER SCHEDULE								
EQUIPMENT TAG	DESCRIPTION	SERVICE	TYPE	VOLTAGE	LOAD	LOAD UNITS	CAPACITY (GPH)	SPECIFICATION
PMP-6211	PRIMARY COAGULANT FEED PUMP 3	PC	DIAPHRAGM	120	1/4	KVA	52	11242
PMP-6221	PRIMARY COAGULANT FEED PUMP 4	PC	DIAPHRAGM	120	1/4	KVA	52	11242
PMP-6541	CAUSTIC SODA SMALL FEED PUMP 1	CS	DIAPHRAGM	120	1/4	KVA	52	11242
PMP-6562	CAUSTIC SODA SMALL FEED PUMP 2	CS	DIAPHRAGM	120	1/4	KVA	52	11242
PMP-6572	CAUSTIC SODA LARGE FEED PUMP 1	CS	HOSE	480	2	HP	720	11244
PMP-6582	CAUSTIC SODA LARGE FEED PUMP 2	CS	HOSE	480	2	HP	720	11244
PMP-6911	PEA FILTER AID SMALL FEED PUMP 1	PEA	DIAPHRAGM	120	1/4	KVA	52	11245
PMP-6916	PEA FILTER AID SMALL FEED PUMP 2	PEA	DIAPHRAGM	120	1/4	KVA	52	11245
PMP-6921	PEA FILTER AID LARGE FEED PUMP 1	PEA	HOSE	480	2	HP	720	11244
PMP-6926	PEA FILTER AID LARGE FEED PUMP 2	PEA	HOSE	480	2	HP	720	11244
PMP-6931	PEA FLOC AID FEED PUMP 1	PEA	HOSE	480	2	HP	720	11244
PMP-6936	PEA FLOC AID FEED PUMP 2	PEA	HOSE	480	2	HP	720	11244
PMP-6941	PEA FLOC AID FEED PUMP 3	PEA	HOSE	480	2	HP	720	11244
PMP-6946	PEA FLOC AID FEED PUMP 4	PEA	HOSE	480	2	HP	720	11244
PMP-6951	PEA STANDBY FEED PUMP	PEA	HOSE	480	2	HP	720	11244
PMP-6956	PEA FILTER AID DOSING PUMP	PEA	DIAPHRAGM	120	1/4	KVA	52	11245


PUMP SCHEDULE										LOAD	LOAD TYPE	SPECIFICATION	FLOW (GPM)	TDH
EQUIPMENT TAG	DESCRIPTION	VOLTAGE	LOAD	UNITS	LOAD TYPE	SPECIFICATION	FLOW (GPM)	TDH						
PMP-3911	FILTER DRAIN PUMP 1	480	5	HP	CONSTANT SPEED	11312K	600	16.5						
PMP-3921	FILTER DRAIN PUMP 2	480	5	HP	CONSTANT SPEED	11312K	600	16.5						
PMP-3931	FILTER DRAIN PUMP 1	120	1/2	HP	CONSTANT SPEED	11312J	60	10						
PMP-3941	FILTER DRAIN PUMP 2	120	1/2	HP	CONSTANT SPEED	11312J	60	10						
PMP-4125	VALVE VAULT SUMP PUMP	120	1/2	HP	CONSTANT SPEED	11312S	25	18						
PMP-6201	PRIMARY COAGULANT TRANSFER PUMP 1	480	3/4	HP	CONSTANT SPEED	11312S	44	43						
PMP-6202	PRIMARY COAGULANT TRANSFER PUMP 2	480	3/4	HP	CONSTANT SPEED	11312S	44	43						
PMP-6211	PRIMARY COAGULANT FEED PUMP 3	120	1/4	KVA	VARIABLE SPEED	11242	23	139						
PMP-6221	PRIMARY COAGULANT FEED PUMP 4	120	1/4	KVA	VARIABLE SPEED	11242	23	139						
PMP-6319	CHLORINE BUILDING SUMP PUMP	120	1/2	HP	CONSTANT SPEED	11312V	25	5						
PMP-6511	CAUSTIC SODA TRANSFER PUMP 1	480	3/4	HP	CONSTANT SPEED	11312S	43	44						
PMP-6521	CAUSTIC SODA TRANSFER PUMP 2	480	3/4	HP	CONSTANT SPEED	11312S	43	44						
PMP-6541	CAUSTIC SODA SMALL FEED PUMP 1	120	1/4	KVA	VARIABLE SPEED	11242	30	139						
PMP-6562	CAUSTIC SODA SMALL FEED PUMP 2	120	1/4	KVA	VARIABLE SPEED	11242	30	139						
PMP-6572	CAUSTIC SODA LARGE FEED PUMP 1	480	2	HP	VARIABLE SPEED	11244	1.0	139						
PMP-6582	CAUSTIC SODA LARGE FEED PUMP 2	480	2	HP	VARIABLE SPEED	11244	1.0	139						
PMP-6852	PAC SUMP PUMP	120	1/2	HP	CONSTANT SPEED	11312J	60	10						
PMP-6911	PEA FILTER AID SMALL FEED PUMP 1	120	1/4	KVA	VARIABLE SPEED	11245	24	139						
PMP-6916	PEA FILTER AID SMALL FEED PUMP 2	120	1/4	KVA	VARIABLE SPEED	11245	24	139						
PMP-6921	PEA FILTER AID LARGE FEED PUMP 1	480	2	HP	VARIABLE SPEED	11244	0.8	139						
PMP-6926	PEA FILTER AID LARGE FEED PUMP 2	480	2	HP	VARIABLE SPEED	11244	0.8	139						
PMP-6931	PEA FLOC AID FEED PUMP 1	480	2	HP	VARIABLE SPEED	11244	3.0	139						
PMP-6936	PEA FLOC AID FEED PUMP 2	480	2	HP	VARIABLE SPEED	11244	3.0	139						
PMP-6941	PEA FLOC AID FEED PUMP 3	480	2	HP	VARIABLE SPEED	11244	3.0	139						
PMP-6946	PEA FLOC AID FEED PUMP 4	480	2	HP	VARIABLE SPEED	11244	3.0	139						
PMP-6951	PEA STANDBY FEED PUMP	480	2	HP	VARIABLE SPEED	11244	3.0	139						
PMP-6956	PEA FILTER AID DOSING PUMP	120	1/4	KVA	VARIABLE SPEED	11245	16	139						
PMP-7103	PEC TRANSFER PUMP 1	480	3/4	HP	CONSTANT SPEED	11312S	28	56						
PMP-7104	PEC TRANSFER PUMP 2	480	3/4	HP	CONSTANT SPEED	11312S	28	56						

MISC. EQUIPMENT SCHEDULE				
EQUIPMENT TAG	P&ID DWG.	DESCRIPTION	SPECIFICATION	COMMENTS
CHL-6331	63N07	FINISHED WATER CHLORINATOR 1	11260	
CHL-6332	63N07	FINISHED WATER CHLORINATOR 2	11260	
CHL-6333	63N07	FINISHED WATER CHLORINATOR 3	11260	
CHL-6334	63N08	RAW WATER CHLORINATOR 1	11260	
CHL-6335	63N08	RAW WATER CHLORINATOR 2	11260	
CHL-6336	63N08	RAW WATER CHLORINATOR 3	11260	
EDU-6341	63N09	FINISHED WATER EDUCTOR 1	11260	
EDU-6342	63N09	FINISHED WATER EDUCTOR 2	11260	
EDU-6346	63N09	FINISHED WATER EDUCTOR 3	11260	
EDU-6343	63N10	RAW WATER EDUCTOR 1	11260	
EDU-6344	63N10	RAW WATER EDUCTOR 2	11260	
EDU-6345	63N10	RAW WATER EDUCTOR 2	11260	
TNK-6391	63N14	CHLORINE SCRUBBER	11265	
-	65N03	DUAL TANK WATER SOFTENER	15400	
-	68N01	PAC FEED SYSTEM 1	13270	
-	68N04	PAC FEED SYSTEM 2	13270	
-	69N01	PEA FEED SYSTEM 1	11256	
-	69N02	PEA FEED SYSTEM 2	11256	

△	04/15/2025	MLL	ADDENDUM NO. 1
REV	DATE	BY	DESCRIPTION

BID SET

DESIGNED
SB
DRAWN
RB
CHECKED
RB
DATE
FEBRUARY 2025

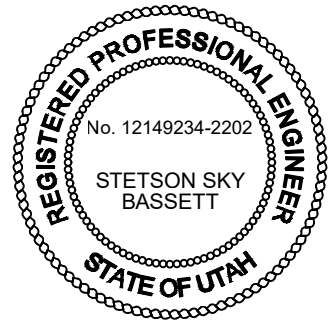

JORDAN VALLEY WATER TREATMENT PLANT

FILTER AND CHEMICAL FEED UPGRADES

GENERAL

EQUIPMENT SCHEDULE 2

VERIFY SCALES

BAR IS ONE INCH ON ORIGINAL DRAWING

0 1"

IF NOT ONE INCH ON THIS SHEET, ADJUST SCALES ACCORDINGLY

JOB NO.

202001.10

DRAWING NO.


00G14

SHEET NO.

OF

Plot Date: 4/15/2024 10:03:49 AM

LAST SAVED BY: MHOOD

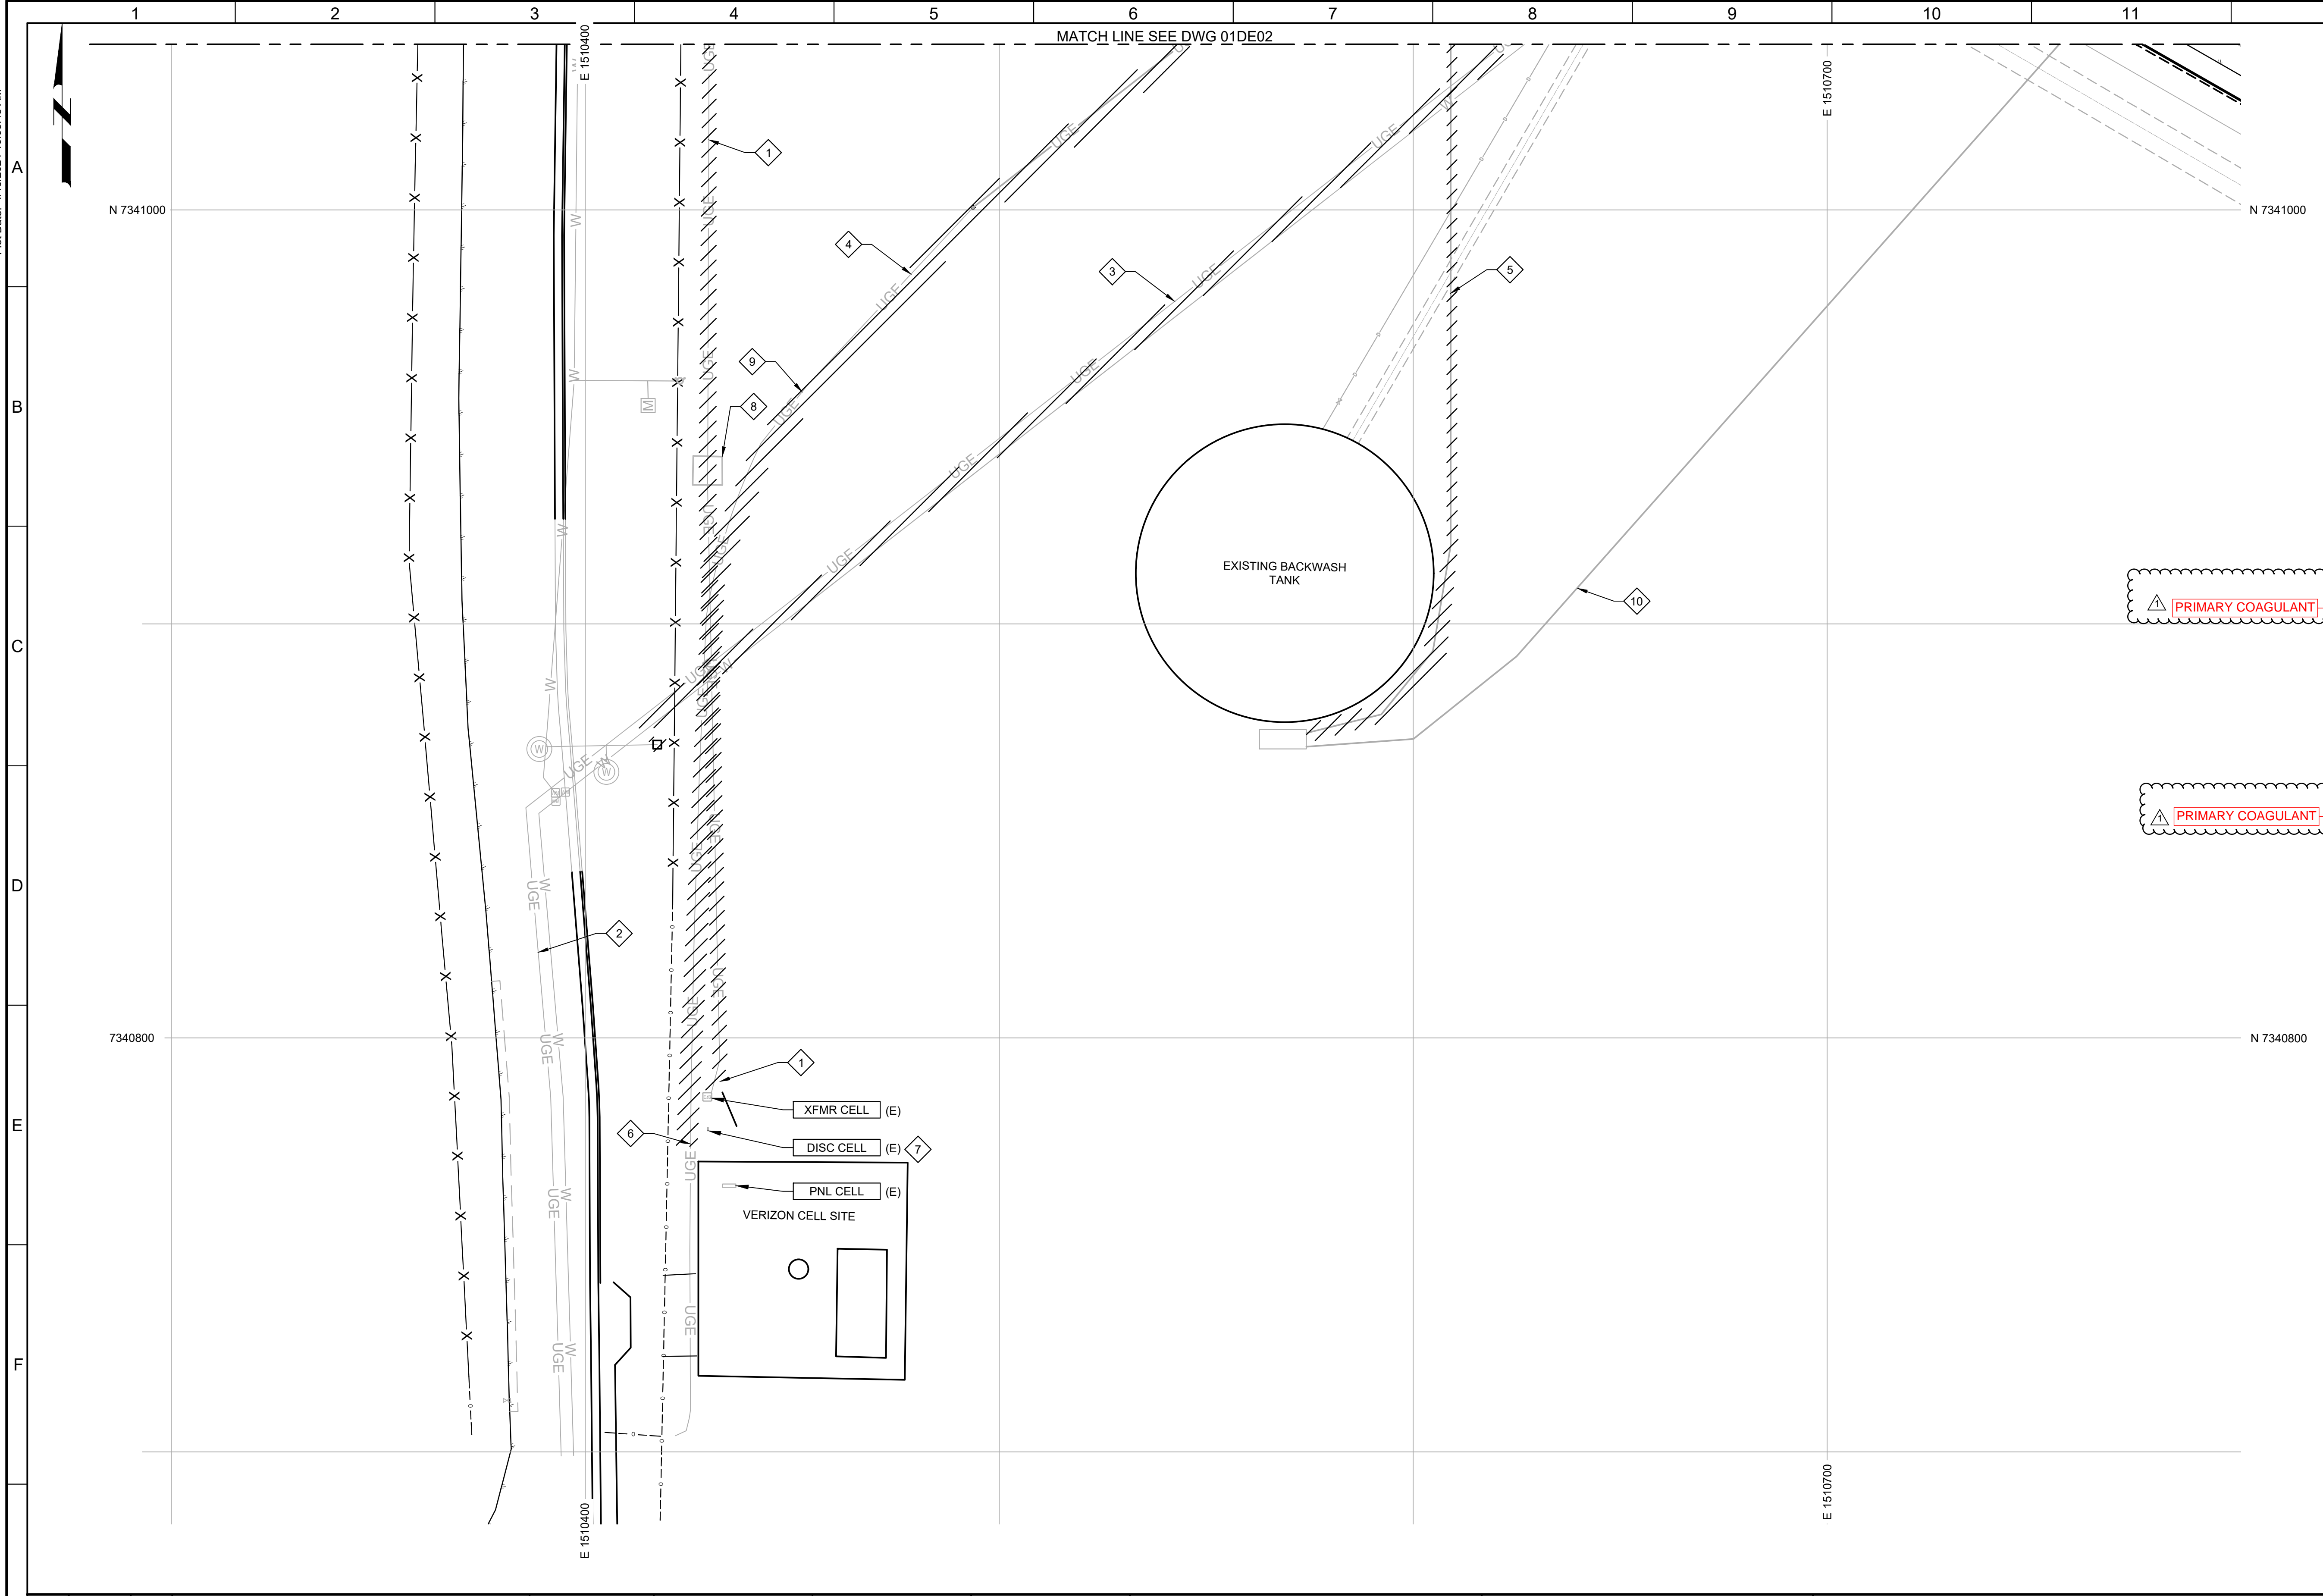


GENERAL NOTES:

1. FIELD VERIFY DETAILS AND QUANTITIES OF ALL ITEMS TO BE DEMOLISHED AND REMOVED.
2. DEMOLISHED ITEMS SPECIFICALLY NOT IDENTIFIED TO BE RELOCATED, SALVAGED, OR STOCKPILED SHALL BE REMOVED AND DISPOSED OFFSITE.
3. ON COMPLETION OF ALL ITEMS TO BE DEMOLISHED, RE-GRADE THE DISTURBED AREAS WITH A UNIFORM SLOPE TO DRAIN AWAY FROM ADJACENT STRUCTURES.
4. REPLACE IN KIND ALL ITEMS DISTURBED BY CONSTRUCTION AND DEMOLITION ACTIVITIES THAT ARE NOT SPECIFICALLY IDENTIFIED FOR DEMOLITION.
5. REFER TO INSTALLATION PLANS FOR NEW WORK. DEMOLISH AS REQUIRED FOR INSTALLATION OF PROPOSED IMPROVEMENTS.
6. COORDINATE ALL ELECTRICAL DISCONNECTION AND SHUTDOWNS WITH OWNER.

KEY NOTES:

1. DEMOLISH 12.47 KV CONDUITS AND CONDUCTORS BETWEEN SECTIONALIZER 4 AND XFMR CELL. DUCT BANK (NOT CONCRETE ENCASED) CONTAINS TWO 4-INCH CONDUITS AND ONE 2-INCH CONDUIT.
2. ABANDONED CONDUITS. LEAVE IN PLACE TO THE POINT WHERE DEMOLITION IS SHOWN.
3. DEMOLISH ABANDONED CONDUITS.
4. REMOVE POLE MOUNTED SECURITY CAMERA AND OTHER EQUIPMENT. RETURN ALL EQUIPMENT FROM POLE TO OWNER. DEMOLISH POLE.
5. DEMOLISH CONDUITS AND WIRE BETWEEN BACKWASH TANK AND FLUORIDE BUILDING.
6. INTERCEPT TWO EXISTING CONDUITS CONTAINING 480V POWER AND FIBER OPTIC FOR THE CULINARY RESERVOIR. REFER TO DRAWING 01E02 FOR NEW PULLBOX AT THIS INTERCEPTION POINT AND NEW TERMINATIONS FOR 480V POWER WIRING AND FIBER OPTIC TO CULINARY RESERVOIR.
7. FUSED DISCONNECT.
8. SALVAGE POWER PULLBOX AND RELOCATE AS SHOWN ON DRAWING 01E02.
9. DEMOLISH CONDUITS AND WIRE FROM POINT OF INTERCEPTION TO THE FLUORIDE BUILDING.
10. PROTECT EXISTING CONDUIT AND WIRE IN PLACE.

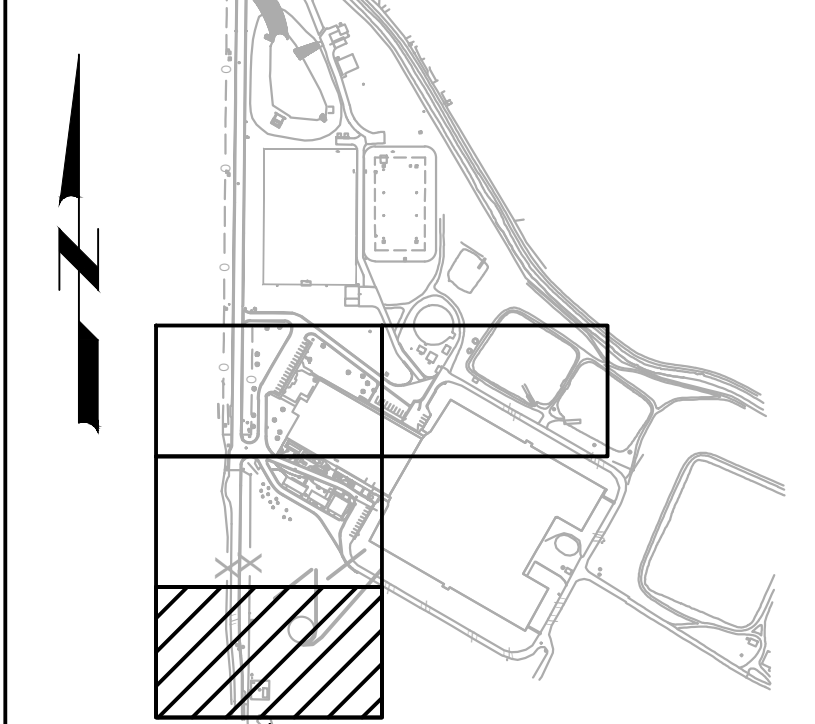


KEY PLAN

Know what's below.
Call 811 before you dig.

BLUE STAKES OF UTAH
UTILITY NOTIFICATION CENTER, INC.
www.bluestakes.org
1-800-662-4111

SCALE

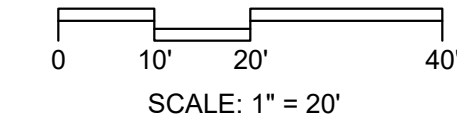

BID SET				DESIGNED SKB								JORDAN VALLEY WATER TREATMENT PLANT		VERIFY SCALES	JOB NO. 202001.10
				DRAWN MNH								FILTER AND CHEMICAL FEED UPGRADES		BAR IS ONE INCH ON ORIGINAL DRAWING	DRAWING NO. 01DE01
				CHECKED GCE								DEMOLITION		0 1" 1"	SHEET NO.
				DATE FEBRUARY 2025								ELECTRICAL PLAN 1		IF NOT ONE INCH ON THIS SHEET, ADJUST SCALES ACCORDINGLY	OF
1	2	3	4	5	6	7	8	9	10	11	12	13			

Plot Date: 10-FEB-2025 8:43:39 AM

User: svcPW

PlotScale: 1:1

Model: Layout1 ColorTable: gshade.ctb DesignScript: Carollo_Stg_Pen_v0905.pen

LAST SAVED BY: jscheele




OVERHEAD DOOR DEMOLITION

12 PHOTO
30D01 SCALE: NO SCALE
FILE: IMG_2212.JPG




BACKWASH FLOWMETER DEMOLITION

14 PHOTO
30D01 SCALE: NO SCALE
FILE: IMG_20221216_111020_10_028.JPG

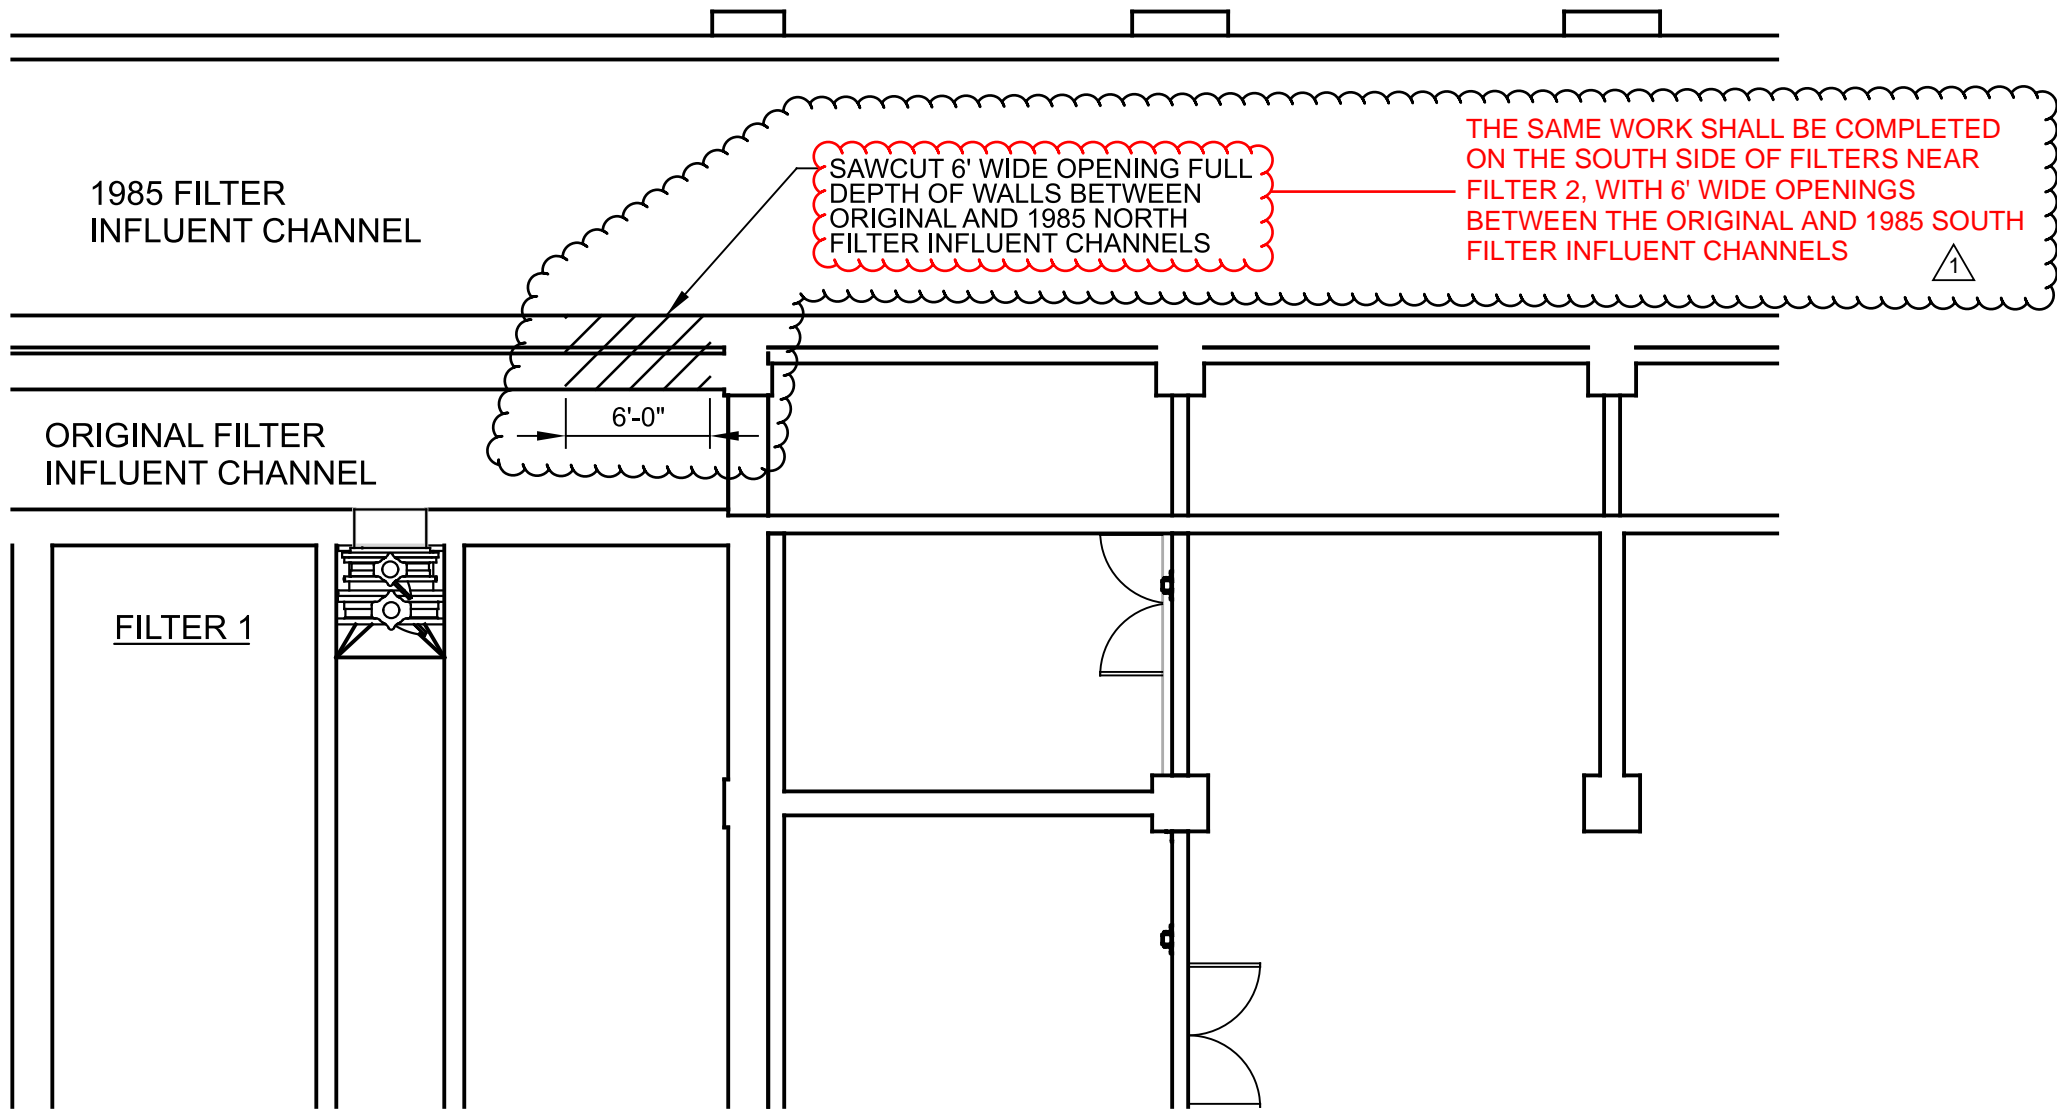

INFLUENT CHANNEL

16 DETAIL
30D01 SCALE: 1/8" = 1'-0"
FILE: 20200130M0801

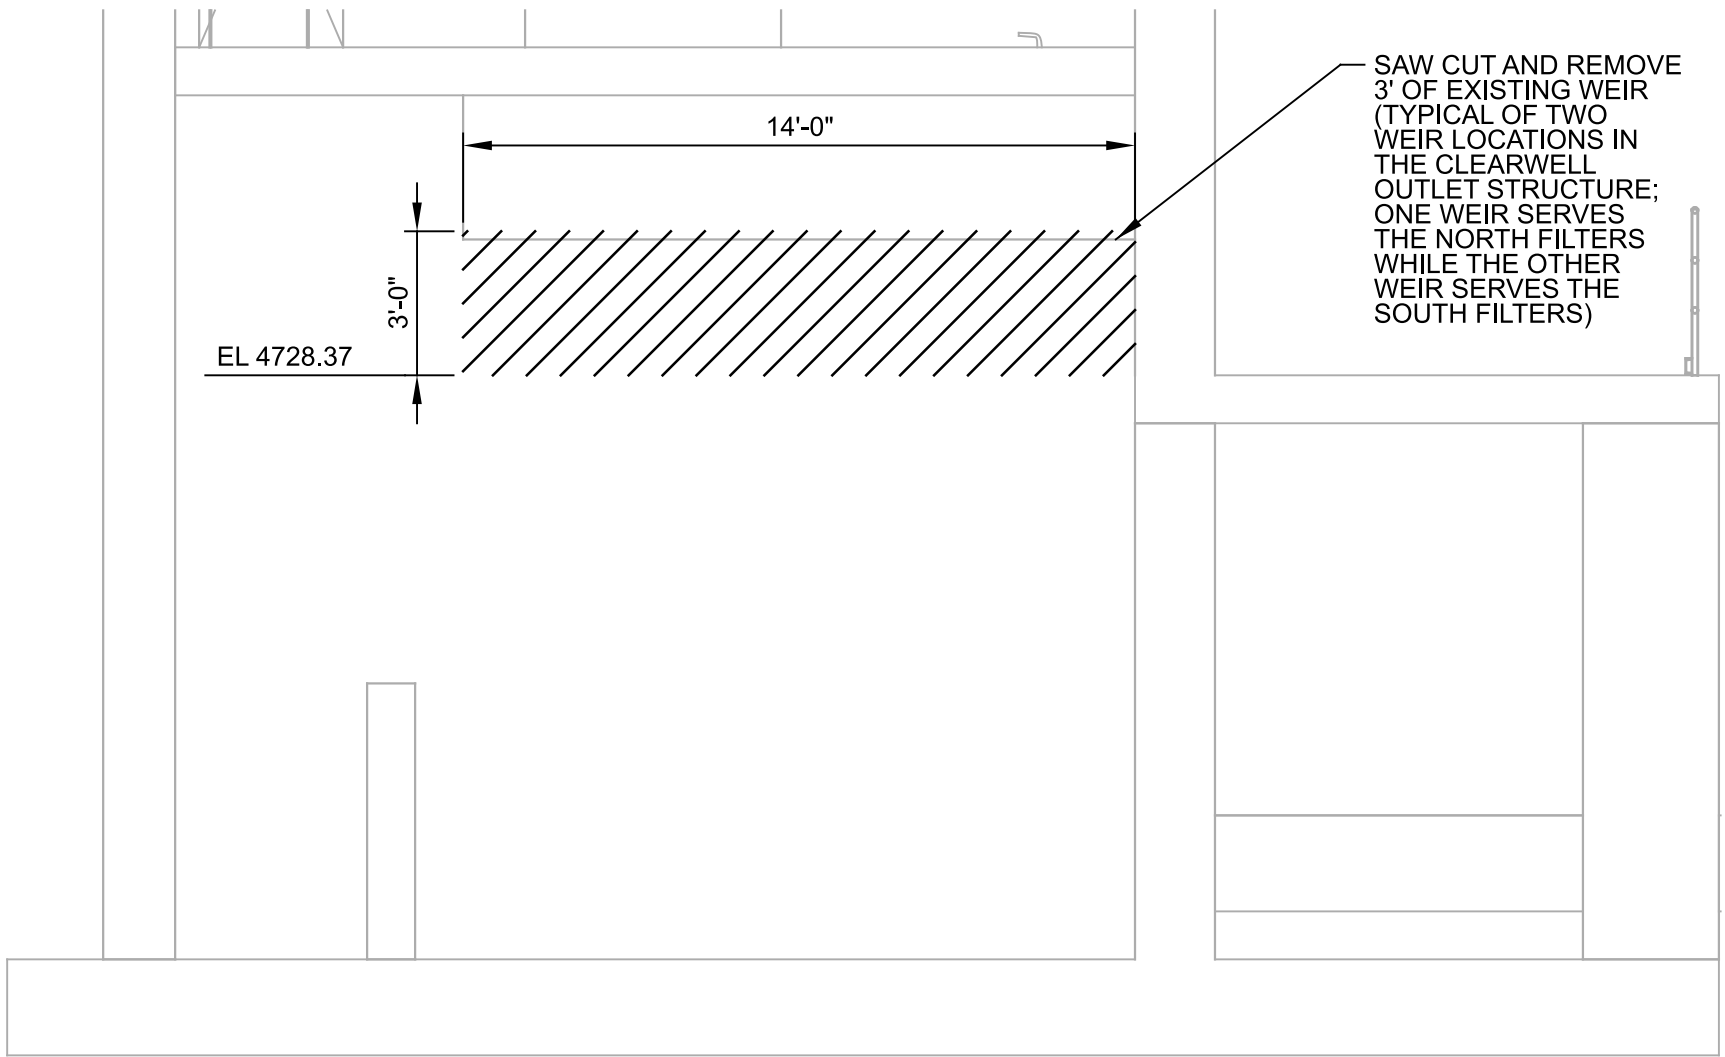


EFFLUENT WEIRS

15 DETAIL
30D01 SCALE: 1/4" = 1'-0"
FILE: SECTION 15

BID SET			
REV	DATE	BY	DESCRIPTION
1	04/15/2025	BRB	ADDENDUM NO. 1

DESIGNED	BRB
DRAWN	SF
CHECKED	
DATE	FEBRUARY 2025

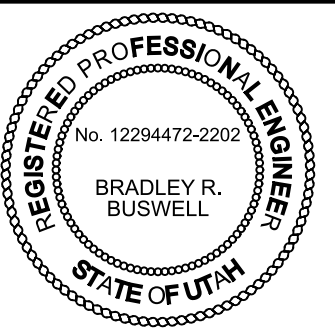

JORDAN VALLEY WATER TREATMENT PLANT

FILTER AND CHEMICAL FEED UPGRADES

DEMOLITION
FILTERS
DETAILS 4

VERIFY SCALES
BAR IS ONE INCH ON ORIGINAL DRAWING
0 1"
IF NOT ONE INCH ON THIS SHEET, ADJUST SCALES ACCORDINGLY

JOB NO.
202001.10
DRAWING NO.
30D07
SHEET NO.
OF

Plot Date: 1/29/2025 6:11:41 PM

LAST SAVED BY: AEVans



PLAN

FILE: 20200101C02


GENERAL NOTES:

- SEE 01C07 FOR COORDINATE DATA AND CURVE DATA.
- ADJUST ALL VALVE BOXES, MANHOLES, HANDHOLES AND PULL BOXES TO FINISHED GRADE.
- THE ELEVATION/SURFACE OF NEW SIDEWALKS, PAVEMENT, CURBS AND OTHER HARD SURFACES SHALL MATCH EXISTING SURFACES AND FEATURES WITHOUT ABRUPT GRADE CHANGES.
- SPREAD SEED MIX PER SPECIFICATION 02939 IN ALL DISTURBED AREAS THAT DO NOT RECEIVE A FINISHED SURFACE TREATMENT SUCH AS PAVEMENT, SIDEWALK, RIPRAP, ETC.
- THE BOUNDARY OF THE "PREVIOUS CONSTRUCTION ROCK DISPOSAL AREA" IS UNKNOWN. LIKEWISE THE SUBSURFACE MATERIAL IN THIS AREA, OTHER THAN WHAT IS EVIDENCED IN THE PROJECTS GEOTECHNICAL REPORT ARE ALSO UNKNOWN.


KEY NOTES:

- DRIVEWAY APPROACH, SIMILAR TO APWA PAN 225.
- ASPHALT PAVEMENT PER DETAIL 1 ON DWG 01C31.
- CURB AND GUTTER PER APWA PLAN 205.1 TYPE A.
- VERTICAL CURB PER APWA PLAN 209 TYPE P.
- INSTALL CORNER POST IN EXISTING FENCE LINE.
- INSTALL VERTICAL PIVOT GATE OPERATORS FROM EXISTING SOUTH GATE WITH NEW CHAINLINK 300+1 GATE LEAVES FROM AUTOGATE. ADJUST AND BALANCE OPERATORS FOR THE NEW GATES LEAVES, SEE EXISTING GATE O&M MANUAL AND ADDITIONAL INFORMATION PROVIDED IN **VOLUME 6 OF 6, APPENDIX C**.
- ORANGE WINDSOCK. AIRPORT WINDSOCK CORPORATION AWCS8-36, 8" BALL BEARING FRAME AWCFB8, AND HINGED 20' POLE AWCP-20. FOUNDATION SIM TO SC190/TYP.
- 48" TALL WOVEN WIRE FENCE PER UDOT STD DWG NO FG 1A AND UDOT STANDARD SPECIFICATION 02822. INSTALL SIM TO TYPE F FENCE WITH THE HEIGHT OF THE FENCE INCREASED TO 48".
- BACKWASH TANK VALVE VAULT, SEE DWG 41S04.
- D₆=6" RIPRAP @ 1 FT DEPTH
- SPLASH PAD PER DETAIL 3 ON DWG 01C33

LEGEND:

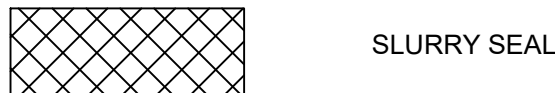


KEY PLAN

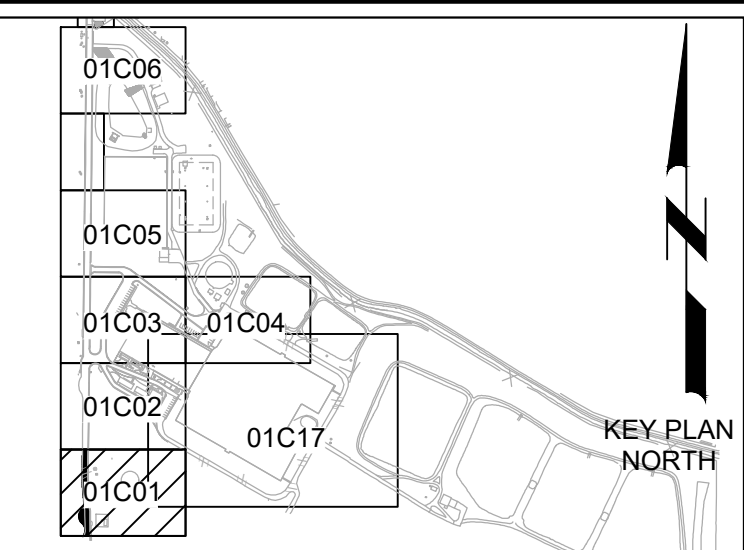

Know what's below.
Call 811 before you dig.


BLUE STAKES OF UTAH
UTILITY NOTIFICATION CENTER, INC.
www.bluestakes.org
1-800-662-4111

SCALE

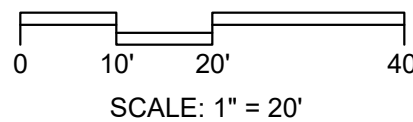

BID SET

DESIGNED
DAS
DRAWN
ARE
CHECKED
DAS
DATE
FEBRUARY 2025

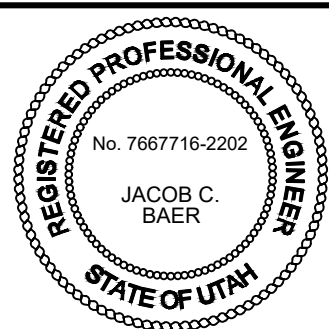

JORDAN VALLEY WATER TREATMENT PLANT

FILTER AND CHEMICAL FEED UPGRADES

CIVIL

GRADING AND PAVING PLAN 1

VERIFY SCALES

BAR IS ONE INCH ON ORIGINAL DRAWING
0 1"
IF NOT ONE INCH ON THIS SHEET, ADJUST SCALES ACCORDINGLY

JOB NO.

202001.10


DRAWING NO.

01C01

SHEET NO.

OF

[illegible]

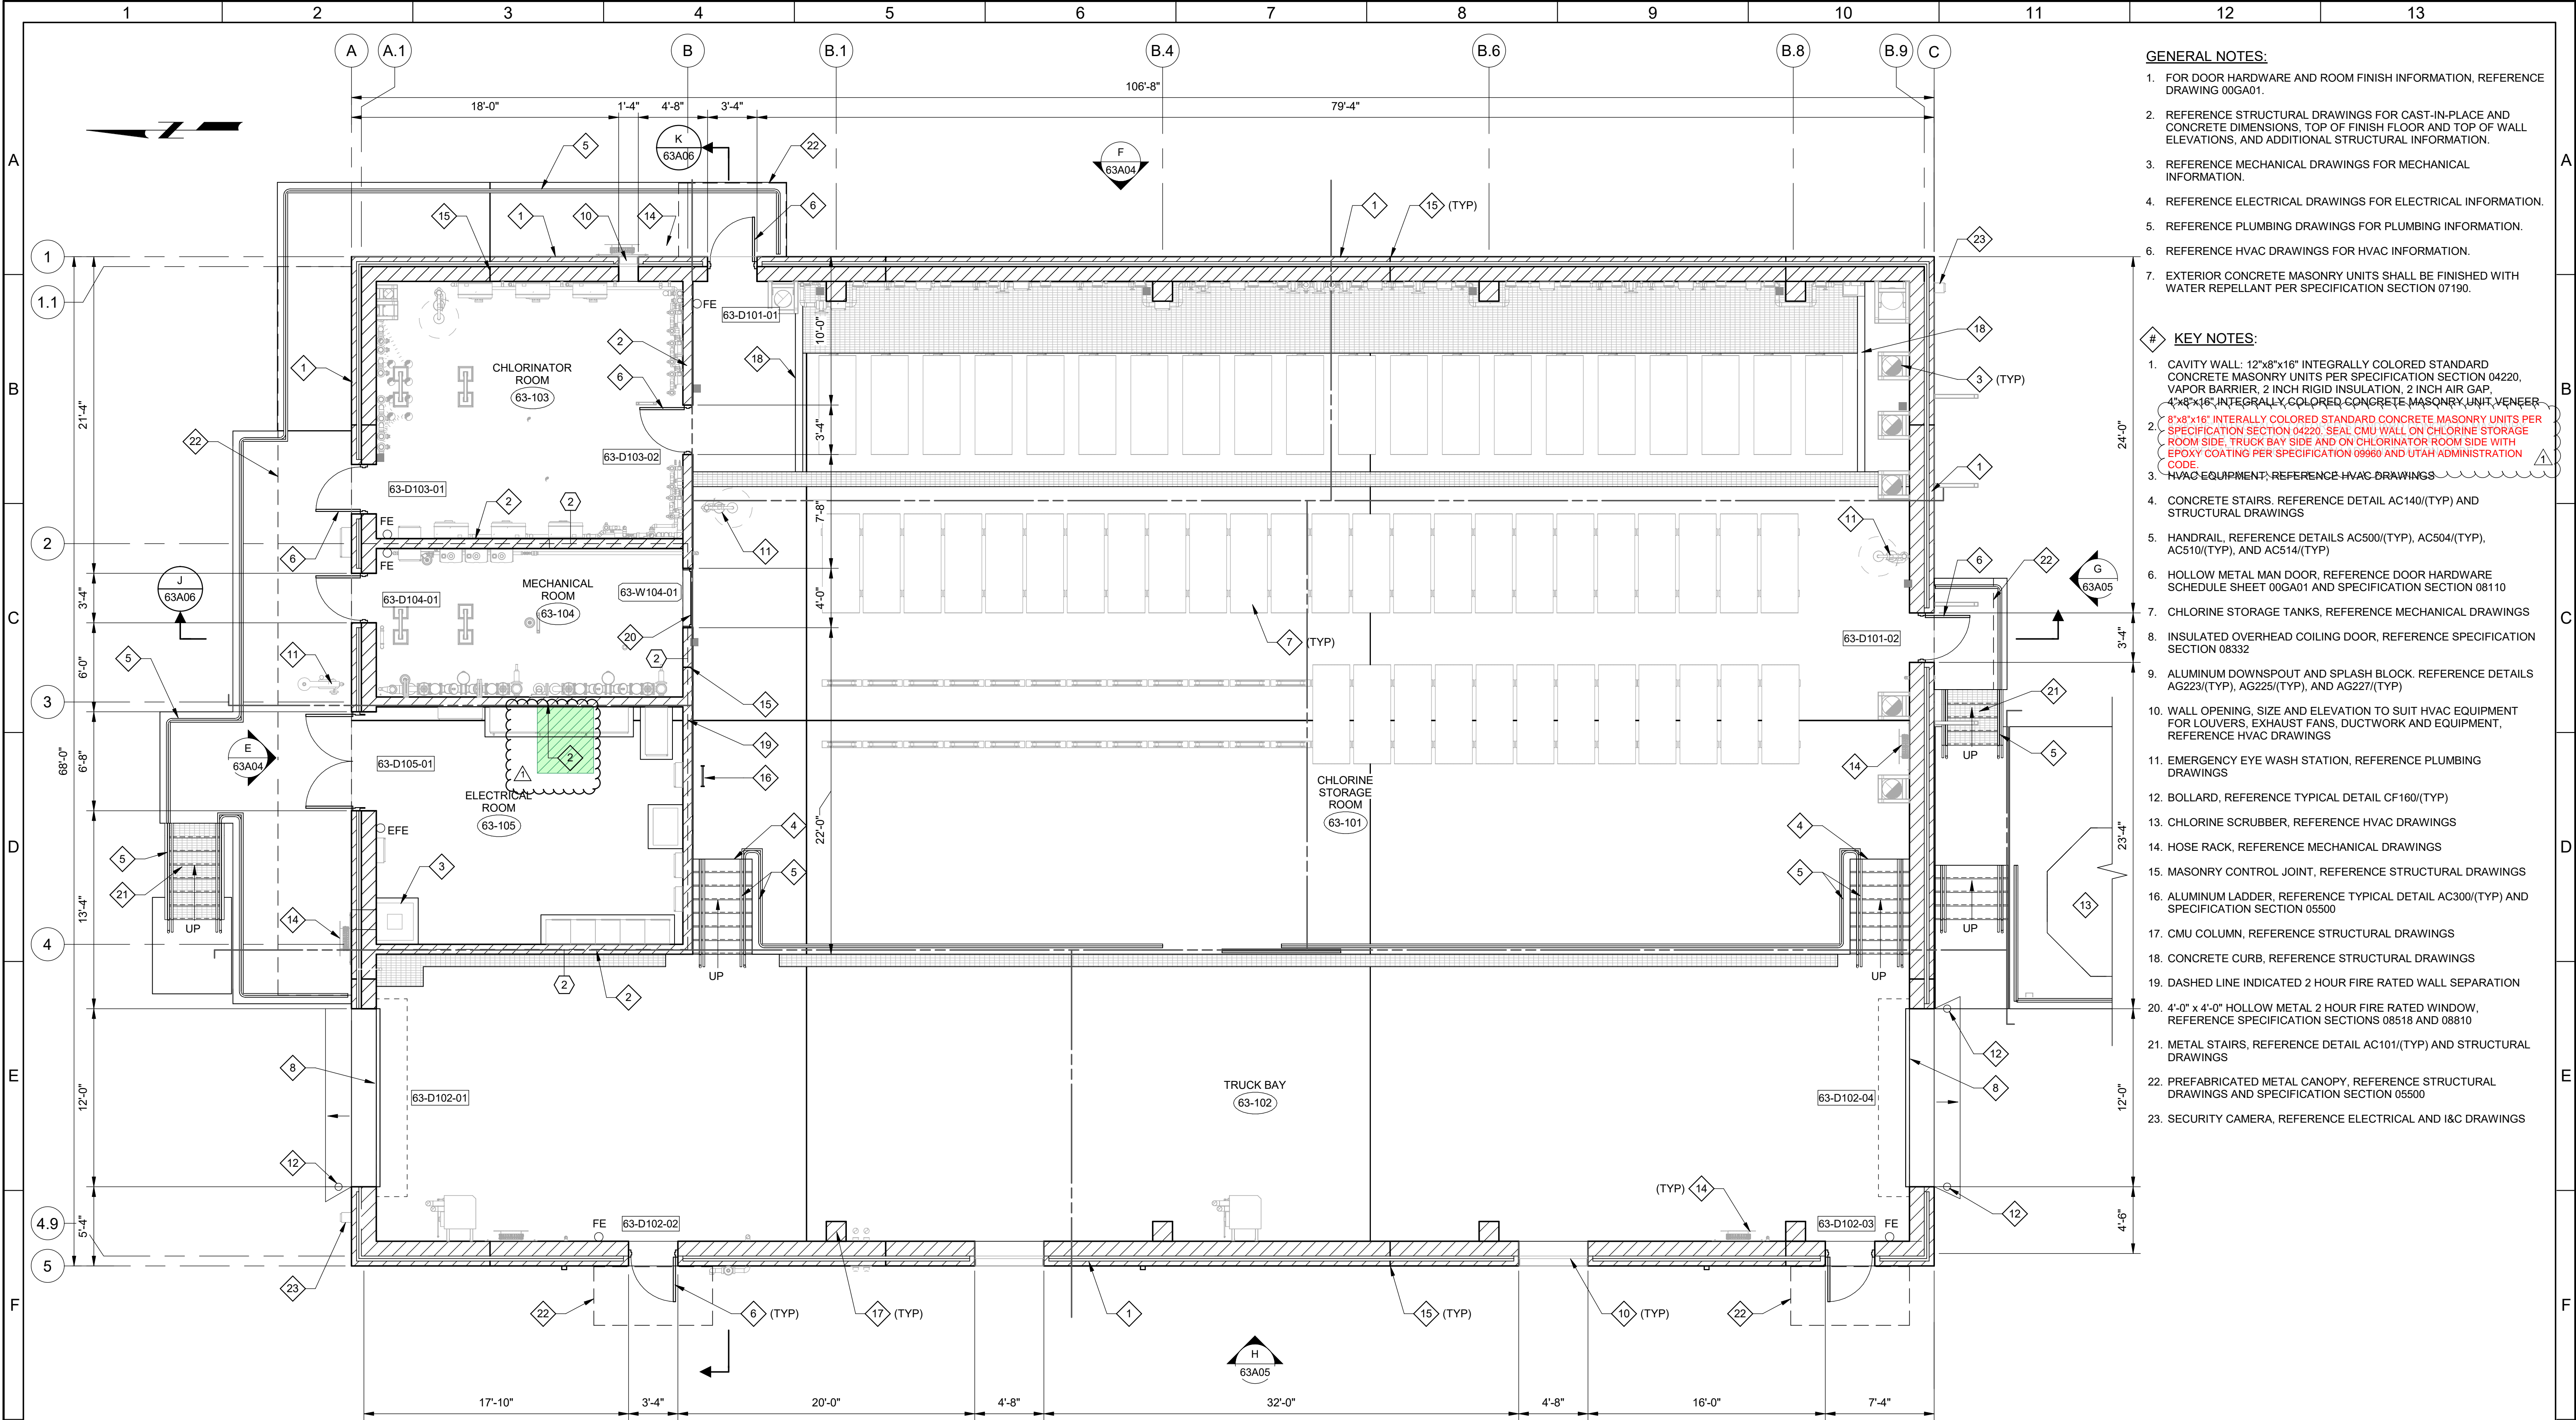


- GENERAL NOTES:**
- FOR DOOR HARDWARE AND ROOM FINISH INFORMATION, REFERENCE DRAWING 00GA01.
 - REFERENCE STRUCTURAL DRAWINGS FOR CAST-IN-PLACE AND CONCRETE DIMENSIONS, TOP OF FINISH FLOOR AND TOP OF WALL ELEVATIONS, AND ADDITIONAL STRUCTURAL INFORMATION.
 - REFERENCE MECHANICAL DRAWINGS FOR MECHANICAL INFORMATION.
 - REFERENCE ELECTRICAL DRAWINGS FOR ELECTRICAL INFORMATION.
 - REFERENCE PLUMBING DRAWINGS FOR PLUMBING INFORMATION.
 - REFERENCE HVAC DRAWINGS FOR HVAC INFORMATION.
 - EXTERIOR CONCRETE MASONRY UNITS SHALL BE FINISHED WITH WATER REPELLANT PER SPECIFICATION SECTION 07190.

- # KEY NOTES:**
- CAVITY WALL: 12"x8"x16" INTEGRALLY COLORED STANDARD CONCRETE MASONRY UNITS PER SPECIFICATION SECTION 04220, VAPOR BARRIER, 2 INCH RIGID INSULATION, 2 INCH AIR GAP, 4"x8"x16" INTEGRALLY COLORED CONCRETE MASONRY UNIT VENEER
 - 8"x8"x16" INTEGRALLY COLORED STANDARD CONCRETE MASONRY UNITS PER SPECIFICATION SECTION 04220. SEAL CMU WALL ON CHLORINE STORAGE ROOM SIDE, TRUCK BAY SIDE AND ON CHLORINATOR ROOM SIDE WITH EPOXY COATING PER SPECIFICATION 09960 AND UTAH ADMINISTRATION CODE.
 - HVAC EQUIPMENT: REFERENCE HVAC DRAWINGS
 - CONCRETE STAIRS, REFERENCE DETAIL AC140/(TYP) AND STRUCTURAL DRAWINGS
 - HANDRAIL, REFERENCE DETAILS AC500/(TYP), AC504/(TYP), AC510/(TYP), AND AC514/(TYP)
 - HOLLOW METAL MAN DOOR, REFERENCE DOOR HARDWARE SCHEDULE SHEET 00GA01 AND SPECIFICATION SECTION 08110
 - CHLORINE STORAGE TANKS, REFERENCE MECHANICAL DRAWINGS
 - INSULATED OVERHEAD COILING DOOR, REFERENCE SPECIFICATION SECTION 08332
 - ALUMINUM DOWNSPOUT AND SPLASH BLOCK, REFERENCE DETAILS AG223/(TYP), AG225/(TYP), AND AG227/(TYP)
 - WALL OPENING, SIZE AND ELEVATION TO SUIT HVAC EQUIPMENT FOR LOUVERS, EXHAUST FANS, DUCTWORK AND EQUIPMENT, REFERENCE HVAC DRAWINGS
 - EMERGENCY EYE WASH STATION, REFERENCE PLUMBING DRAWINGS
 - BOLLARD, REFERENCE TYPICAL DETAIL CF160/(TYP)
 - CHLORINE SCRUBBER, REFERENCE HVAC DRAWINGS
 - HOSE RACK, REFERENCE MECHANICAL DRAWINGS
 - MASONRY CONTROL JOINT, REFERENCE STRUCTURAL DRAWINGS
 - ALUMINUM LADDER, REFERENCE TYPICAL DETAIL AC300/(TYP) AND SPECIFICATION SECTION 05500
 - CMU COLUMN, REFERENCE STRUCTURAL DRAWINGS
 - CONCRETE CURB, REFERENCE STRUCTURAL DRAWINGS
 - DASHED LINE INDICATED 2 HOUR FIRE RATED WALL SEPARATION
 - 4'-0" x 4'-0" HOLLOW METAL 2 HOUR FIRE RATED WINDOW, REFERENCE SPECIFICATION SECTIONS 08518 AND 08810
 - METAL STAIRS, REFERENCE DETAIL AC101/(TYP) AND STRUCTURAL DRAWINGS
 - PREFABRICATED METAL CANOPY, REFERENCE STRUCTURAL DRAWINGS AND SPECIFICATION SECTION 05500
 - SECURITY CAMERA, REFERENCE ELECTRICAL AND I&C DRAWINGS

FLOOR
B PLAN
SCALE: 3/16" = 1'-0"

BID SET				DESIGNED MEH								JORDAN VALLEY WATER TREATMENT PLANT			VERIFY SCALES	JOB NO. 202001.10
				DRAWN JA								FILTER AND CHEMICAL FEED UPGRADES			BAR IS ONE INCH ON ORIGINAL DRAWING	DRAWING NO.
				CHECKED JCA											0 1"	63A01
				DATE FEBRUARY 2025								ARCHITECTURAL CHLORINE BUILDING FLOOR PLAN			IF NOT ONE INCH ON THIS SHEET, ADJUST SCALES ACCORDINGLY	SHEET NO. OF
REV	DATE	MEH	ADDENDUM NO. 1	DESCRIPTION												
1																
2																
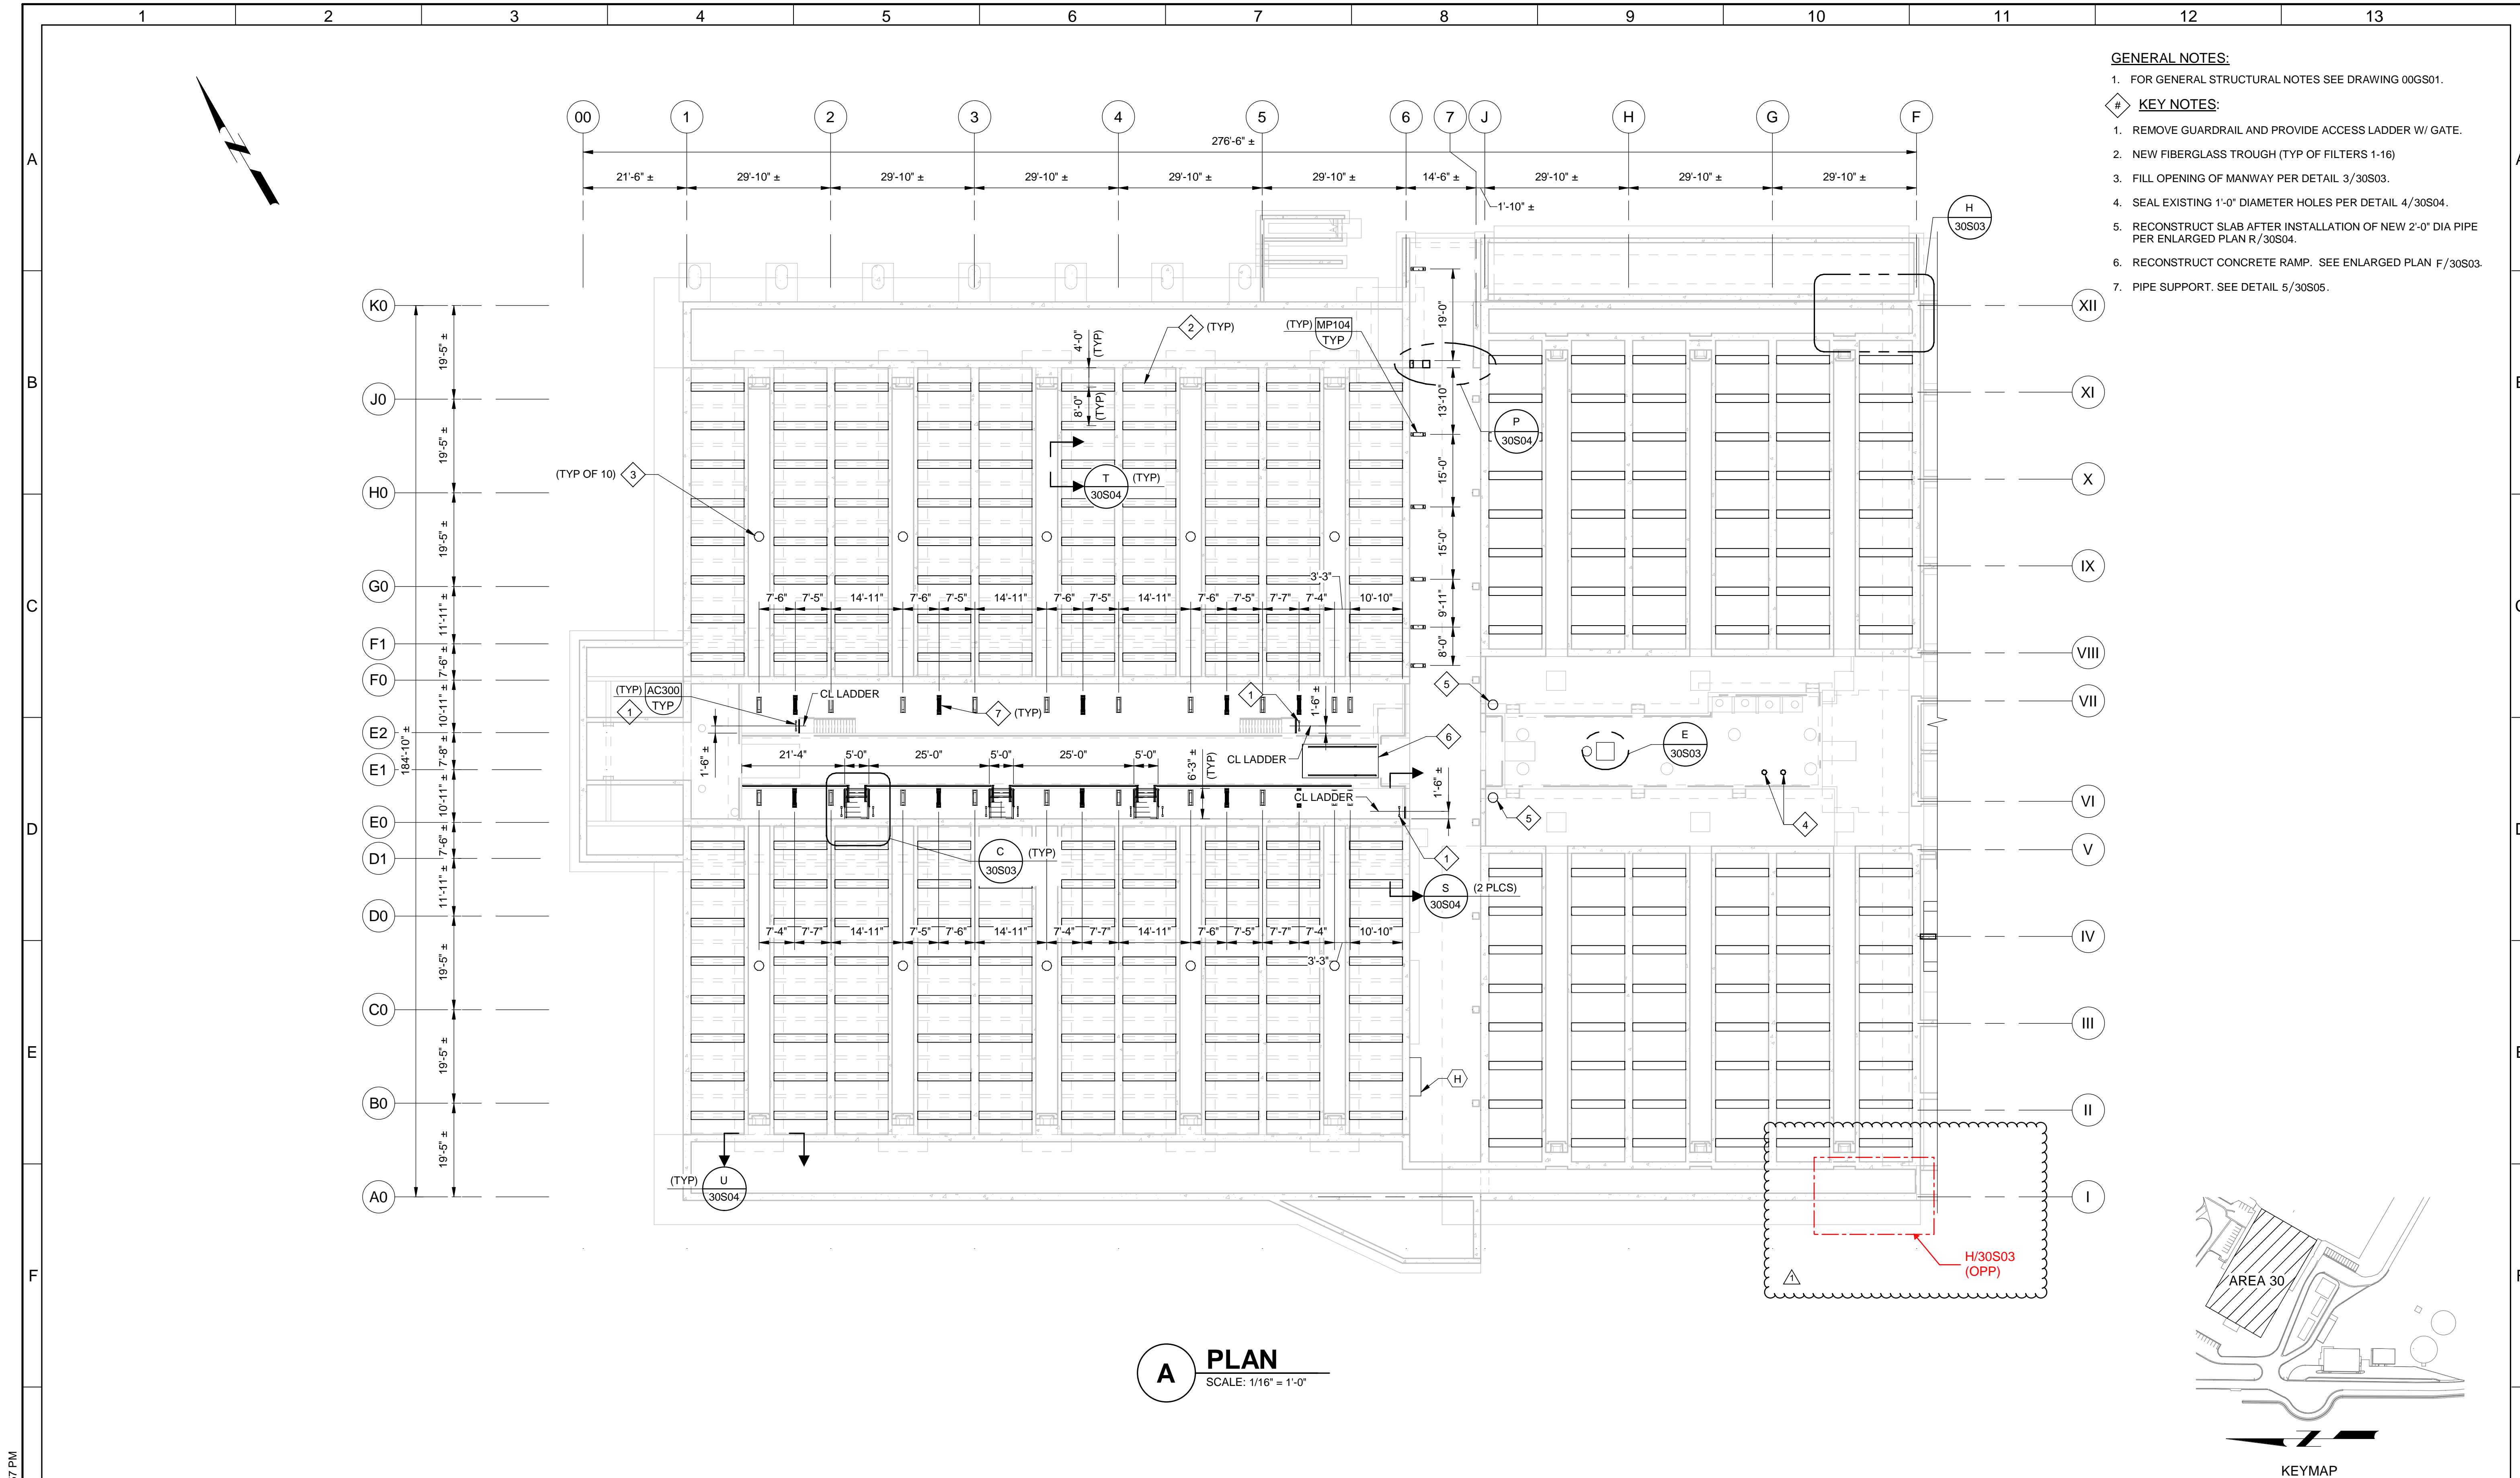


- GENERAL NOTES:**
- FOR GENERAL STRUCTURAL NOTES SEE DRAWING 00GS01.
- KEY NOTES:**
- REMOVE GUARDRAIL AND PROVIDE ACCESS LADDER W/ GATE.
 - NEW FIBERGLASS TROUGH (TYP OF FILTERS 1-16)
 - FILL OPENING OF MANWAY PER DETAIL 3/30S03.
 - SEAL EXISTING 1'-0" DIAMETER HOLES PER DETAIL 4/30S04.
 - RECONSTRUCT SLAB AFTER INSTALLATION OF NEW 2'-0" DIA PIPE PER ENLARGED PLAN R/30S04.
 - RECONSTRUCT CONCRETE RAMP. SEE ENLARGED PLAN F/30S03.
 - PIPE SUPPORT. SEE DETAIL 5/30S05.

A PLAN
SCALE: 1/16" = 1'-0"

PLOT DATE: 2/12/2025 2:13:57 PM

BID SET			
REV	DATE	CB	DESCRIPTION
1	04/15/2025	CB	ADDENDUM NO. 1

DESIGNED CB
DRAWN TJD
CHECKED JAD
DATE FEBRUARY 2025

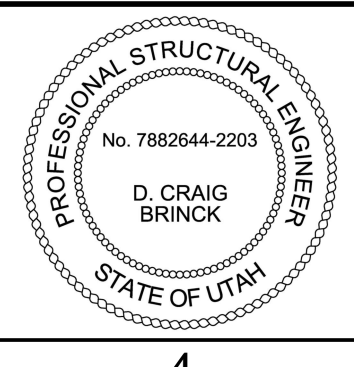


JORDAN VALLEY WATER TREATMENT PLANT
FILTER AND CHEMICAL FEED UPGRADES
STRUCTURAL FILTERS LOWER PLAN

VERIFY SCALES BAR IS ONE INCH ON ORIGINAL DRAWING
0 1"
IF NOT ONE INCH ON THIS SHEET, ADJUST SCALES ACCORDINGLY

JOB NO. 202001.10
DRAWING NO. 30S01
SHEET NO. OF

PLOT DATE: 2/12/2025 2:14:16 PM

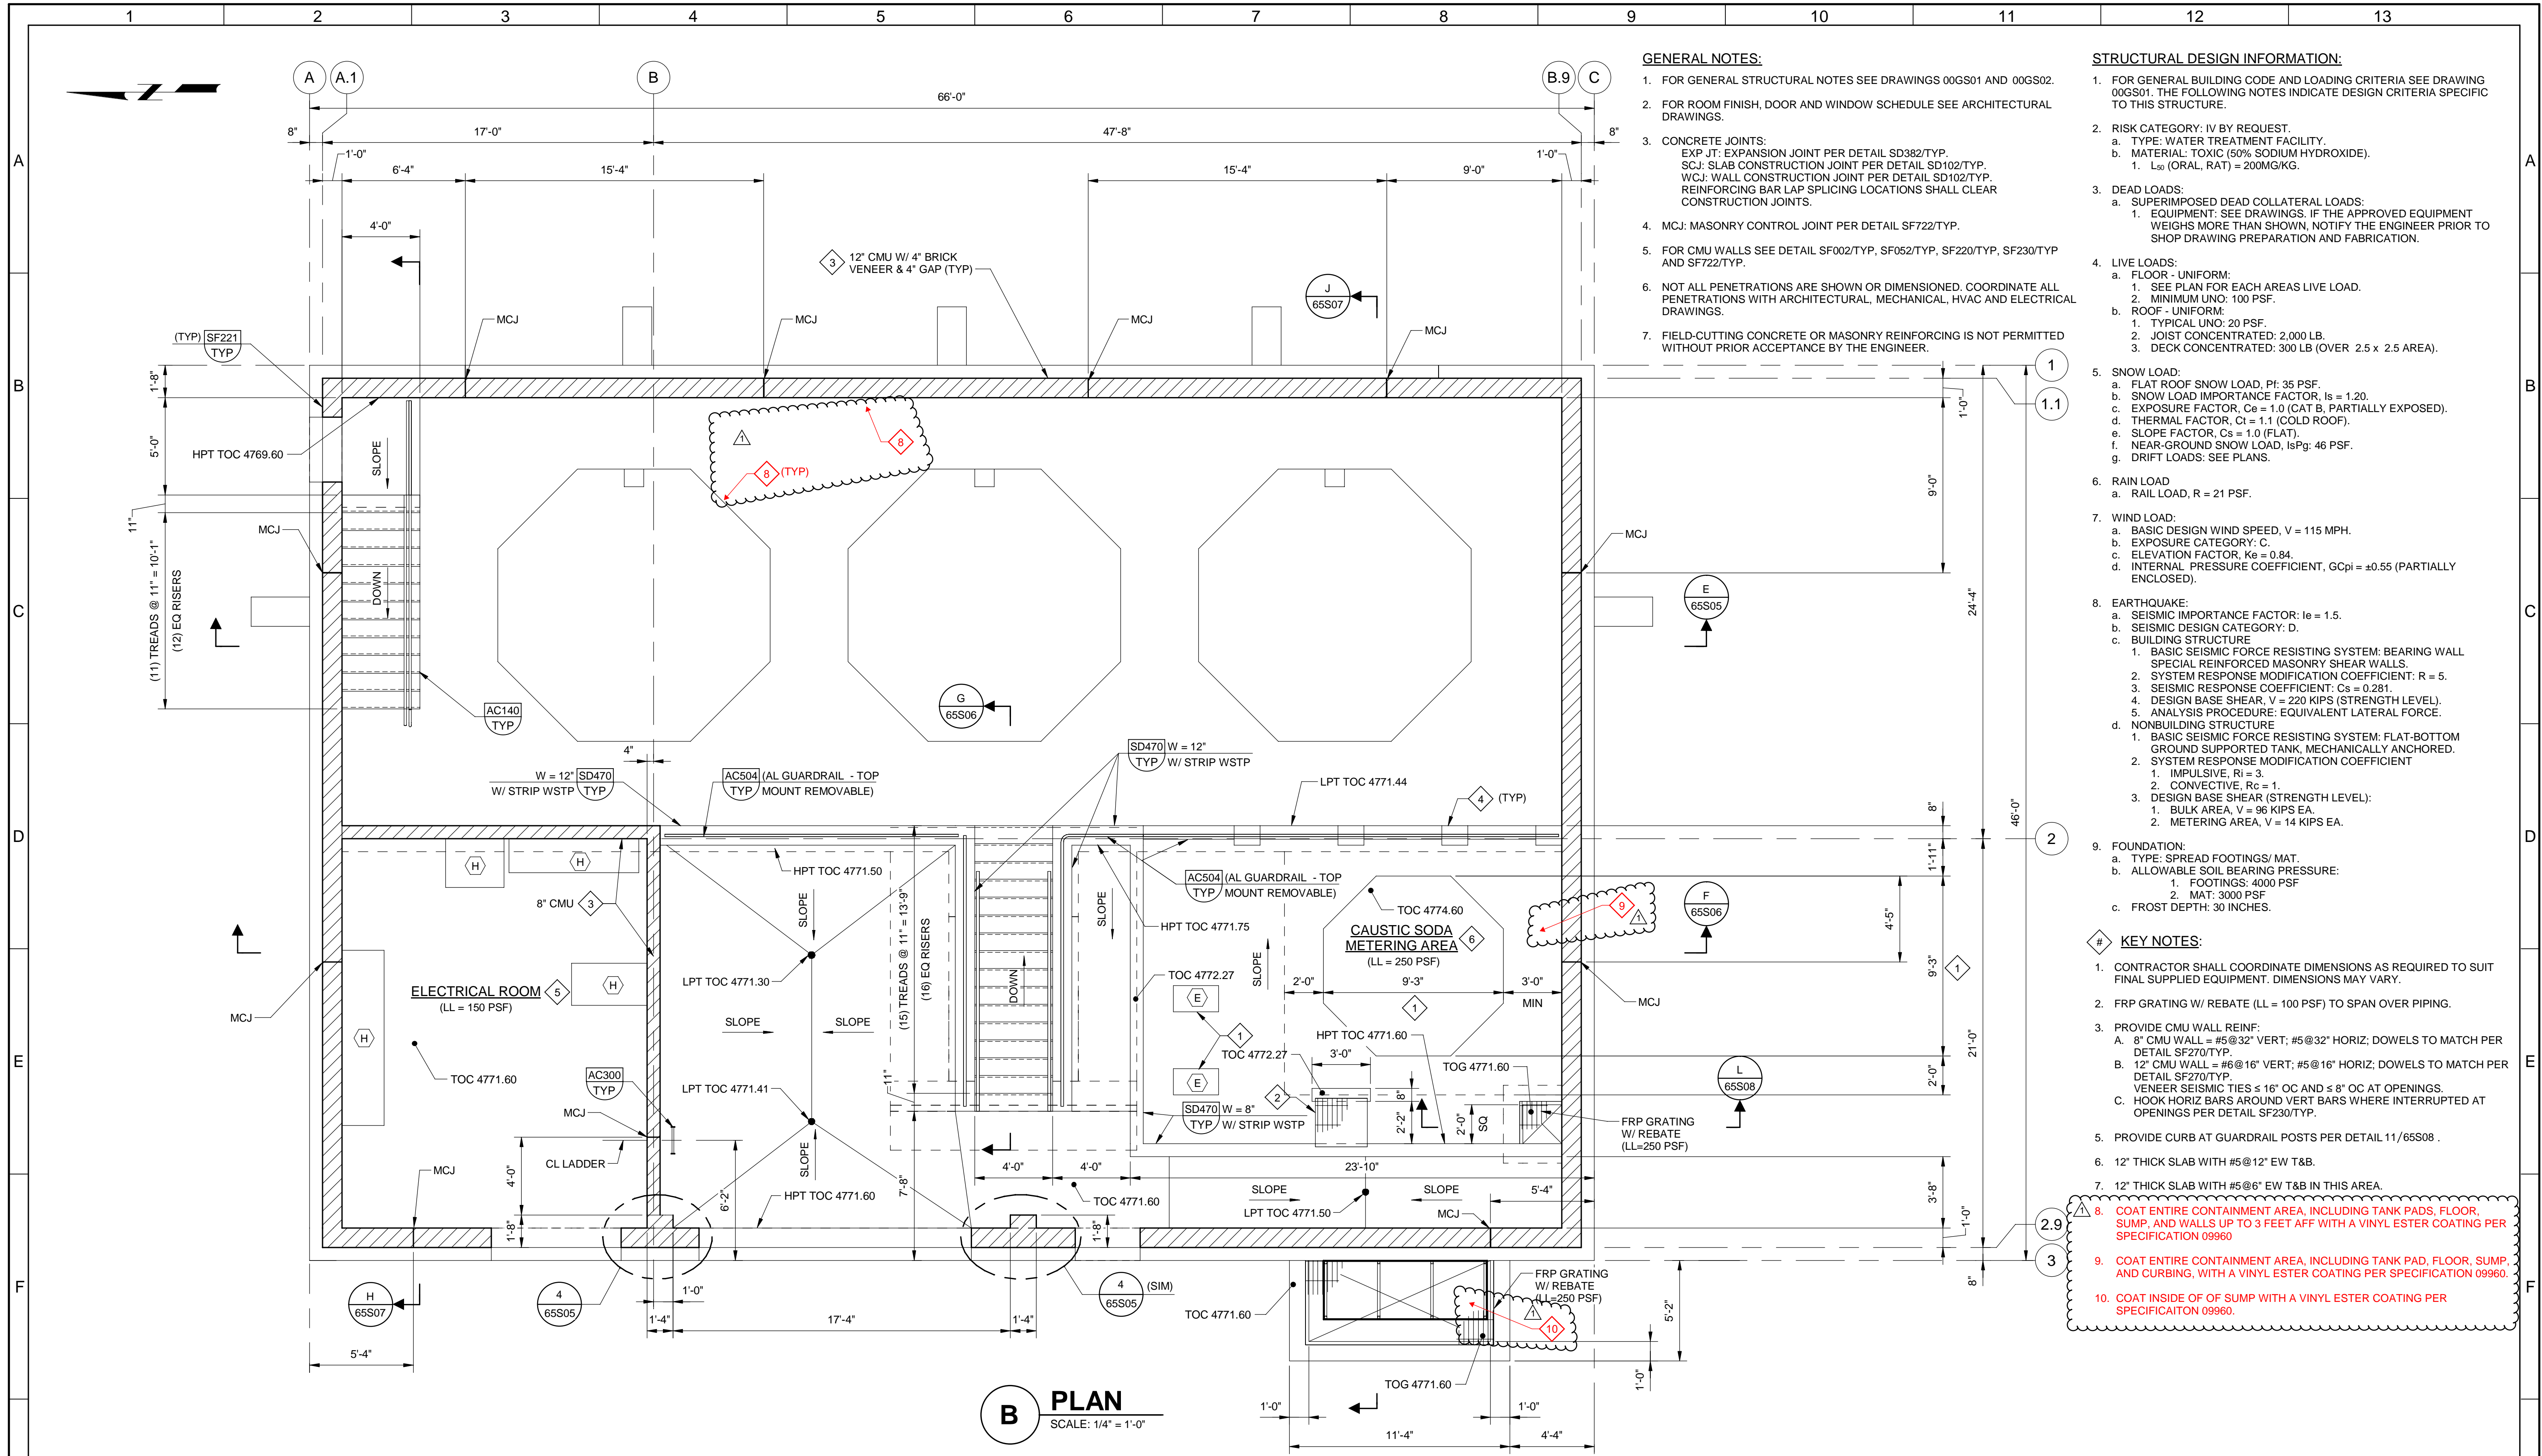

GENERAL NOTES:

- FOR GENERAL STRUCTURAL NOTES SEE DRAWINGS 00GS01 AND 00GS02.
- FOR ROOM FINISH, DOOR AND WINDOW SCHEDULE SEE ARCHITECTURAL DRAWINGS.
- CONCRETE JOINTS:
EXP JT: EXPANSION JOINT PER DETAIL SD382/TYP.
SCJ: SLAB CONSTRUCTION JOINT PER DETAIL SD102/TYP.
WCJ: WALL CONSTRUCTION JOINT PER DETAIL SD102/TYP.
REINFORCING BAR LAP SPlicing LOCATIONS SHALL CLEAR CONSTRUCTION JOINTS.
- MCJ: MASONRY CONTROL JOINT PER DETAIL SF722/TYP.
- FOR CMU WALLS SEE DETAIL SF002/TYP, SF052/TYP, SF220/TYP, SF230/TYP AND SF722/TYP.
- NOT ALL PENETRATIONS ARE SHOWN OR DIMENSIONED. COORDINATE ALL PENETRATIONS WITH ARCHITECTURAL, MECHANICAL, HVAC AND ELECTRICAL DRAWINGS.
- FIELD-CUTTING CONCRETE OR MASONRY REINFORCING IS NOT PERMITTED WITHOUT PRIOR ACCEPTANCE BY THE ENGINEER.

STRUCTURAL DESIGN INFORMATION:


- FOR GENERAL BUILDING CODE AND LOADING CRITERIA SEE DRAWING 00GS01. THE FOLLOWING NOTES INDICATE DESIGN CRITERIA SPECIFIC TO THIS STRUCTURE.
- RISK CATEGORY: IV BY REQUEST.
a. TYPE: WATER TREATMENT FACILITY.
b. MATERIAL: TOXIC (50% SODIUM HYDROXIDE).
1. L_{so} (ORAL, RAT) = 200MG/KG.
- DEAD LOADS:
a. SUPERIMPOSED DEAD COLLATERAL LOADS:
1. EQUIPMENT: SEE DRAWINGS. IF THE APPROVED EQUIPMENT WEIGHS MORE THAN SHOWN, NOTIFY THE ENGINEER PRIOR TO SHOP DRAWING PREPARATION AND FABRICATION.
- LIVE LOADS:
a. FLOOR - UNIFORM:
1. SEE PLAN FOR EACH AREA LIVE LOAD.
2. MINIMUM UNO: 100 PSF.
b. ROOF - UNIFORM:
1. TYPICAL UNO: 20 PSF.
2. JOIST CONCENTRATED: 2,000 LB.
3. DECK CONCENTRATED: 300 LB (OVER 2.5 x 2.5 AREA).
- SNOW LOAD:
a. FLAT ROOF SNOW LOAD, P_f : 35 PSF.
b. SNOW LOAD IMPORTANCE FACTOR, I_s = 1.20.
c. EXPOSURE FACTOR, C_e = 1.0 (CAT B, PARTIALLY EXPOSED).
d. THERMAL FACTOR, C_t = 1.1 (COLD ROOF).
e. SLOPE FACTOR, C_s = 1.0 (FLAT).
f. NEAR-GROUND SNOW LOAD, I_sPg : 46 PSF.
g. DRIFT LOADS: SEE PLANS.
- RAIN LOAD
a. RAIL LOAD, R = 21 PSF.
- WIND LOAD:
a. BASIC DESIGN WIND SPEED, V = 115 MPH.
b. EXPOSURE CATEGORY: C.
c. ELEVATION FACTOR, K_e = 0.84.
d. INTERNAL PRESSURE COEFFICIENT, GCP_i = ± 0.55 (PARTIALLY ENCLOSED).
- EARTHQUAKE:
a. SEISMIC IMPORTANCE FACTOR: I_e = 1.5.
b. SEISMIC DESIGN CATEGORY: D.
c. BUILDING STRUCTURE
1. BASIC SEISMIC FORCE RESISTING SYSTEM: BEARING WALL SPECIAL REINFORCED MASONRY SHEAR WALLS.
2. SYSTEM RESPONSE MODIFICATION COEFFICIENT: R = 5.
3. SEISMIC RESPONSE COEFFICIENT: C_s = 0.281.
4. DESIGN BASE SHEAR, V = 220 KIPS (STRENGTH LEVEL).
5. ANALYSIS PROCEDURE: EQUIVALENT LATERAL FORCE.
d. NONBUILDING STRUCTURE
1. BASIC SEISMIC FORCE RESISTING SYSTEM: FLAT-BOTTOM GROUND SUPPORTED TANK, MECHANICALLY ANCHORED.
2. SYSTEM RESPONSE MODIFICATION COEFFICIENT
1. IMPULSIVE, R_i = 3.
2. CONVECTIVE, R_c = 1.
3. DESIGN BASE SHEAR (STRENGTH LEVEL):
1. BULK AREA, V = 96 KIPS EA.
2. METERING AREA, V = 14 KIPS EA.
- FOUNDATION:
a. TYPE: SPREAD FOOTINGS/ MAT.
b. ALLOWABLE SOIL BEARING PRESSURE:
1. FOOTINGS: 4000 PSF
2. MAT: 3000 PSF
c. FROST DEPTH: 30 INCHES.

KEY NOTES:

- CONTRACTOR SHALL COORDINATE DIMENSIONS AS REQUIRED TO SUIT FINAL SUPPLIED EQUIPMENT. DIMENSIONS MAY VARY.
- FRP GRATING W/ REBATE (LL = 100 PSF) TO SPAN OVER PIPING.
- PROVIDE CMU WALL REINF:
A. 8" CMU WALL = #5@32" VERT; #5@32" HORIZ; DOWELS TO MATCH PER DETAIL SF270/TYP.
B. 12" CMU WALL = #6@16" VERT; #5@16" HORIZ; DOWELS TO MATCH PER DETAIL SF270/TYP.
C. HOOK HORIZ BARS AROUND VERT BARS WHERE INTERRUPTED AT OPENINGS PER DETAIL SF230/TYP.
- PROVIDE CURB AT GUARDRAIL POSTS PER DETAIL 11/65S08.
- 12" THICK SLAB WITH #5@12" EW T&B.
- 12" THICK SLAB WITH #5@6" EW T&B IN THIS AREA.
- COAT ENTIRE CONTAINMENT AREA, INCLUDING TANK PADS, FLOOR, SUMP, AND WALLS UP TO 3 FEET AFF WITH A VINYL ESTER COATING PER SPECIFICATION 09960
- COAT ENTIRE CONTAINMENT AREA, INCLUDING TANK PAD, FLOOR, SUMP, AND CURBING, WITH A VINYL ESTER COATING PER SPECIFICATION 09960.
- COAT INSIDE OF OF SUMP WITH A VINYL ESTER COATING PER SPECIFICATION 09960.

B PLAN
SCALE: 1/4" = 1'-0"


BID SET				DESIGNED JMY										JORDAN VALLEY WATER TREATMENT PLANT				VERIFY SCALES	JOB NO. 202001.10												
				DRAWN TJD										FILTER AND CHEMICAL FEED UPGRADES				BAR IS ONE INCH ON ORIGINAL DRAWING	DRAWING NO.												
				CHECKED JAD										STRUCTURAL CAUSTIC SODA BUILDING LOWER PLAN				0 1"	65S02												
				DATE FEBRUARY 2025														IF NOT ONE INCH ON THIS SHEET, ADJUST SCALES ACCORDINGLY	SHEET NO. OF												
REV	DATE	DCB	ADDDENDUM NO. 1	DESCRIPTION																											
1																															

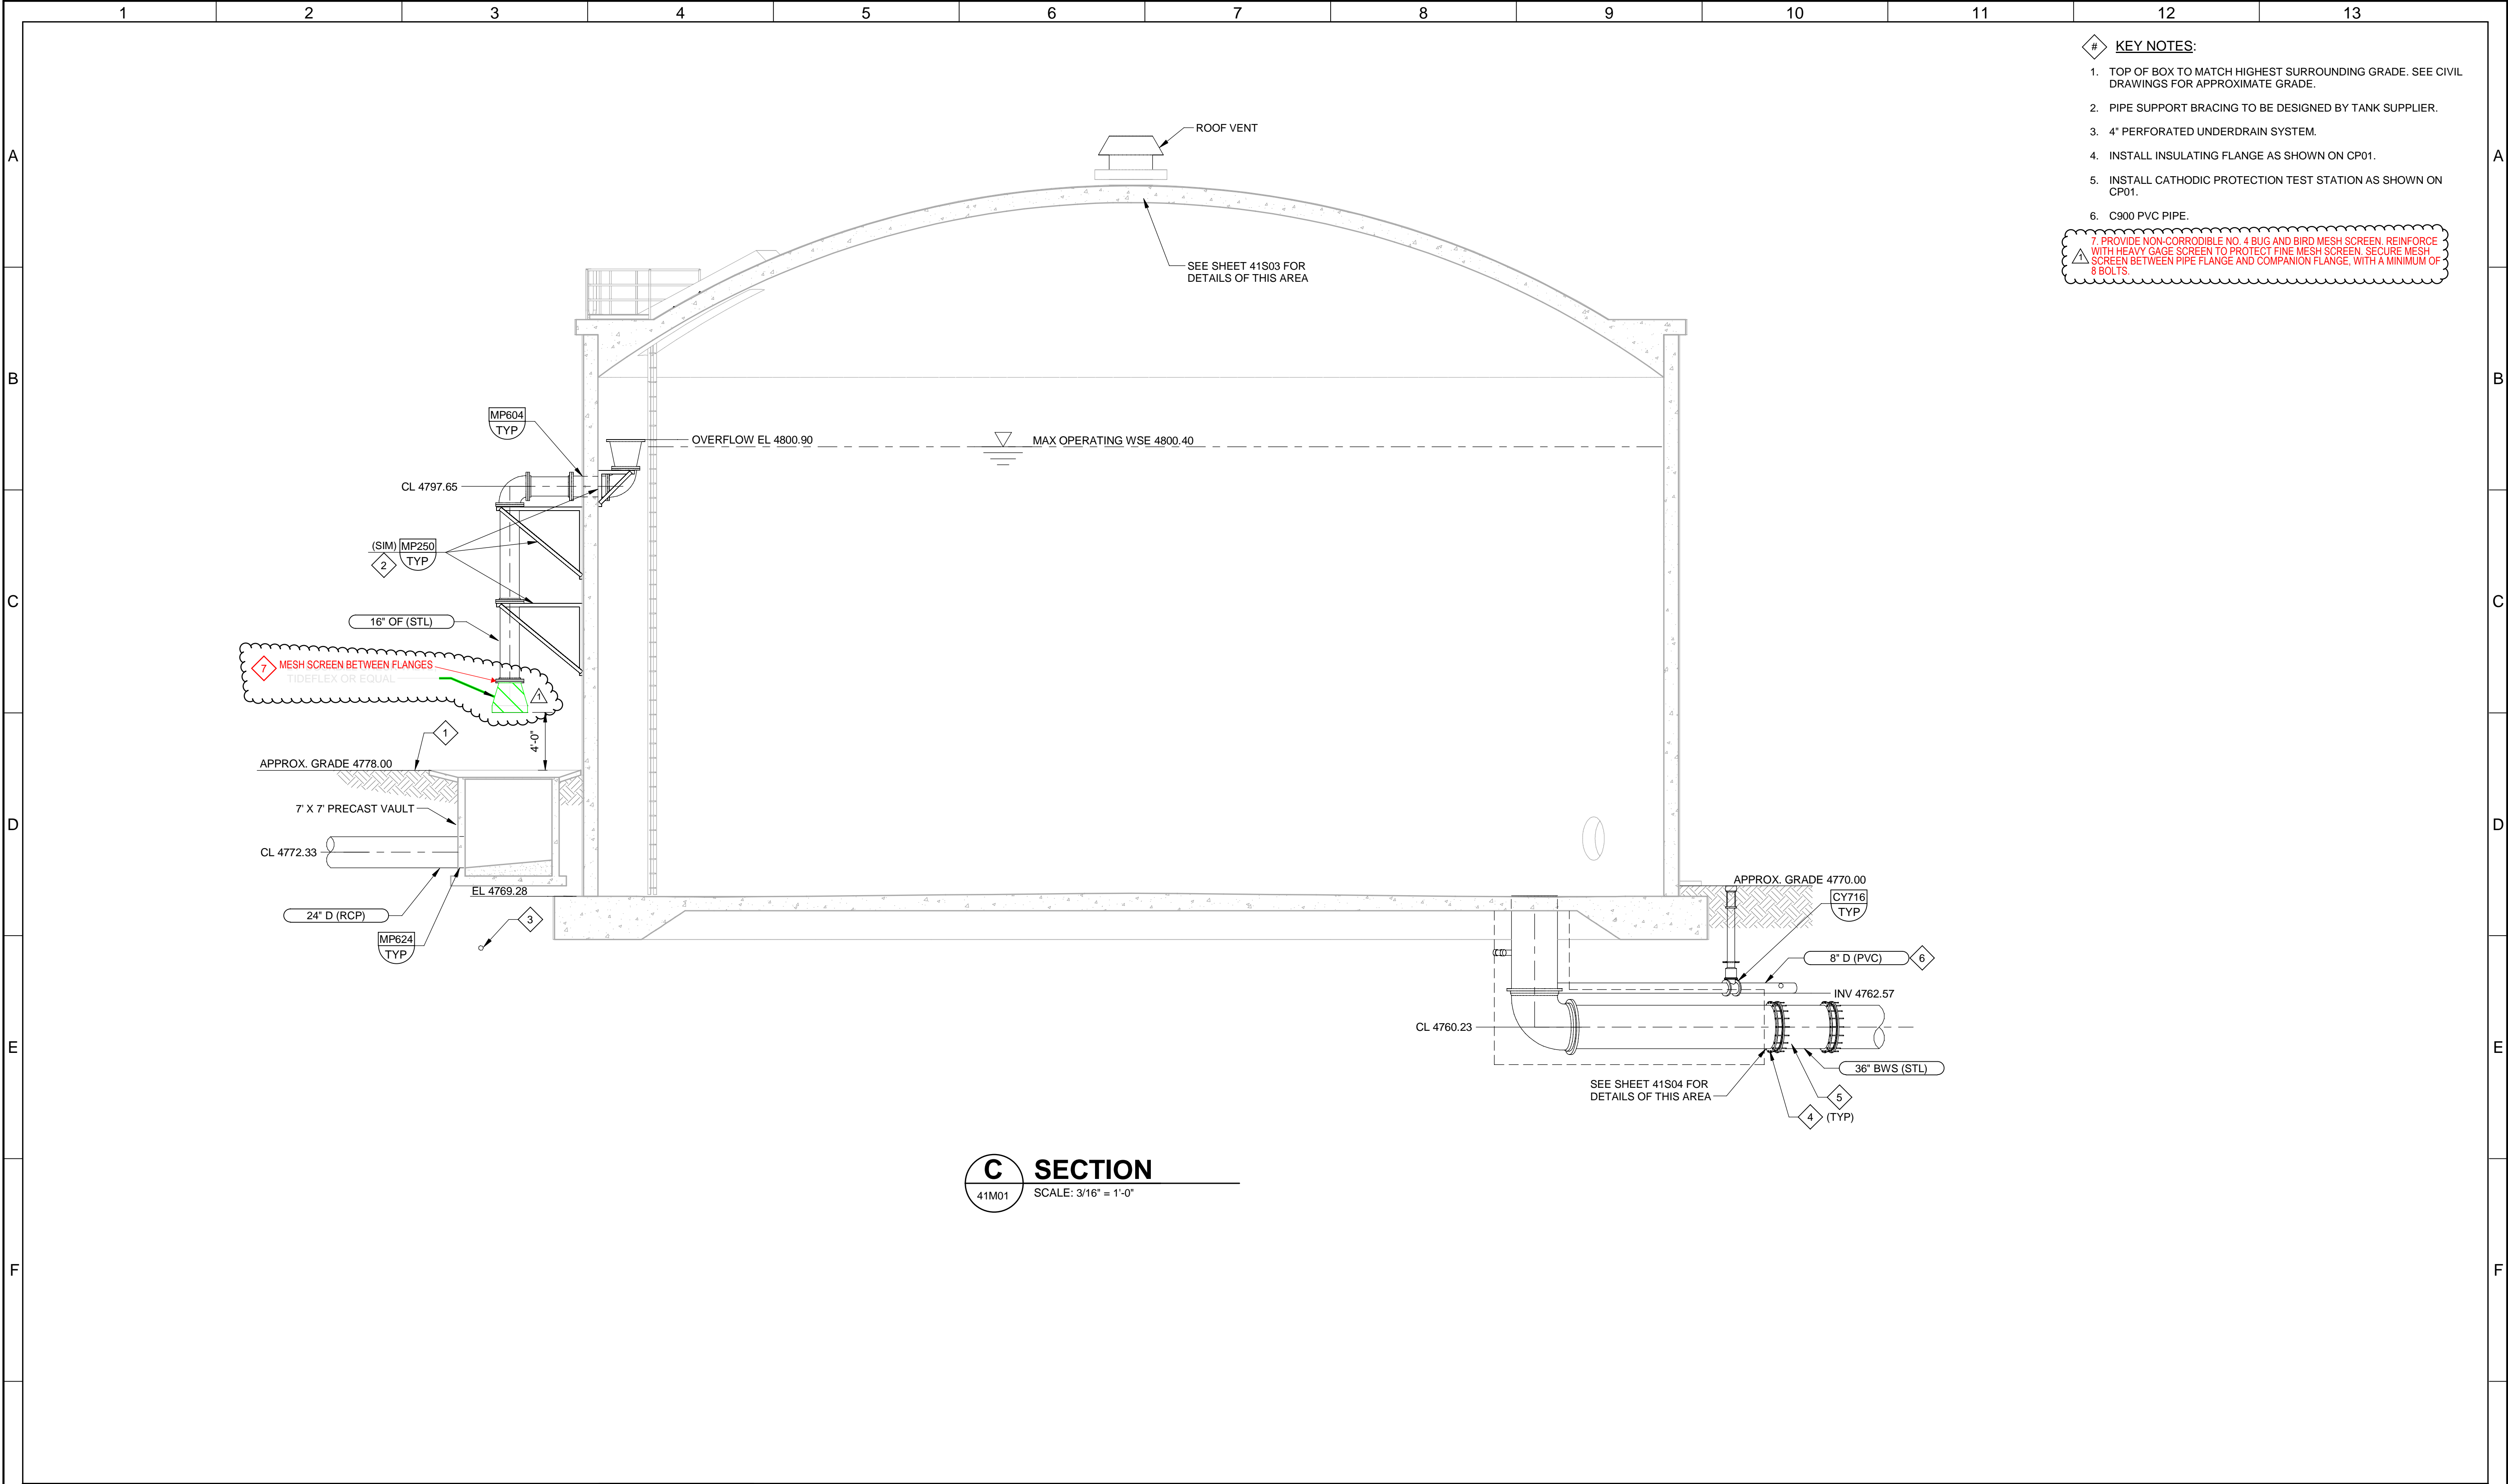

- # KEY NOTES:
1. TOP OF BOX TO MATCH HIGHEST SURROUNDING GRADE. SEE CIVIL DRAWINGS FOR APPROXIMATE GRADE.
 2. PIPE SUPPORT BRACING TO BE DESIGNED BY TANK SUPPLIER.
 3. 4" PERFORATED UNDERDRAIN SYSTEM.
 4. INSTALL INSULATING FLANGE AS SHOWN ON CP01.
 5. INSTALL CATHODIC PROTECTION TEST STATION AS SHOWN ON CP01.
 6. C900 PVC PIPE.
 7. PROVIDE NON-CORRODIBLE NO. 4 BUG AND BIRD MESH SCREEN. REINFORCE WITH HEAVY GAGE SCREEN TO PROTECT FINE MESH SCREEN. SECURE MESH SCREEN BETWEEN PIPE FLANGE AND COMPANION FLANGE, WITH A MINIMUM OF 8 BOLTS.

C SECTION
41M01 SCALE: 3/16" = 1'-0"

G				BID SET		DESIGNED ML							JORDAN VALLEY WATER TREATMENT PLANT			VERIFY SCALES	JOB NO. 202001.10	G								
					DRAWN RPW			FILTER AND CHEMICAL FEED UPGRADES					BAR IS ONE INCH ON ORIGINAL DRAWING	DRAWING NO.												
					CHECKED BRB			MECHANICAL BACKWASH TANK SECTIONS AND DETAILS					0	41M02												
		04/15/2025	RAP	ADDENDUM NO. 1	DATE FEBRUARY 2025								IF NOT ONE INCH ON THIS SHEET, ADJUST SCALES ACCORDINGLY	SHEET NO.												
	REV	DATE	BY	DESCRIPTION										OF												
	1		2		3		4		5		6		7		8		9		10		11		12		13	

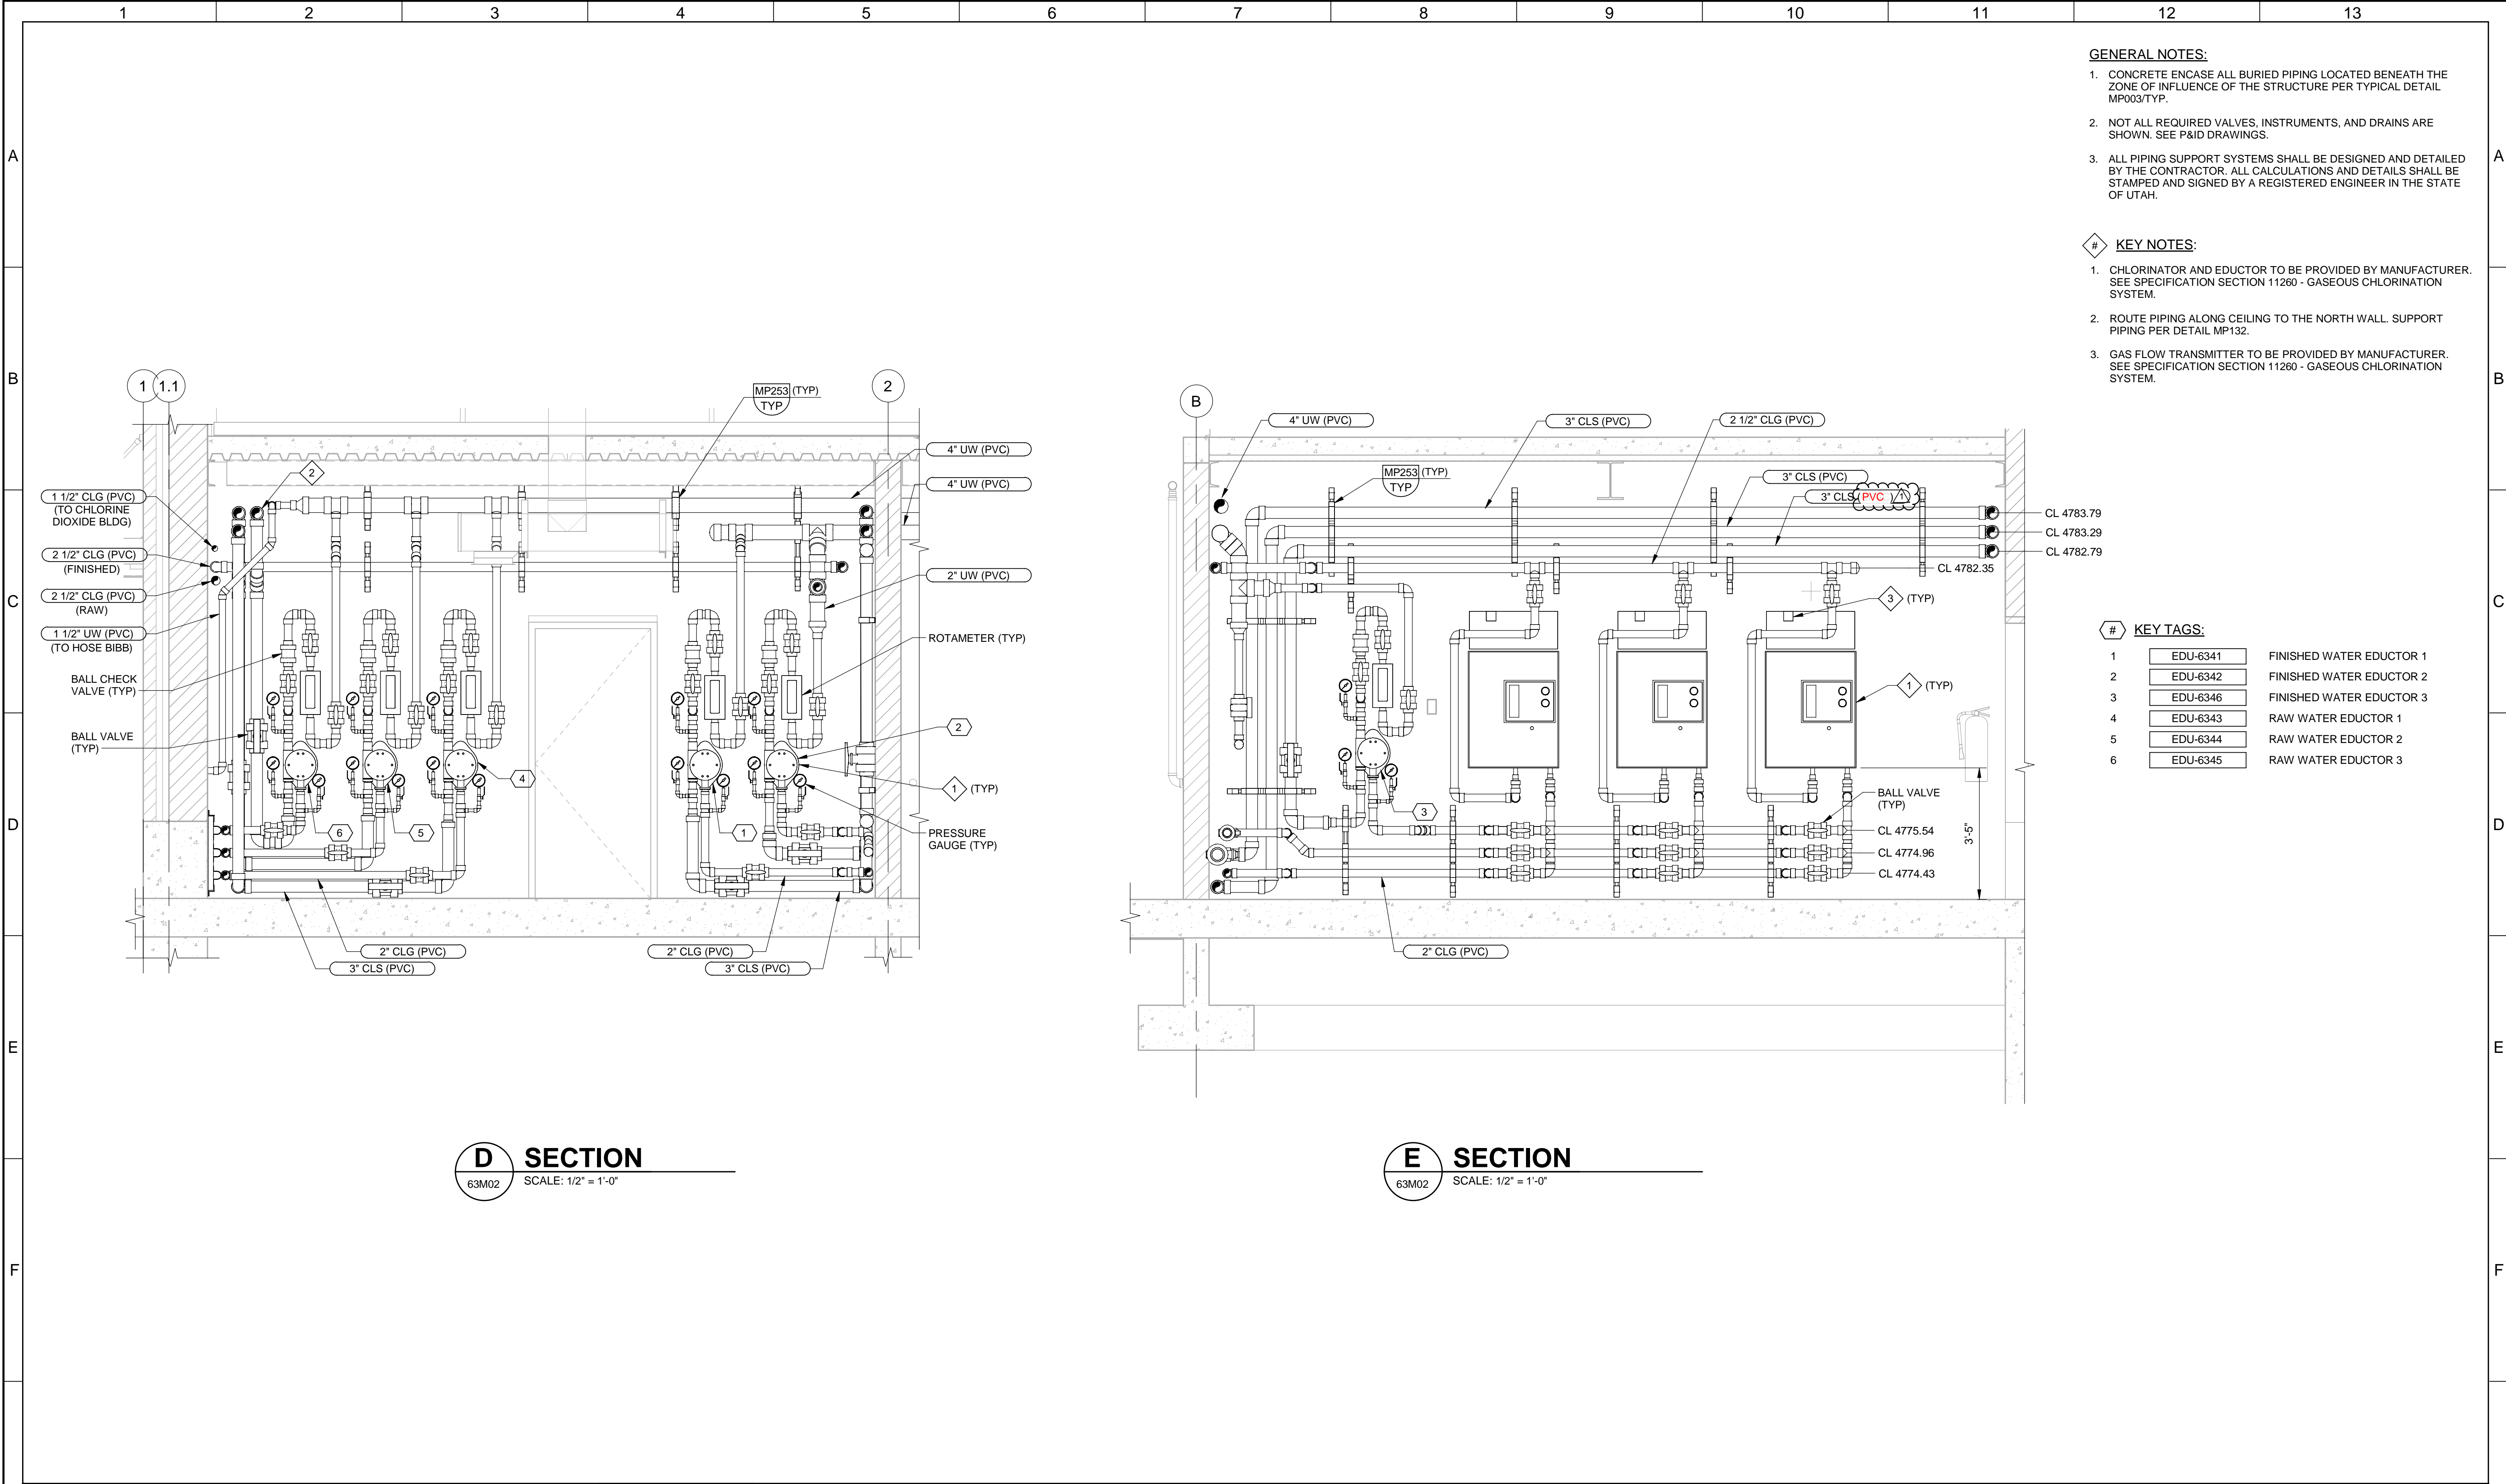

- GENERAL NOTES:**
1. CONCRETE ENCASE ALL BURIED PIPING LOCATED BENEATH THE ZONE OF INFLUENCE OF THE STRUCTURE PER TYPICAL DETAIL MP003/TYP.
 2. NOT ALL REQUIRED VALVES, INSTRUMENTS, AND DRAINS ARE SHOWN. SEE P&ID DRAWINGS.
 3. ALL PIPING SUPPORT SYSTEMS SHALL BE DESIGNED AND DETAILED BY THE CONTRACTOR. ALL CALCULATIONS AND DETAILS SHALL BE STAMPED AND SIGNED BY A REGISTERED ENGINEER IN THE STATE OF UTAH.


- KEY NOTES:**
1. CHLORINATOR AND EDUCTOR TO BE PROVIDED BY MANUFACTURER. SEE SPECIFICATION SECTION 11260 - GASEOUS CHLORINATION SYSTEM.
 2. ROUTE PIPING ALONG CEILING TO THE NORTH WALL. SUPPORT PIPING PER DETAIL MP132.
 3. GAS FLOW TRANSMITTER TO BE PROVIDED BY MANUFACTURER. SEE SPECIFICATION SECTION 11260 - GASEOUS CHLORINATION SYSTEM.

#	KEY TAGS:	
1	EDU-6341	FINISHED WATER EDUCTOR 1
2	EDU-6342	FINISHED WATER EDUCTOR 2
3	EDU-6346	FINISHED WATER EDUCTOR 3
4	EDU-6343	RAW WATER EDUCTOR 1
5	EDU-6344	RAW WATER EDUCTOR 2
6	EDU-6345	RAW WATER EDUCTOR 3

D SECTION
63M02 SCALE: 1/2" = 1'-0"

E SECTION
63M02 SCALE: 1/2" = 1'-0"

BID SET				DESIGNED SSB								JORDAN VALLEY WATER TREATMENT PLANT			VERIFY SCALES	JOB NO. 202001.10
				DRAWN RPW								FILTER AND CHEMICAL FEED UPGRADES			BAR IS ONE INCH ON ORIGINAL DRAWING	DRAWING NO.
				CHECKED ARL											0 1"	63M04
				DATE FEBRUARY 2025											IF NOT ONE INCH ON THIS SHEET, ADJUST SCALES ACCORDINGLY	SHEET NO. OF
REV	DATE	SSB BY	DESCRIPTION													
1																
2																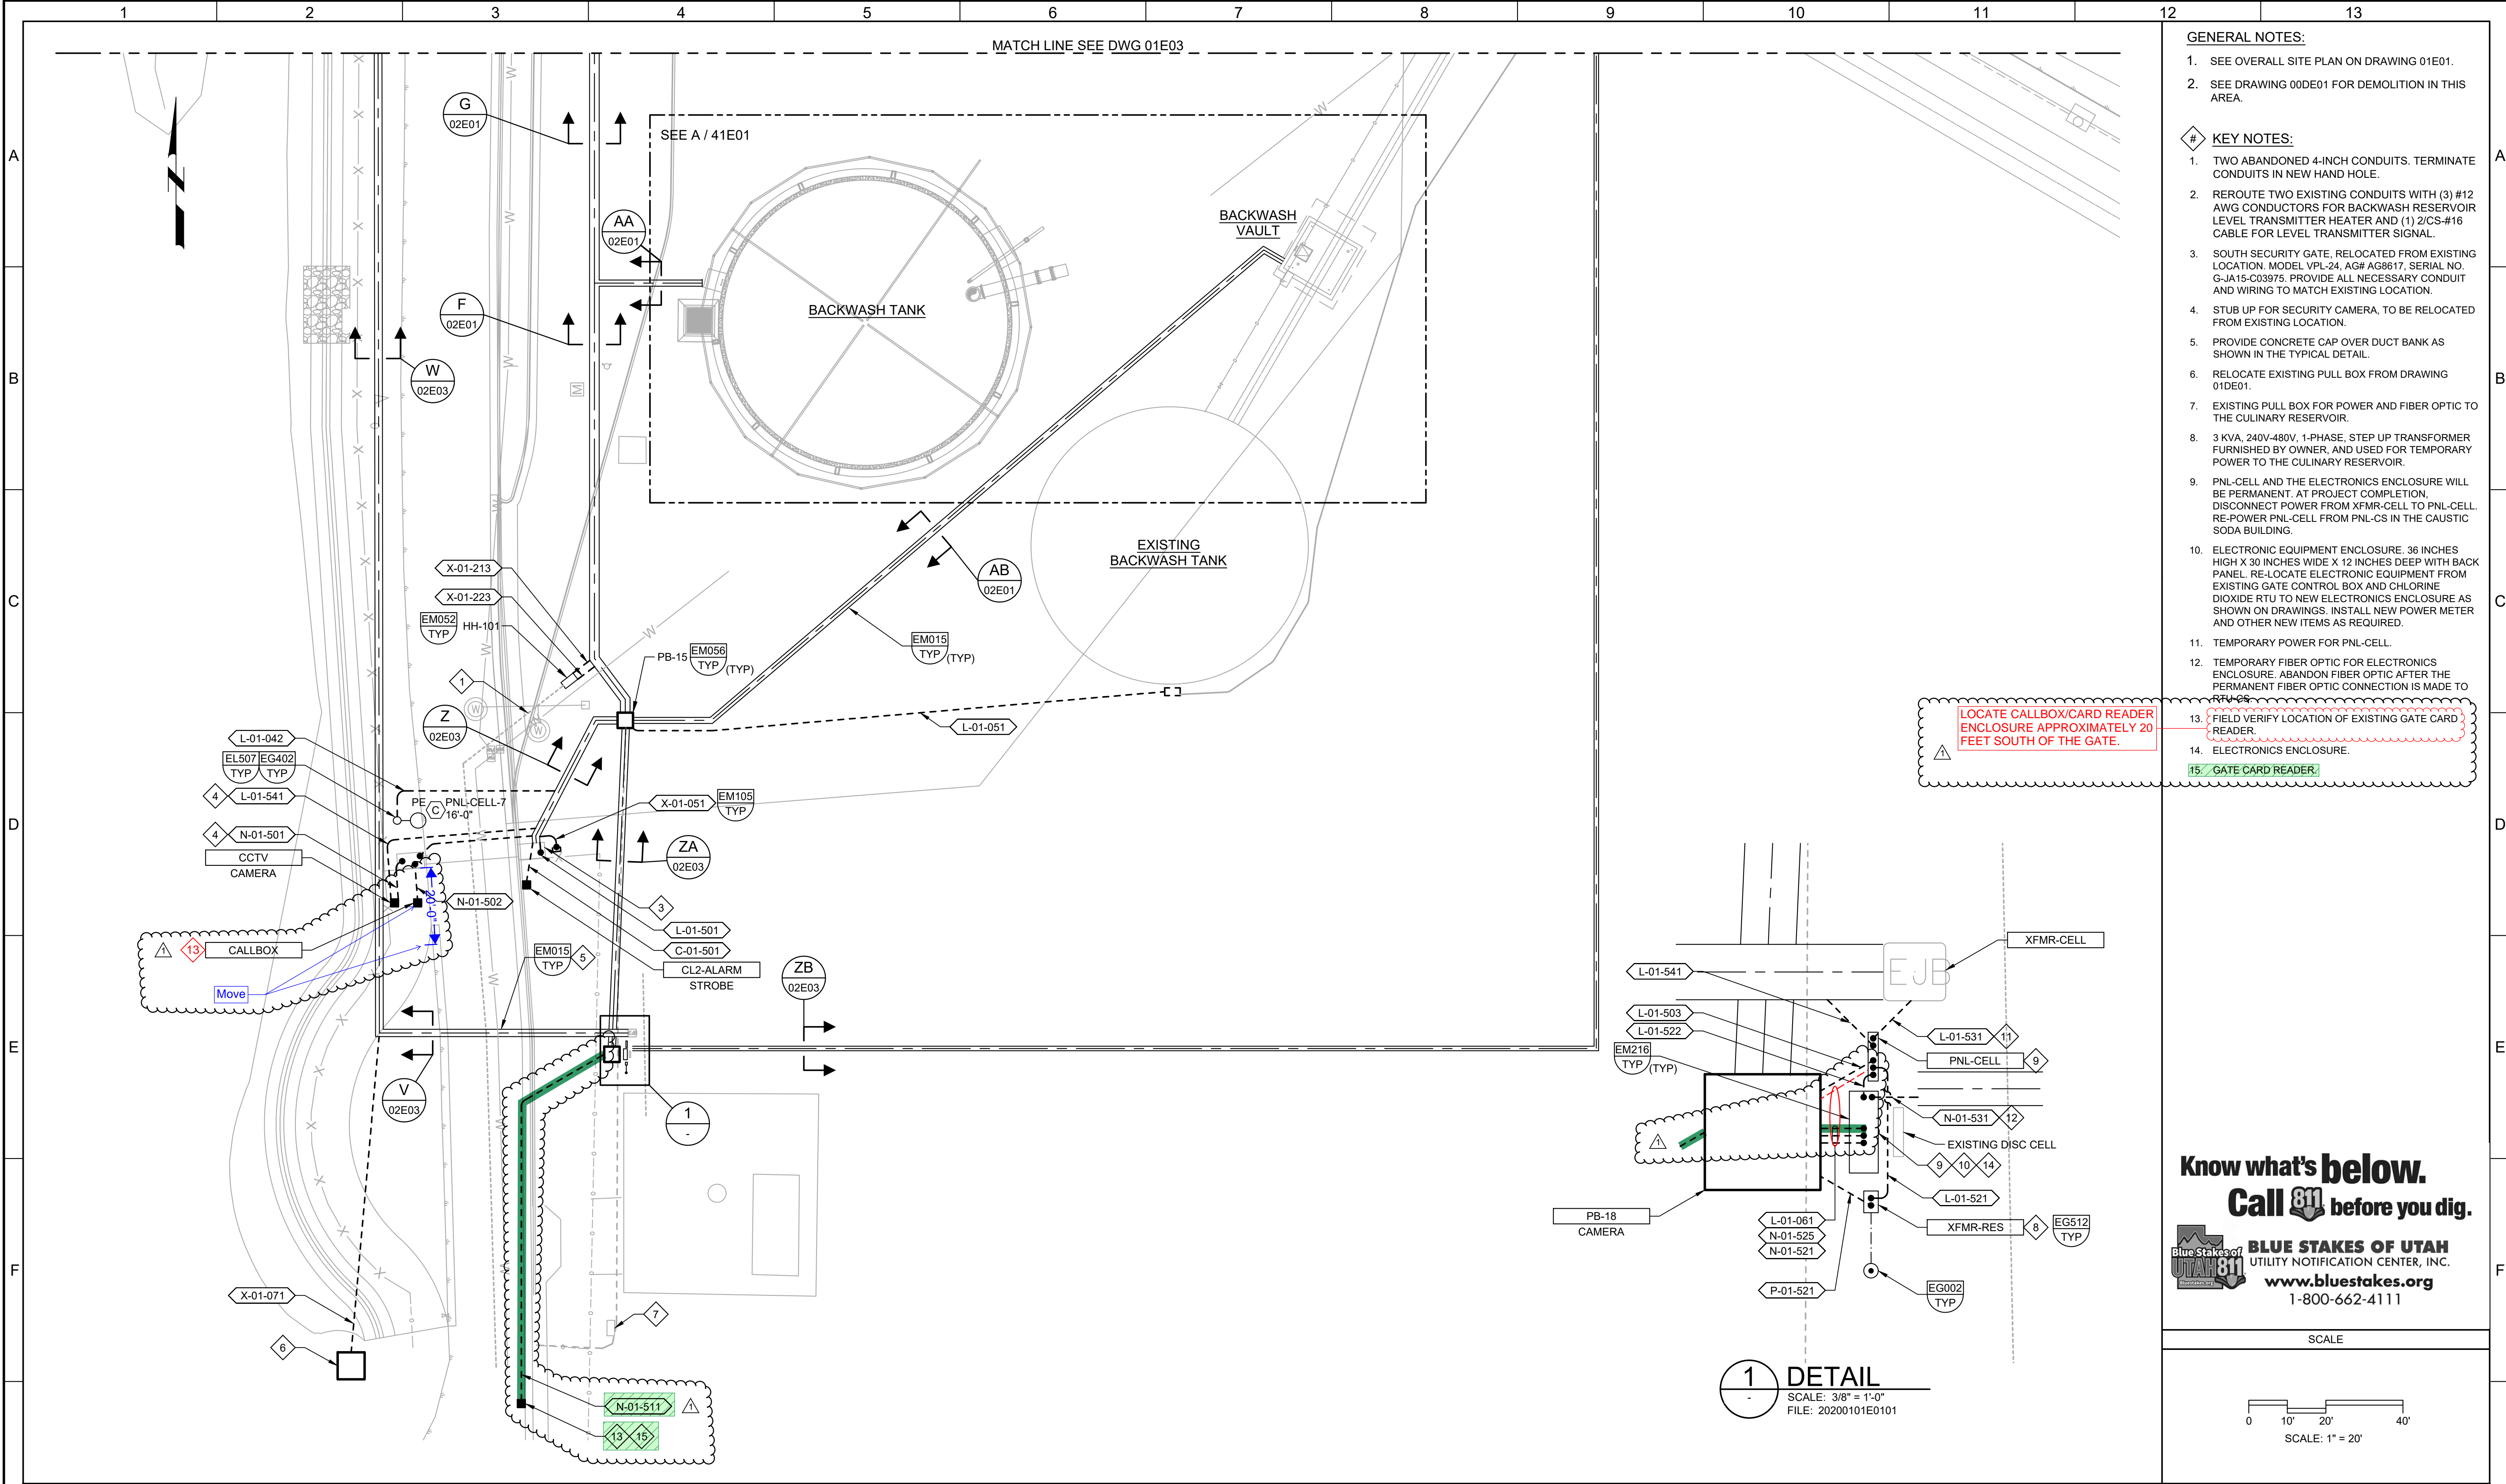
GENERAL NOTES:

1. SEE OVERALL SITE PLAN ON DRAWING 01E01.
2. SEE DRAWING 00DE01 FOR DEMOLITION IN THIS AREA.

KEY NOTES:


1. TWO ABANDONED 4-INCH CONDUITS. TERMINATE CONDUITS IN NEW HAND HOLE.
2. REROUTE TWO EXISTING CONDUITS WITH (3) #12 AWG CONDUCTORS FOR BACKWASH RESERVOIR LEVEL TRANSMITTER HEATER AND (1) 2/CS-#16 CABLE FOR LEVEL TRANSMITTER SIGNAL.
3. SOUTH SECURITY GATE, RELOCATED FROM EXISTING LOCATION. MODEL VPL-24, AG# AG8617, SERIAL NO. G-JA15-C03975. PROVIDE ALL NECESSARY CONDUIT AND WIRING TO MATCH EXISTING LOCATION.
4. STUB UP FOR SECURITY CAMERA, TO BE RELOCATED FROM EXISTING LOCATION.
5. PROVIDE CONCRETE CAP OVER DUCT BANK AS SHOWN IN THE TYPICAL DETAIL.
6. RELOCATE EXISTING PULL BOX FROM DRAWING 01DE01.
7. EXISTING PULL BOX FOR POWER AND FIBER OPTIC TO THE CULINARY RESERVOIR.
8. 3 KVA, 240V-480V, 1-PHASE, STEP UP TRANSFORMER FURNISHED BY OWNER, AND USED FOR TEMPORARY POWER TO THE CULINARY RESERVOIR.
9. PNL-CELL AND THE ELECTRONICS ENCLOSURE WILL BE PERMANENT. AT PROJECT COMPLETION, DISCONNECT POWER FROM XFMR-CELL TO PNL-CELL. RE-POWER PNL-CELL FROM PNL-CS IN THE CAUSTIC SODA BUILDING.
10. ELECTRONIC EQUIPMENT ENCLOSURE. 36 INCHES HIGH X 30 INCHES WIDE X 12 INCHES DEEP WITH BACK PANEL. RE-LOCATE ELECTRONIC EQUIPMENT FROM EXISTING GATE CONTROL BOX AND CHLORINE DIOXIDE RTU TO NEW ELECTRONICS ENCLOSURE AS SHOWN ON DRAWINGS. INSTALL NEW POWER METER AND OTHER NEW ITEMS AS REQUIRED.
11. TEMPORARY POWER FOR PNL-CELL.
12. TEMPORARY FIBER OPTIC FOR ELECTRONICS ENCLOSURE. ABANDON FIBER OPTIC AFTER THE PERMANENT FIBER OPTIC CONNECTION IS MADE TO THE GATE.
13. FIELD VERIFY LOCATION OF EXISTING GATE CARD READER.
14. ELECTRONICS ENCLOSURE.
15. GATE CARD READER.

LOCATE CALLBOX/CARD READER ENCLOSURE APPROXIMATELY 20 FEET SOUTH OF THE GATE.

Know what's below.
Call 811 before you dig.

BLUE STAKES OF UTAH
UTILITY NOTIFICATION CENTER, INC.
www.bluestakes.org
1-800-662-4111

SCALE

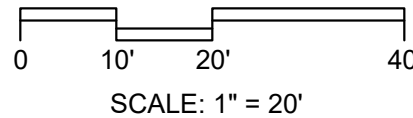


1 DETAIL

SCALE: 3/8" = 1'-0"
FILE: 20200101E0101

BID SET

DESIGNED
SKB
DRAWN
NKK
CHECKED
GCE
DATE
FEBRUARY 2025

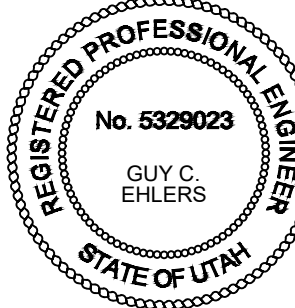

carollo



JORDAN VALLEY WATER TREATMENT PLANT

FILTER AND CHEMICAL FEED UPGRADES

ELECTRICAL


ENLARGED SITE PLAN 1

VERIFY SCALES

BAR IS ONE INCH ON ORIGINAL DRAWING
0 1"
IF NOT ONE INCH ON THIS SHEET, ADJUST SCALES ACCORDINGLY

JOB NO.
202001.10
DRAWING NO.
01E02
SHEET NO.
OF

LAST SAVED BY: NKKilian

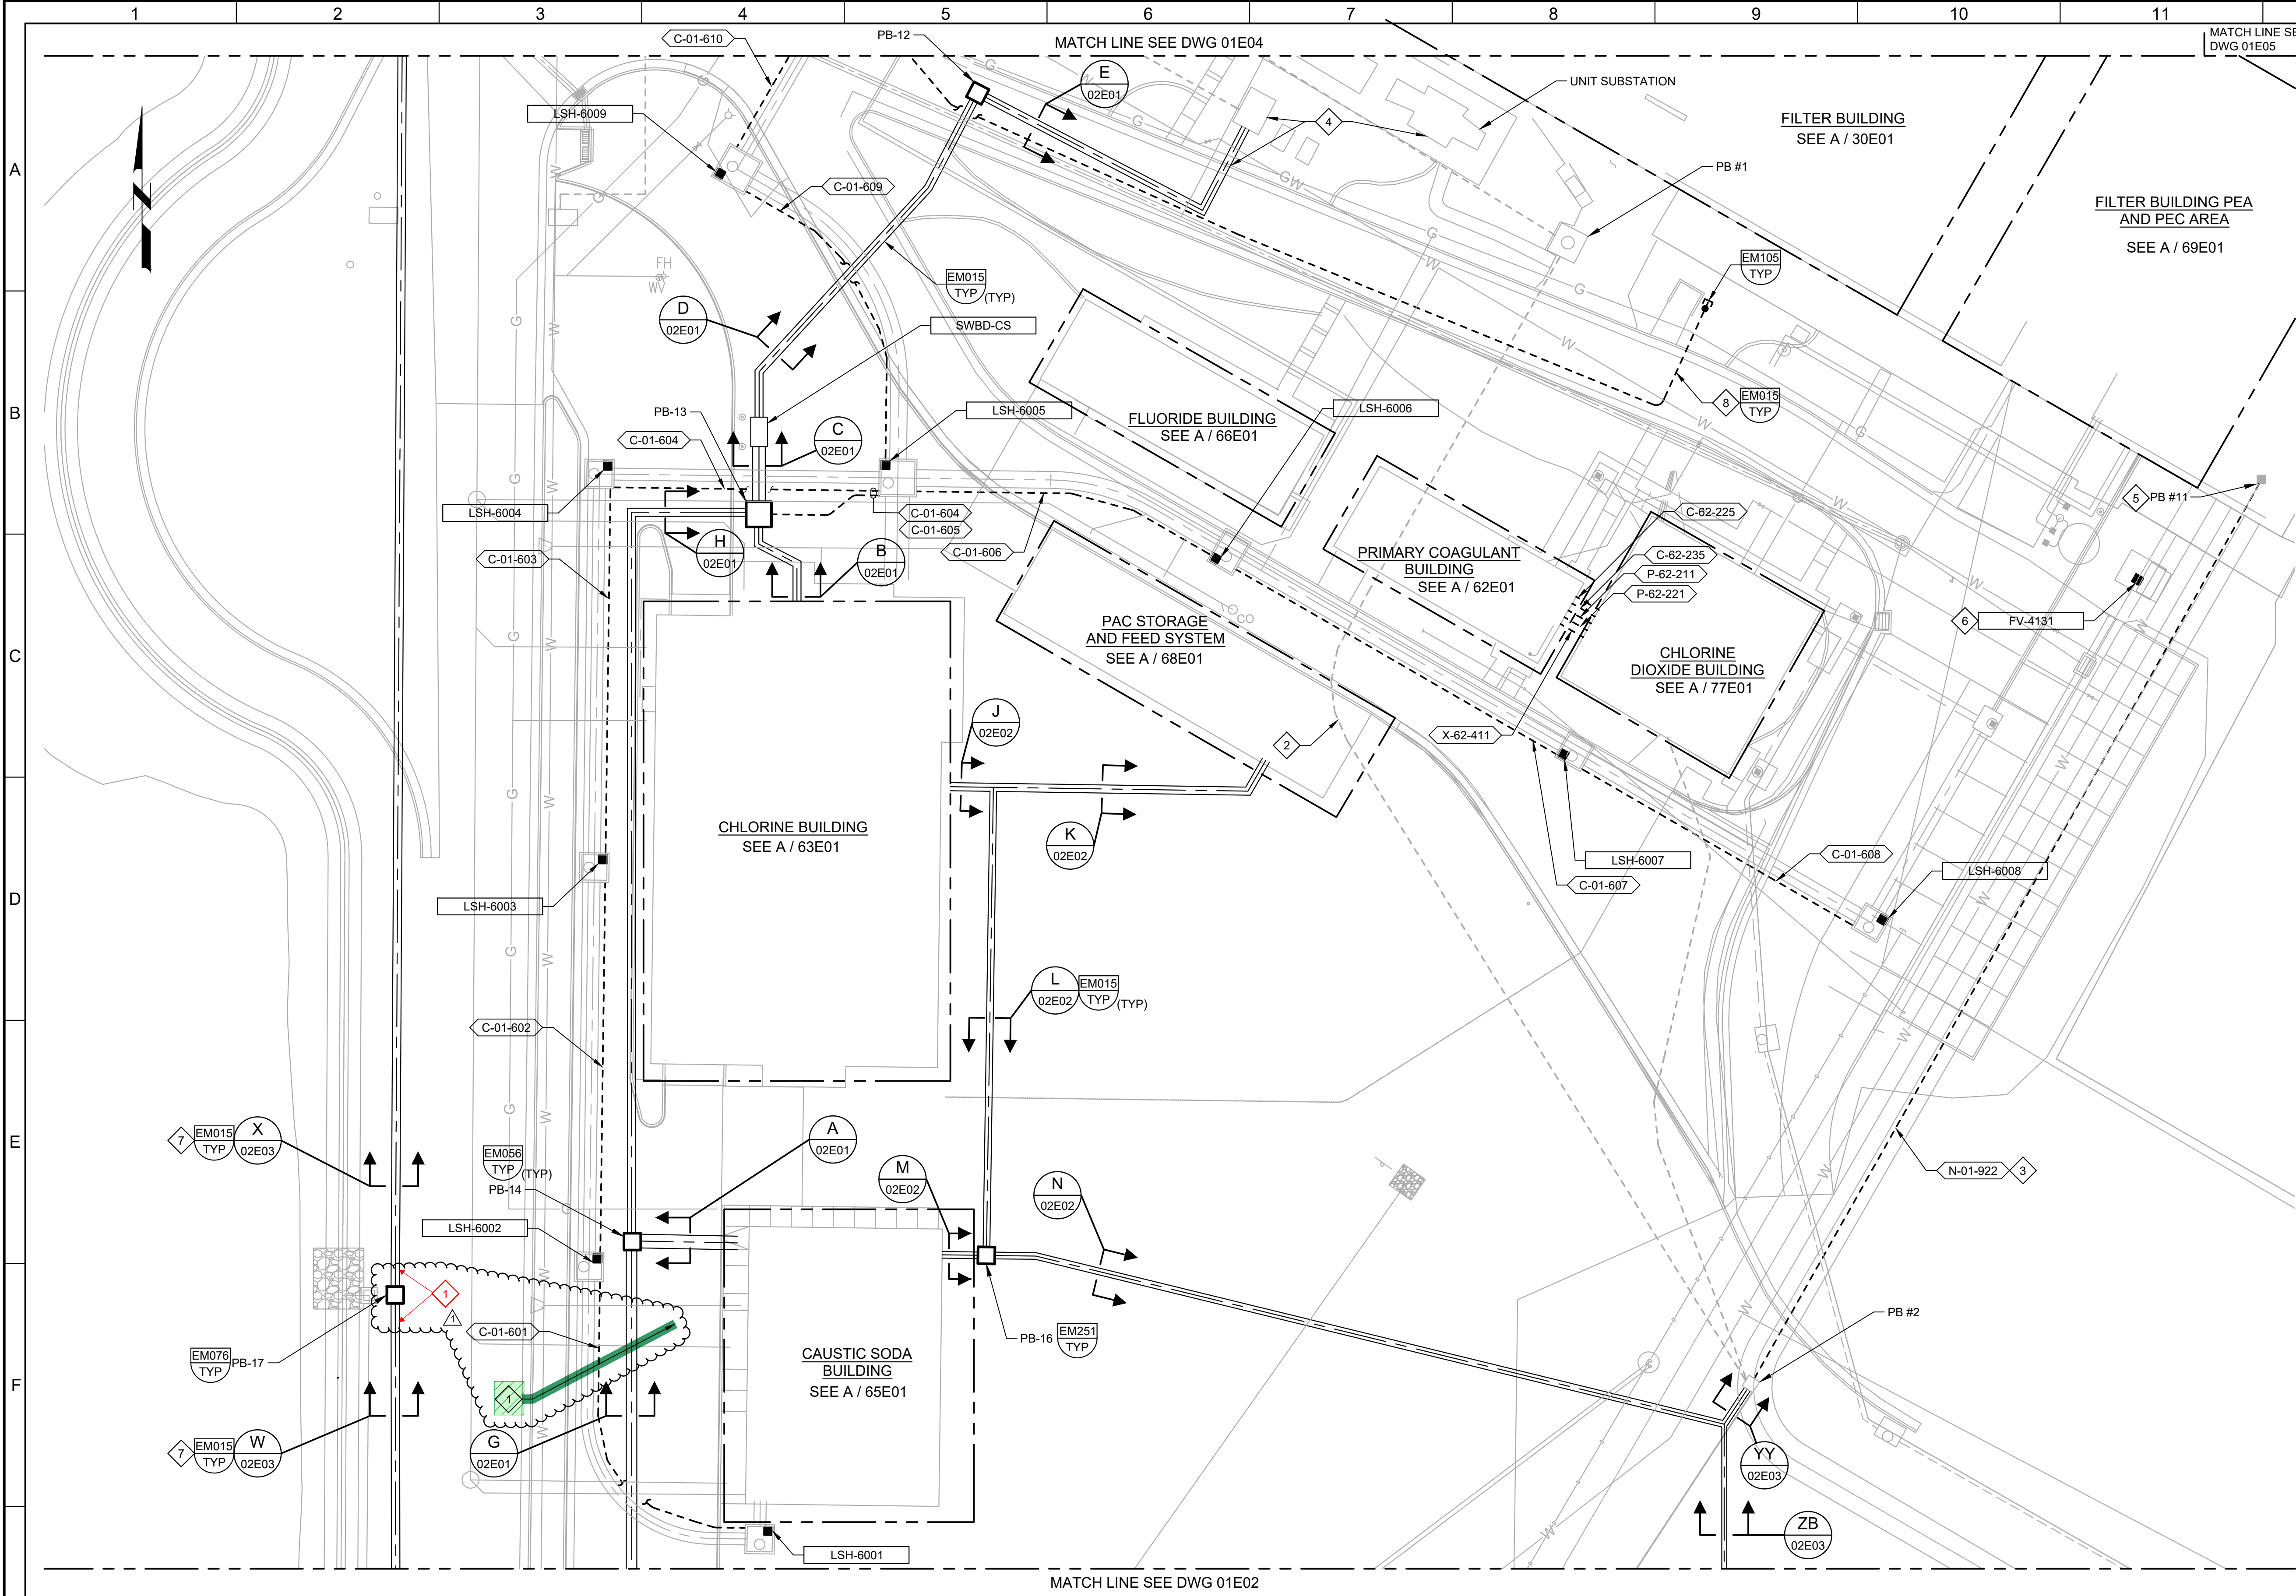

- GENERAL NOTES:**
- SEE OVERALL SITE PLAN ON DRAWING 01E01.
 - SEE DRAWING 00DE02 FOR DEMOLITION IN THIS AREA.
 - PROVIDE 120VAC, 1 POLE INSTRUMENT DISCONNECT PER DETAIL NA900/TYP FOR ALL 4-WIRE INSTRUMENTS.
- KEY NOTES:**
- XFMR CELL

1. REROUTE EXISTING 12.47KV SINGLE PHASE CIRCUIT BETWEEN HANDHOLE AND SECTIONALIZER 4 FOR THE CELL TOWER. REFER TO ONE-LINE DIAGRAM ON DRAWING 03E02 FOR CABLE SIZE. SPLICE IN HANDHOLE AND PROVIDE NEW CABLES TO MATCH EXISTING CABLES.

2. PROTECT EXISTING DUCT BANK IN PLACE BELOW THE NEW PAC AREA.

3. USE EXISTING SPARE CONDUIT TO ROUTE FIBER OPTIC WIRING THROUGH EXISTING DUCT BANK FROM PB #2 TO PB #11.

4. USE EXISTING VAULT BELOW THE TRANSFORMER TO ROUTE NEW 480V CIRCUIT FROM UNIT SUBSTATION TO NEW SWBD-CS THROUGH TWO EXISTING CONDUITS AND NEW DUCT BANK.

5. SEE DRAWING 30E10 FOR CONTINUATION.


6. RECONNECT NEW VALVE ACTUATOR TO EXISTING POWER AND I/O CONDUCTORS.

7. PROVIDE CONCRETE CAP OVER DUCT BANK AS SHOWN IN THE TYPICAL DETAIL.


8. INSTALL 5-INCH PVC CONDUIT. USE EXISTING SPARE CONDUIT IN EXISTING DUCT BANK.

Know what's below.
Call 811 before you dig.

BLUE STAKES OF UTAH
UTILITY NOTIFICATION CENTER, INC.
www.bluestakes.org
1-800-662-4111

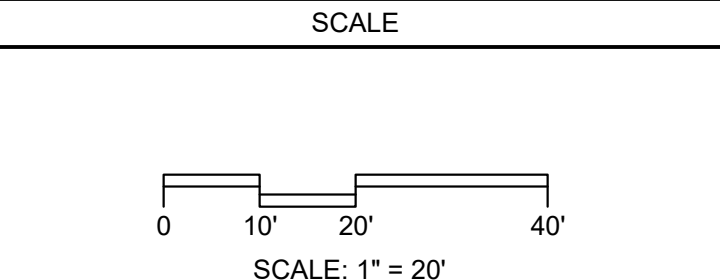

LAST SAVED BY: NKilian		DESIGNED SKB					JORDAN VALLEY WATER TREATMENT PLANT		VERIFY SCALES	JOB NO. 202001.10
DRAWN NKK		CHECKED GCE	FILTER AND CHEMICAL FEED UPGRADES				BAR IS ONE INCH ON ORIGINAL DRAWING	DRAWING NO. 01E03		
DATE 04/15/2025		BY SKB	ELECTRICAL				0 1"	SHEET NO. OF		
ADDENDUM NO. 1		DATE FEBRUARY 2025		ENLARGED SITE PLAN 3						
PROJECT NO.		FILE NAME: 20200101E03.dwg								

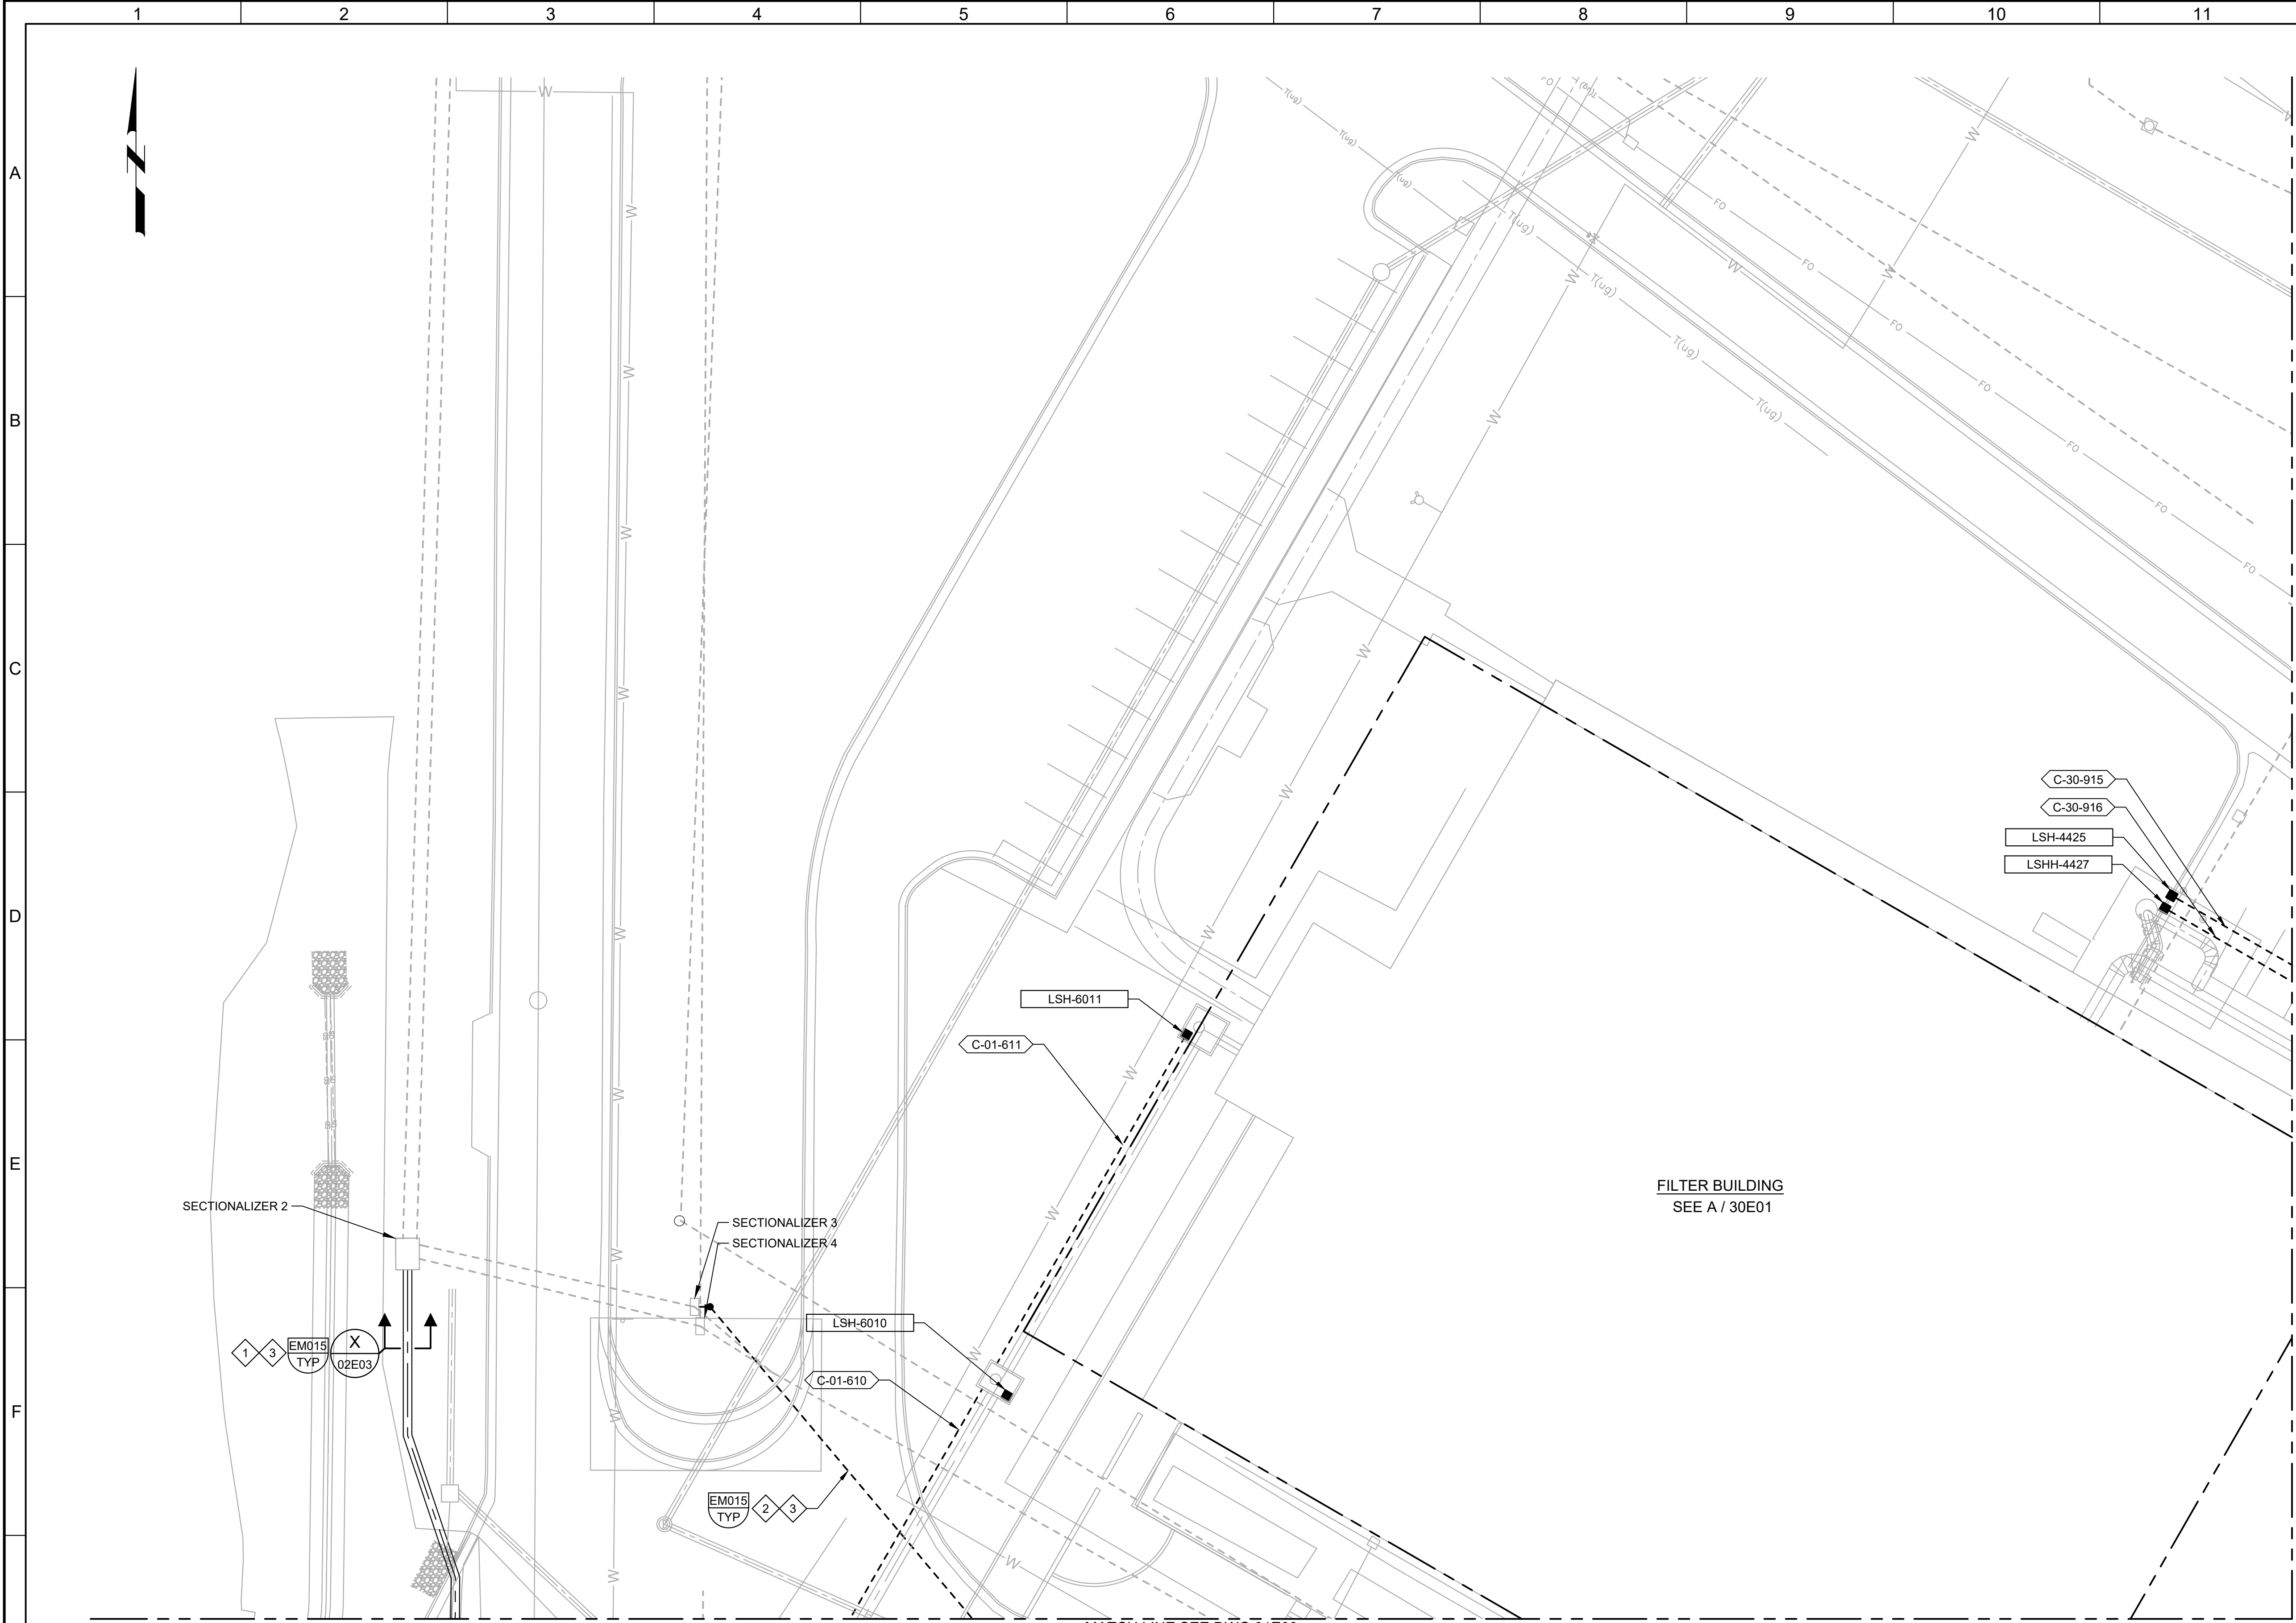


GENERAL NOTES:

- SEE OVERALL SITE PLAN ON DRAWING 01E01.
- SEE DRAWING 00DE03 FOR DEMOLITION IN THIS AREA.
- PROVIDE 120VAC, 1 POLE INSTRUMENT DISCONNECT PER DETAIL NA900/TYP FOR ALL 4-WIRE INSTRUMENTS.

KEY NOTES:


- REROUTE EXISTING 12.47KV SINGLE PHASE CIRCUIT BETWEEN HANDHOLE AND SECTIONALIZER 4 FOR THE CELL TOWER. REFER TO ONE-LINE DIAGRAM ON DRAWING 03E02 FOR CABLE SIZE. **SPlice IN HANDHOLE AND** PROVIDE NEW CABLES TO MATCH EXISTING CABLES.
- INSTALL 5-INCH PVC CONDUIT.
- PROVIDE CONCRETE CAP OVER DUCT BANK AS SHOWN IN THE TYPICAL DETAIL.

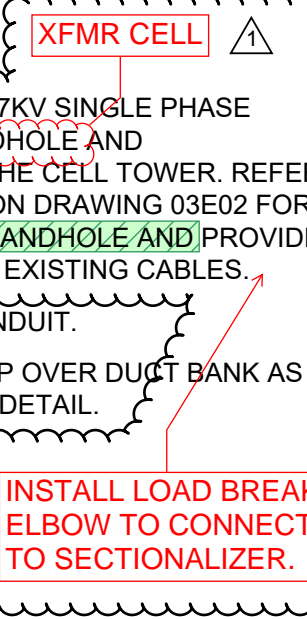

Know what's below.
Call 811 before you dig.


BLUE STAKES OF UTAH
UTILITY NOTIFICATION CENTER, INC.
www.bluestakes.org
1-800-662-4111

SCALE

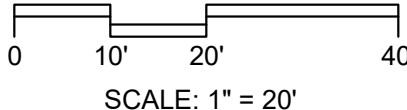

BID SET			
REV	DATE	SKB BY	DESCRIPTION
1	04/15/2025	SKB	ADDENDUM NO. 1


DESIGNED
SKB
DRAWN
NKK
CHECKED
GCE
DATE
FEBRUARY 2025

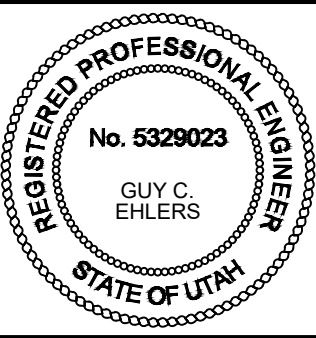

JORDAN VALLEY WATER TREATMENT PLANT
FILTER AND CHEMICAL FEED UPGRADES
ELECTRICAL
ENLARGED SITE PLAN 4

VERIFY SCALES
BAR IS ONE INCH ON ORIGINAL DRAWING
0 1"
IF NOT ONE INCH ON THIS SHEET, ADJUST SCALES ACCORDINGLY

JOB NO.
202001.10
DRAWING NO.
01E04
SHEET NO.
OF

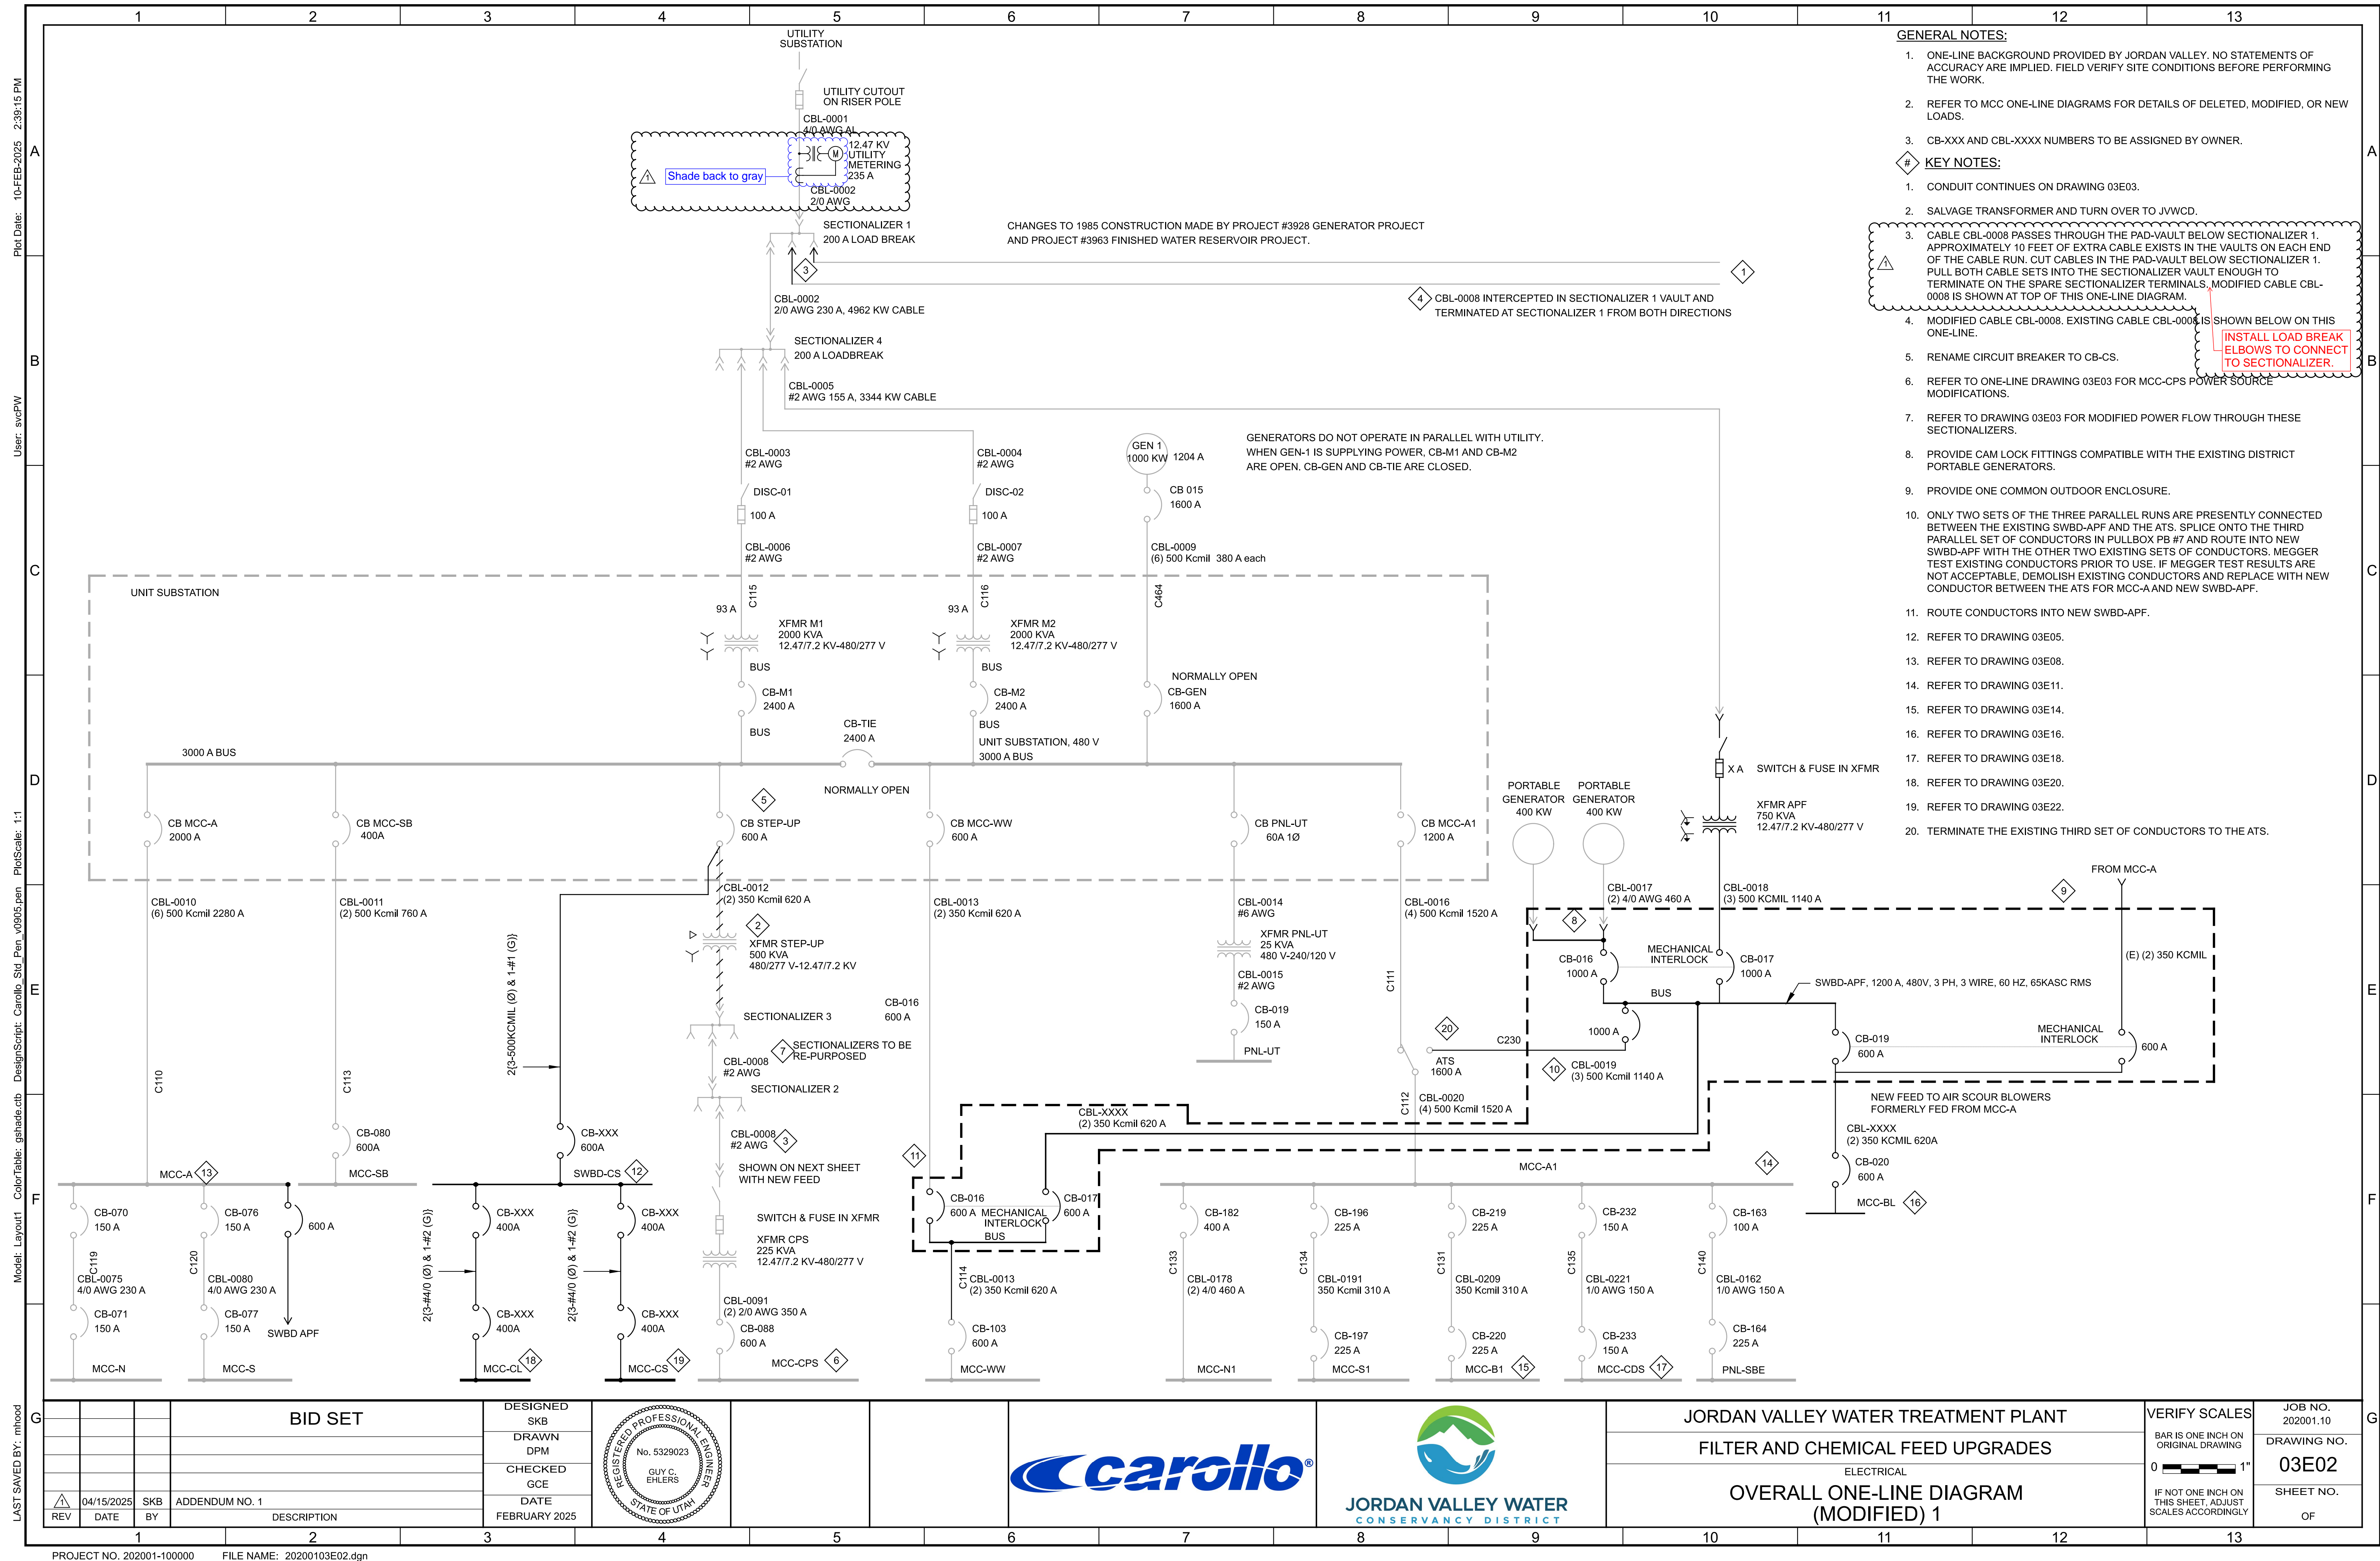


Plot Date: 10-FEB-2025 2:38:33 PM

User: svcPW


Model: Layout1 ColorTable: gshade.ctb DesignScript: Carollo Std_Pen_v0905.pen PlotScale: 1:1

LAST SAVED BY: jtblriones

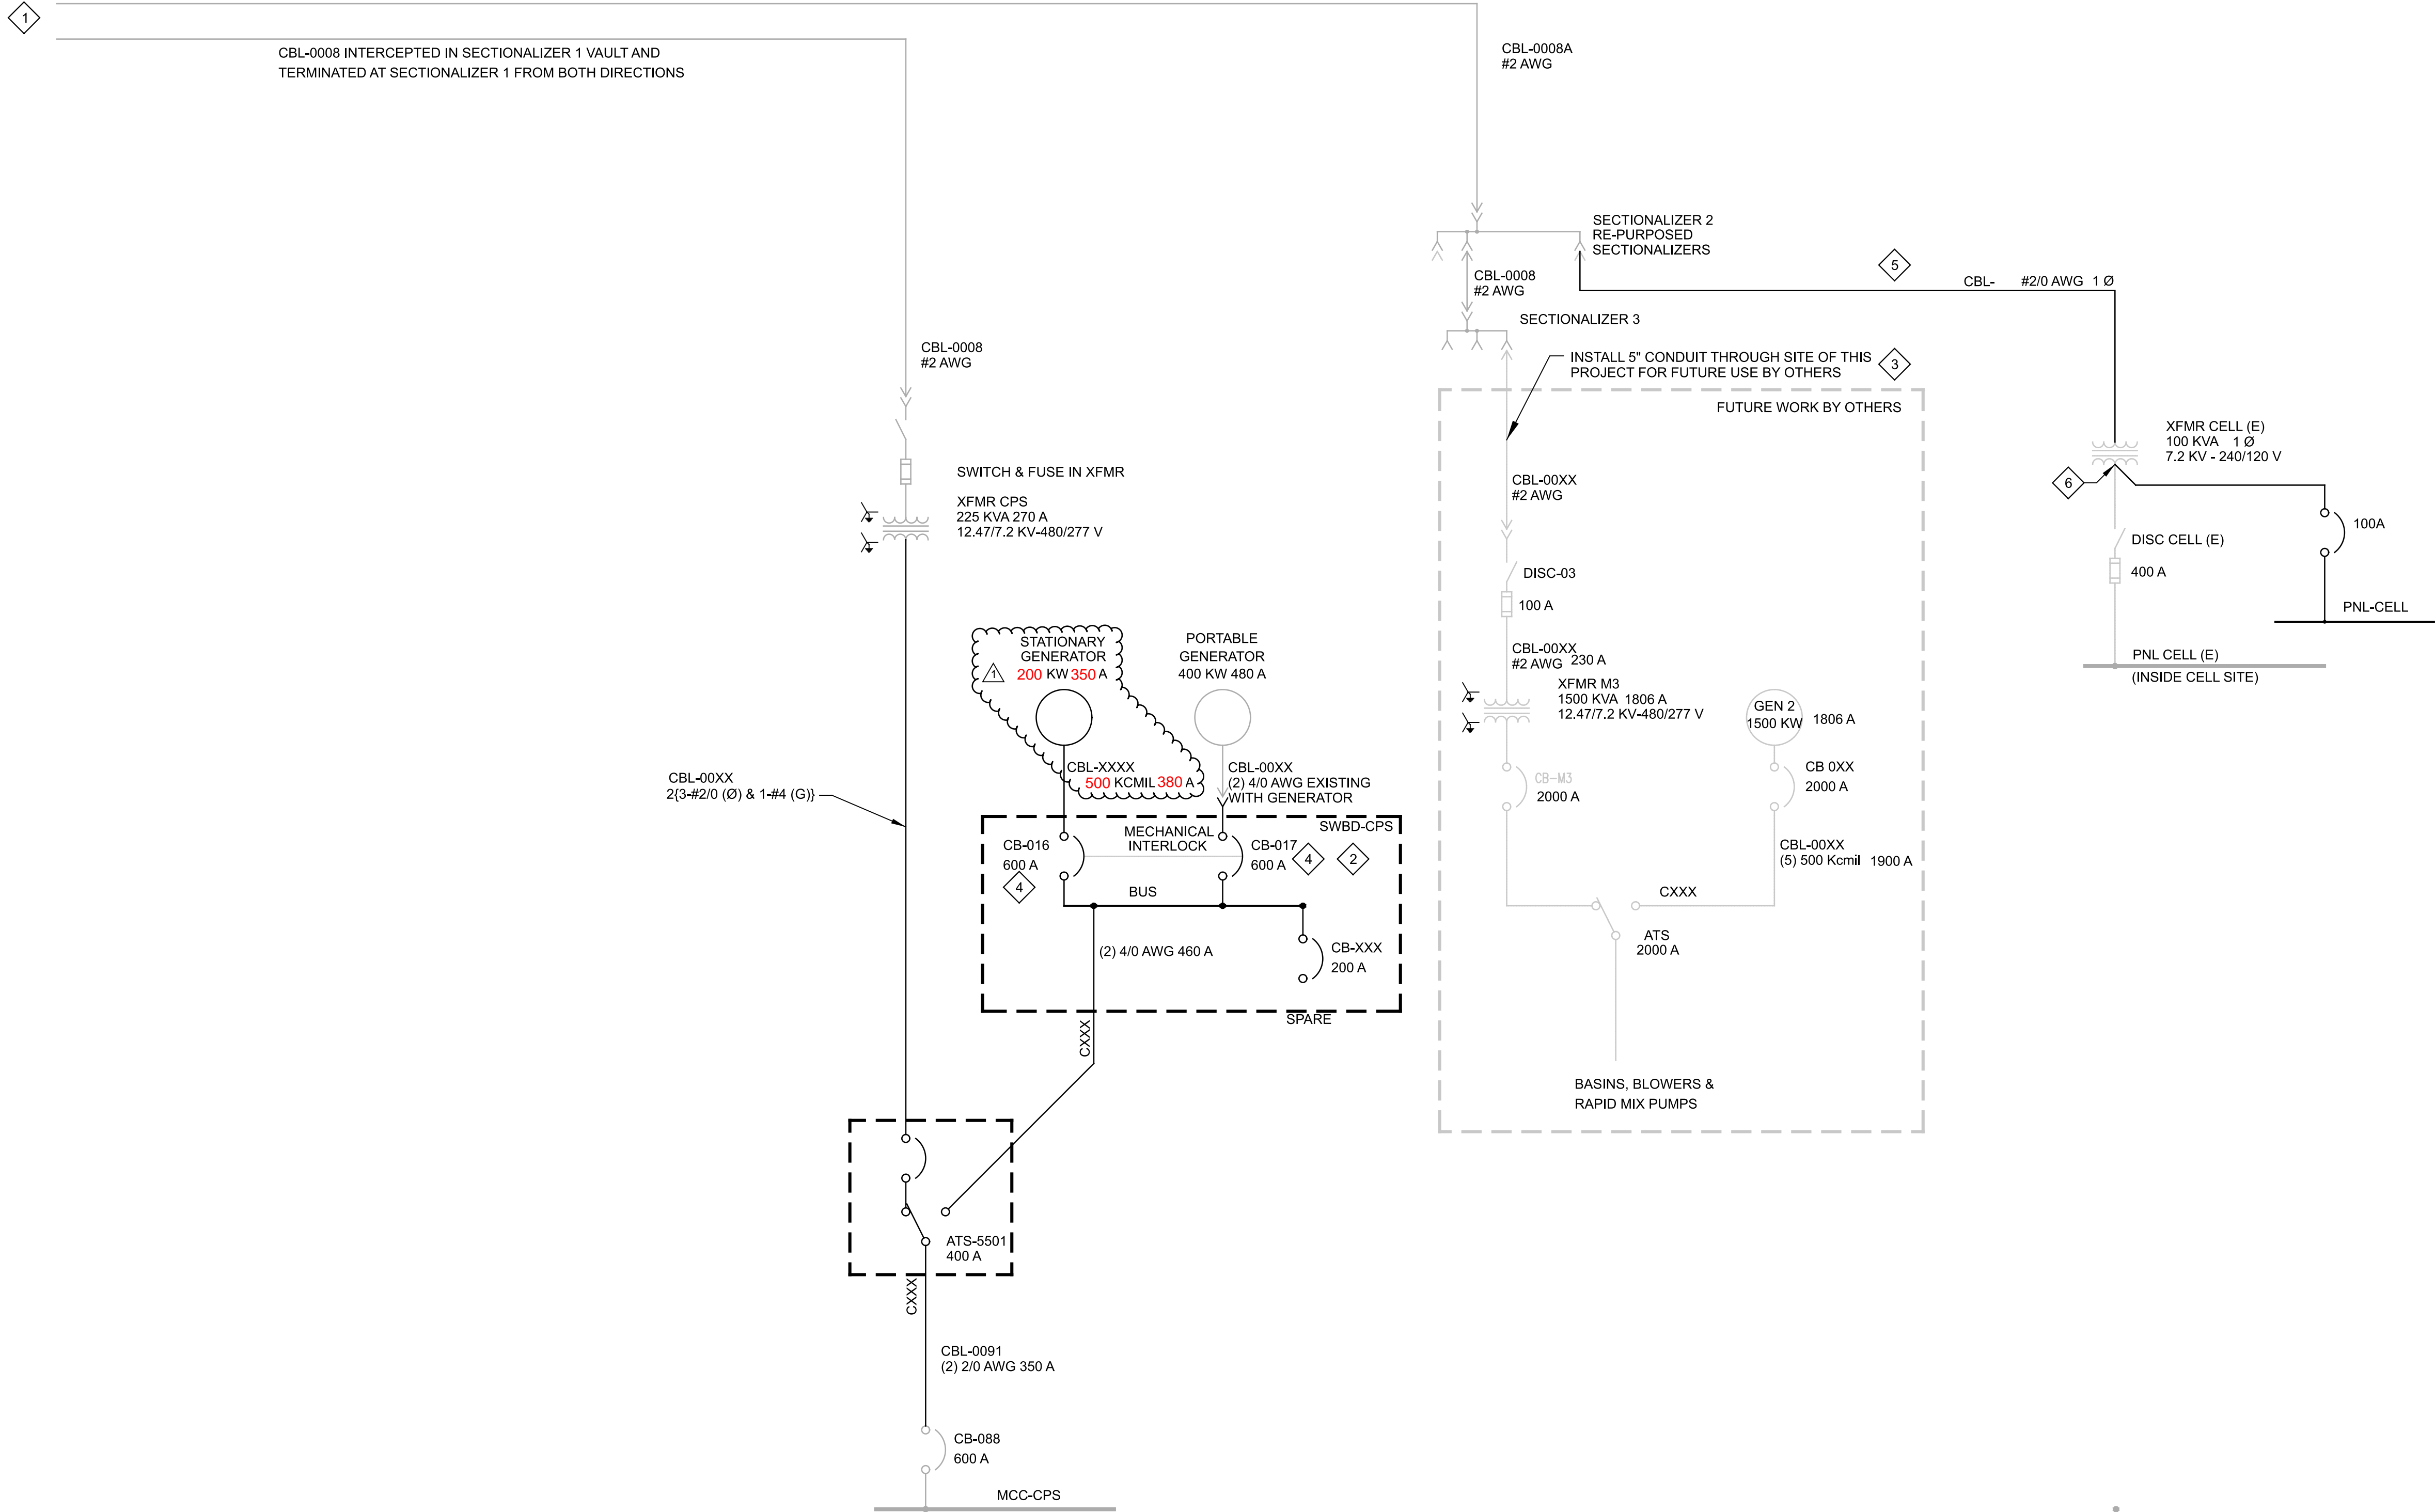

- GENERAL NOTES:**
- ONE-LINE BACKGROUND PROVIDED BY JORDAN VALLEY. NO STATEMENTS OF ACCURACY ARE IMPLIED. FIELD VERIFY SITE CONDITIONS BEFORE PERFORMING THE WORK.
 - CB-XXX AND CBL-XXXX NUMBERS TO BE ASSIGNED BY OWNER.
- KEY NOTES:**
- CONDUIT CONTINUES ON DRAWING 03E02.
 - EXISTING SWITCHBOARD FORMERLY IDENTIFIED AS "SWBD-APF" FOR THE ALTERNATE PLANT FEED TO BE RELOCATED TO THE CULINARY PUMP STATION AND RELABELED AS SWBD-CPS. REFER TO DRAWING 01E06.
 - INSTALL NEW 5-INCH CONDUIT AS SHOWN ON DRAWINGS 01E03 AND 01E04.
 - UPDATE EXISTING BREAKER TO 350A TRIP.
 - REROUTE EXISTING CIRCUIT AS SHOWN ON THE SITE PLAN DRAWINGS.
 - TAP OFF OF SECONDARY SIDE OF TRANSFORMER FOR TEMPORARY POWER TO NEW PANELBOARD PNL-CELL.


BID SET			
DESIGNED	SKB		
DRAWN	DPM		
CHECKED	GCE		
DATE	FEBRUARY 2025		
REV	04/15/2025	SKB	ADDENDUM NO. 1
DATE		BY	DESCRIPTION

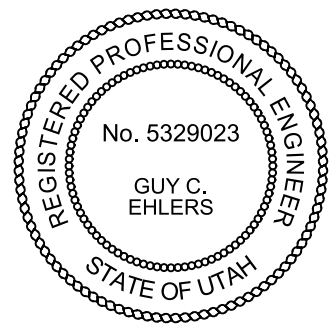


JORDAN VALLEY WATER TREATMENT PLANT	
FILTER AND CHEMICAL FEED UPGRADES	
ELECTRICAL	
OVERALL ONE-LINE DIAGRAM (MODIFIED) 2	


VERIFY SCALES	JOB NO. 202001.10
BAR IS ONE INCH ON ORIGINAL DRAWING	DRAWING NO. 03E03
IF NOT ONE INCH ON THIS SHEET, ADJUST SCALES ACCORDINGLY	SHEET NO. OF

Plot Date: 10-FEB-2025 2:35:47 PM
User: svcPW
Model: Layout1 ColorTable: gshade.ctb DesignScript: Carollo Std_Pen_v0905.pen PlotScale: 1:1
LAST SAVED BY: Crollins

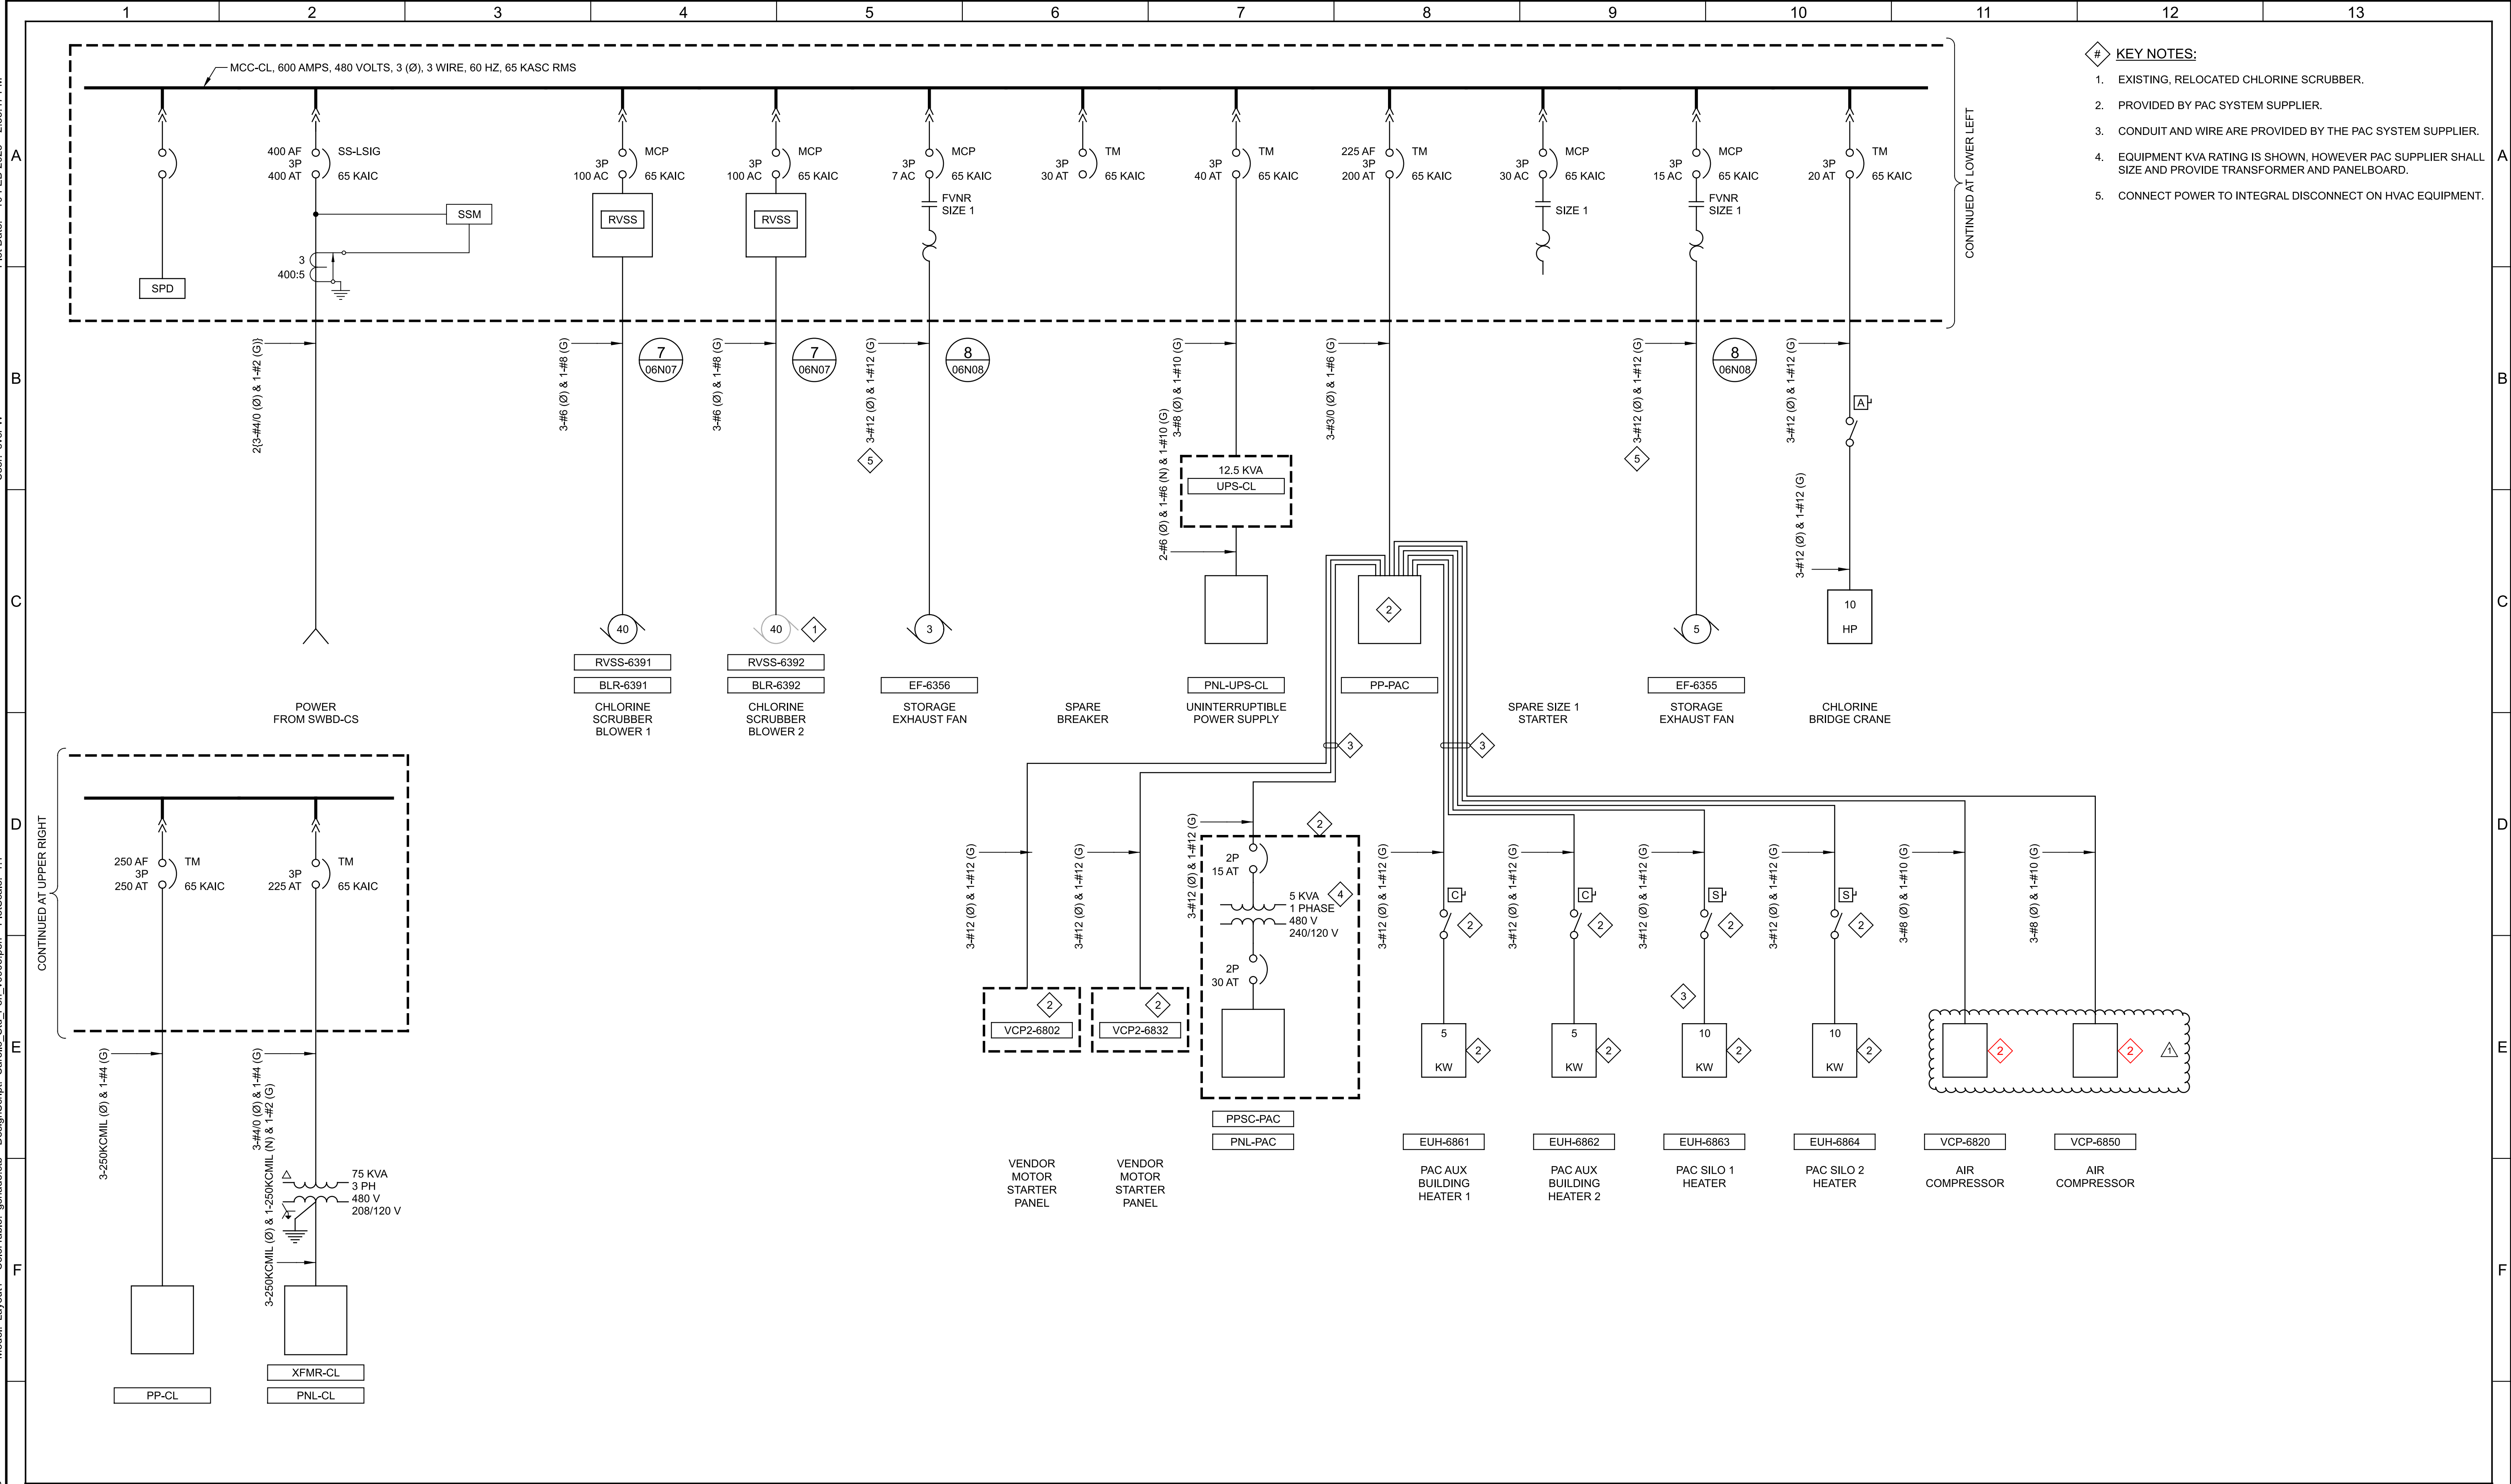

G				BID SET		DESIGNED SKB					JORDAN VALLEY WATER TREATMENT PLANT		VERIFY SCALES	JOB NO. 202001.10	G
					DRAWN NCS	FILTER AND CHEMICAL FEED UPGRADES					BAR IS ONE INCH ON ORIGINAL DRAWING	DRAWING NO.			
					CHECKED GCE	ELECTRICAL					0 1"	03E20			
					DATE FEBRUARY 2025	MCC-CL ONE-LINE DIAGRAM					IF NOT ONE INCH ON THIS SHEET, ADJUST SCALES ACCORDINGLY	SHEET NO.			
												OF			
		04/15/2025	SKB	ADDENDUM NO. 1	DESCRIPTION										
	REV	DATE	BY												

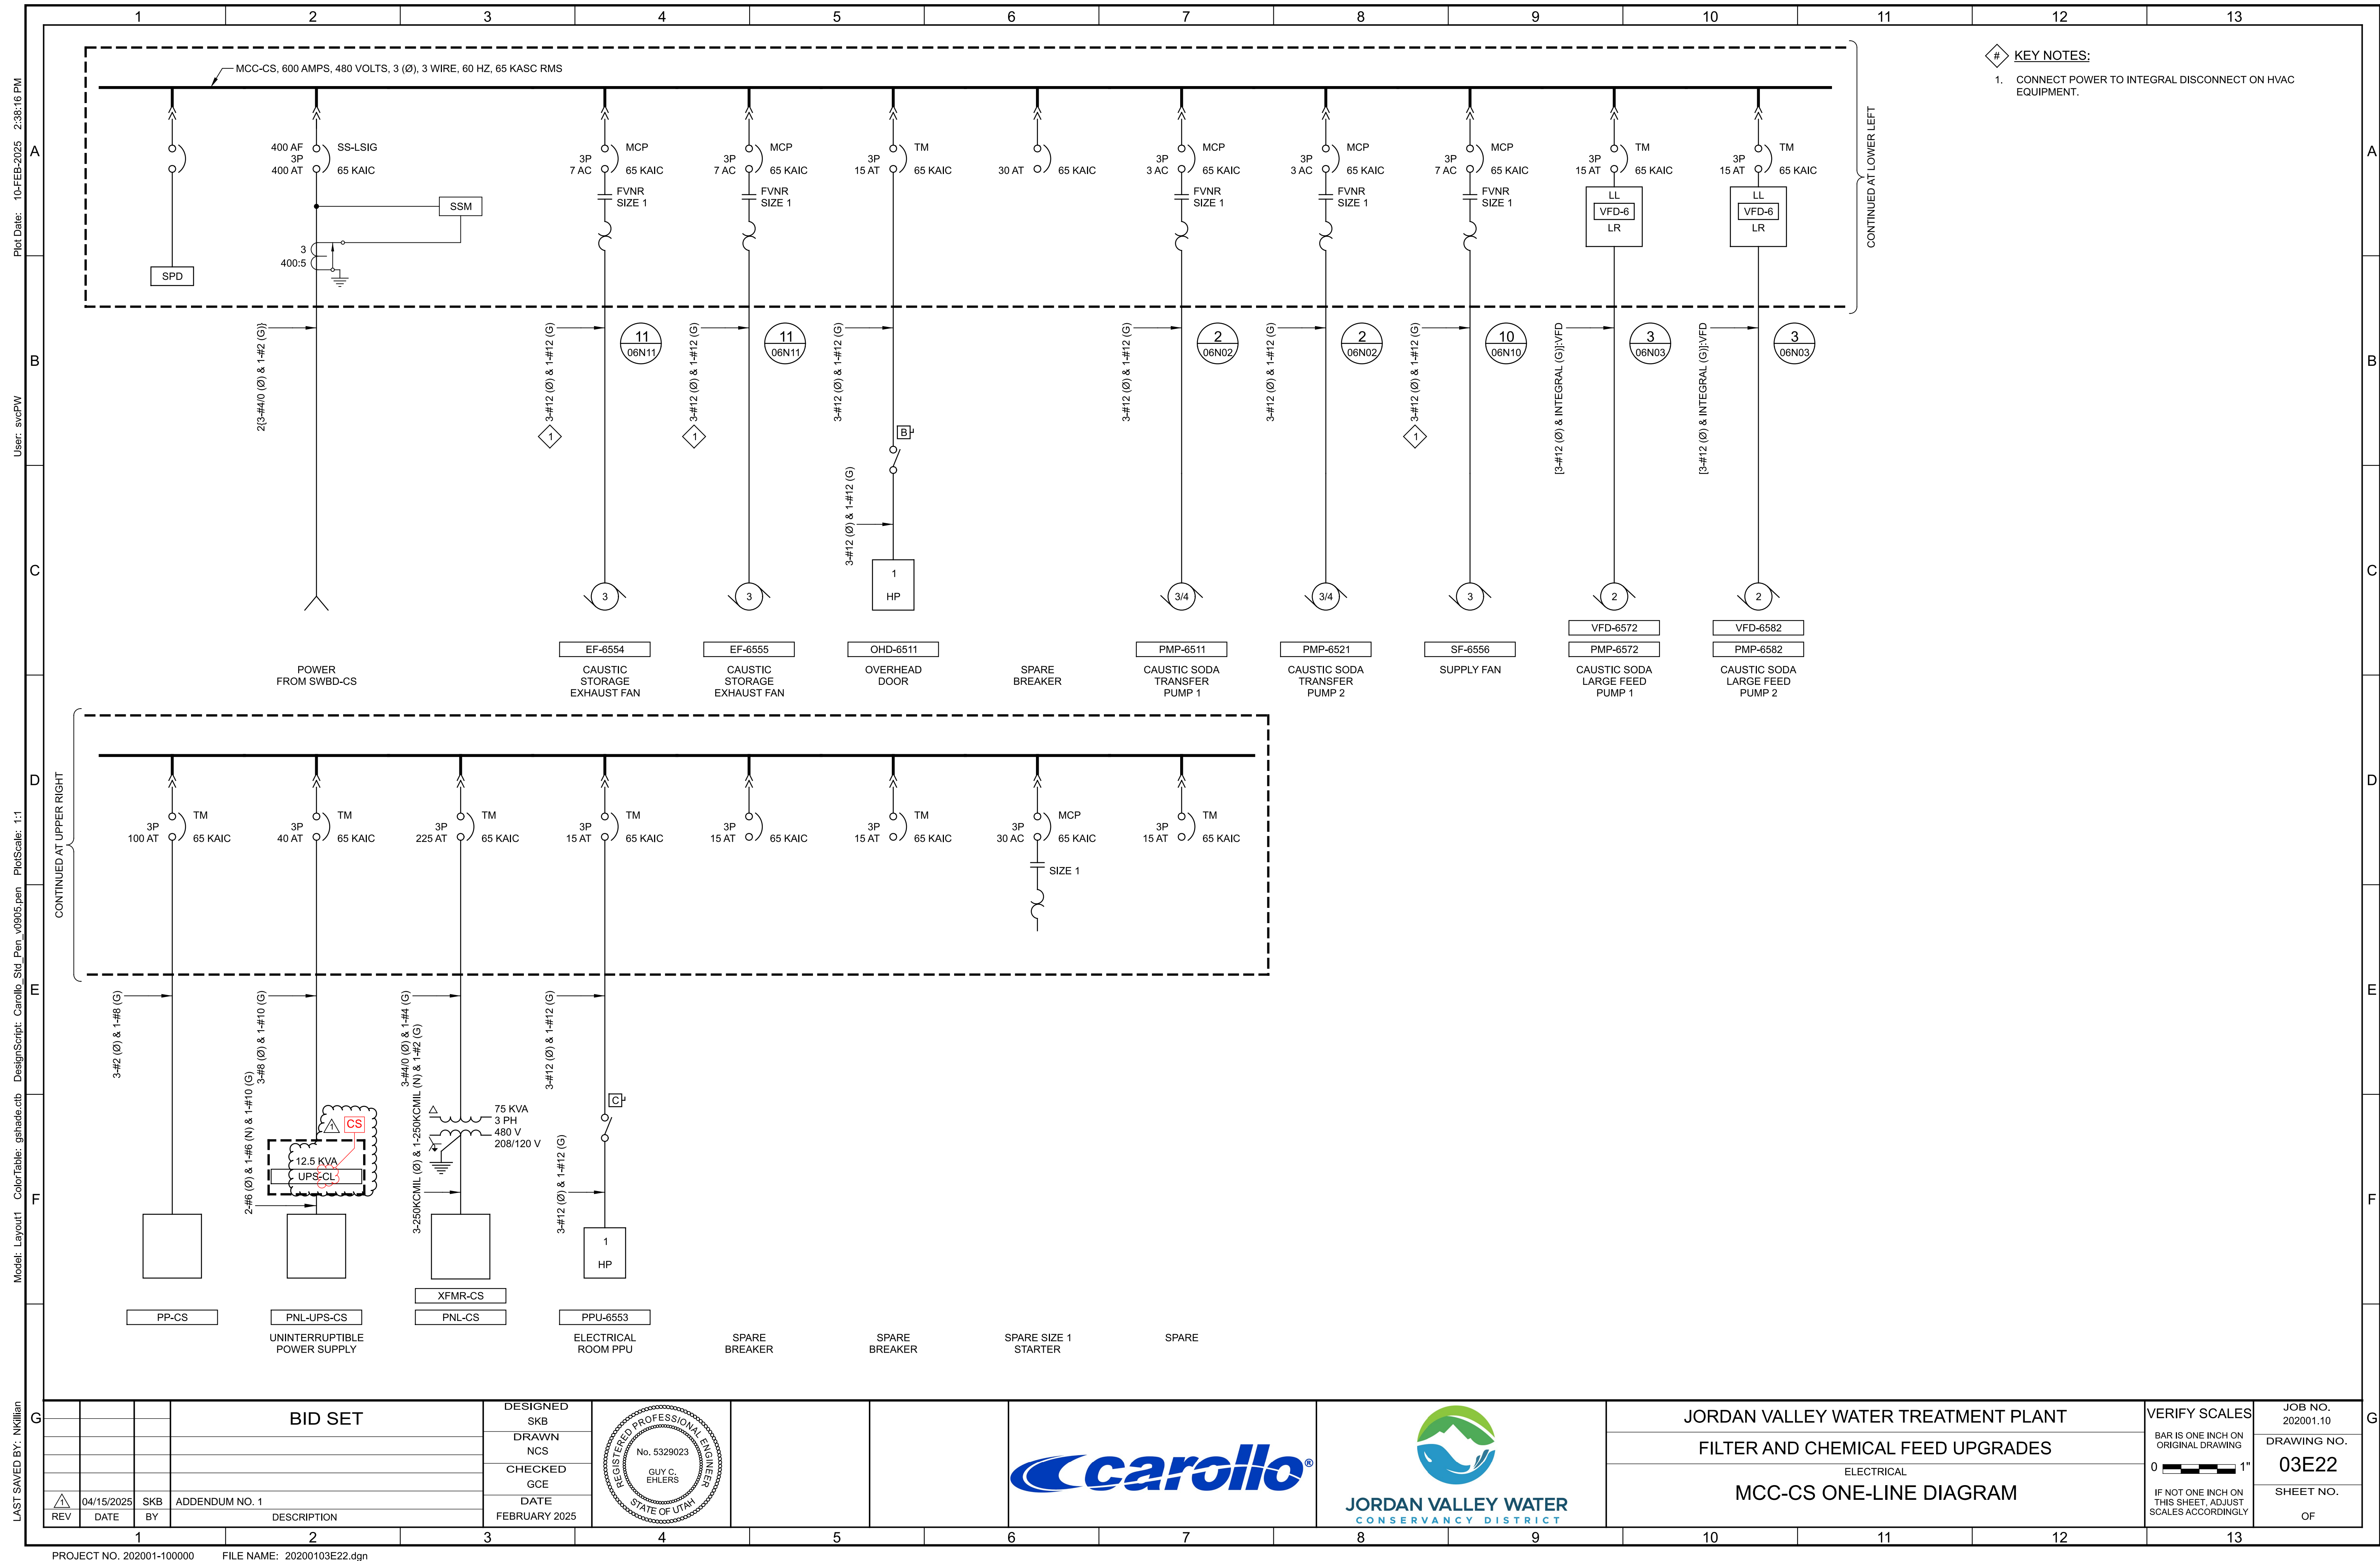


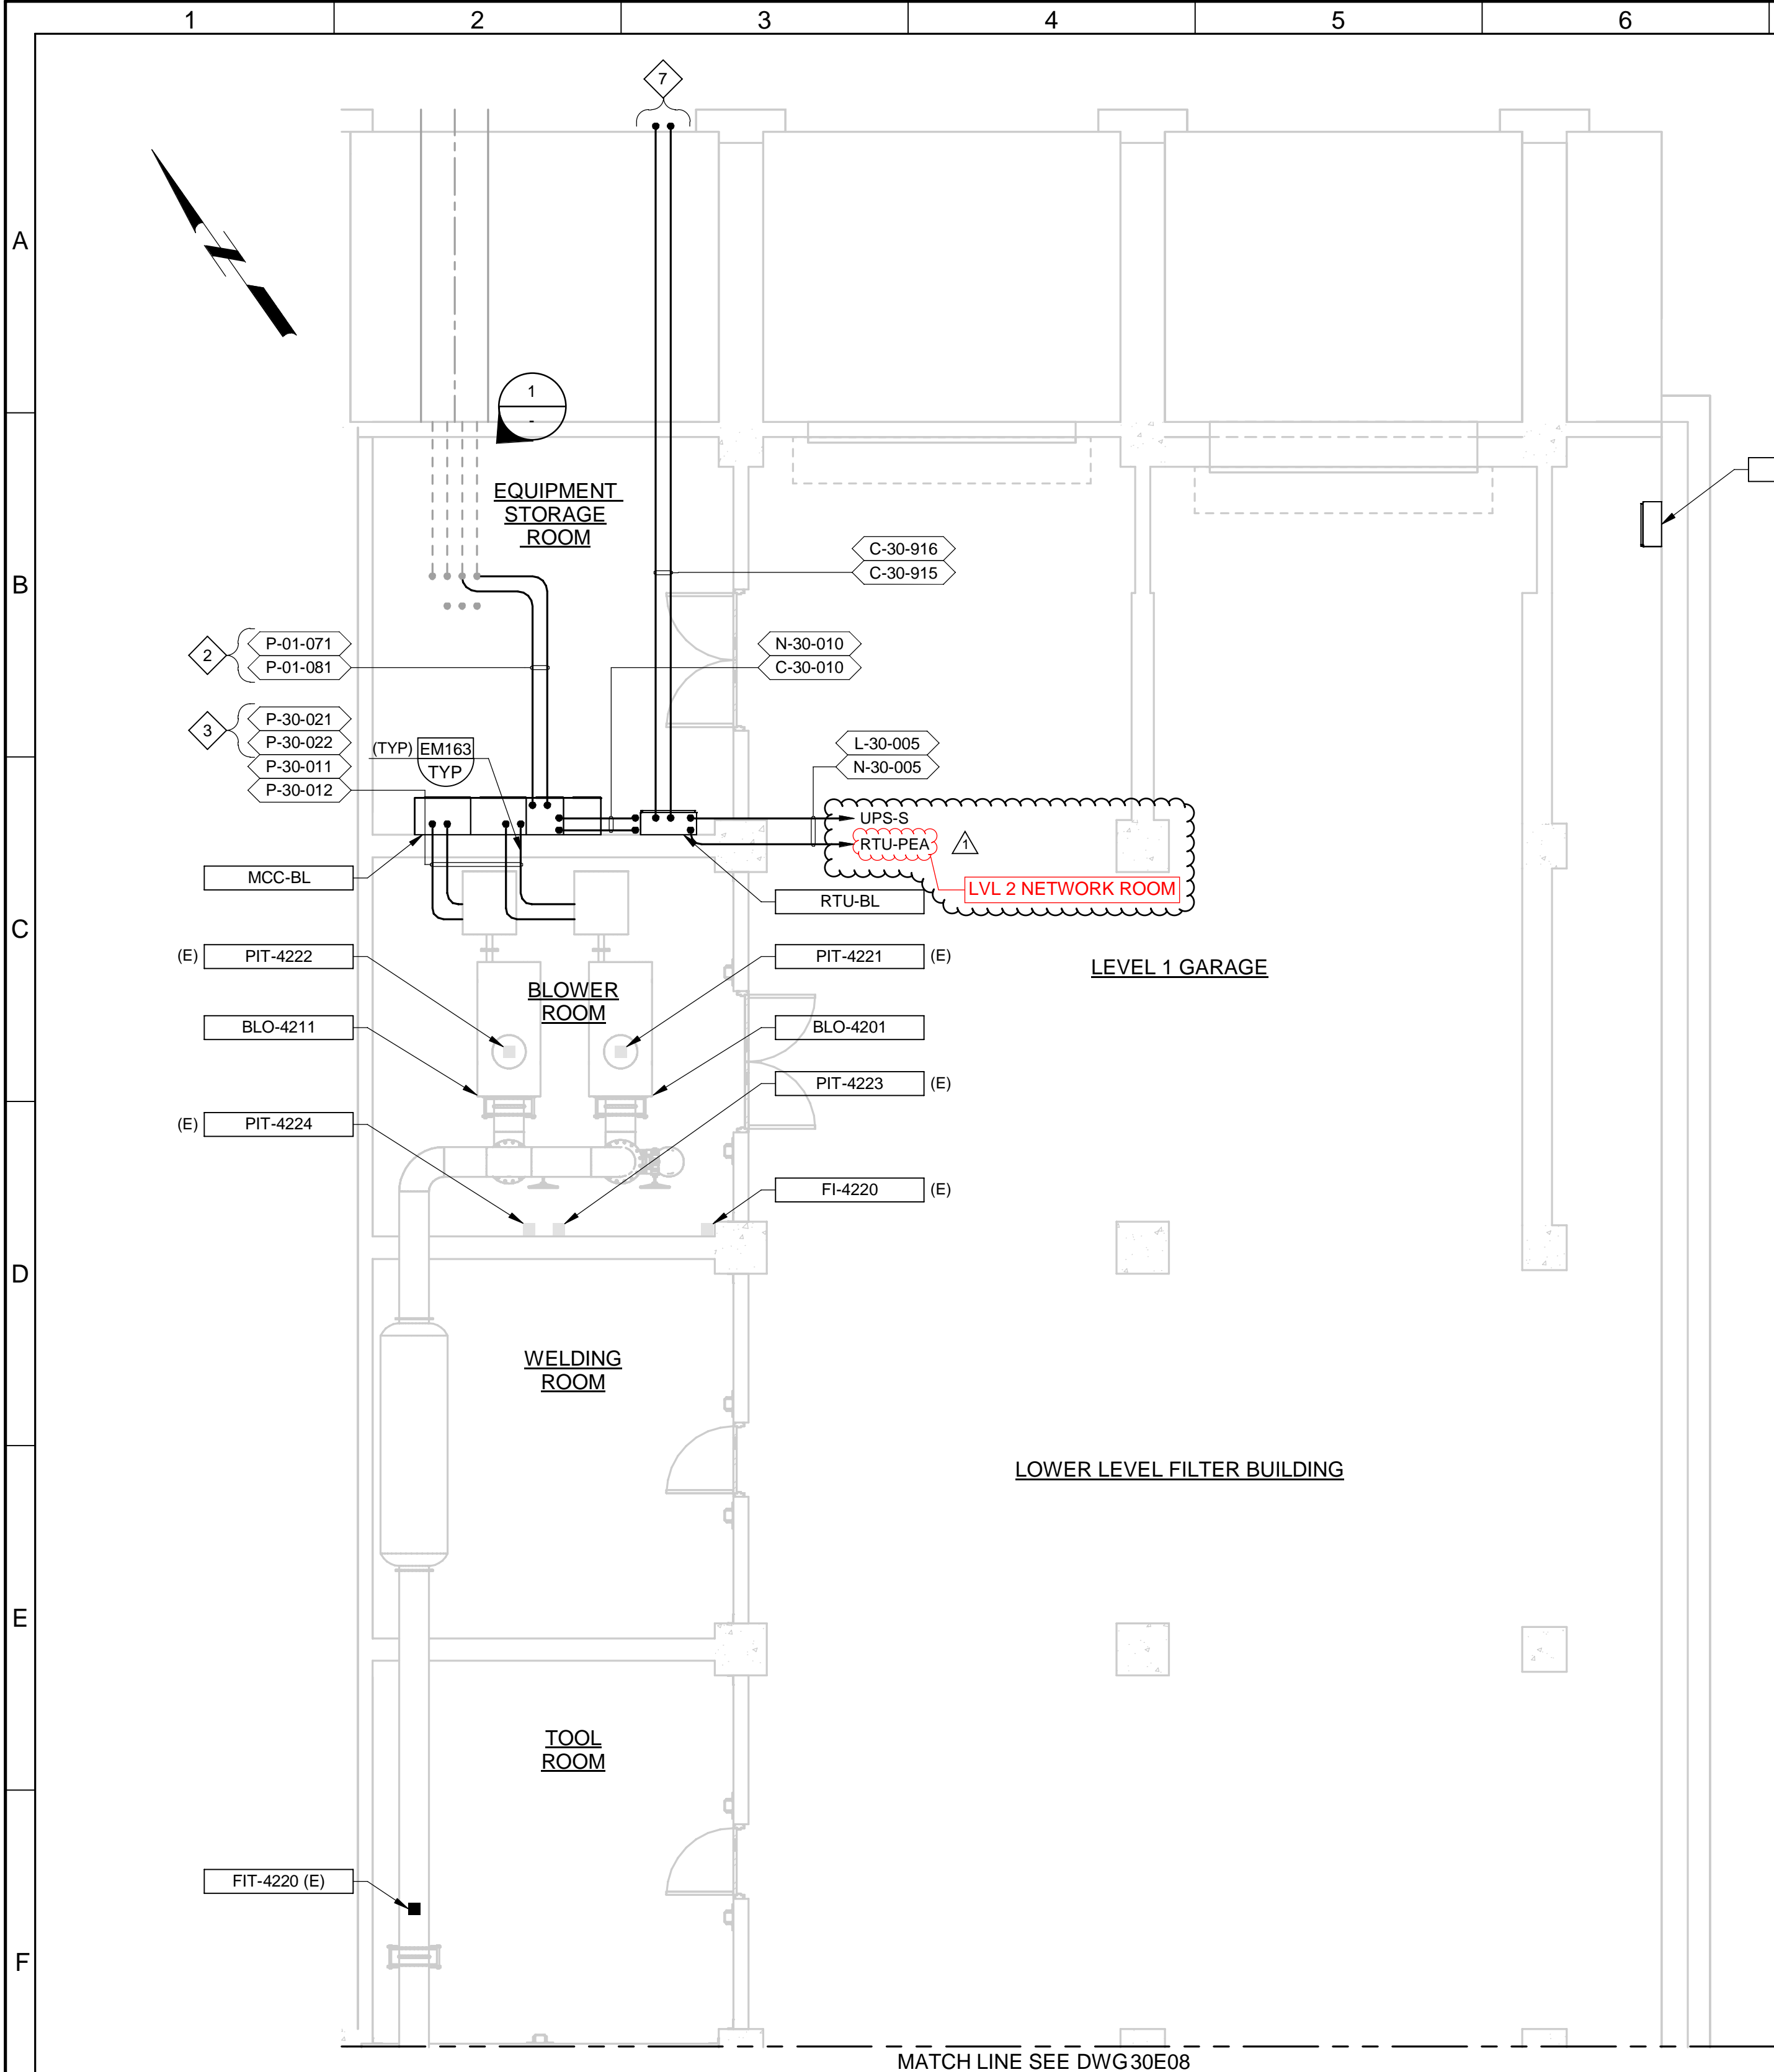

C PLAN
SCALE: 3/16" = 1'-0"




1 PHOTO
SCALE: NO SCALE

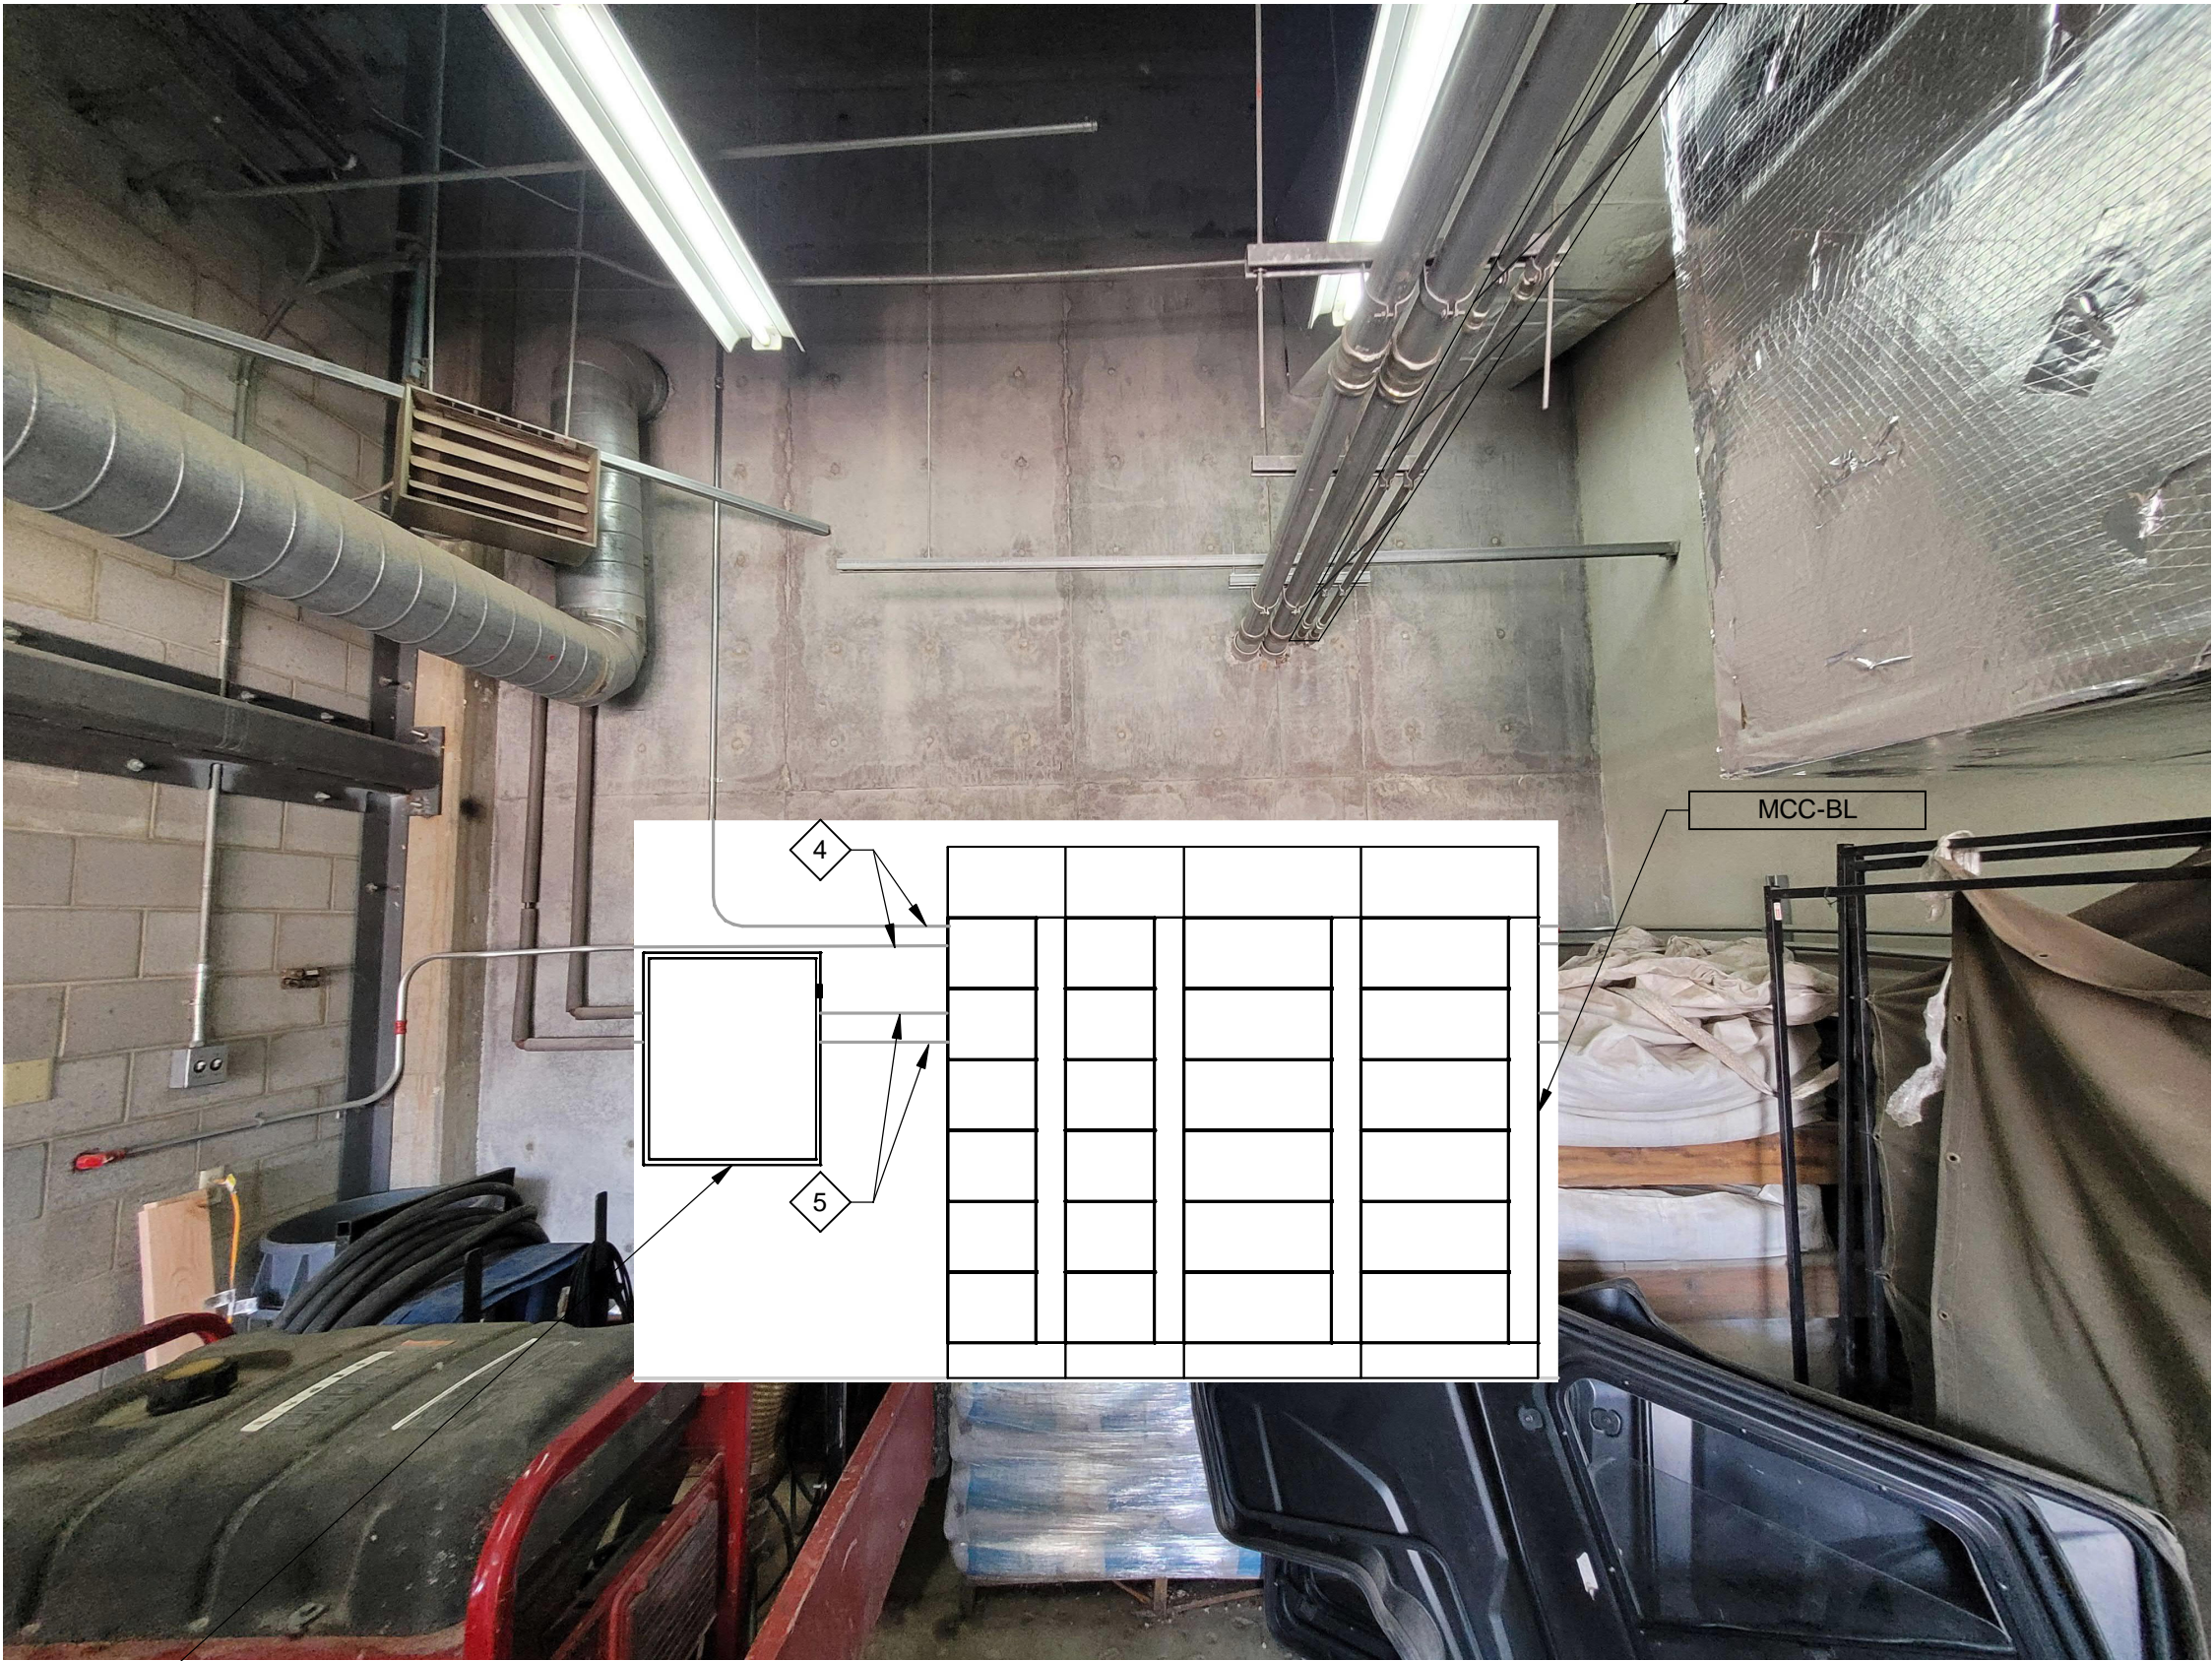


2 SECTION
SCALE: NO SCALE


- GENERAL NOTES:**
- NEW MCC SHOWN ON THIS DRAWING IS TALLER THAN THE DOORWAYS AND WILL NEED TO BE BROUGHT INTO THE BUILDING ON ITS SIDE. COORDINATE WITH MANUFACTURER FOR PROPER BRACING AND SUPPORTS TO PROTECT EQUIPMENT DURING INSTALLATION.
- KEY NOTES:**
- INTERCEPT EXISTING POWER CONDUITS FROM PB #7 TO THE EXISTING BLOWERS.
 - ROUTE VIA EXISTING INTERCEPTED CONDUITS TO PB #7.
 - AT CONTRACTOR'S DISCRETION, THE EXISTING CONDUITS MAY BE REUSED AS A PATH BETWEEN BLOWER BLO-4211, BLO-4201 AND THE NEW MCC.
 - RELOCATE EXISTING LIGHTING AND FIRE ALARM CONDUITS.
 - RELOCATE EXISTING HOT WATER SUPPLY AND RETURN LINES.
 - DEMOLISH TWO SOLENOID CONDUITS AND RE-ROUTE TO NEW MCC-BL.
 - CONDUITS CONTINUE ON DRAWING 01E05.
 - CAP EXISTING CONDUITS.

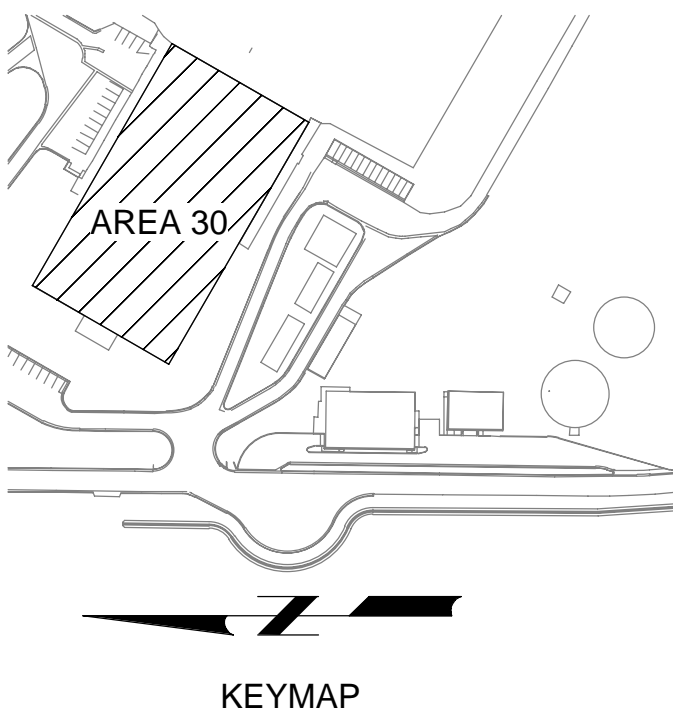


G																																																																																																																																																																																																																																																																																																																																																																																																																																																																																																																																																																																																																																																																																																																																																																																																																																																																																																																																																																																																																																																																																																																																																																																																																																																																																																																																																																																																																																																																																																																																																																																																																																																																																																																																																																						
---	--	--	
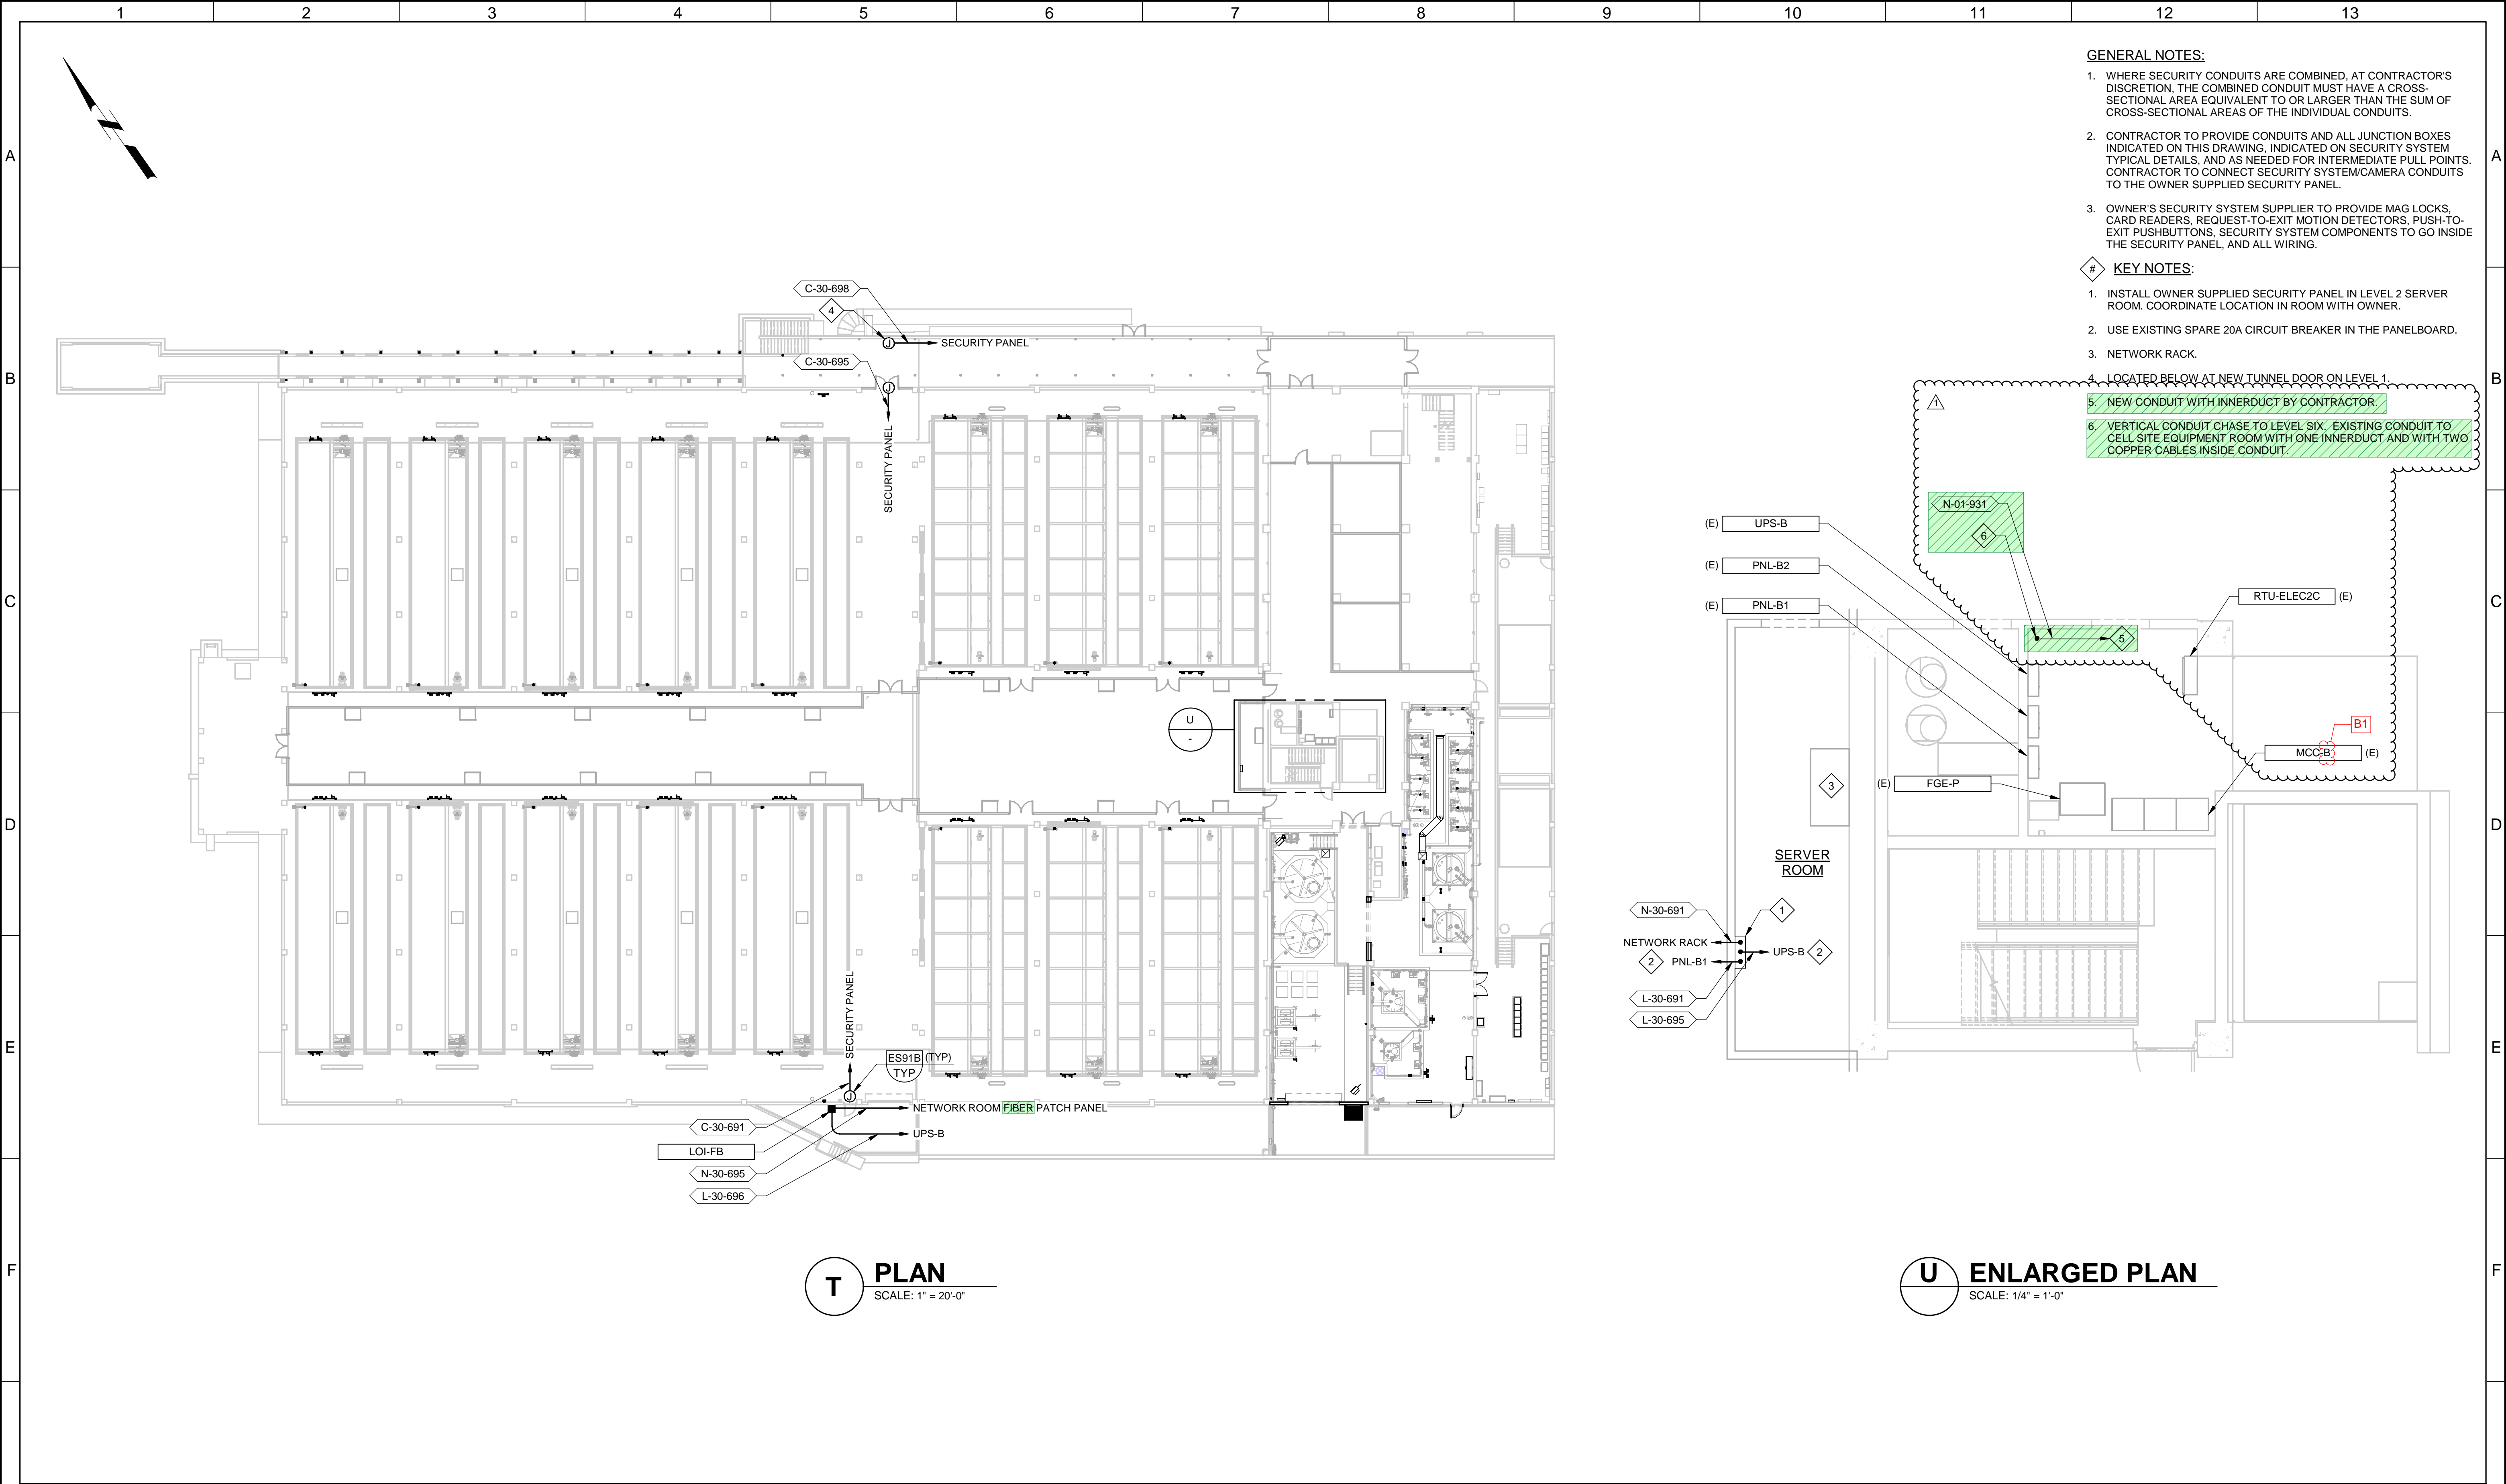


BID SET				DESIGNED SKB								JORDAN VALLEY WATER TREATMENT PLANT			VERIFY SCALES	JOB NO. 202001.10
				DRAWN MNH								FILTER AND CHEMICAL FEED UPGRADES			BAR IS ONE INCH ON ORIGINAL DRAWING	DRAWING NO.
				CHECKED GCE											0 1"	30E19
				DATE FEBRUARY 2025								ELECTRICAL FILTERS SECURITY PLAN			IF NOT ONE INCH ON THIS SHEET, ADJUST SCALES ACCORDINGLY	SHEET NO. OF
REV	DATE	SKB BY	ADDENDUM NO. 1	DESCRIPTION												
1																

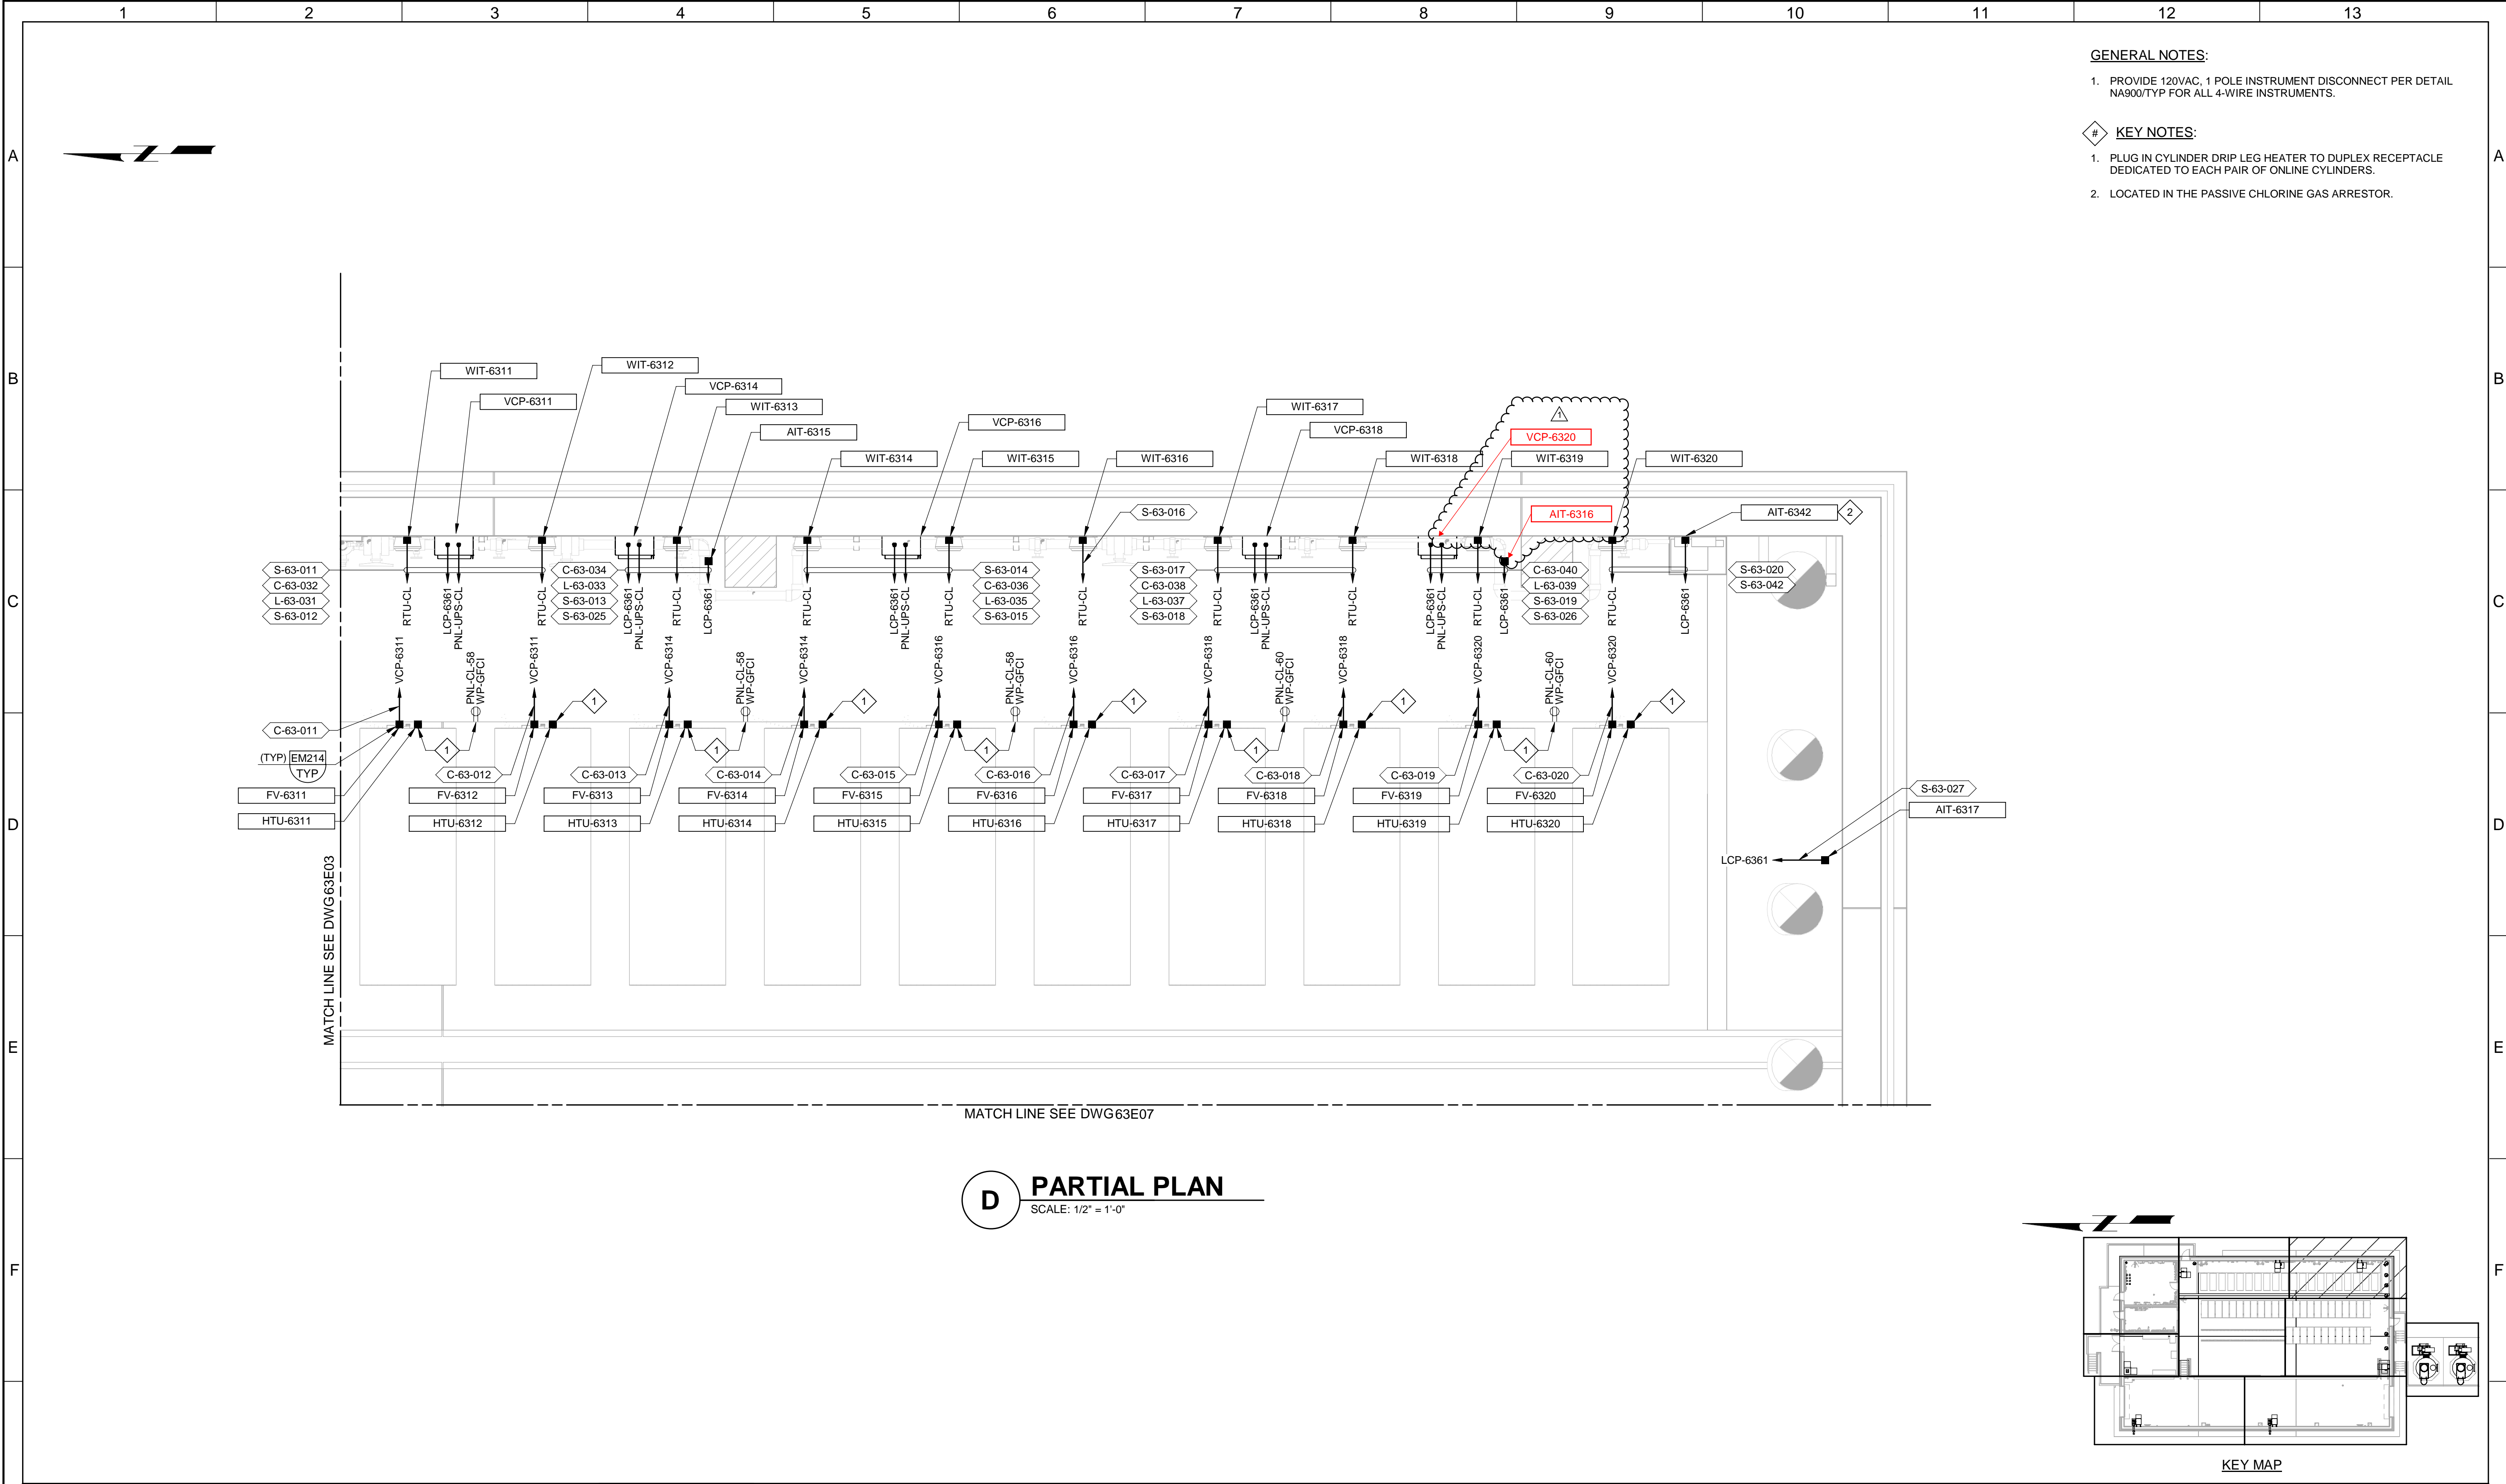

G				BID SET		DESIGNED MJG							JORDAN VALLEY WATER TREATMENT PLANT			VERIFY SCALES	JOB NO. 202001.10	G								
					DRAWN MNH			FILTER AND CHEMICAL FEED UPGRADES					BAR IS ONE INCH ON ORIGINAL DRAWING	DRAWING NO.												
					CHECKED GCE			ELECTRICAL					0 1"	63E04												
					DATE FEBRUARY 2025			CHLORINE BUILDING CHLORINE AREA SOUTH POWER AND CONTROL PLAN					IF NOT ONE INCH ON THIS SHEET, ADJUST SCALES ACCORDINGLY	SHEET NO. OF												
		04/15/2025	SKB	ADDENDUM NO. 1																						
REV	DATE	BY	DESCRIPTION																							
	1		2		3		4		5		6		7		8		9		10		11		12		13	

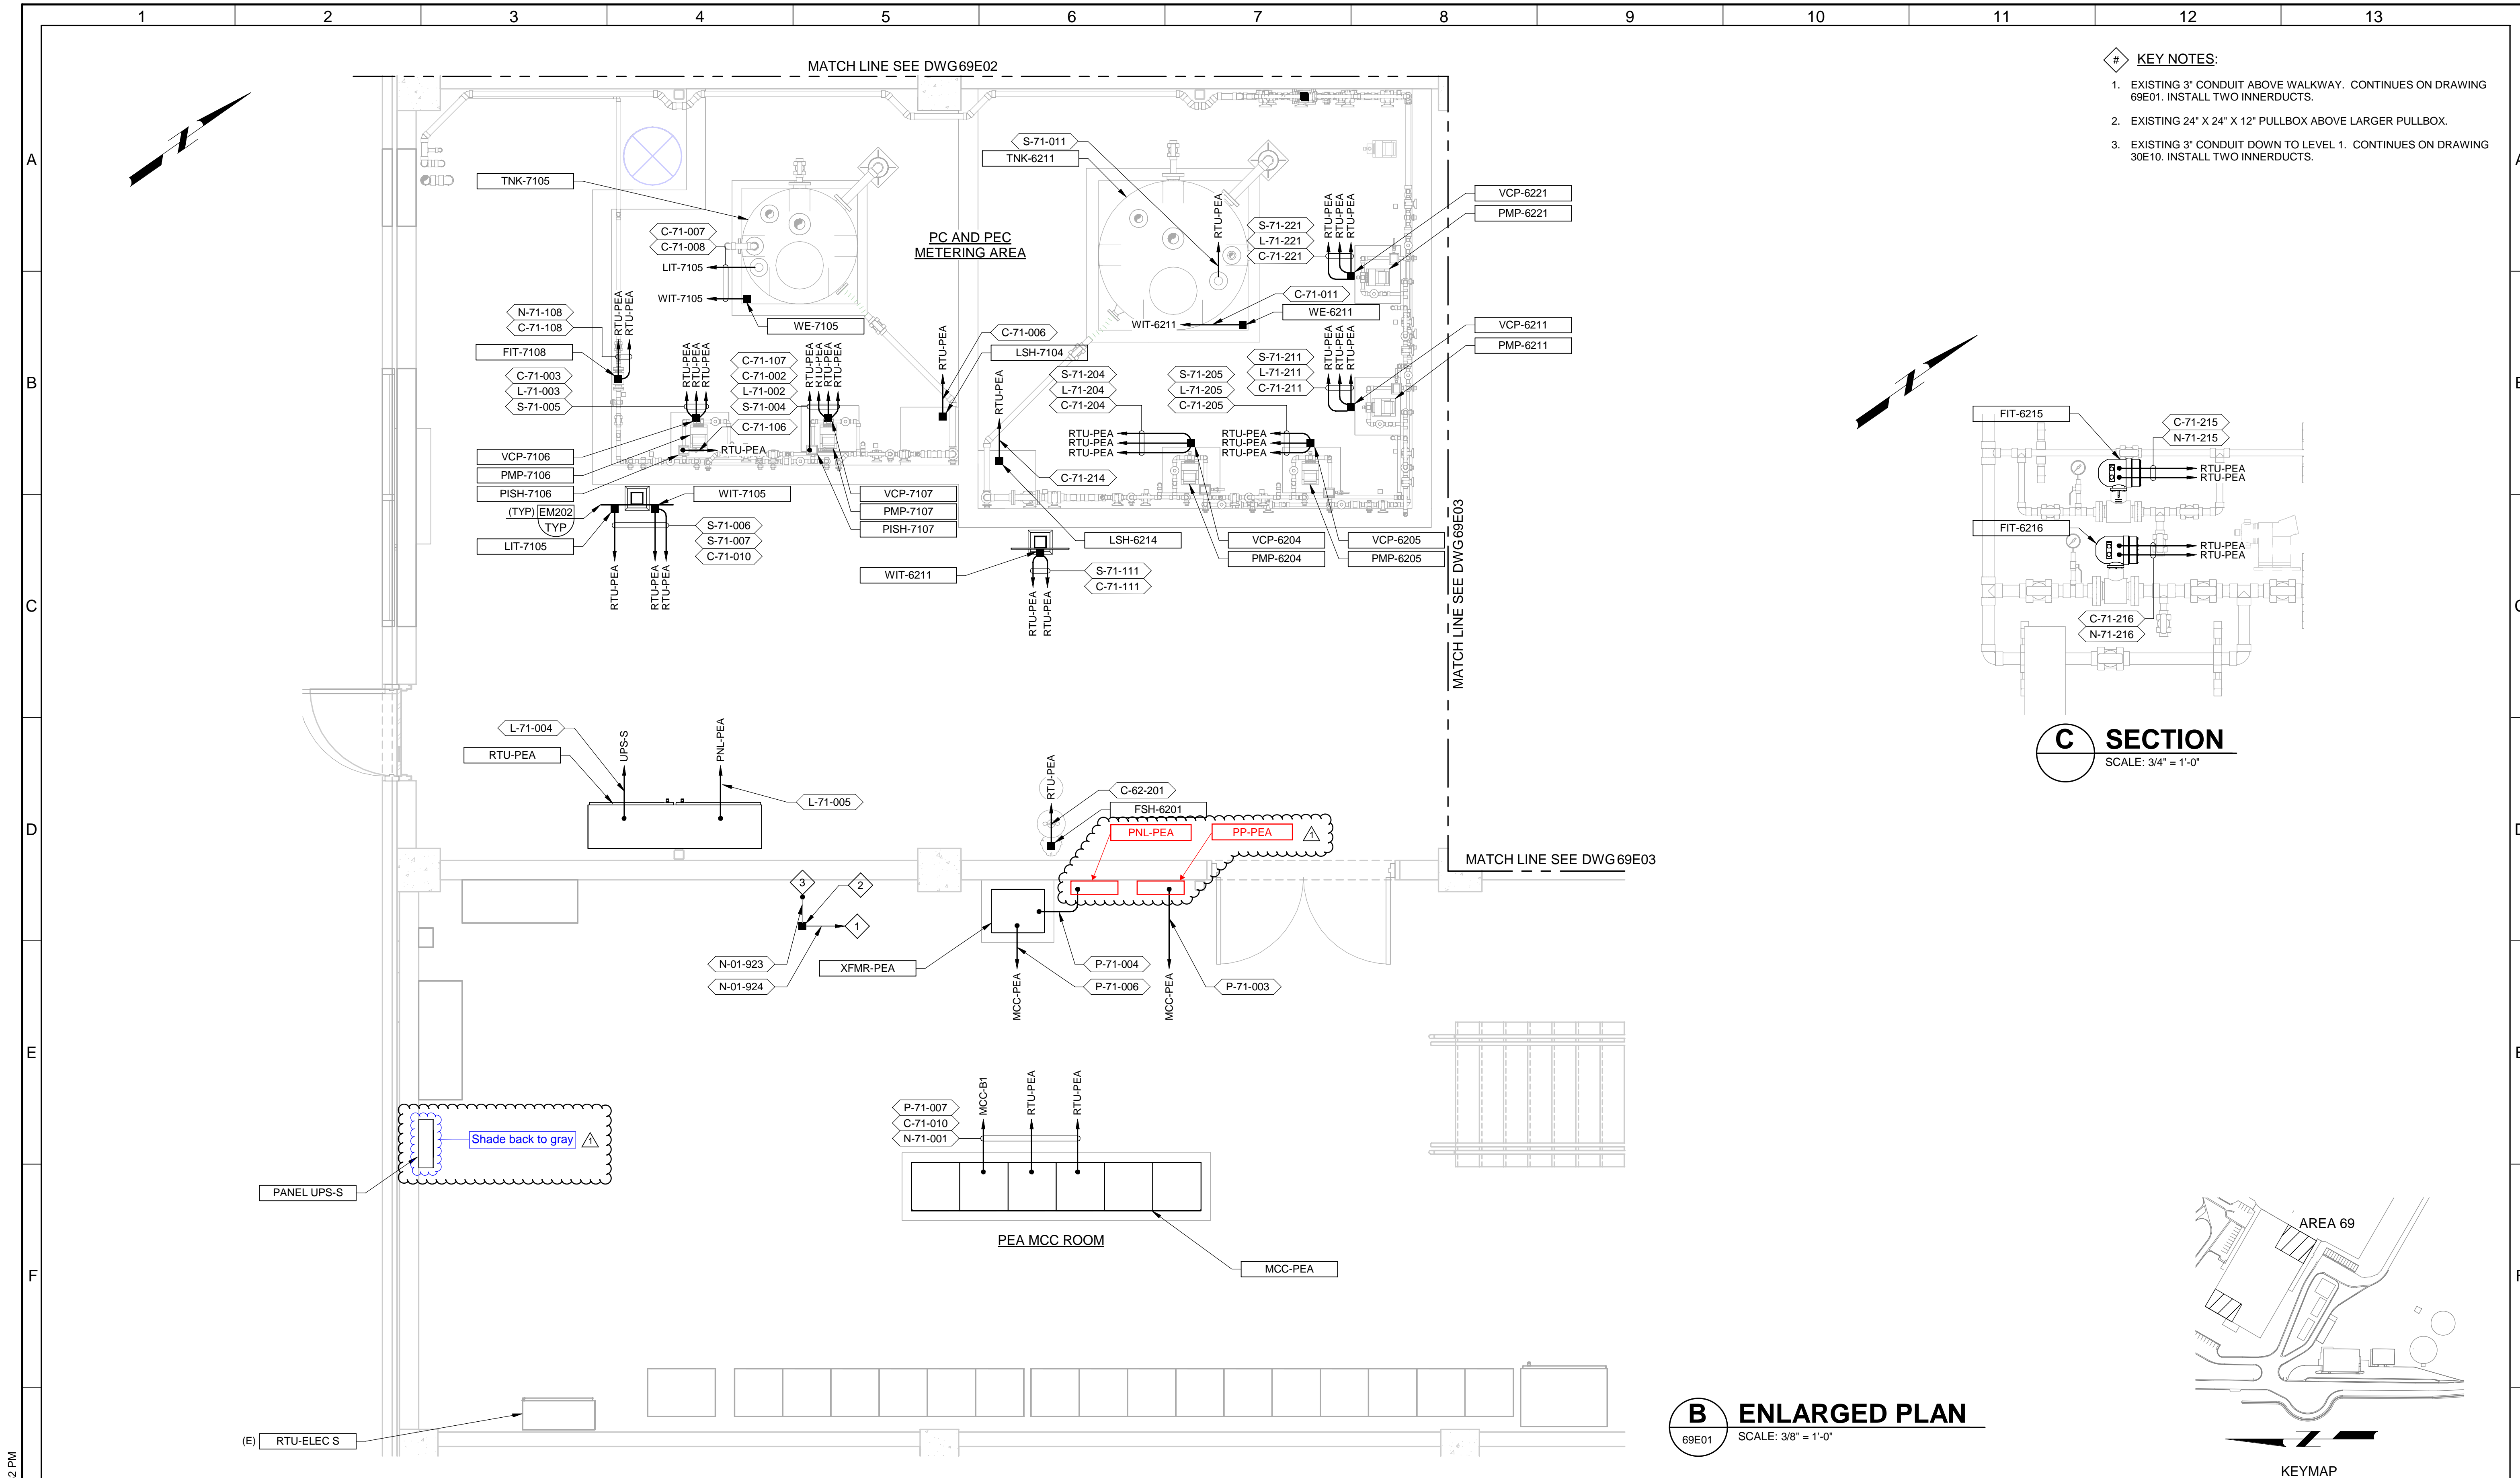


- # KEY NOTES:
- EXISTING 3" CONDUIT ABOVE WALKWAY. CONTINUES ON DRAWING 69E01. INSTALL TWO INNERDUCTS.
 - EXISTING 24" X 24" X 12" PULLBOX ABOVE LARGER PULLBOX.
 - EXISTING 3" CONDUIT DOWN TO LEVEL 1. CONTINUES ON DRAWING 30E10. INSTALL TWO INNERDUCTS.

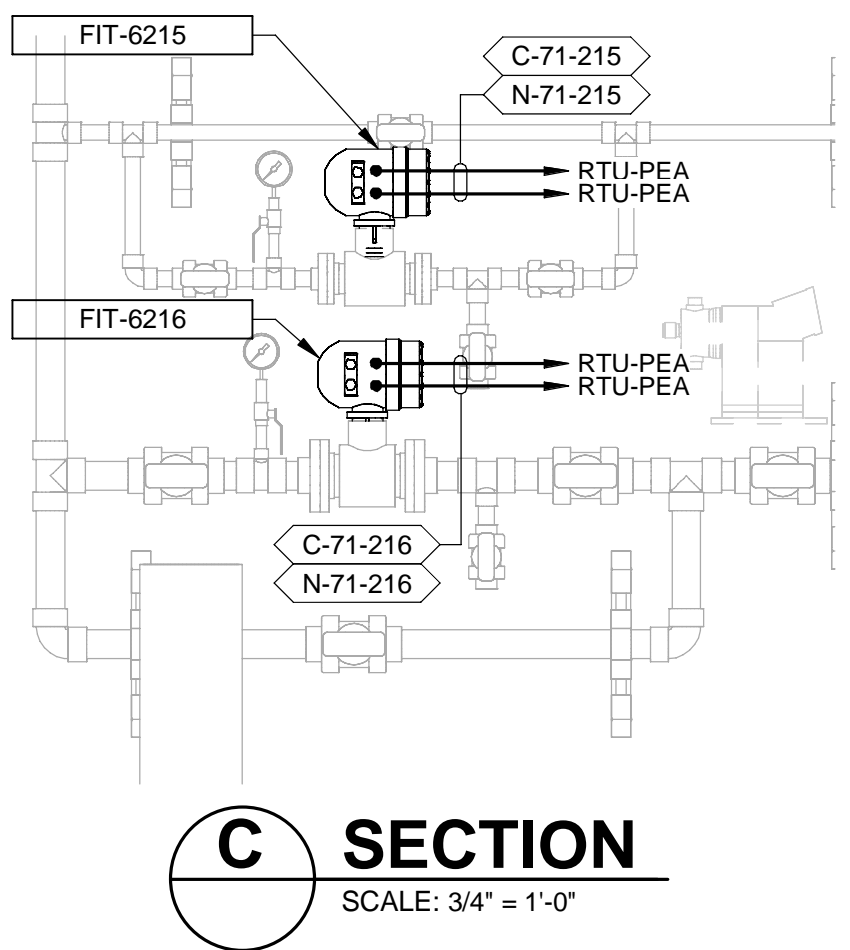

C SECTION
SCALE: 3/4" = 1'-0"

B ENLARGED PLAN
69E01 SCALE: 3/8" = 1'-0"

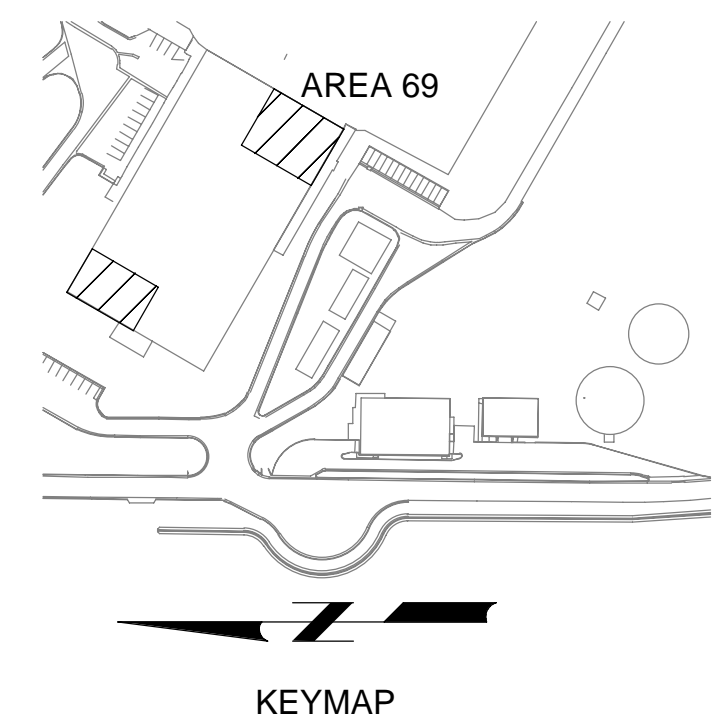

</

PLOT DATE: 2/10/2025 4:52:32 PM

12345678910111213

EQUIPMENT TAGGING SYSTEM

EQUIPMENT EXAMPLE: FLO-22.1101 (FLOCCULATOR TRAIN 1 NO. 1) REPRESENTS MAJOR PIECE OF EQUIPMENT

XXX-ABCD

EQUIPMENT DESCRIPTOR			
XXX		XXX	
AEB	AERATION BASIN	FDR	FEEDER
AER	AERATOR	FLT	FILTER
AHU	AIR HANDLING UNIT	FLA	FLARE
AND	ANAEROBIC DIGESTER	FLO	FLOCCULATOR
ARC	AIR COMPRESSOR	FU	FUSE
ARF	AIR FILTER	GAT	GATE
ARR	ARRESTOR	GRI	GRINDER
AUG	AUGER	GRC	GRIT CHAMBER
AVR	AIR VACUUM RELIEF	HOI	HOIST
BAR	BAR SCREEN	IC	ISOLATION CONTACTOR
BAS	BASIN	INJ	INJECTOR
BC	BYPASS CONTACTOR	LAG	LAGOON
BFP	BELT FILTER PRESS	MAU	MAKE-UP AIR UNIT
BIT	BIO TOWER	MIX	MIXER
BLO	BLOWER	MMS	MAGNETIC MOTOR STARTER
BOI	BOILER	MPR	MOTOR PROTECTION RELAY
BUR	BURNER	MTR	MOTOR
CAL	CALIBRATION COLUMN	PLO	PLOW
CB	CIRCUIT BREAKER	PPR	PUMP PROTECTION RELAY
CEN	CENTRIFUGE	PRE	PRESS
CHI	CHILLER	PUD	PULSATION DAMPENER
CHL	CHLORINATOR	PMP	PUMP
CLR	CLARIFIER	REC	RECEIVER
CLA	CLASSIFIER	RES	RESERVOIR
CLU	CLUTCH	SCB	SCRUBBER
COA	COALESCE	SCR	SCREEN
COL	COLLECTOR	SEL	SEAL
COS	COMPOSITE SAMPLER	SF	SUPPLY FAN
CON	CONVEYOR	SHA	SHAKER
COO	COOLER	SLA	SLAKER
CPT	CONTROL POWER TRANSFORMER	SLC	SLUDGE COLLECTOR
CR	CONTROL RELAY	STR	STRAINER
DAM	DAMPENER	SV	SOLENOID VALVE
DEC	DECARBONATOR	TNK	TANK
DCD	DC DRIVE	THI	THICKENER
DIF	DIFFUSER	TRA	TRAP
DIS	DISTRIBUTOR	UVR	ULTRA VIOLET REACTOR
DRY	DRYER	VAL	VALVE
DSC	DUST COLLECTOR	VFD	VARIABLE FREQUENCY DRIVE
EDU	EDUCTOR	WEL	WELL
EF	EXHAUST FAN	*CV	* CONTROL VALVE
ENG	ENGINE GENERATOR	*V	* VALVE
EUH	ELECTRIC UNIT HEATER	*CG	* CONTROL GATE
EVP	EVAPORATOR	*G	* GATE
EXC	EXCHANGER		* = A (ANALYTICAL), F (FLOW), L (LEVEL)
FAN	FAN		P (PRESSURE), T (TEMPERATURE)

PROCESS AREA DESIGNATION TABLE	
LOOP	PROCESS AREA
1XXX	RAW WATER
	11XX VALVES
	12XX FLOW METERING
	13XX STORAGE
	14XX PRESEDIMENTATION
	15XX SCREENING
	16XX PUMPING
	17XX OTHER INSTRUMENTS
	18XX PILOT PLANT
2XXX	PRETREATMENT
	21XX FLASH MIX
	22XX FLOCCULATION
	23XX SEDIMENTATION
	24XX ACTIFLO PROCESS
3XXX	FILTERS
4XXX	FILTER PERIPHERALS
	41XX BACKWASH WATER
	42XX AIRWASH
	43XX SOLIDS RESIDUALS
	44XX WASTE WASHWATER
5XXX	FINISHED WATER
	55XX CULINARY WATER PUMP STATION
6XXX	CHEMICALS
	61XX ALUM
	62XX PRIMARY COAGULANT
	63XX CHLORINE
	64XX CARBON
	65XX CAUSTIC
	66XX FLUORIDE
	67XX KMNO4
	68XX PAC
	69XX PEA
7XXX	CHEMICALS (CONTINUED)
	71XX PEC
	72XX BRIDGING POLYMER
	77XX CHLORINE DIOXIDE
8XXX	RESERVED
9XXX	UTILITIES
	91XX WATER
	92XX AIR
	93XX DIESEL FUEL
	94XX NATURAL GAS
	95XX HVAC
	96XX ELECTRIC
	97XX COMMUNICATIONS
	98XX SECURITY

DESIGNED CE
DRAWN CE
CHECKED GCE
DATE
FEBRUARY 2025

REGISTERED PROFESSIONAL ENGINEER
No. 5329023
GUY C. EHLERS
STATE OF UTAH

carollo

JORDAN VALLEY WATER
CONSERVANCY DISTRICT


JORDAN VALLEY WATER TREATMENT PLANT
FILTER AND CHEMICAL FEED UPGRADES
INSTRUMENTATION
GENERAL
EQUIPMENT TAGGING SYSTEM


VERIFY SCALES
BAR IS ONE INCH ON ORIGINAL DRAWING
0 1"
IF NOT ONE INCH ON THIS SHEET, ADJUST SCALES ACCORDINGLY

JOB NO.
202001.10
DRAWING NO.
00GN07
SHEET NO.
OF


12345678910111213


PROJECT NO. 202001-100000 FILE NAME: 20200100GN07.dwg

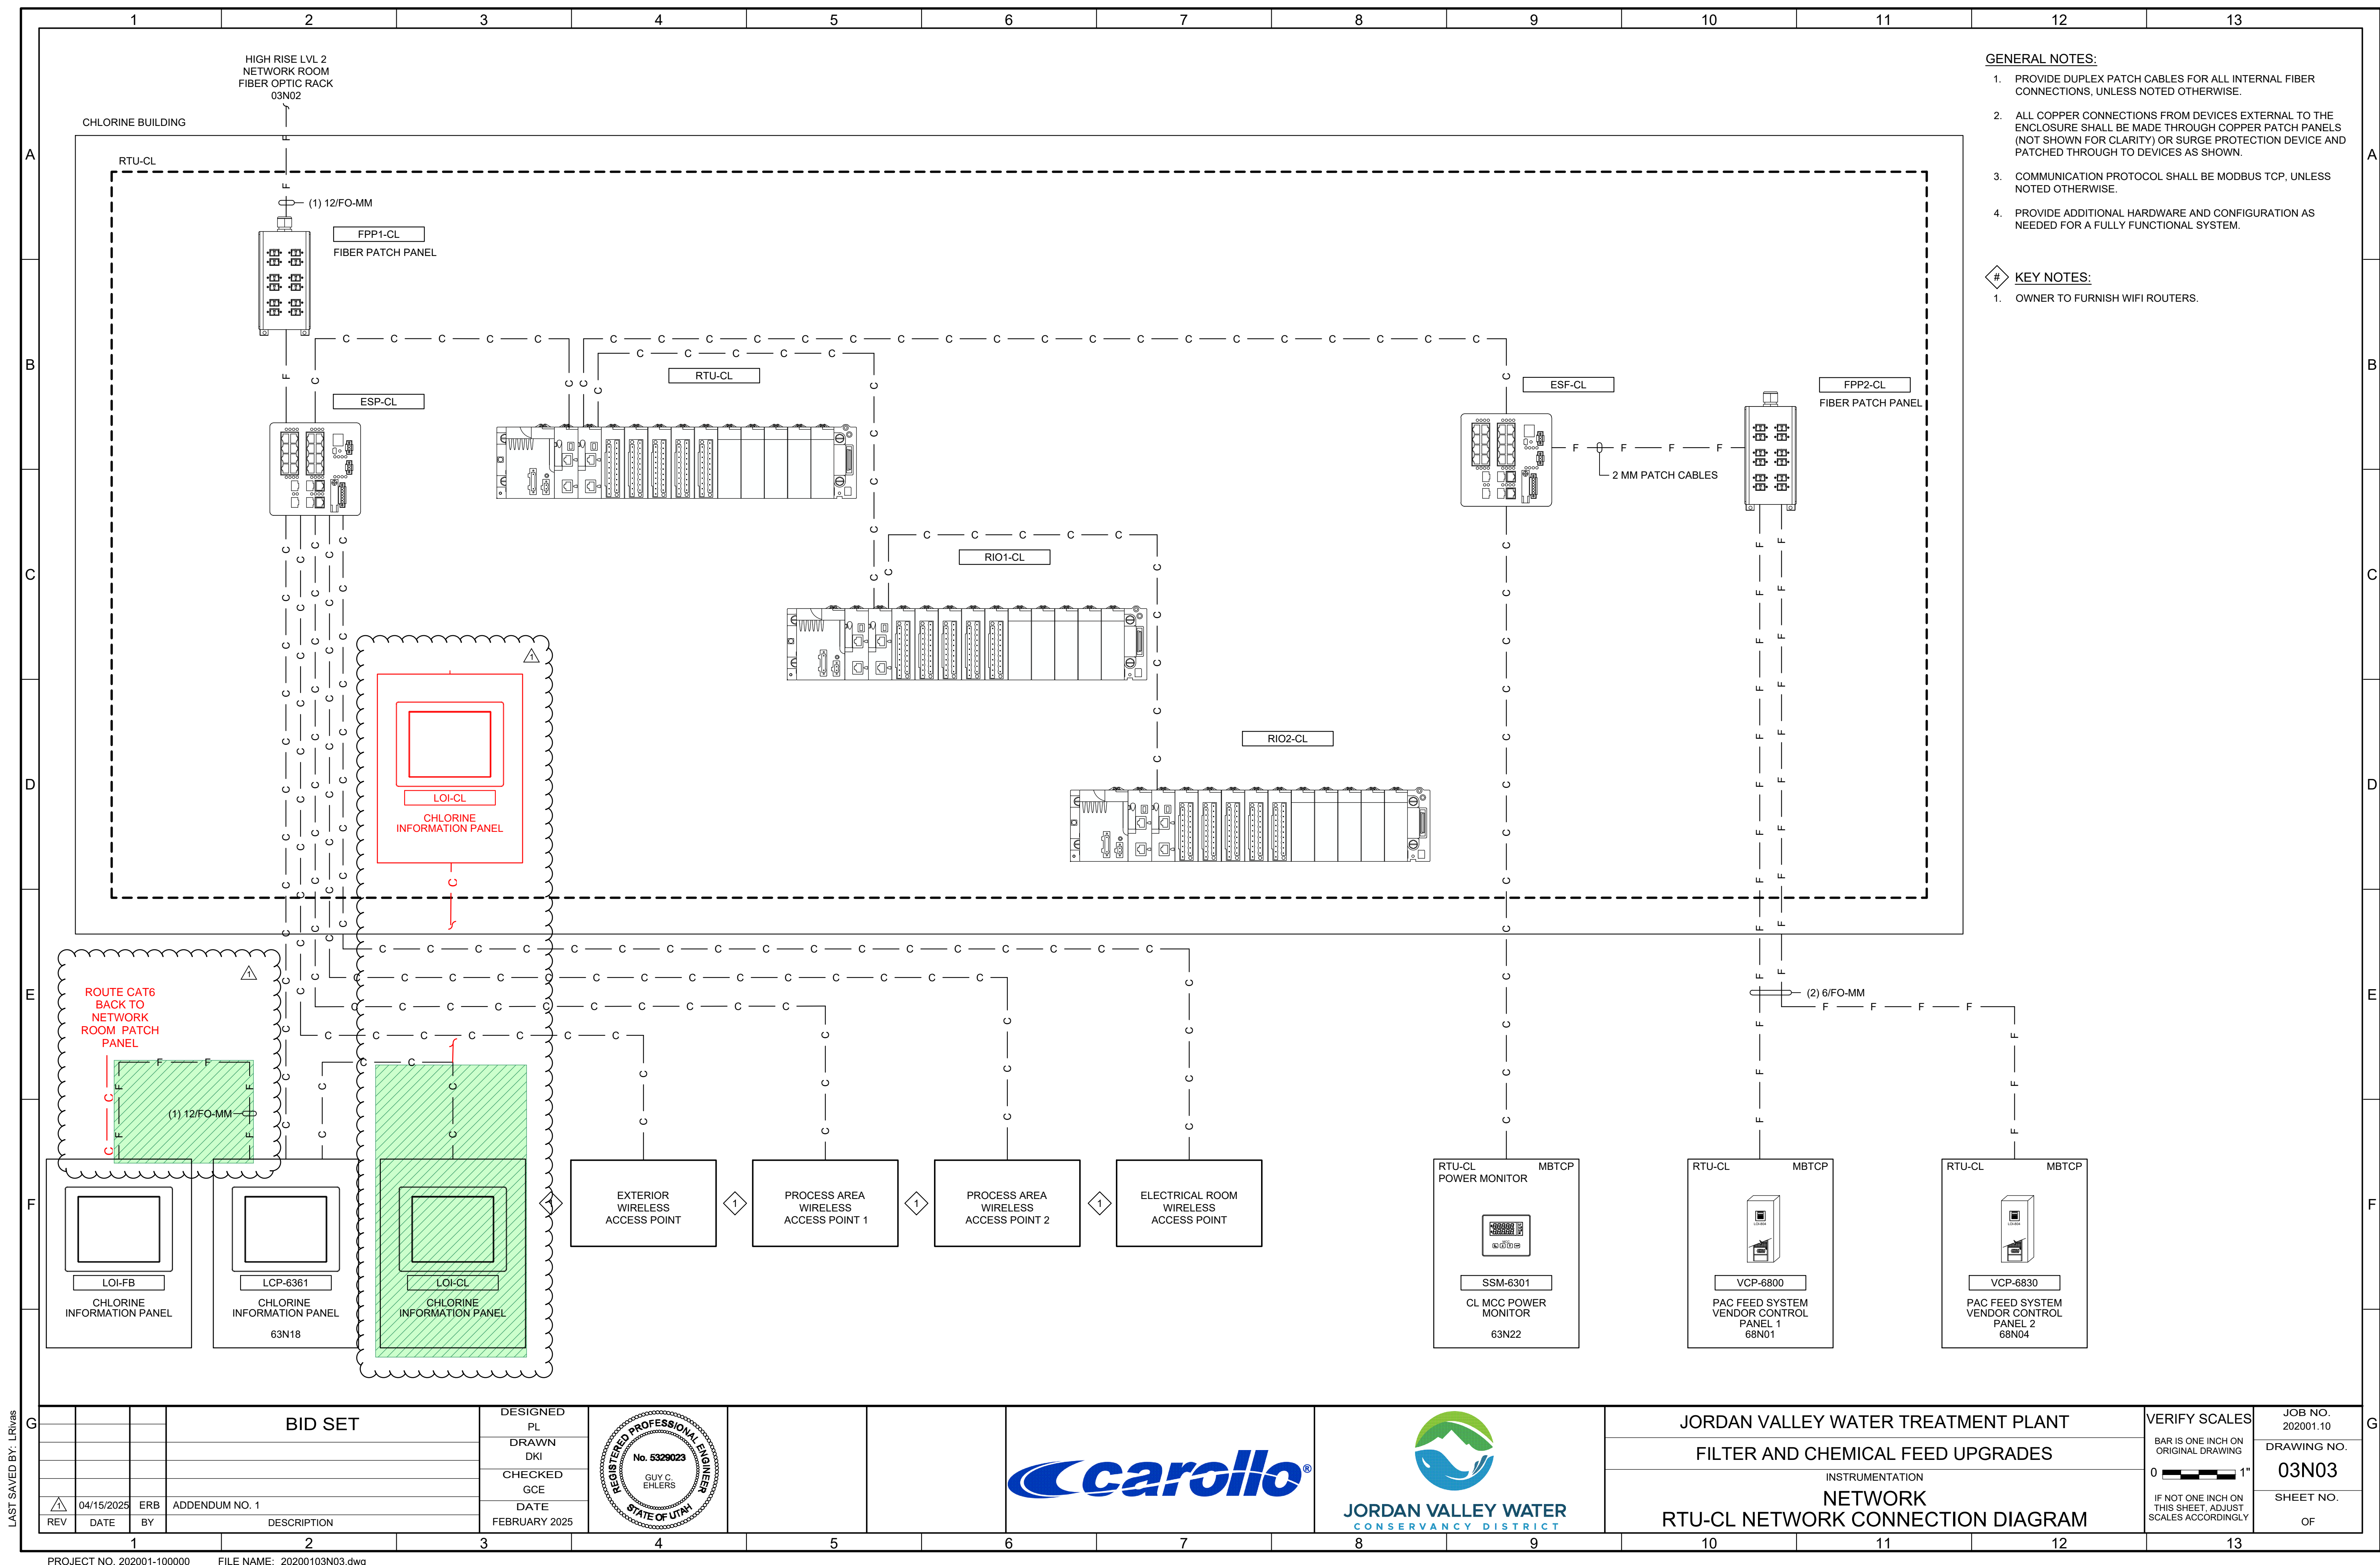


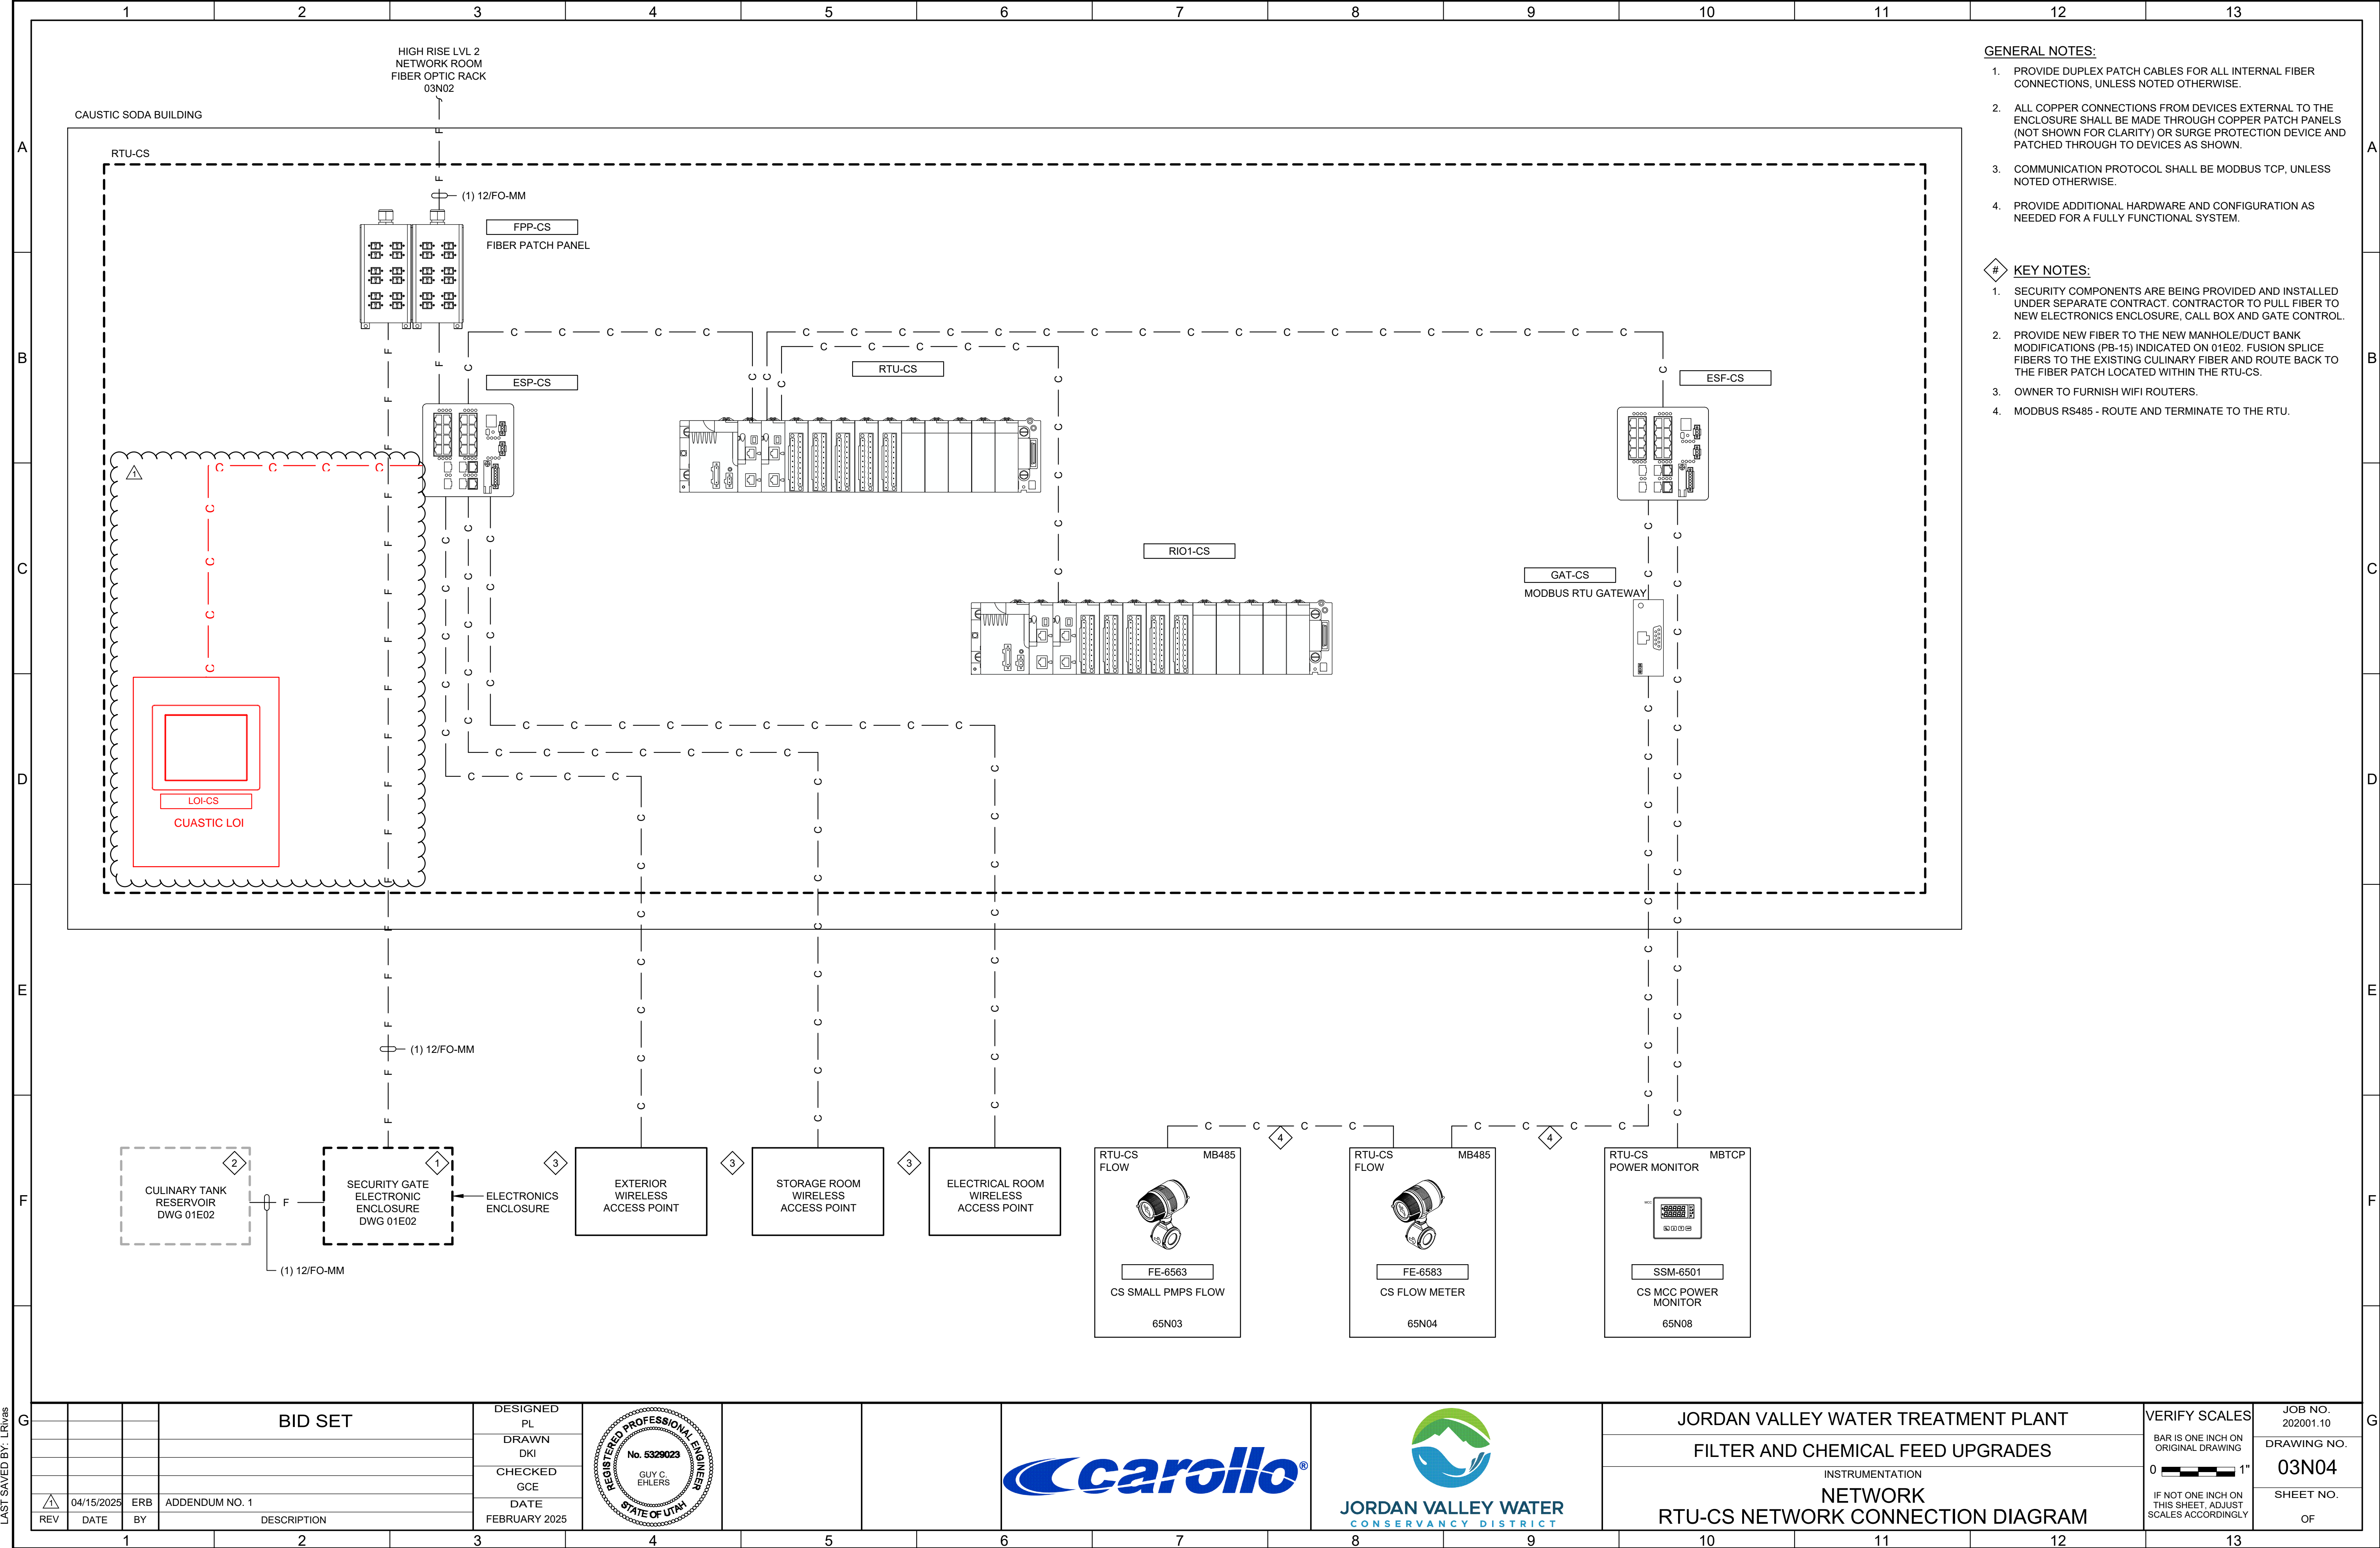

LAST SAVED BY: LRivas

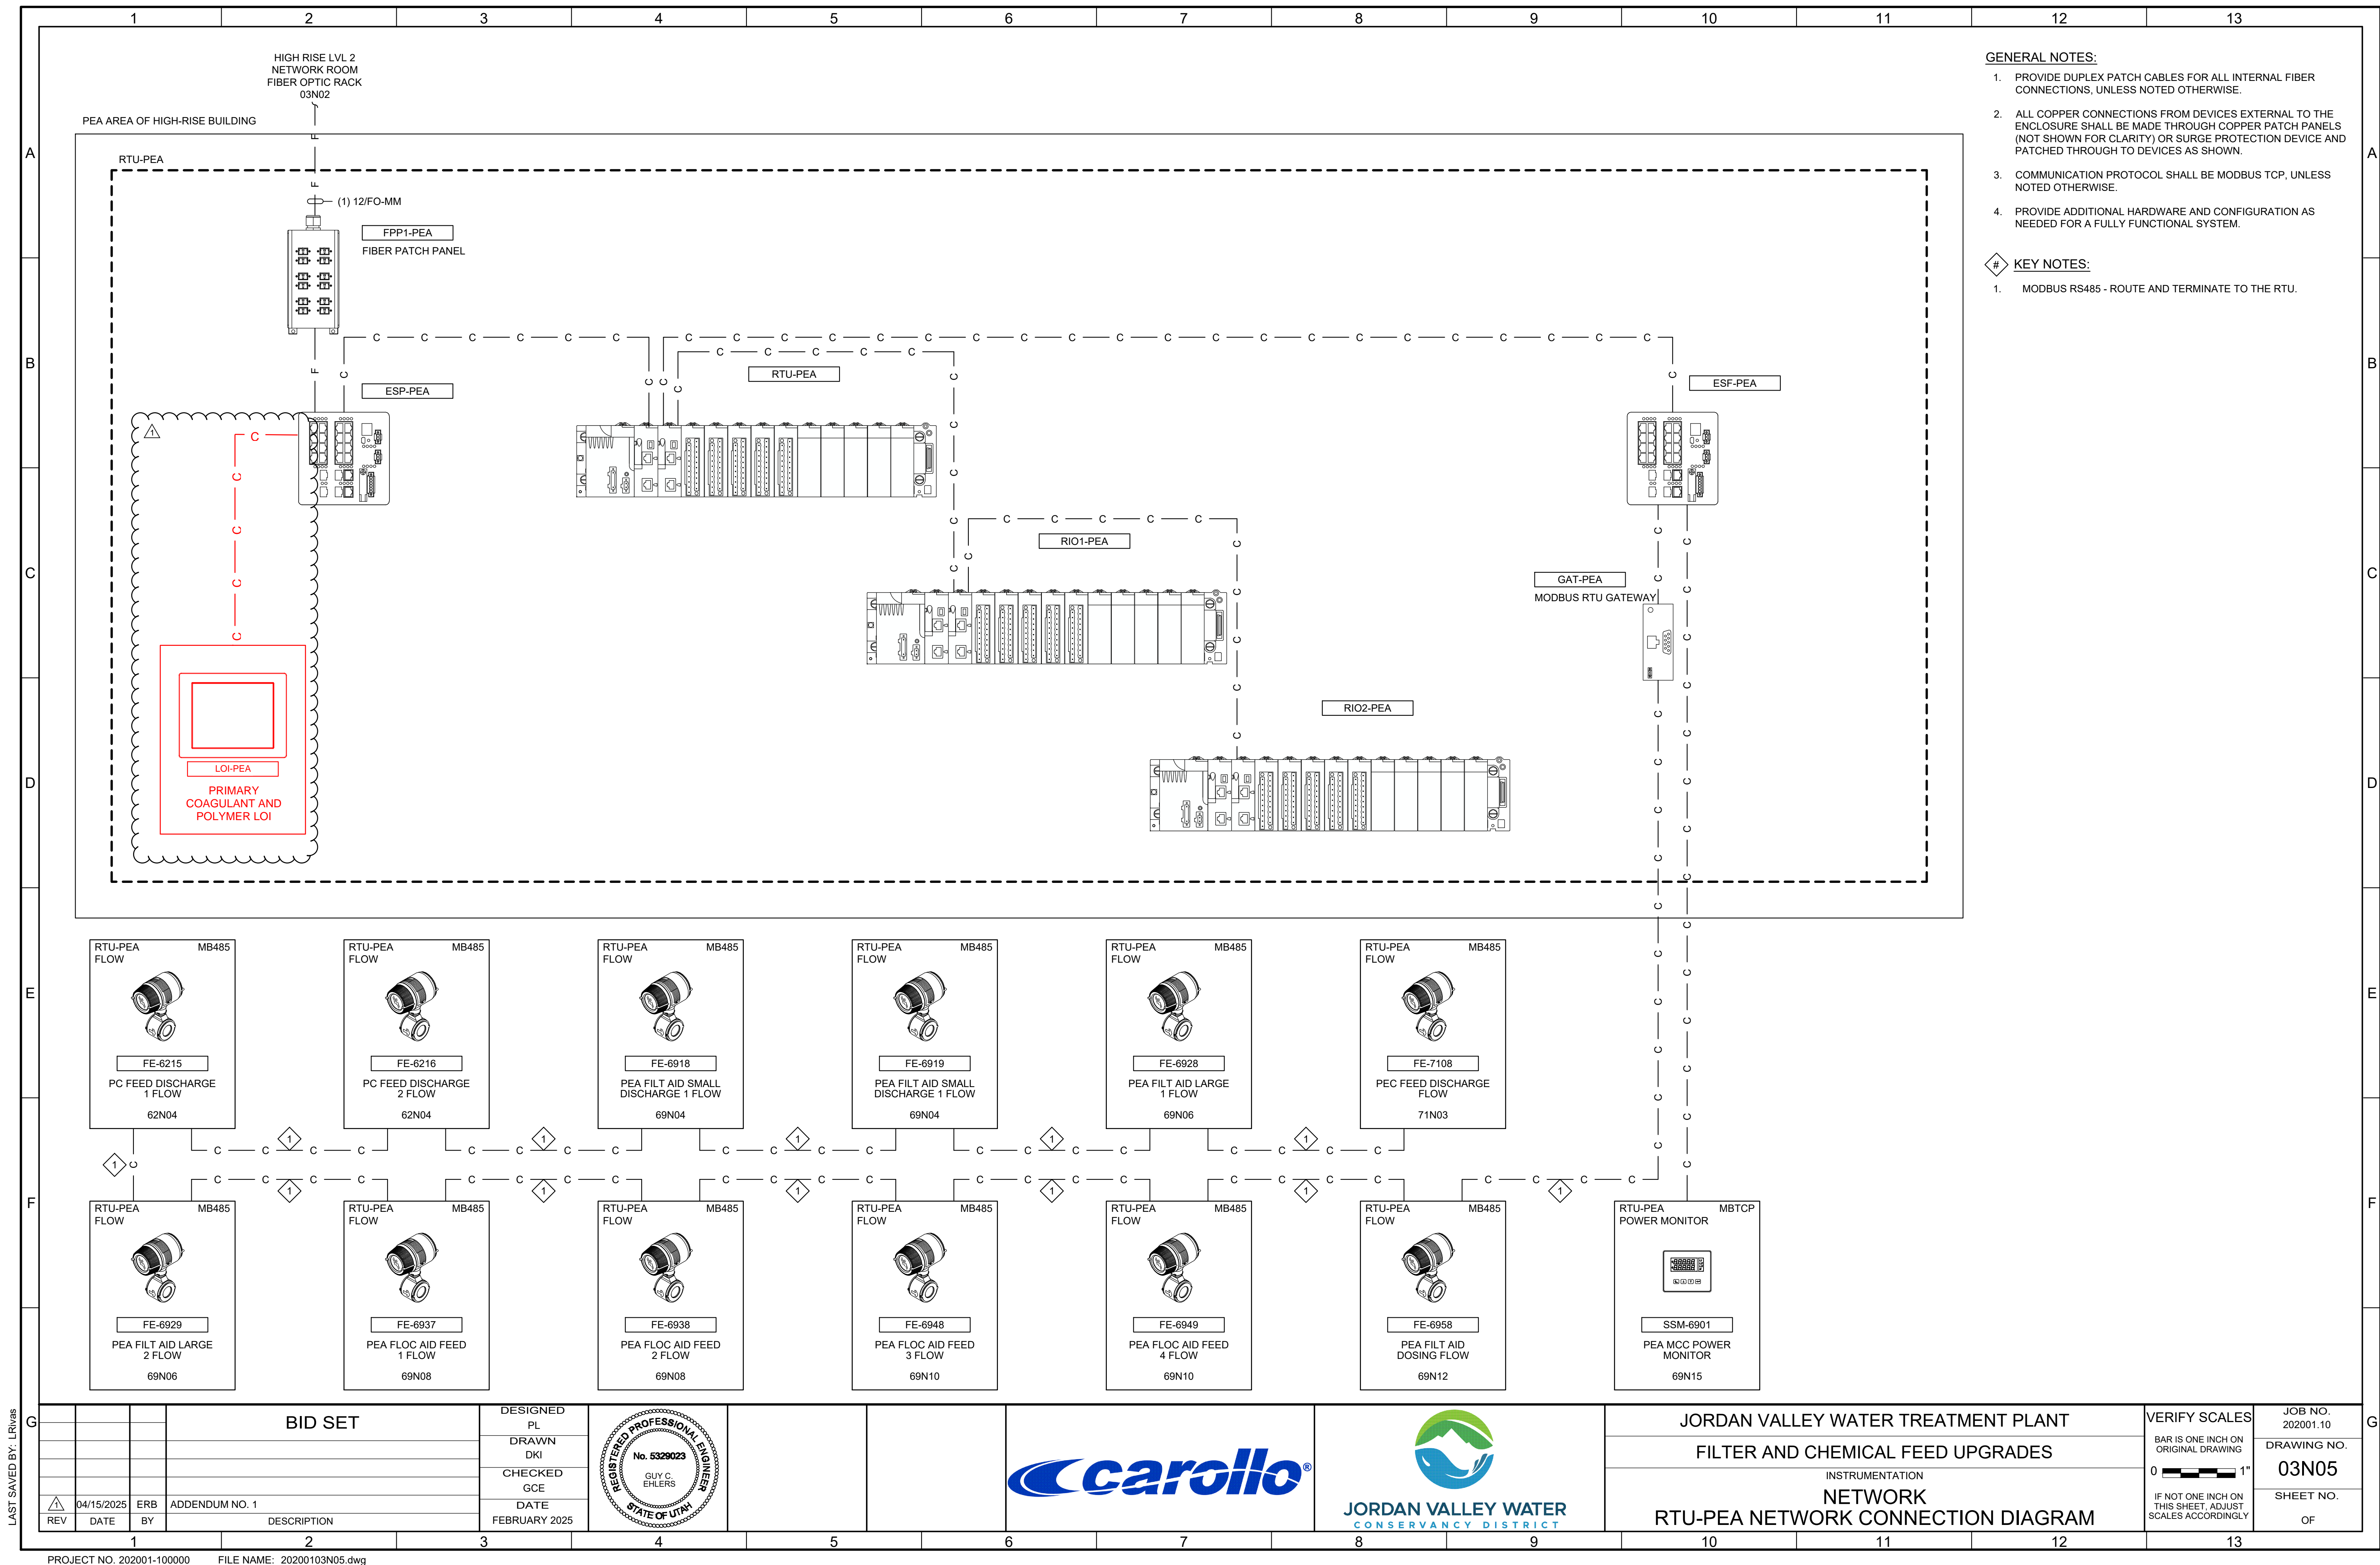

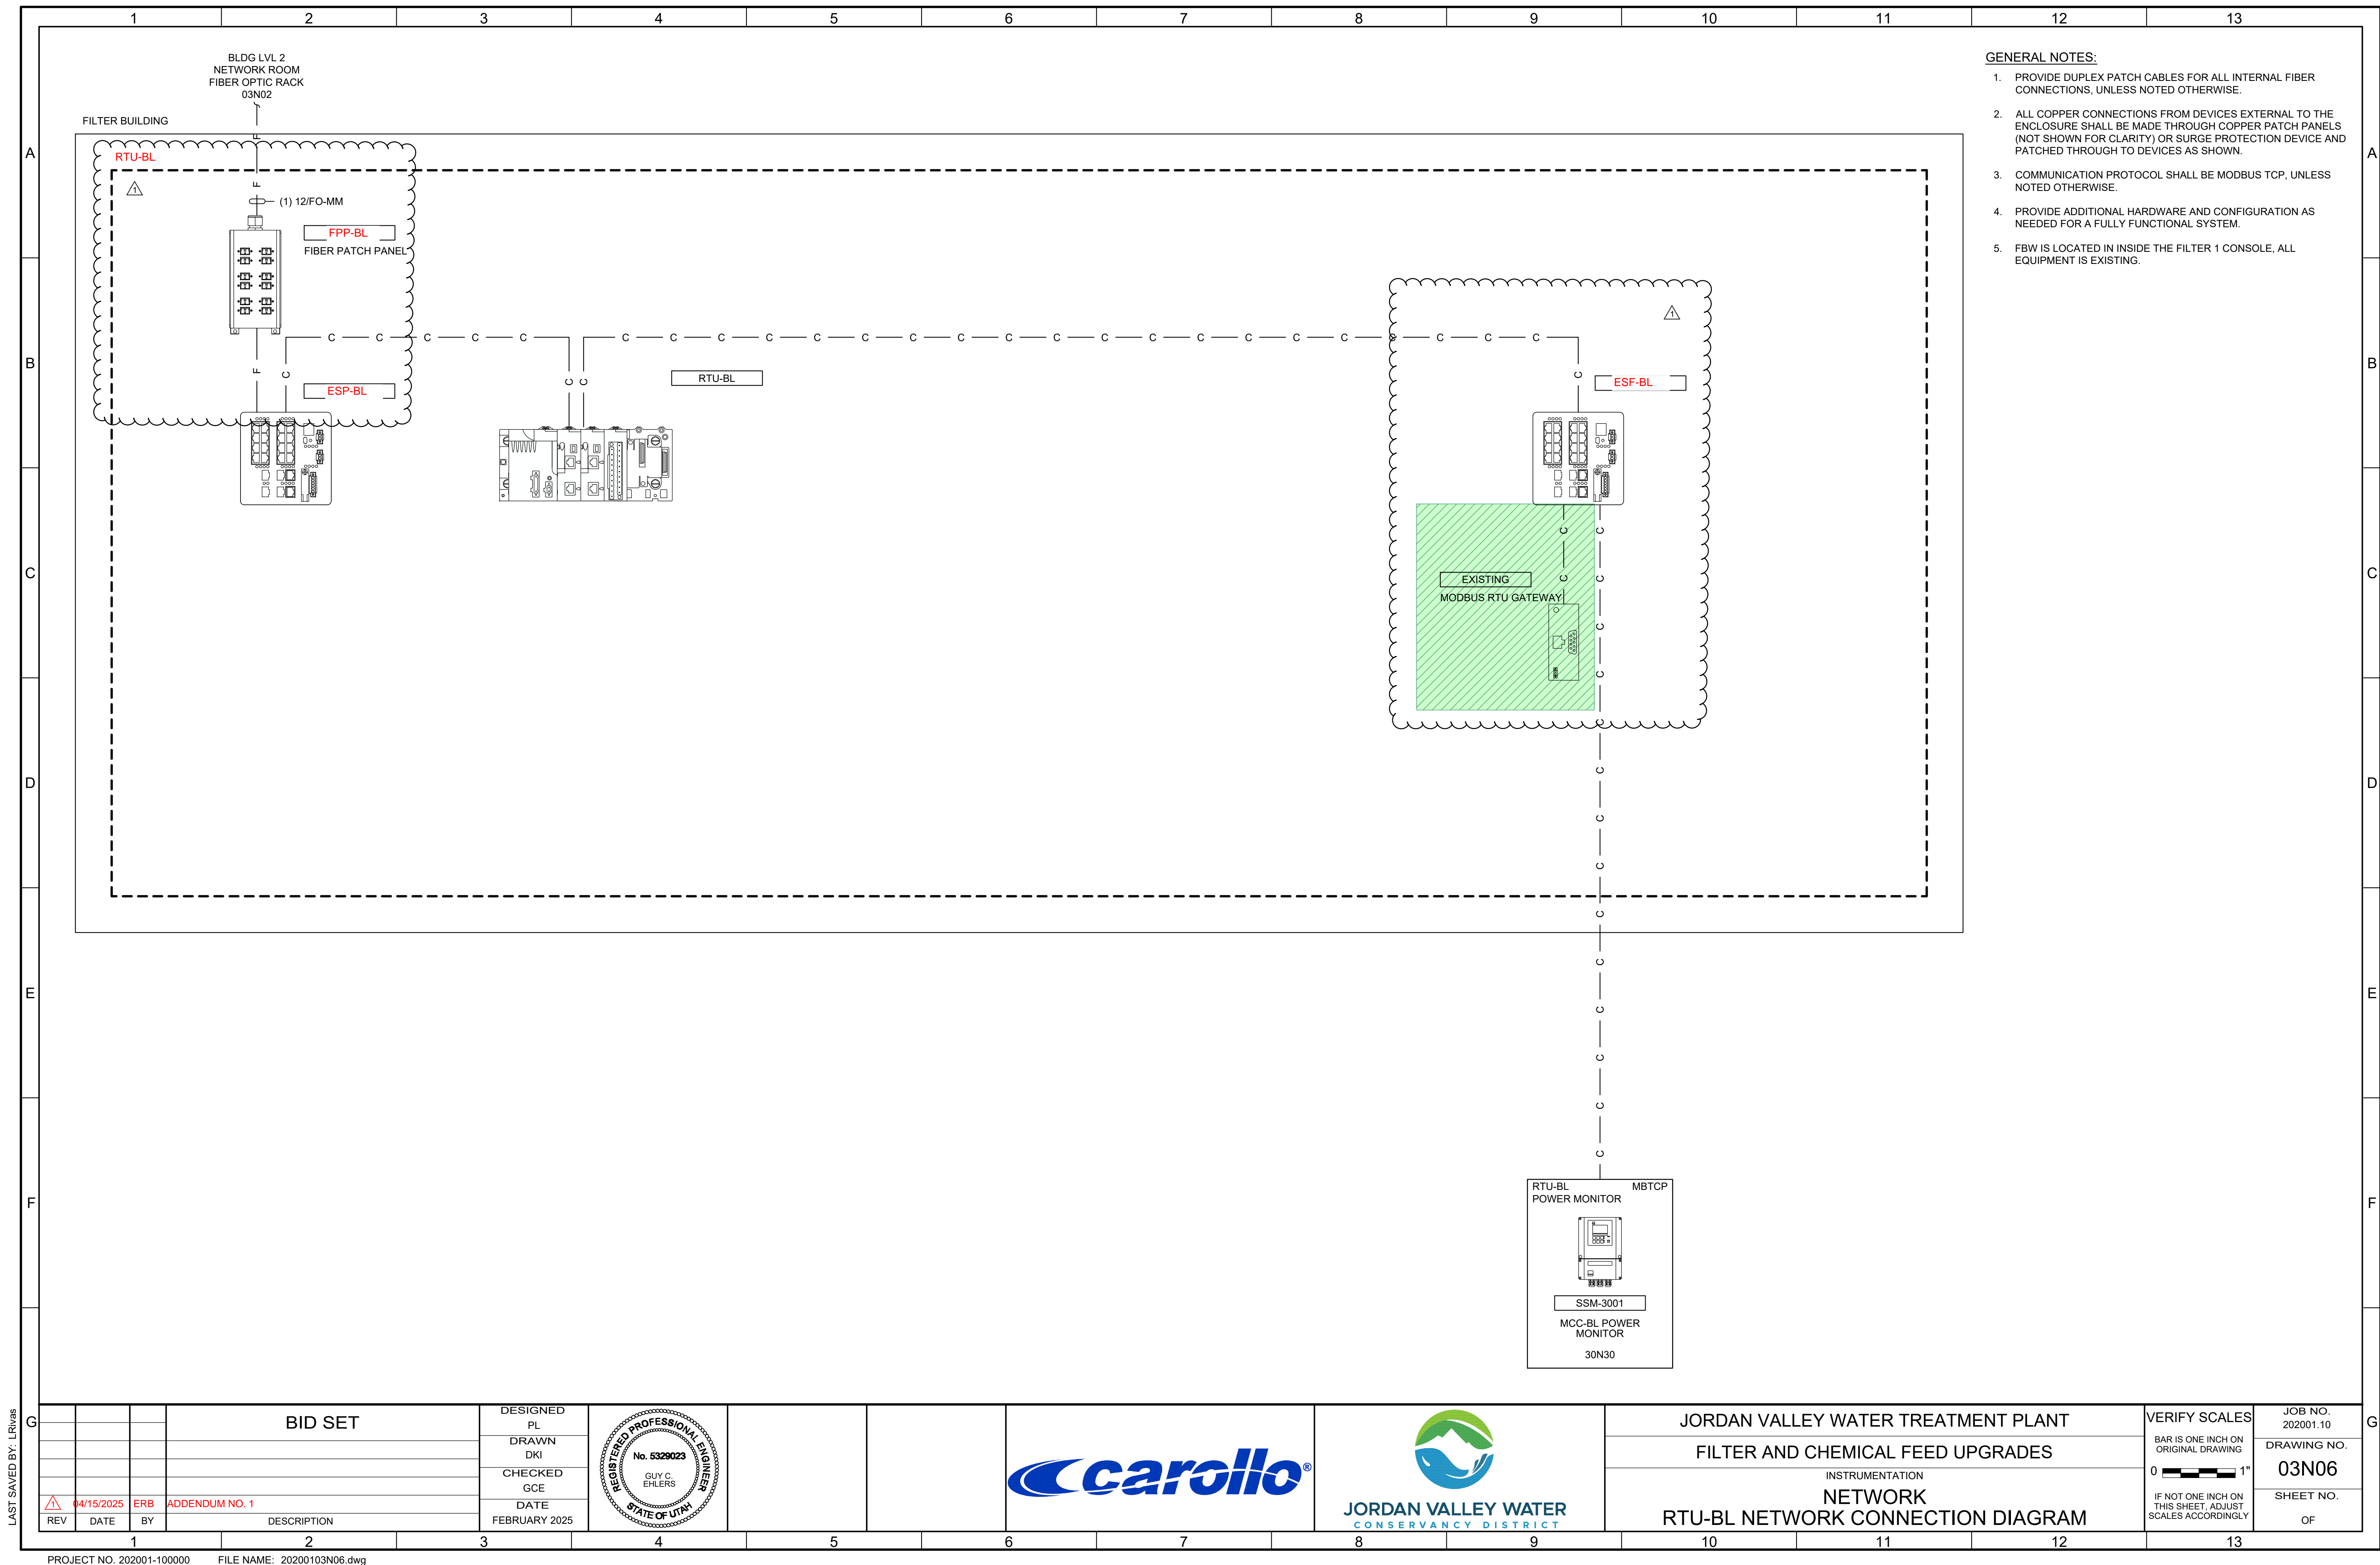

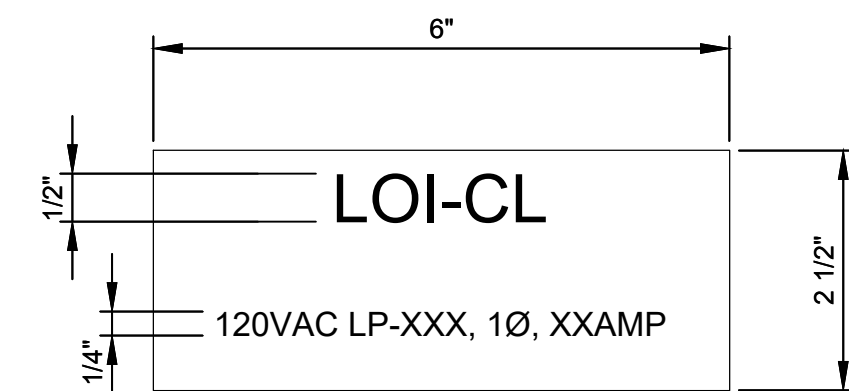


MAJOR EQUIPMENT SCHEDULE	
ITEM	DESCRIPTION
1	ENCLOSURE, SS304 NEMA 4X WALL MOUNT
2	OPERATOR TOUCHSCREEN
3	NAMEPLATE


4. NOT USED



REGISTERED PROFESSIONAL ENGINEER
No. 5329023
GUY C. EHLERS
STATE OF UTAH



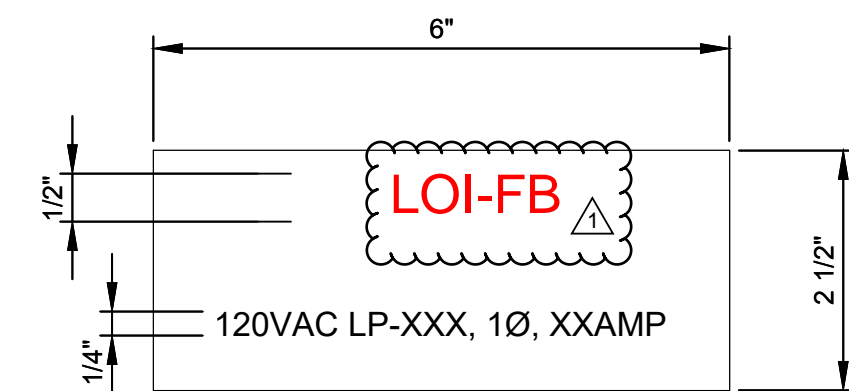

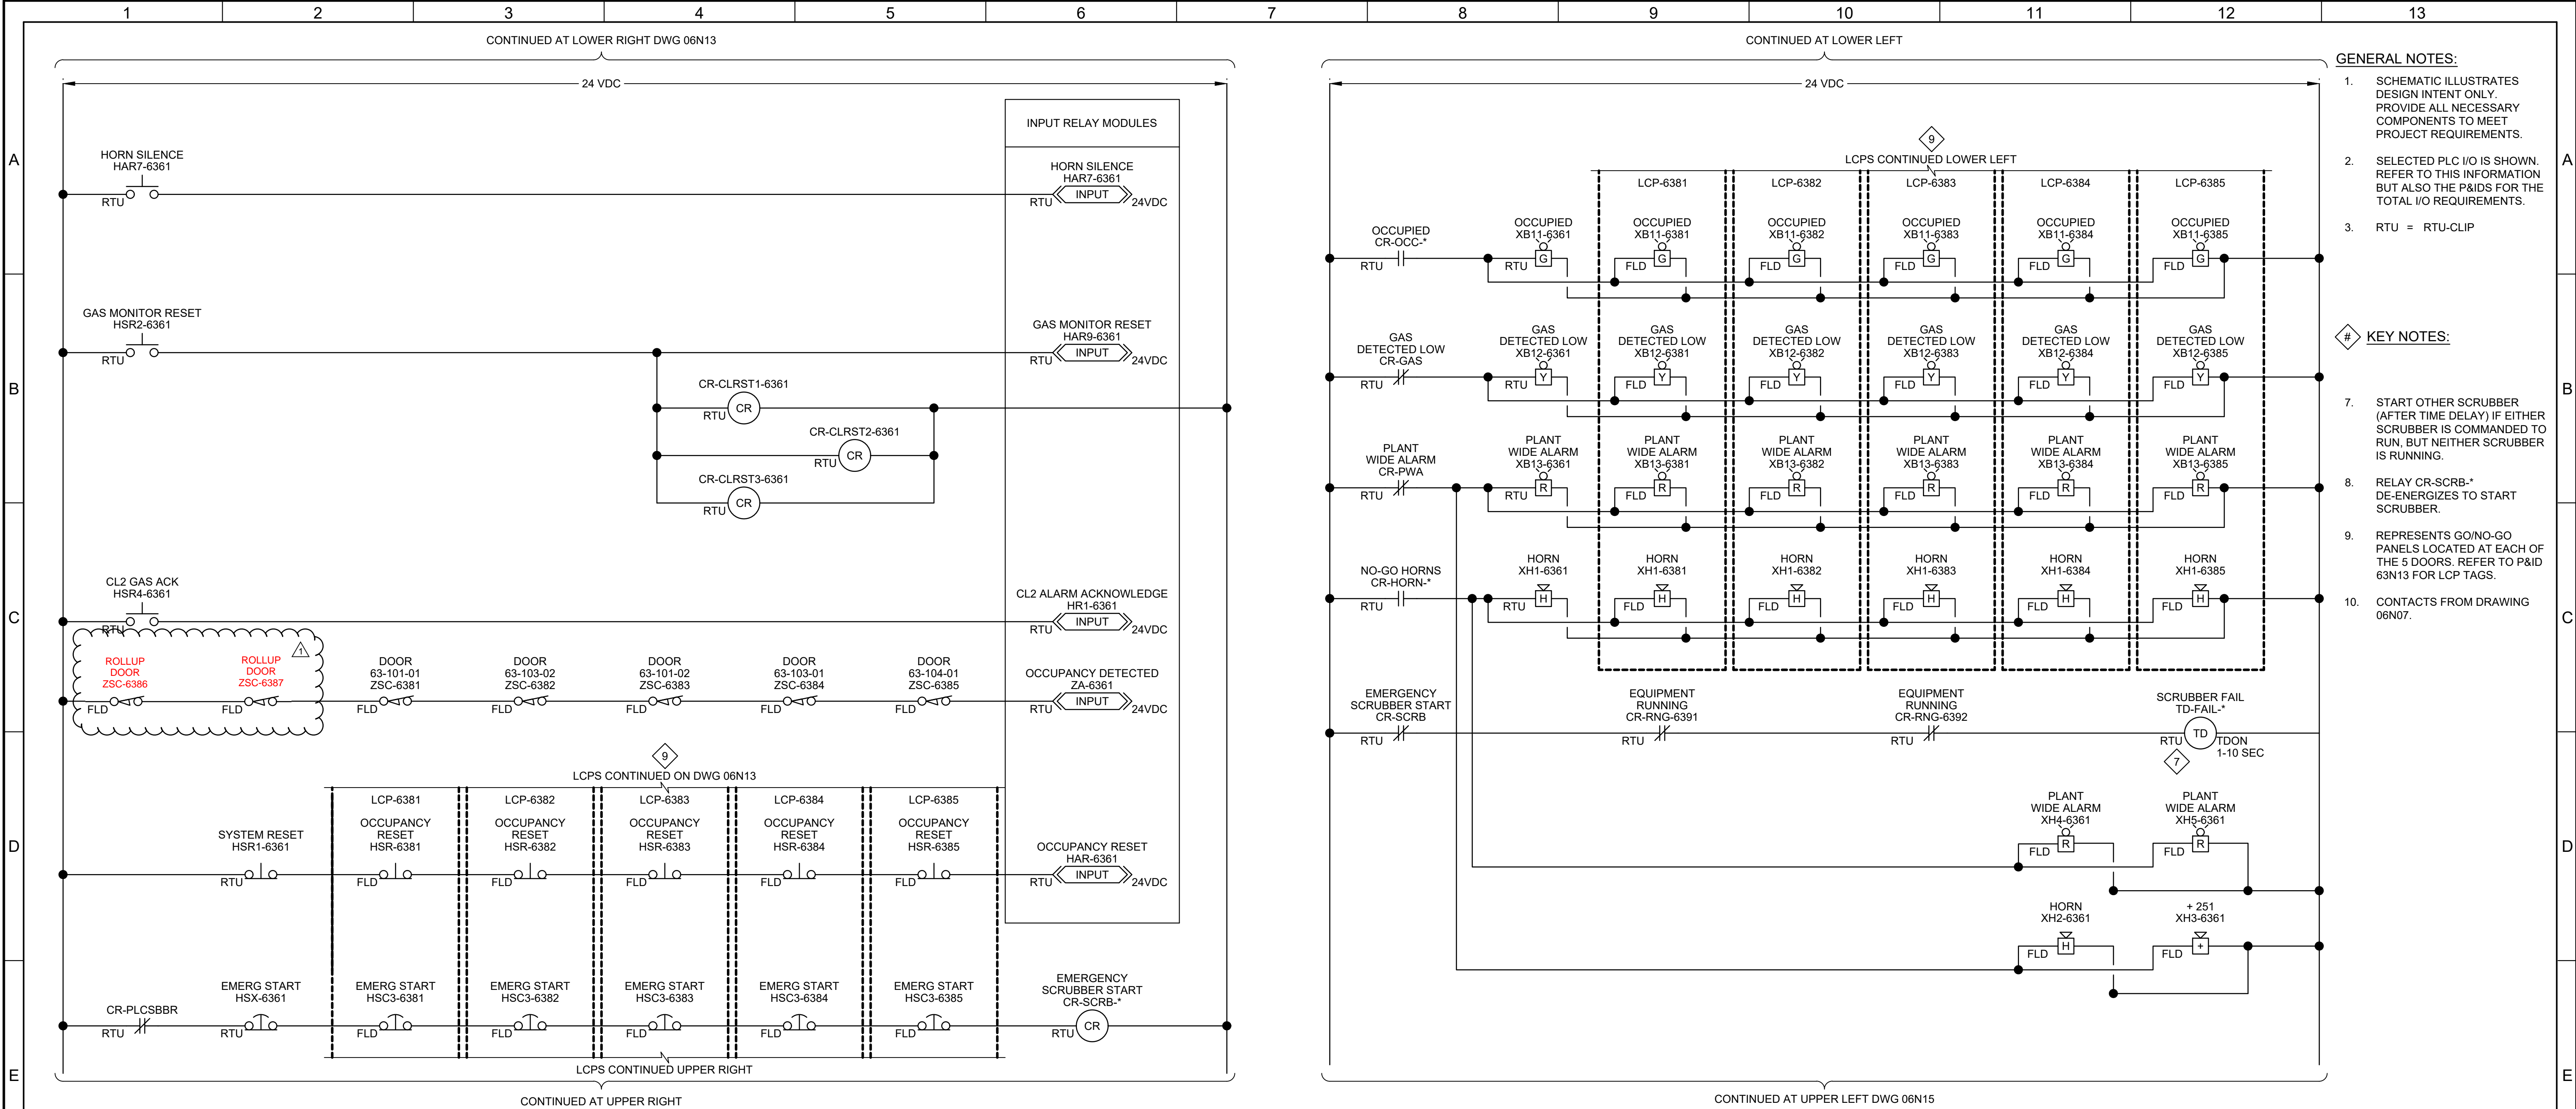

LAST SAVED BY: LRivas

CHLORINE MASTER GO/NO-GO CONT.

13B CONTROL SCHEMATIC


TAG ↔ LOOP
* = XXXX ↔ 6361

REFERENCE DWG.
63N SERIES P&IDS

LOCATION LEGEND

RTU RTU (PLC) PANEL
MCC MOTOR CONTROL CENTER
FLD FIELD DEVICE
LCP LOCAL CONTROL PANEL
STR FREE-STANDING STARTER
VFD FREE-STANDING VFD

BID SET				DESIGNED RJB								JORDAN VALLEY WATER TREATMENT PLANT	VERIFY SCALES	JOB NO. 202001.10
				DRAWN DKI								FILTER AND CHEMICAL FEED UPGRADES	BAR IS ONE INCH ON ORIGINAL DRAWING	DRAWING NO.
				CHECKED GCE								INSTRUMENTATION	0 1"	06N14
				DATE FEBRUARY 2025								CONTROL SCHEMATICS CHLORINE MASTER GO/NO-GO PART 2	IF NOT ONE INCH ON THIS SHEET, ADJUST SCALES ACCORDINGLY	SHEET NO. OF
1	2	3	4	5	6	7	8	9	10	11	12	13		

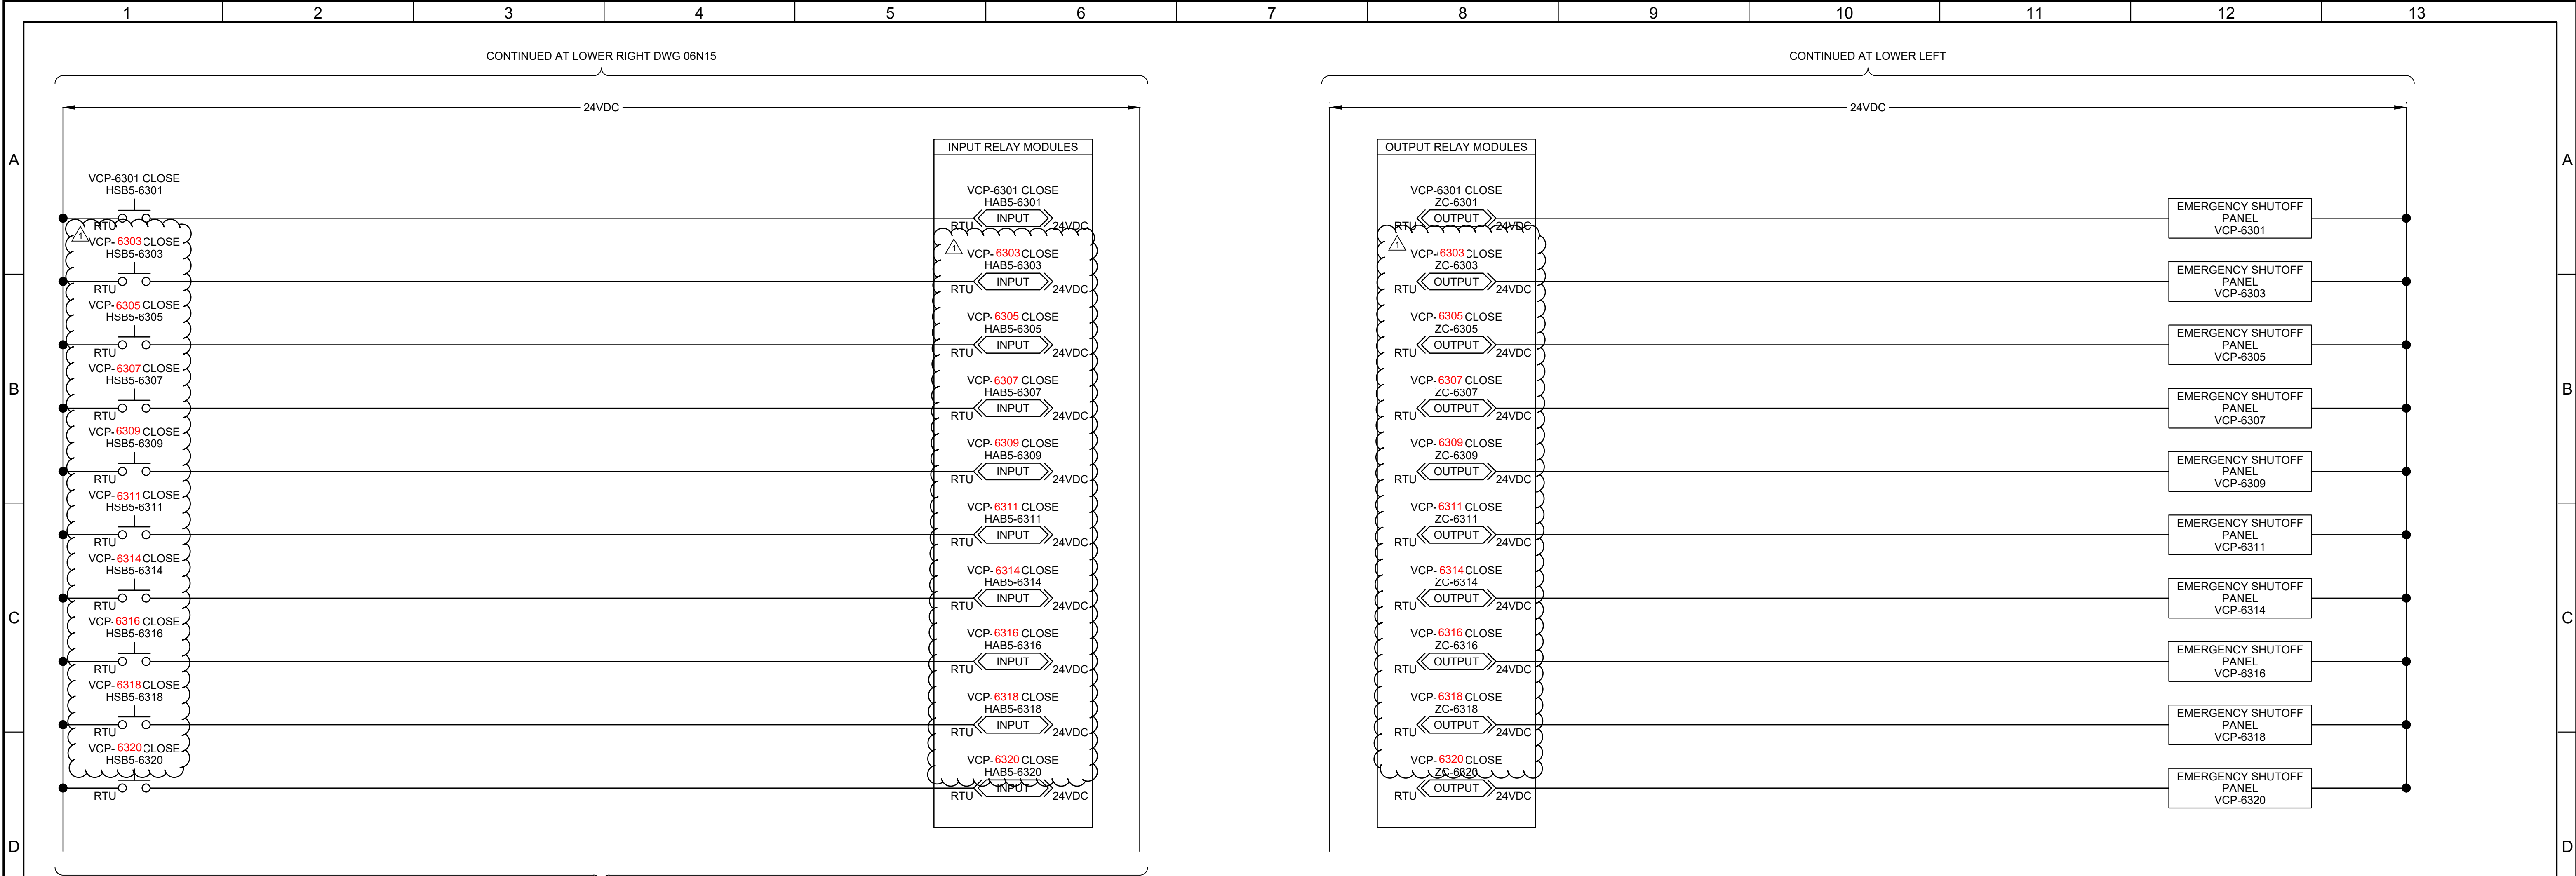

CHLORINE EQUIPMENT		SCRUBBER 1	SCRUBBER 2	CHLORINE CYLINDER VALVES	CHLORINE STORAGE	CHLORINE STORAGE	CHLORINE FEED	CHLORINE STORAGE	CHLORINE STORAGE	CHLORINE STORAGE	CHLORINE FEED	OCCUPIED STROBE (GREEN)	LOW GAS (YELLOW)	PLANT WIDE ALARM (RED)	PLANT WIDE ALARM (HORN)	ALARM SCADA
CONDITIONS	SET POINTS	BLR-6391	BLR-6392	6301 -6320	EF-6355	EF-6356	EF-6357	MAU-6354	LVR-6355	LVR-6357	LVR-6358	XB11-*	XB12-*	XB13-*	XH1-*	
NORMAL OPERATION	STORAGE TEMP < 84F	-	-	OPEN	ON	OFF	ON	ON	CLOSED	CLOSED	CLOSED	OFF	OFF	OFF	OFF	OFF
HIGH STORAGE ROOM TEMP	STORAGE TEMP > 85F	-	-	OPEN	ON	ON	ON	ON	OPEN	OPEN	OPEN	OFF	OFF	OFF	OFF	OFF
LOW LEVEL CL2 DETECTED	CL2 > 1 PPM	OFF	OFF	OPEN	ON	ON	ON	ON	OPEN	OPEN	OPEN	OFF	ON	OFF	OFF	ON
HIGH LEVEL CL2 DETECTED	CL2 > 3 PPM	ON	OR ON	OPEN	OFF	OFF	OFF	OFF	OPEN	OPEN	OPEN	OFF	OFF	ON	ON	ON
SMOKE DETECTED	SMOKE	OFF	OFF	OPEN	OFF	OFF	OFF	OFF	CLOSED	CLOSED	CLOSED	OFF	OFF	OFF	OFF	ON
STORAGE OR FEED ROOM OCCUPIED	OCCUPANCY DETECTED	-	-	OPEN	-	-	-	-	-	-	-	ON	-	-	-	ON
HIGH CO DETECTED	CO > 50 PPM	-	-	OPEN	ON	ON	ON	ON	OPEN	OPEN	-	-	-	-	-	ON
EYEWASH	FLOW DETECTED	-	-	-	-	-	-	-	-	-	-	-	-	-	-	ON
CLIP PANEL PILOT DEVICES																
ALARM ACK (HSR4-6361)	-	-	-	-	-	-	-	-	-	-	-	-	-	-	OFF	-
HORN SILENCE (HAR7-6361)	-	-	-	-	-	-	-	-	-	-	-	-	-	-	OFF	OFF
OCCUPANCY RESET (HSR1-6361)	-	-	-	-	-	-	-	-	-	-	-	OFF	-	-	-	-
SCRUBBER SELECT 1/2 (HSF-6361)	-	-	-	-	-	-	-	-	-	-	-	-	-	-	-	-
GAS MONITOR RESET (HSR2-6361)	-	-	-	-	-	-	-	-	-	-	-	-	-	OFF	OFF	OFF
EMERGENCY START (HSX-6361)	-	ON	OR ON	CLOSE	OFF	OFF	OFF	OFF	OPEN	OPEN	OPEN	OFF	OFF	ON	ON	ON

NOTES:
THE CHLORINE STORAGE CYLINDER VALVES WILL BE CLOSED MANUALLY BY OPERATIONS IN ALL CONDITIONS.
SEVERAL TEST MODES WILL BE REQUIRED IN THE PLC/HMI PROGRAMMING.
TEST MODE 1: PROVIDE A TESTING SEQUENCE FOR OPERATIONS TRAINING THAT ALARMS LOCALLY BUT NOT ENGAGE THE PLANTWIDE ALARMS, NOR DOES IT START THE SCRUBBERS.
TEST MODE 2: IS EQUIPMENT TEST FOR MAINTENANCE - THIS MODE ALLOWS EQUIPMENT TESTING AND SHOWS ALL STATUS BUT DOES NOT GENERATE ANY ALARMS.
TEST MODE 3: IS A MODE FOR TESTING AND CALIBRATION ALL THE GAS SENSORS AND INCLUDES SUPPRESSION OF ALL ALARMS.

TAG ↔ LOOP
* = XXXX ↔ 6361

REFERENCE DWG.
63N SERIES P&IDS


LOCATION LEGEND


RTU RTU (PLC) PANEL
MCC MOTOR CONTROL CENTER
FLD FIELD DEVICE
LCP LOCAL CONTROL PANEL
STR FREE-STANDING STARTER
VFD FREE-STANDING VFD


CHLORINE MASTER GO/NO-GO

13D CONTROL SCHEMATIC

																																																																																																																																																																																																																																																																																																																																																																																																																																																																																																																																																																																																																																																																																																																																																																																																																																																																																																																																																																																																																																																																																																																																																																																																																																																																																																																																																																																																																																																																																</
--	--	----

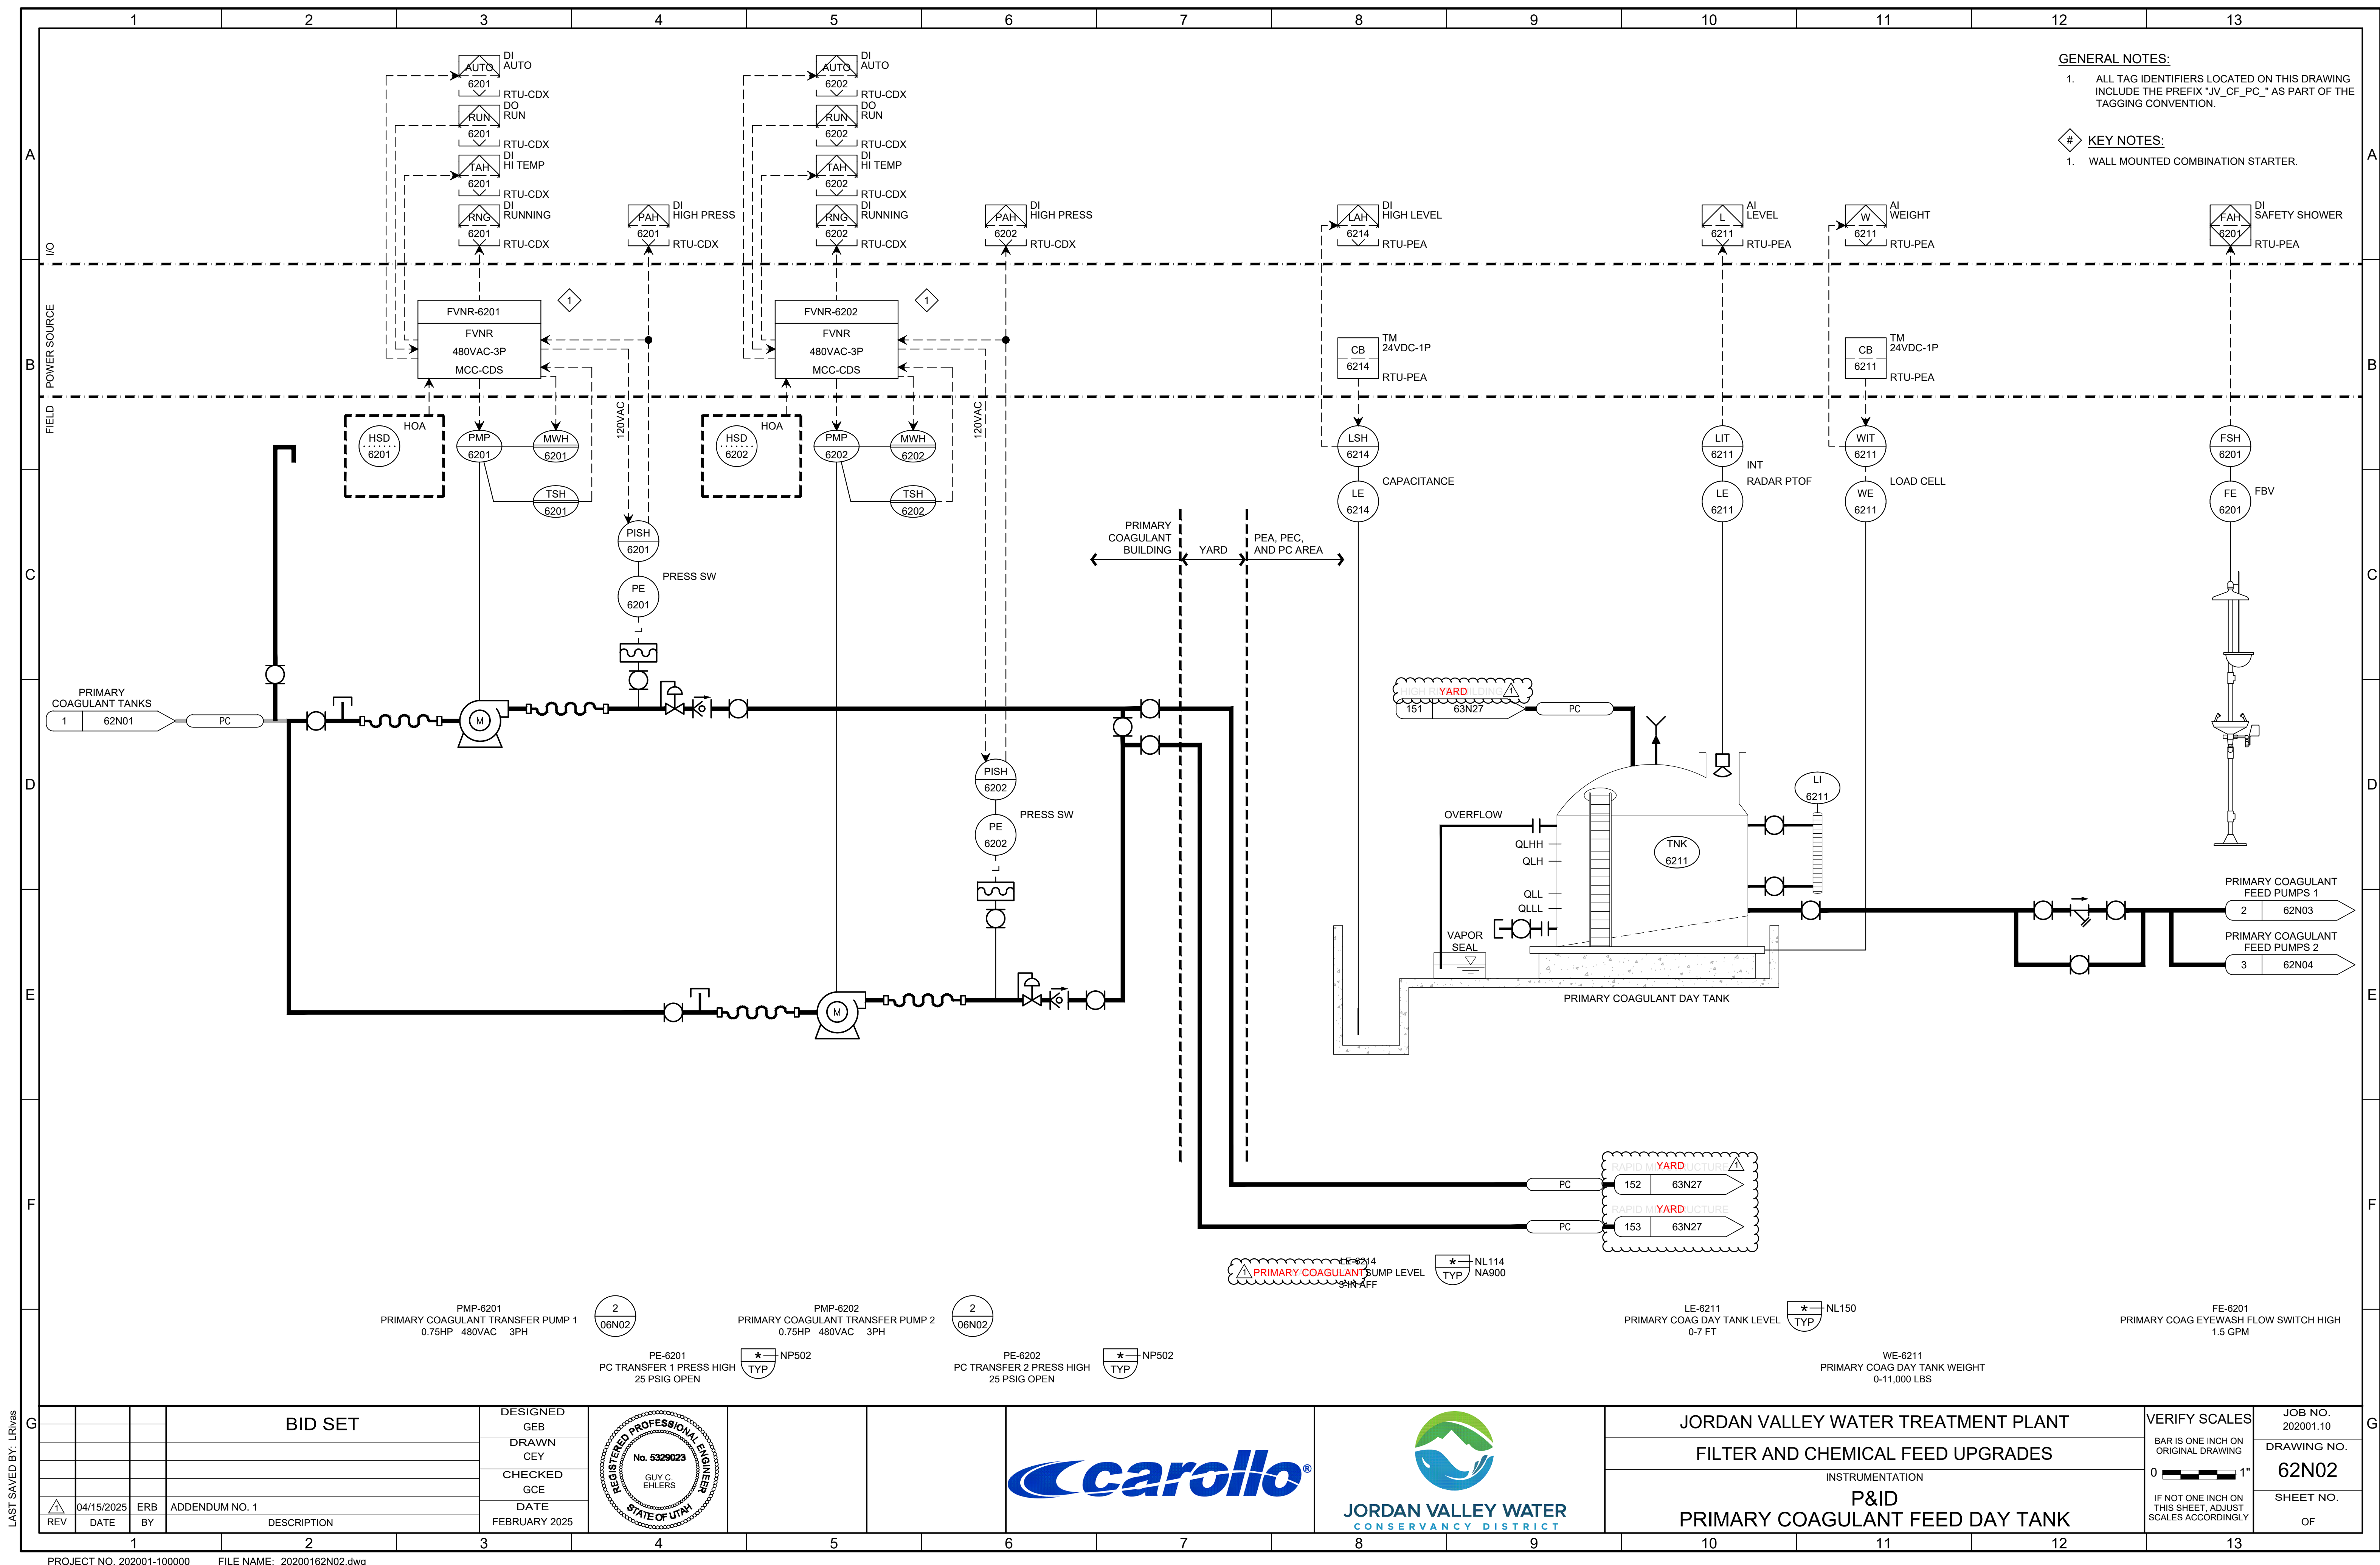

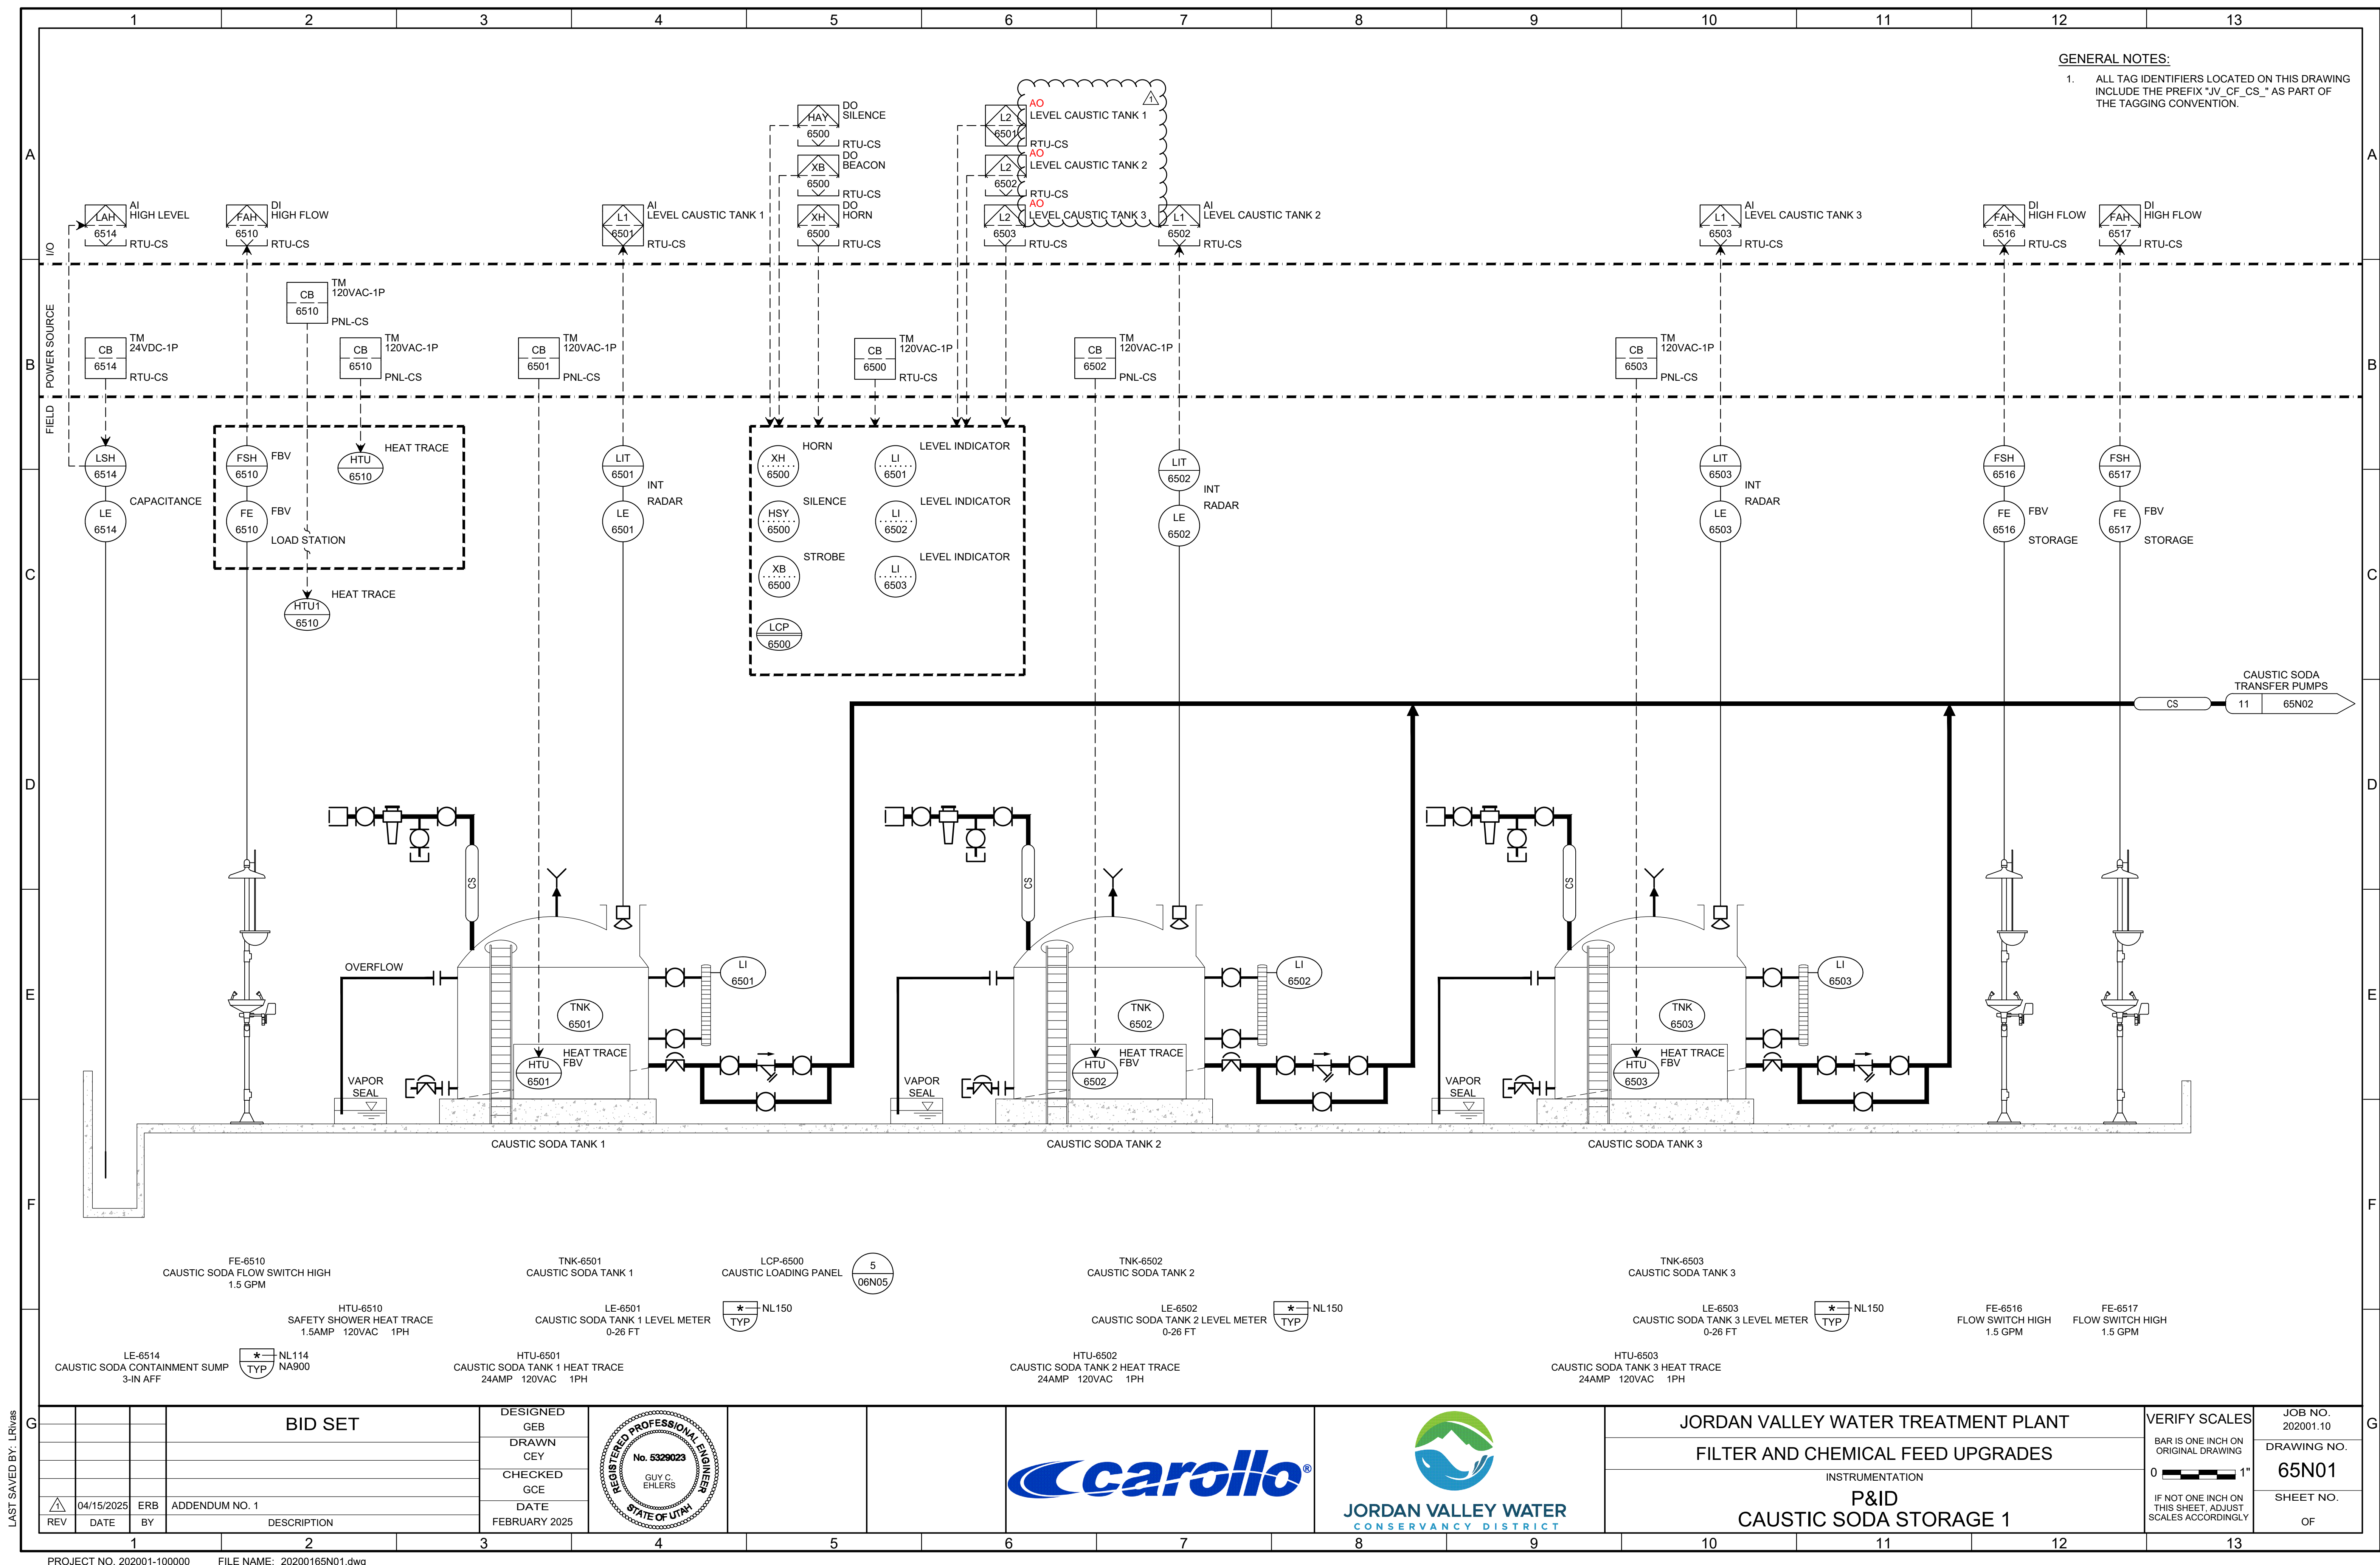

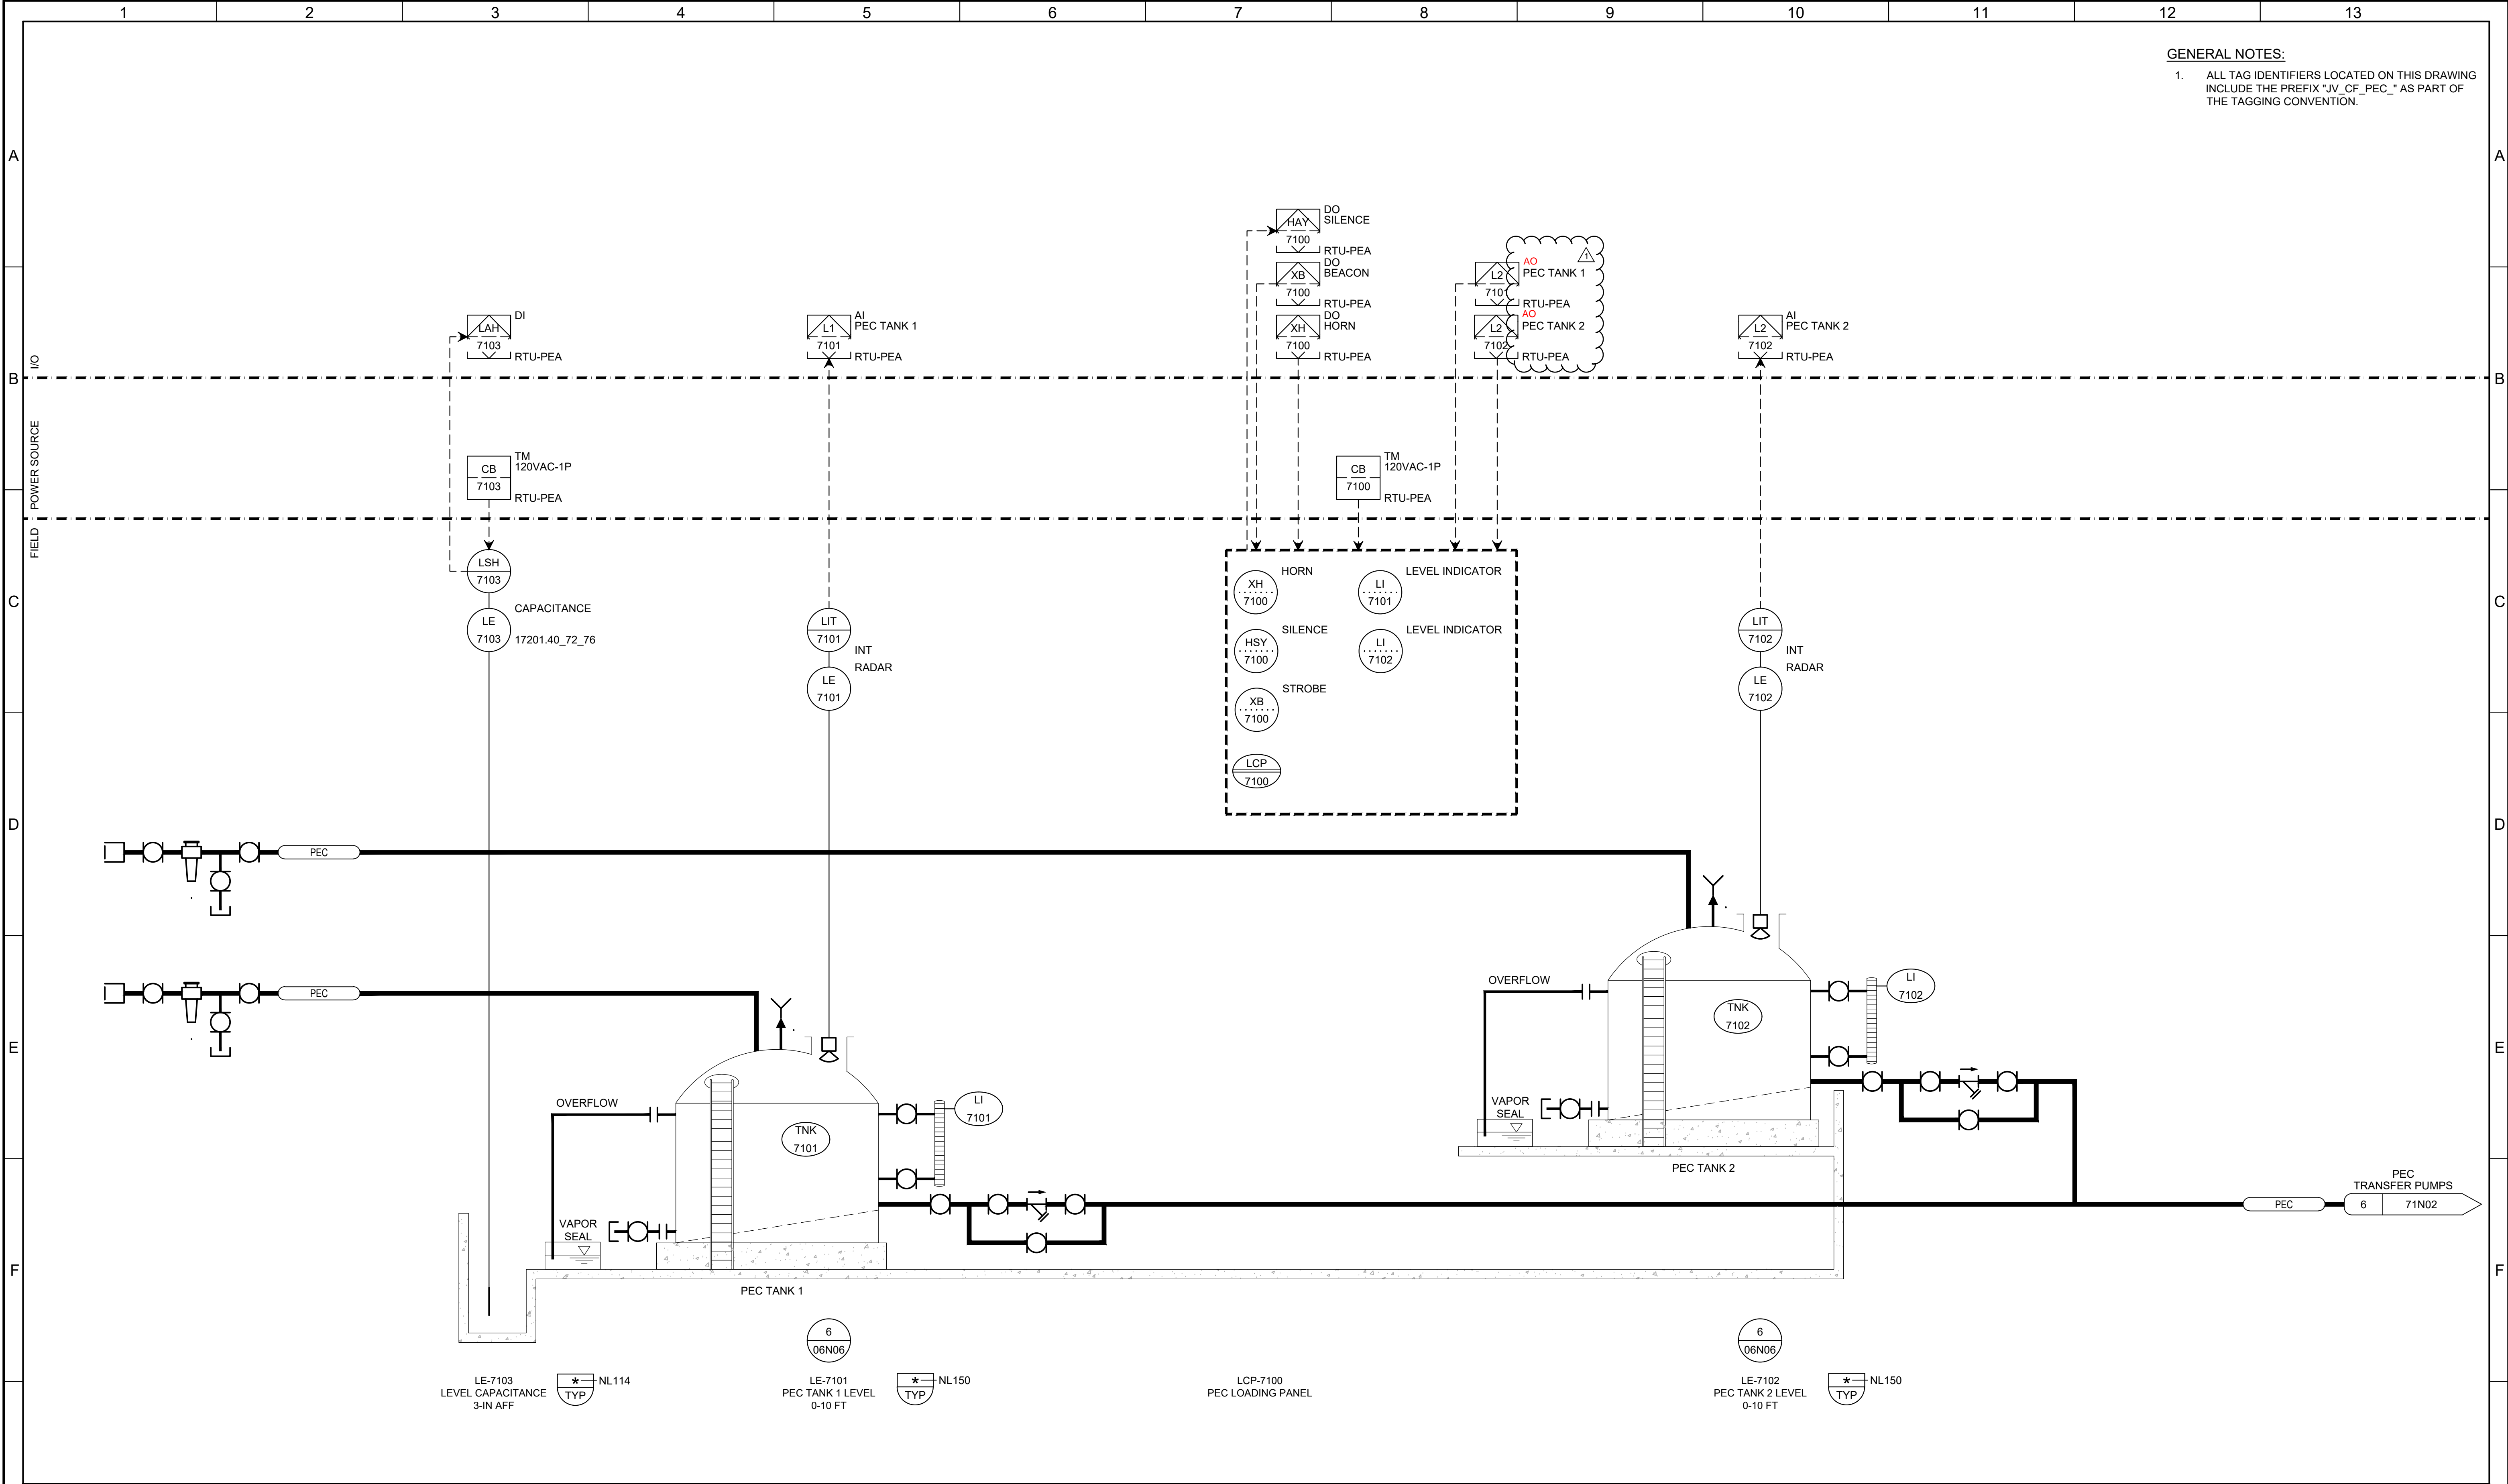

BID SET				DESIGNED GEB						JORDAN VALLEY WATER TREATMENT PLANT			VERIFY SCALES	JOB NO. 202001.10
				DRAWN CEY						FILTER AND CHEMICAL FEED UPGRADES			BAR IS ONE INCH ON ORIGINAL DRAWING	DRAWING NO. 71N01
				CHECKED GCE						INSTRUMENTATION			0 1"	SHEET NO.
				DATE FEBRUARY 2025						P&ID PEC FEED STORAGE			IF NOT ONE INCH ON THIS SHEET, ADJUST SCALES ACCORDINGLY	OF
1	2	3	4	5	6	7	8	9	10	11	12	13		



JORDAN VALLEY WATER TREATMENT PLANT FILTER AND CHEMICAL UPGRADES
JORDAN VALLEY WATER CONSERVANCY DISTRICT
WEST JORDAN, UTAH

Bidder RFI Responses
April 16, 2025

No.	Question	Response
1	I had a question for you regarding specification section 13206A, FRP Storage Tanks for Jordan Valley. I represent Diamond Fiberglass and we're hoping to bid on this project. Would you see any issue with them bidding? They were specified/named by Carollo for the TSSD Package B project. Also, Diamond let me know that Ershigs and Belco (the two named manufacturers) are now part of the same company (NOV) and Ershigs isn't making tanks anymore, so effectively, the only named bidder would be Belco. Would you consider naming Diamond by addendum? Or is it better to just go through the bid as an "or equal"? I'm not sure what your preference is	Any manufacturer that meets Specification 13206 requirements, including ASME RTP-1 certification outlined in 1.05.C and 2.02.A, can be submitted as an 'or equal'.
2	1. Shall all excavation spoils be exported to off site or is there room on the property to waste the spoils?	Please refer to specification section 01537-Erosion and Sediment Control, 3.01E, which states: If a Project spoil site is not indicated on the Drawings, dispose of sediment off site at location not in or adjacent to stream or floodplain. 2. Assume responsibility for off-site disposal. Please also reference specification section 02300 - Earthwork 2.01, which states: Obtain acceptable import material from other sources if surplus obtained within Project site does not conform to specified requirements or are not sufficient in quantity.
3	2. Please clarify Specification "General Conditions, 6.06 Permits" it appears that permit fees shall be paid by the Contractor. Is there a list of required permits/ permitting agencies and or a list of expected costs for the permits?	General Conditions section 6.06 describes requirements for SWPPP compliance but does not contain an exhaustive list of all permits that may be required. It is the contractor's responsibility to determine all permitting requirements. A building permit with the City of Herriman will also be required. Any planned dewatering activities will also require a permit with the State of Utah DEQ. Please refer to section 01410 for a list of authorities having jurisdiction and contact these authorities directly for all costs and requirements.
4	3. Will the Owner Provide and Pay for Construction Water and Power or shall the contractor add it to the cost of construction?	Please refer to specification section 01500 - Temporary Facilities and Controls: Under the subsection "1.04 TEMPORARY UTILITIES", it states: A. Temporary electrical power: 1. Arrange with the Owner to provide adequate temporary electrical service. Owner will supply the electricity from its facilities for the Contractors use in connection with the performance of the Work at no charge to Contractor. B. Temporary water: 1. Arrange with the Owner to provide adequate temporary water service for the Work. Owner will supply the water from its facilities for the Contractor's use in connection with the performance of the Work at no charge to Contractor.
5	4. Some areas requiring demolition have existing overhead trollies and cranes, may the contractor use these to assist with demolition?	Use of any available overhead trollies and cranes is allowed; However, the district cannot guarantee the condition of this equipment, or the suitability of this equipment to meet the contractor's needs. If an overhead trolley or crane is damaged by the contractor during the work, the contractor will be responsible to make the necessary repairs.
6	5. Will demolished items remain the property of the owner or shall the contractor be responsible for disposal of demolished items. If some items are to be conveyed to the owner please provide a list and a location where the Owner will receive them.	Section 01738 - Selective Alterations and Demolition: Under part 3, subsection 7 states: "Assume possession of materials unless otherwise indicated on the Drawings or specified." Demolition drawings describe the valves and instrumentation that should be salvaged to owner (for example see 69D01 Key Note 1). No location is provided for this, as each piece of equipment salvaged to the owner should be handed directly to district operations or maintenance personnel.
7	6. When needed, will the Chlorine Cylinders be removed by the Owners personnel or shall the contractor be responsible to move them. If the Contractor will move them is training required, where is training available? Where shall the cylinders be delivered?	Please refer to specification section 01140 - Work Restrictions, L.5, where it states that "Owner will be responsible for delivery, handling, or moving of chlorine gas cylinders. Contractor shall coordinate timeframes with Owner."
8	How will contractors personnel and deliveries be given access to the site through the gate / security system?	A paragraph has been added to 01140 - Work Contraints and 01500 - Temporary facilities and Controls defining additional requirements for Contractor access to the site.
10	The O&M manual for the existing gate is referenced as being attached to the supplemental general conditions, but was not found at this location	Referenced location for the O&M manual has been updated to reference its location. Please see Appendix C.
11	Several months ago we established that a booster pump isn't required for the PAC system and the specification generally doesn't acknowledge it. However, there are two sections that list it: 13270 – 2.05.K.2. and 2.05.N.9. Can you confirm if this is intentional? If not, can you confirm it needs to be deleted?	These references have been removed from Specification 13270 in this addendum.
12	The Bid Allowance for the Dust Hazard Analysis lists item 5 has an electrically actuated knife gate. Chemco can supply this as electric or pneumatic. An electric valve will cost more due to the expense of the Class II, Div. 1 Group F hazard rating on the actuator. The primary concern and operation that Carollo/Jordan Valley need to be aware of is an electric valve will close much slower than a pneumatic valve. The electric valve will have a motor that will rotate a helical screw to move the knife gate open/close. This action can take up to 10 seconds or longer. A pneumatic knife gate uses compressed air to actuate a rod-cylinder-assembly and the actuation occurs in less than second. Considering this valve is for DHA safety, it makes more sense to Chemco that this should be pneumatic. Especially because we will have compressed air routed throughout the silo. Please confirm Carollo/Jordan Valley preference. At this time, I plan to submit pricing for both in the event a decision is not made.	The specification has been adjusted in Division 0 Section C-3 of this addendum to include a pneumatically actuated knife gate instead of electrically actuated.
14	Is it possible to ask the engineer if we can get the conduit schedules in an Excel format. Specs 4 of 6 Section 16990A, B, C, D, E, F, G, H, J, and K.	Yes, a contractor version can be made available.
16	Please clarify if 'MCC-B1' on sheet 03E14 is the same as 'MCC-B' on sheet 30E19.	Yes, MCC-B and MCC-B1 are the same. MCC-B1 is the correct designation.
17	The Utility Transformer and metering on the top center of sheet 03E02 is shown in dark print. Will this Transformer be newly provided by the EC? Please clarify the work connected with this Transformer shown in dark print.	Utility metering/transformer are existing. No new work for this project.
18	Please confirm that the EC will be responsible for providing and installing MV 'XFMR-APF'. See sheet 03E02.	XFMR-APF on sheet 03E02 will be new. The Contractor is responsible for the work. How it is broken up between the general and sub is up to the Contractor.
19	Will 'XFMR-APF' require a vault or will a pad be sufficient per key note #1 on sheet 01E05?	A pad will be sufficient.
20	Please refer to Plant Area Electrical Material Requirements 16050-5 Table 1. Please clarify which Electrical rooms will require Nema 12 Enclosures.	Where NEMA Type 12 is listed in a specification it may be used in Electrical Rooms, for example formed steel enclosures in specification section 16134.
21	Please clarify if 'PANEL UPS-S' on sheet 71E02 is new or existing. If new, please provide a One-Line diagram for equipment size and connections.	Panel UPS-S is existing.
22	Please provide locations for 'PNL-PEA' & 'PP-PEA'. It appears that these should be located on sheet 71E02, but they are not shown.	PNL-PEA and PP-PEA will be shown on 71E02 by addendum.
23	UPS-CL' appears on sheets 03E20 & 03E22. Please clarify that 'UPS-CL' on sheet 03E22 should be named 'UPS-CS'. Please clarify if the rating for this UPS should be 12.5 KVA.	UPS-CL' on sheet 03E22 should be named 'UPS-CS', and is rated 12.5 KVA.
24	Please clarify who is responsible for providing and installing Process Piping and Equipment Heat Tracing.	The bidding Contractor has the ultimate responsibility to deliver the scope of work described in the contract documents. How the job is broken out by trade/sub is means & methods determined by the Contractor.
25	Will there be any Gutter Melt required for roofs, gutters and downspouts of the new buildings? Please clarify.	No, Gutter Melt is not required for new buildings.
26	Please clarify what will be required for cable management and fire tape in Medium Voltage Vaults and Pull Boxes.	The cable can lie on the floor of the medium voltage pull box. Fire tape is not required.
27	Who will be responsible for cutting and demolishing existing Concrete and Asphalt for Duct Banks and Underground conduits on the Site?	The bidding Contractor has the ultimate responsibility to deliver the scope of work described in the contract documents. How the job is broken out by trade/sub is means & methods determined by the Contractor.

28	Please Clarify if any Fire Alarm systems will be required. If so, please provide Manufacturer information and locations of existing Fire Alarm systems for integration purposes.	Fire alarm systems will not be required.
29	Please provide an Instrument list for the Process Instruments.	Each instrument (not provided by a vendor or indicated as FBV on the P&IDs) has a data sheet with the detailed information located at the end of each instrument spec.
30	HVAC Control wiring is not shown for the T-stats on the drawings or in the conduit/cable schedule, however some control wiring is shown in the P&ID's. Please clarify who is responsible for providing and installing HVAC control systems.	Mechanical contractor is responsible for control wiring between HVAC equipment and control device. Refer to specification section 15500-2.02.A.2 and section 15936-3.02. Electrical contractor is responsible for control wiring from HVAC equipment and/or devices that is connected to RTU (PLC). Refer to specification section 16990 for conduit schedules.
31	Please provide a set of Typical Details for this project.	Typical details are provided at the beginning of each disciplines drawing set, in Volume 6 of the bid set.
32	Please confirm that all Medium Voltage cables will be Concentric Neutral type per spec section 16124-4 2.05-B-7.	Yes, section 16124 applies to all medium voltage cables.
33	Please clarify the Scope of work required by the EC for Access control and CCTV security systems.	Please refer to General Note 2 on the Security Plan drawings.
34	The room finish schedule indicates that the exposed structural members and deck be "Coated" My question is it the intent of the engineer to use system 3.07 E and G in Specification 09910 or system EPU-M-1 or EPX-M-1.	Attachment A in Specification 09960 has been adjusted to clarify which surfaces will require coating with EPX-M-2.
35	The finish schedule on drawing 00GA01 indicates that the floor finish for the floors in the Chlorine Storage Room, Chlorinator Room, Cuastic Soda Metering Area and Caustic Soda Bulk Area to be clear sealer. Painting specification in Attachment B, Coating Detail Sheet for System VE-C-1 is a Vinyl Ester coating for secondary containment. My question is: Should any of the above rooms have the scheduled floor sealer be changed to the Vinyl Ester system considering the chemicals used in those rooms?	The Caustic Soda Bulk Area and Caustic Soda Metering Area should be coated in vinyl ester per Attachment B. See revised drawings
36	The finish schedule for the rooms in question one indicates that the wall finishes is "Coating" The only coating in the painting specifications is Section 09910 System 3.07 A which is a "Latex, semi-gloss". On similar projects we have applied high performance water borne epoxies or solvent based epoxy. My question is: Is the latex semi-gloss the correct wall coating for those rooms or should a chemical resistant epoxy for added for extra wall protection for those rooms?	The latex, semi-gloss painting is the correct wall coating for all the buildings, except where noted in 62A01 Key Note 2 in the Chlorine Building
37	Key note #2 on pages 63A01, 63A06 and numerous other architectural drawings indicates the interior CMU should be sealed per section 09960. There are no paint system for CMU sealing. Also, this not is in contradiction with the room finish schedule which indicates the interior CMU walls should be "coated".	The outside wall of the interior rooms of the chlorine building (chlorinator room, mechanical room, and electrical room) should be coated (sealed) with an epoxy based paint per Key Note 2 and Specification 09960. This is to provide a barrier between the chlorine gas storage area and the interior rooms. All other walls should be painted with the latex, semi-gloss paint per Specification 09910. Drawing 63A01 has been revised in this addendum to provide additional clarity
38	There appears to be quite a bit of new electrical/control work in the existing structures (Areas D, E, & F of the filter building especially), but there is not much information regarding demolition. The electrical demo drawings focus mostly on site demolition, and the filter building electrical drawings focus almost solely on new work. The one-lines show demo work, as does one of the panel schedules. However, there does not seem to be any information for the instrumentation/control circuits? Can more details be provided on what needs to stay and what needs to be removed?	Instrumentation/control electrical demolition in the filter area is minimal. Existing conduit and conductors will remain in use.
39	For security system work in Filters area (30E19), is there an existing system? If so, does the existing system need to be removed? If so, please provide details.	The existing security system in the filter area will remain. Work shown on Sheet 30E19 will add security for 3 doors.
40	What are the dimensions for the Contractor provided security panel enclosures? Drawing 63E16, General Note 2, drawing 65E10, General Note 3, & drawing 69E04, General Note 2 state that the Contractor is to "provide security panel enclosure as indicated on other drawings." What other drawings is this referring to? Some drawings, such as above, only state the Contractor is to provide. Some drawings state that it is provided by the Owner (30E19). Drawing 03N04, Key Note 1 alludes to the Security Gate Electronic Enclosure being provided by the Contractor and Drawing 01E02, Key Note 10 does provide dimensions for this enclosure. Are these the dimensions to be used for all security panel enclosures? Please provide some clarity.	Specification language has been added to 17050 describing the procedure for determining exact panel enclosure sizes. Refer to electrical drawings for plan view dimensions.