



JORDAN VALLEY WATER CONSERVANCY DISTRICT

JORDAN VALLEY WATER CONSERVANCY DISTRICT
WEST JORDAN, UTAH

JORDAN VALLEY WATER TREATMENT PLANT
FILTER AND CHEMICAL FEED UPGRADES

JVWCD PROJECT #4289

ADDENDUM NO. 4
TO THE
CONTRACT DOCUMENTS

MAY 2025



Bidders on the above-named project are hereby notified that the Bidding Documents are modified as indicated below. Bidders are required to acknowledge receipt of this Addendum in the space provided on the Document C-1 Bid Form.

This addendum consists of the following items:

ADDENDUM ITEM	NO. OF PAGES
This document (including cover page)	6
Drawing Markups	25
Answers to Bidder Questions	2
09960 Attachment A	7

This Addendum shall become part of the Contract and provisions of the Contract apply.

NOTICE: The bid date has been changed by Addendum 2 to 2:00 pm on June 12, 2025.

All RFI's should be submitted before 2:00 pm on May 29, 2025.

SPECIFICATIONS

The following sections are modified as indicated below.

1. SECTION 09960 – HIGH-PERFORMANCE COATINGS:
 - a. **REPLACE** Attachments A and B in their entirety.
2. SECTION 11256 – POLYMER BLENDING AND FEED EQUIPMENT: DRY:
 - a. **REMOVE** the following language from paragraph 1.01.D.4.a:
 1. “and Section 17622 - Weight Measurement: Platform Scale and Load Cells”.
 - b. **REMOVE** paragraph 2.01.B.1.g in its entirety.
 - c. **REMOVE** paragraph 2.13.B in its entirety.
 - d. **REPLACE** paragraph 2.13.C with the following:

C. Mix tank shall be constructed of fiberglass and shall be cylindrical, sloped flat, open top with 4 mixing baffles. Fiberglass tanks shall meet the requirements as specified in Section 13206A – Fiberglass Reinforced Plastic Aboveground Storage Tanks.
 - e. **REMOVE** the following paragraphs: 2.13.C.1, 2.13.C.2, and 2.13.C.3.
3. SECTION 13206A – FIBERGLASS REINFORCED PLASTIC ABOVEGROUND STORAGE TANKS:
 - a. **REPLACE** the following language from paragraph 2.02.B:
 1. “Tank filling: Design shall include any necessary accommodations to allow for pneumatic unloading of chemicals from tanker truck, **where shown on the Drawings.** This unloading process involves pressurizing the tanker truck to 15 psi

and pushing chemical into the storage tank to fill it. At the end of the filling operation, as the truck empties, the tank may be exposed to this pressurized vessel for a brief period of time.”

- b. **ADD** the following paragraph 2.02.K:

K. PEA Mix/Age Tanks

1. General: Suitable for storage of polymer (PEA) solution, stored at 0.1 to 0.4 percent concentration. Design tanks for liquid specific gravity up to 1.1 with a minimum internal pressure rating of 0.5 inches WC.
2. Day Tank: TNK-6905, TNK6915.
 - a. Number of units: 2.
 - b. Required Storage Volume (each tank): 2,000 gallons (nominal).
 - c. Diameter: 8 feet.
 - d. Straight Shell Length: 6 feet.
 - e. Orientation: Vertical, cylindrical, sloped flat, open top
 - f. Access manway and nozzles, as indicated on the Drawings.
 - g. Tank Connections:
 - 1) Drain: One 2-inch on tank bottom.
 - 2) Outlet: One 4-inch on tank bottom.
 - 3) Overflow: One 4-inch.
 - h. Appurtenances:
 - 1) Flanged ports for pressure transducers, as required.
 - 2) Welded clips for attachment of overflow pipe.
 - i. Level gauge.
 - 1) 3-inch flanged port reserved for the sight level.
 - j. Slope bottom of tank to the outlet drain to allow for full drainage of tank contents.

- c. **REPLACE** the following language from paragraph 2.06.A.1:

1. “Provide tanks with heater pads or tape for freeze protection, **as indicated in the drawings and the table below.**”

4. SECTION 13226 – FILTER MEDIA:

- a. **ADD** the following line to paragraph 2.04.A and 2.04B (both locations):

1. **Red Flint Sand and Gravel, LLC**

5. SECTION 16235 – SINGLE SPARK-IGNITED GENERATOR SET:

- a. **REPLACE** the following language from paragraph 2.02 B:

1. “Provide a complete automatic standby spark-ignited **natural gas or** combination natural gas/LP vapor fueled engine driven generator system with necessary components to make a complete and operating engine-driven power supply.”

- b. **REPLACE** the following language from section 2.02 C:

1. "Include the supply of such minor details of electrical, plumbing, or mechanical work not specified or indicated on the Drawings, which are necessary for the successful operation of the **natural gas or** combination natural gas/LP vapor fueled engine-driven generator required by these Specifications."
 - c. **REPLACE** the following language from paragraph 2.06 B.1:
 1. "Engine-driven generator consists of a spark-ignited, **natural gas or** combination natural gas/LP vapor -fueled engine directly coupled to an electric generator providing continuous electric power for the duration of any power failure of the normal utility power supply."
 - d. **REPLACE** the following language from paragraph 2.07 B.4.m.1)c):
 1. "Suitable for use on **natural gas or** combination natural gas/LP vapor-fueled engines."
6. SECTION 16990B – CONDUIT SCHEDULE – AREA 30:
- a. **REMOVE** the reference to drawing 30E04 from the following conduits:

1. C-30-703	4. C-30-853	7. S-30-803
2. C-30-753	5. S-30-703	8. S-30-853
3. C-30-803	6. S-30-753	
 - b. **REMOVE** the reference to drawing 30E05 from the following conduits:

1. C-30-403	5. C-30-603	9. S-30-503
2. C-30-453	6. C-30-653	10. S-30-553
3. C-30-503	7. S-30-403	11. S-30-603
4. C-30-553	8. S-30-453	12. S-30-653
7. SECTION 16990F – CONDUIT SCHEDULE – AREA 63:
- a. **REMOVE** conduits C-63-075 and C-63-076 in their entirety.
8. SECTION 16990G – CONDUIT SCHEDULE – AREA 65:
- a. **REPLACE** conduit C-65-009 with the following:

C-65-009	65E02	0.75"	4	#14	XHHW-2	1	#14	XHHW-2	FR:	XS-6560	
									TO:	MAU-6560	
									4	#14	>> XS-6560 CONTROL

- b. **REMOVE** conduits C-65-039, C-65-040, and C-65-042 in their entirety.
- c. **REMOVE** the duplicate entries for conduits L-65-501, L-65-502, and L-65-503 on specification page 4, above conduit L-65-030.

L-65-023	65E04	0.75"	2	#12	XHHW-2	1	#12	XHHW-2	FR: TO:	FIT-6563 RTU-CS 2 #12 >> FIT-6563 POWER
L-65-501	65E05	0.75"	2	#10	XHHW-2	1	#10	XHHW-2	FR: TO:	HTU-6501 PNL-CS 2 #10 >> HTU-6501 POWER
L-65-502	65E05	0.75"	2	#10	XHHW-2	1	#10	XHHW-2	FR: TO:	HTU-6502 PNL-CS 2 #10 >> HTU-6502 POWER
L-65-503	65E05	0.75"	2	#10	XHHW-2	1	#10	XHHW-2	FR: TO:	HTU-6503 PNL-CS 2 #10 >> HTU-6503 POWER
L-65-030	65E02	1"	3	#6	XHHW-2	1	#10	XHHW-2	FR: TO:	PNL-UPS-CS UPS-CS 3 #6 >> PNL-UPS-CS POWER
L-65-031	65E02	1"	3	#6	XHHW-2	1	#10	XHHW-2	FR: TO:	UPS-CS UPS BYPASS DISC 3 #6 >> UPS-CS (BYPASS) POWER
L-65-032	65E02	1"	3	#6	XHHW-2	1	#10	XHHW-2	FR: TO:	UPS BYPASS DISC PNL-CS 3 #6 >> UPS BYPASS DISC POWER
L-65-501	65E05	0.75"	2	#10	XHHW-2	1	#10	XHHW-2	FR: TO:	HTU-6501 PNL-CS 2 #10 >> HTU-6501 CONTROLLER POWER

d. **REPLACE** conduits P-65-020 and P-65-021 with the following:

P-65-020	65E05	0.75"	3 4	#12 #14	XHHW-2 XHHW-2	1	#12	XHHW-2	FR: TO:	PMP-6511 MCC-CS 3 #12 >> PMP-6511 POWER 2 #14 >> PMP-6511 MWH CONTROL 2 #14 >> PMP-6511 TSH CONTROL
P-65-021	65E05	0.75"	3 4	#12 #14	XHHW-2 XHHW-2	1	#12	XHHW-2	FR: TO:	PMP-6521 MCC-CS 3 #12 >> PMP-6521 POWER 2 #14 >> PMP-6521 MWH CONTROL 2 #14 >> PMP-6521 TSH CONTROL

9. SECTION 16990J – CONDUIT SCHEDULE – AREA 69:

a. **REMOVE** the following conduits in their entirety.

- | | | |
|-------------|-------------|-------------|
| 1. C-69-405 | 4. C-69-515 | 7. S-69-505 |
| 2. C-69-415 | 5. C-69-710 | 8. S-69-415 |
| 3. C-69-505 | 6. L-69-710 | 9. S-69-710 |

10. SECTION 16990K – CONDUIT SCHEDULE – AREA 71:

a. **REPLACE** conduits C-71-001, L-71-001, L-71-005, and S-71-003 with the following:

C-71-001	69E02	0.75"	6	#14	XHHW-2	1	#14	XHHW-2	FR: TO:	LCP-7100 RTU-PEA 6 #14 >> LCP-7100 CONTROL
L-71-001	69E02	0.75"	2	#12	XHHW-2	1	#12	XHHW-2	FR: TO:	LCP-7100 RTU-PEA 2 #12 >> LCP-7100 POWER
L-71-005	71E02	0.75"	2	#12	XHHW-2	1	#12	XHHW-2	FR: TO:	RTU-PEA PNL-PEA 2 #12 >> RTU-PEA POWER
S-71-003	69E02	0.75"	2	2/CS-#16		1	#14	XHHW-2	FR: TO:	LCP-7100 RTU-PEA 2 2/CS-#16 >> LCP-7100 SIGNAL

11. SECTION 17101B – SPECIFIC CONTROL STRATEGIES – CAUSTIC SODA:

a. **REPLACE** title of the Specification to the following:

SPECIFIC CONTROL STRATEGIES – CHEMICALS

b. **REMOVE** paragraph 3.08.E.2.d in its entirety.

- c. **REPLACE** paragraph 3.08.E.3.b.1) with “None.”

12. SECTION 17622 – WEIGHT MEASUREMENT: PLATFORM SCALE AND LOAD CELLS:

- a. **REMOVE** the following datasheets in their entirety from Attachment A:
- 1) WIT-6905 (WE-6905) [page 3]
 - 2) WIT-6915 (WE-6915) [page 4]
- b. **REPLACE** the following information in the datasheet WIT-7105 (WE-7105) [page 5] in Attachment A:
- 1) **SERVICE PEC DAY TANK WEIGHT**
 - 2) **WEIGHT RANGE 0 – 6,000 LBS**

DRAWINGS

Note to Bidders on addenda drawings: The addenda drawings make use of color coding to show revisions made by addendum. The following color codes are used, for clarity:
Red is used to highlight additions, corrections, or changes that are incorporated into the drawing.

Green is used to indicate items that shall be removed or deleted from the drawing.

Blue is used for comments, notes, clarifications, or instructions that may not be physically added to the drawing itself.


The following drawings are modified as indicated below.


1. **REPLACE** the following drawings in their entirety with the drawings attached:

- | | | |
|-----------|----------|----------|
| a. 01C34 | j. 01E03 | s. 65E06 |
| b. 30M13 | k. 30E04 | t. 69E02 |
| c. 30M17 | l. 30E05 | u. 69E03 |
| d. 63M03 | m. 30E06 | v. 71E01 |
| e. 65M04 | n. 30E13 | w. 69N01 |
| f. 69M03 | o. 30E16 | x. 69N02 |
| g. 69M04 | p. 63E08 | y. 71N02 |
| h. 00GH02 | q. 63E02 | |
| i. 00GE06 | r. 65E05 | |

Plot Date: 4/4/2024 1:36:42 PM

LAST SAVED BY: AEVans

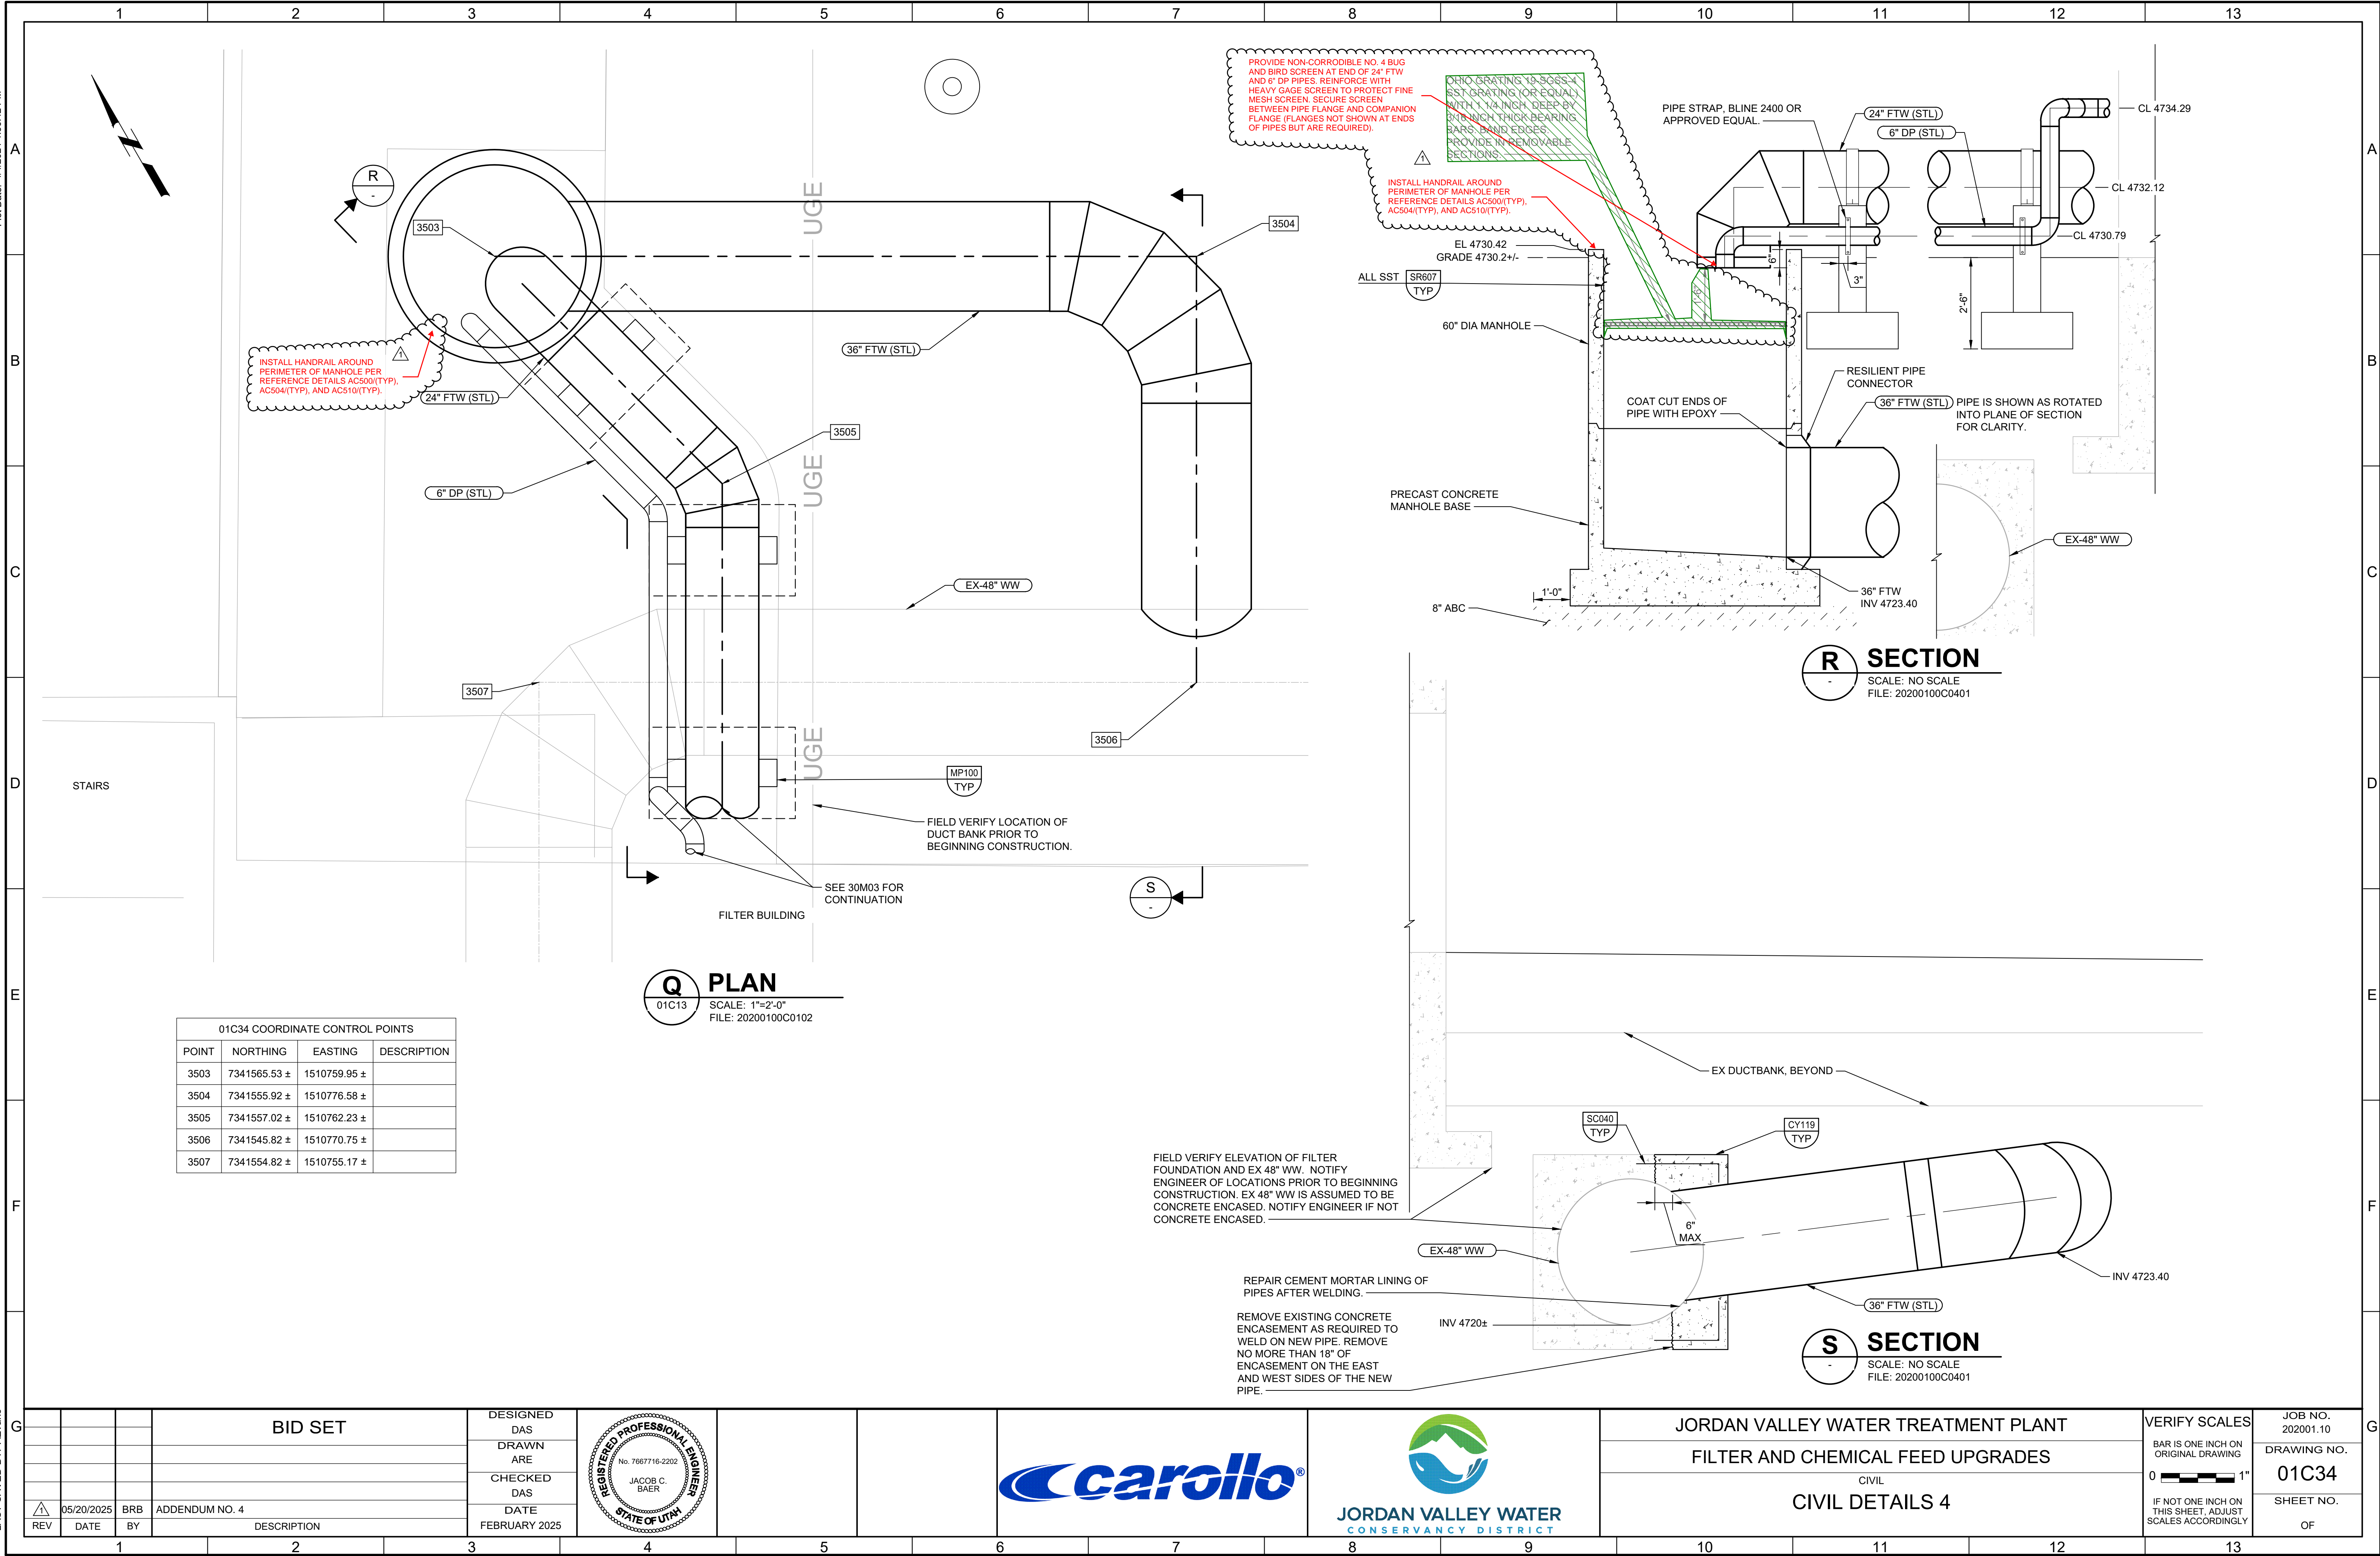


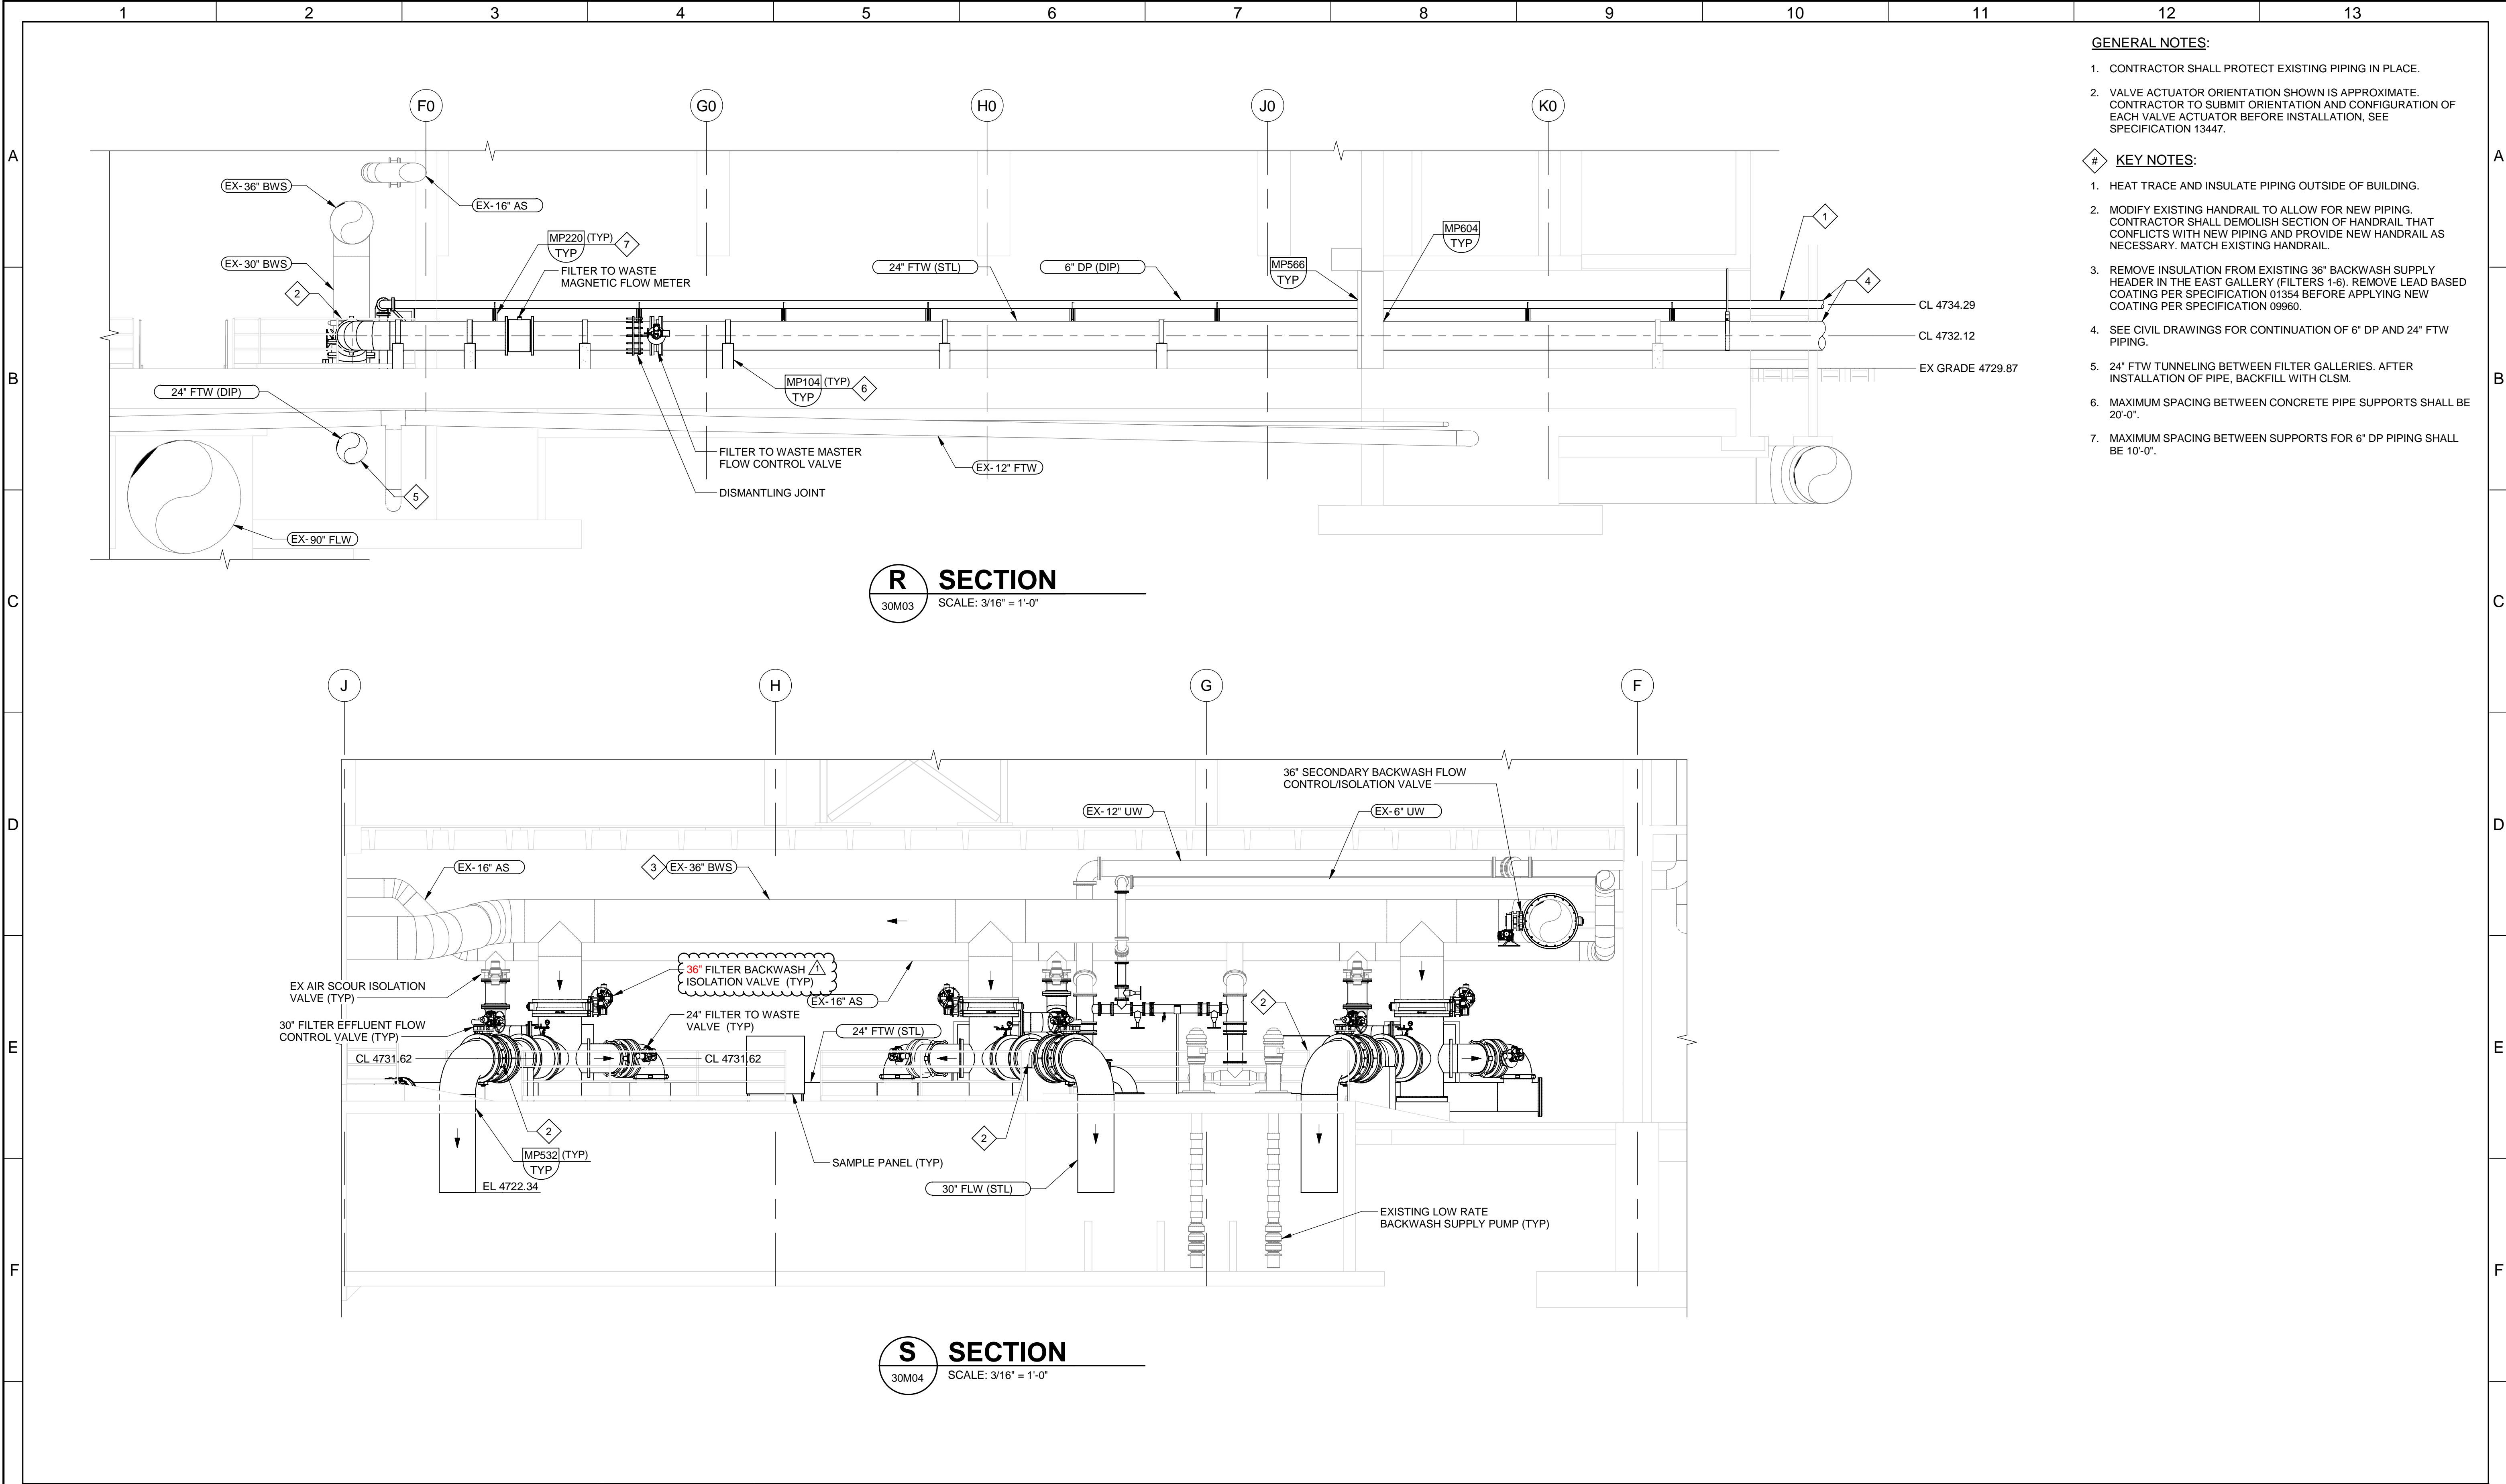


- GENERAL NOTES:**
- CONTRACTOR SHALL PROTECT EXISTING PIPING IN PLACE.
 - VALVE ACTUATOR ORIENTATION SHOWN IS APPROXIMATE. CONTRACTOR TO SUBMIT ORIENTATION AND CONFIGURATION OF EACH VALVE ACTUATOR BEFORE INSTALLATION. SEE SPECIFICATION 13447.
- KEY NOTES:**
- HEAT TRACE AND INSULATE PIPING OUTSIDE OF BUILDING.
 - MODIFY EXISTING HANDRAIL TO ALLOW FOR NEW PIPING. CONTRACTOR SHALL DEMOLISH SECTION OF HANDRAIL THAT CONFLICTS WITH NEW PIPING AND PROVIDE NEW HANDRAIL AS NECESSARY. MATCH EXISTING HANDRAIL.
 - REMOVE INSULATION FROM EXISTING 36\"/>

G				BID SET		DESIGNED BB							JORDAN VALLEY WATER TREATMENT PLANT			VERIFY SCALES	JOB NO. 202001.10	G								
					DRAWN RPW				FILTER AND CHEMICAL FEED UPGRADES				BAR IS ONE INCH ON ORIGINAL DRAWING	DRAWING NO.												
					CHECKED Checker								0 1"	30M13												
					DATE FEBRUARY 2025								IF NOT ONE INCH ON THIS SHEET, ADJUST SCALES ACCORDINGLY	SHEET NO.												
					DESCRIPTION												OF									
		05/20/2025	BRB	ADDENDUM NO. 4																						
	REV	DATE	BY																							
	1		2		3		4		5		6		7		8		9		10		11		12		13	


PLOT DATE: 2/10/2025 4:01:06 PM

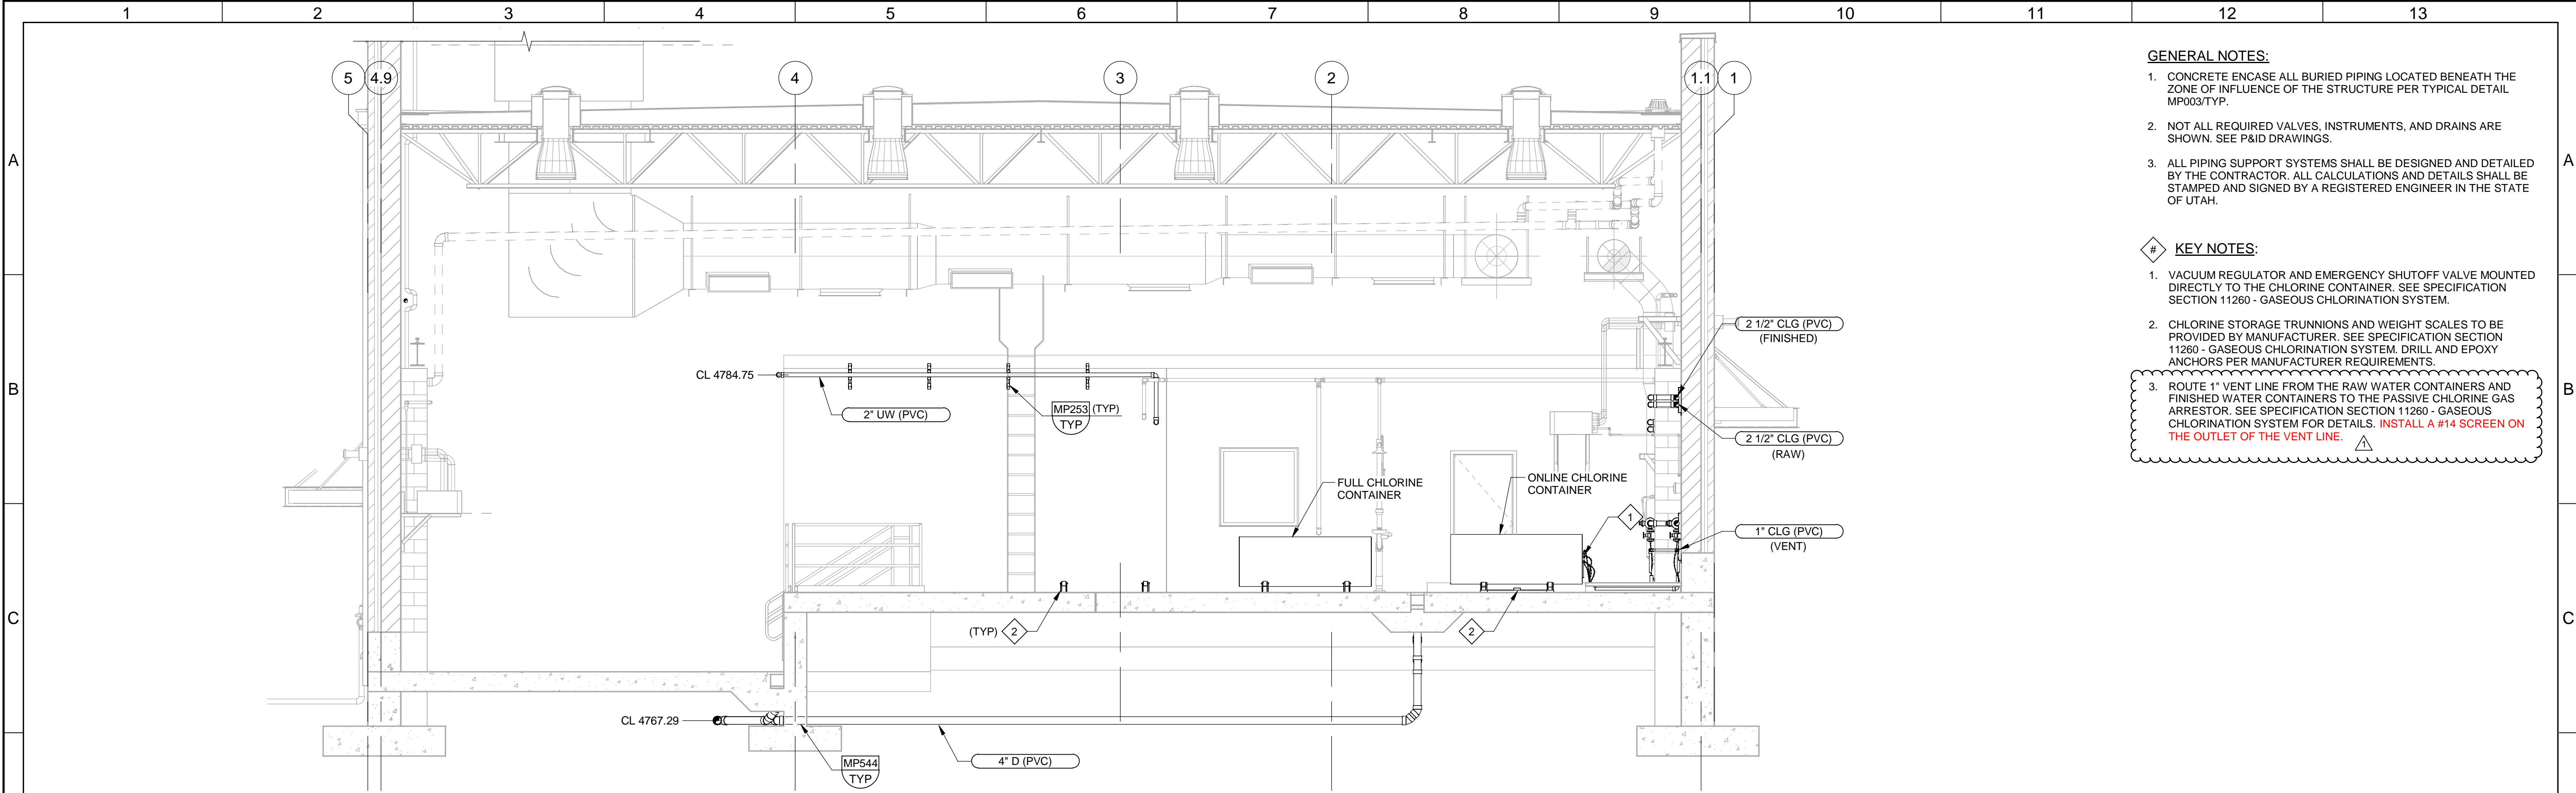

- GENERAL NOTES:**
1. CONCRETE ENCASE ALL BURIED PIPING LOCATED BENEATH THE ZONE OF INFLUENCE OF THE STRUCTURE PER TYPICAL DETAIL MP003/TYP.
 2. NOT ALL REQUIRED VALVES, INSTRUMENTS, AND DRAINS ARE SHOWN. SEE P&ID DRAWINGS.
 3. ALL PIPING SUPPORT SYSTEMS SHALL BE DESIGNED AND DETAILED BY THE CONTRACTOR. ALL CALCULATIONS AND DETAILS SHALL BE STAMPED AND SIGNED BY A REGISTERED ENGINEER IN THE STATE OF UTAH.
- KEY NOTES:**
1. VACUUM REGULATOR AND EMERGENCY SHUTOFF VALVE MOUNTED DIRECTLY TO THE CHLORINE CONTAINER. SEE SPECIFICATION SECTION 11260 - GASEOUS CHLORINATION SYSTEM.
 2. CHLORINE STORAGE TRUNNIONS AND WEIGHT SCALES TO BE PROVIDED BY MANUFACTURER. SEE SPECIFICATION SECTION 11260 - GASEOUS CHLORINATION SYSTEM. DRILL AND EPOXY ANCHORS PER MANUFACTURER REQUIREMENTS.
 3. ROUTE 1" VENT LINE FROM THE RAW WATER CONTAINERS AND FINISHED WATER CONTAINERS TO THE PASSIVE CHLORINE GAS ARRESTOR. SEE SPECIFICATION SECTION 11260 - GASEOUS CHLORINATION SYSTEM FOR DETAILS. **INSTALL A #14 SCREEN ON THE OUTLET OF THE VENT LINE.**

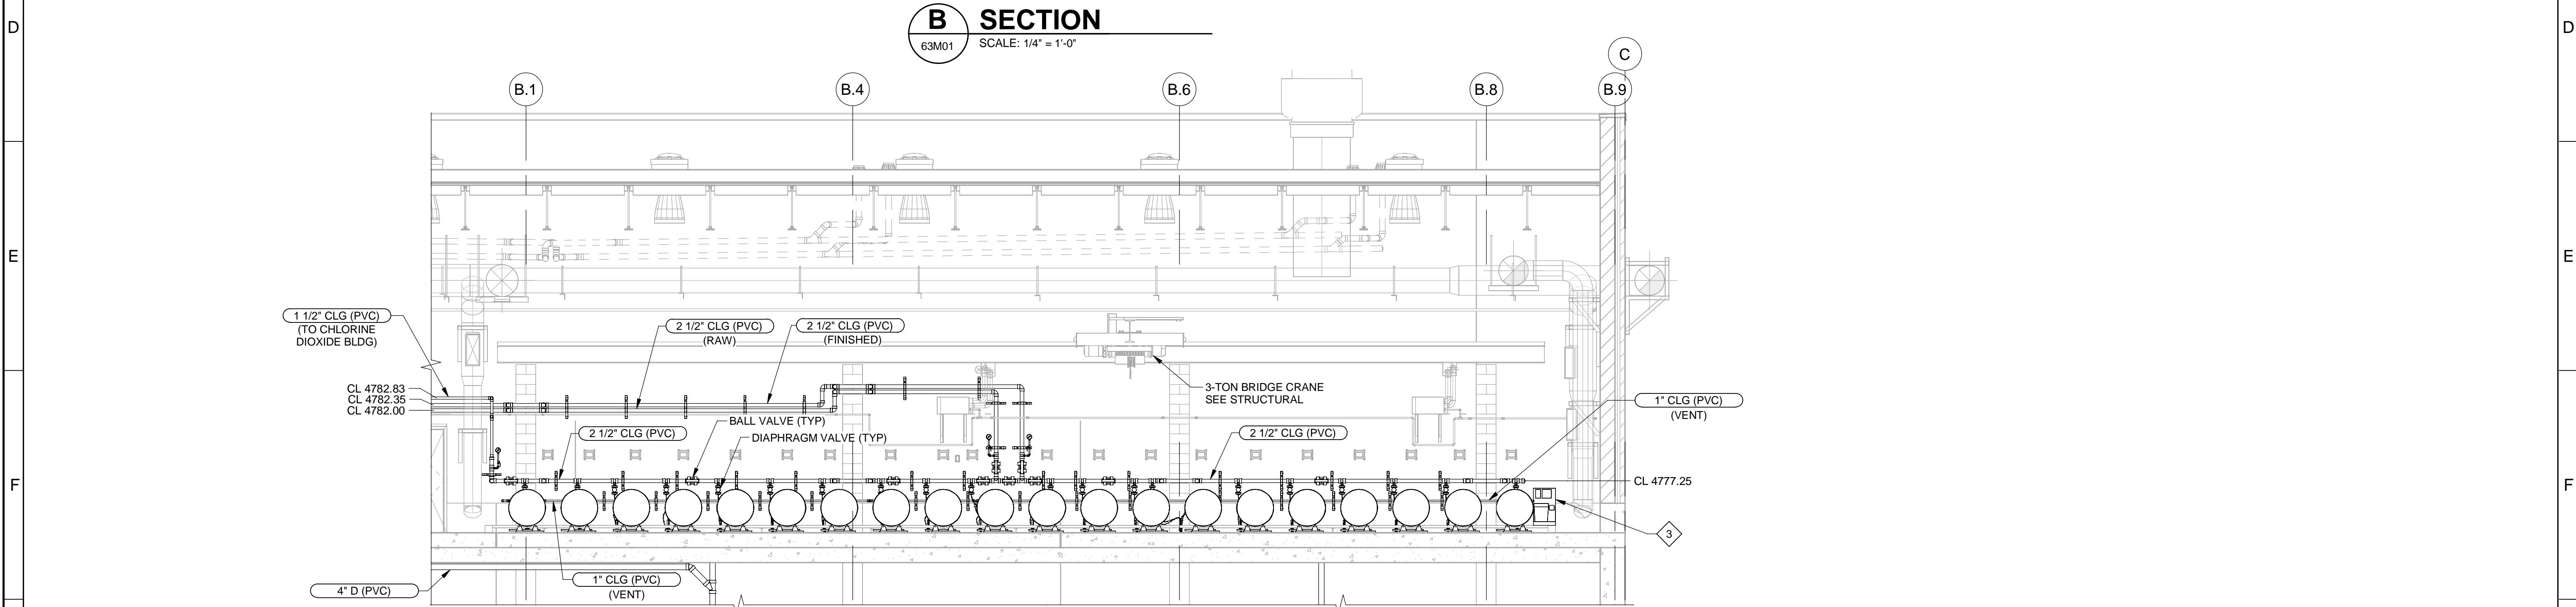


BID SET				DESIGNED SSB								JORDAN VALLEY WATER TREATMENT PLANT			VERIFY SCALES	JOB NO. 202001.10
				DRAWN RPW								FILTER AND CHEMICAL FEED UPGRADES			BAR IS ONE INCH ON ORIGINAL DRAWING	DRAWING NO.
				CHECKED ARL											0 1"	63M03
				DATE FEBRUARY 2025								MECHANICAL CHLORINE BUILDING SECTIONS 1			IF NOT ONE INCH ON THIS SHEET, ADJUST SCALES ACCORDINGLY	SHEET NO. OF
REV	DATE	SSB	BY	DESCRIPTION												
1																
2																
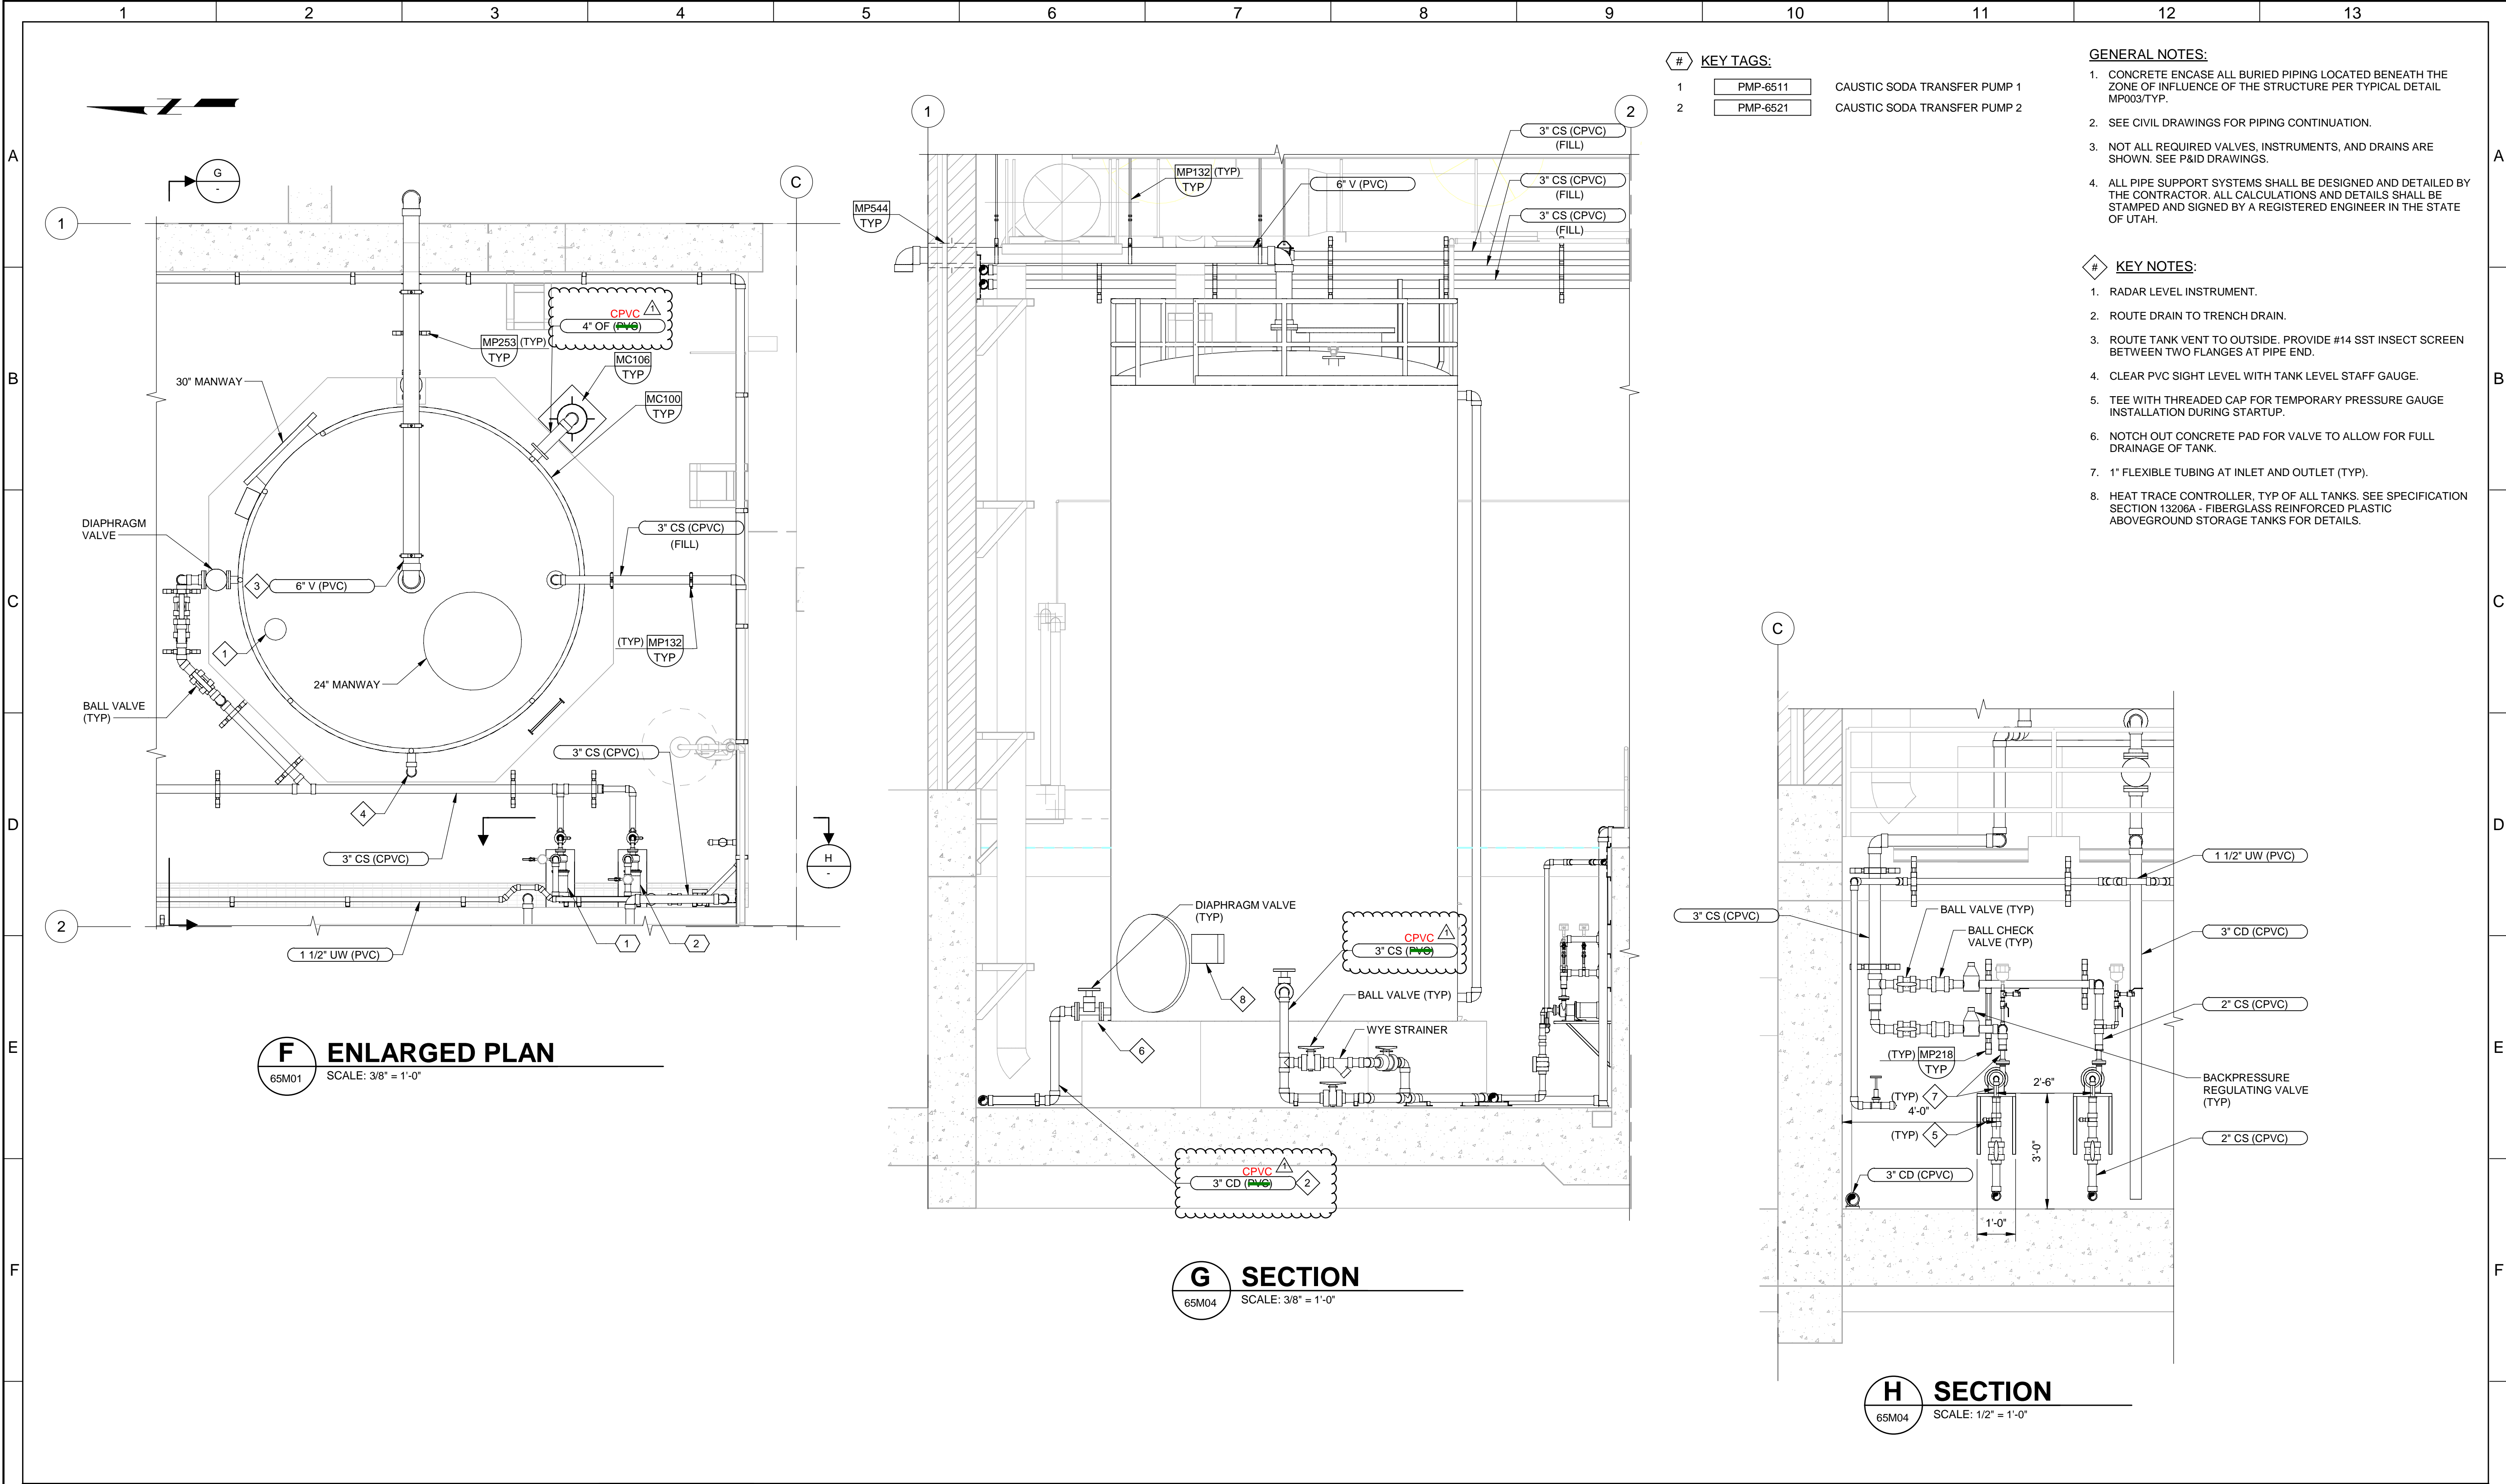

#	KEY TAGS:	
1	PMP-6511	CAUSTIC SODA TRANSFER PUMP 1
2	PMP-6521	CAUSTIC SODA TRANSFER PUMP 2

- GENERAL NOTES:**
1. CONCRETE ENCASE ALL BURIED PIPING LOCATED BENEATH THE ZONE OF INFLUENCE OF THE STRUCTURE PER TYPICAL DETAIL MP003/TYP.
 2. SEE CIVIL DRAWINGS FOR PIPING CONTINUATION.
 3. NOT ALL REQUIRED VALVES, INSTRUMENTS, AND DRAINS ARE SHOWN. SEE P&ID DRAWINGS.
 4. ALL PIPE SUPPORT SYSTEMS SHALL BE DESIGNED AND DETAILED BY THE CONTRACTOR. ALL CALCULATIONS AND DETAILS SHALL BE STAMPED AND SIGNED BY A REGISTERED ENGINEER IN THE STATE OF UTAH.
- KEY NOTES:**
1. RADAR LEVEL INSTRUMENT.
 2. ROUTE DRAIN TO TRENCH DRAIN.
 3. ROUTE TANK VENT TO OUTSIDE. PROVIDE #14 SST INSECT SCREEN BETWEEN TWO FLANGES AT PIPE END.
 4. CLEAR PVC SIGHT LEVEL WITH TANK LEVEL STAFF GAUGE.
 5. TEE WITH THREADED CAP FOR TEMPORARY PRESSURE GAUGE INSTALLATION DURING STARTUP.
 6. NOTCH OUT CONCRETE PAD FOR VALVE TO ALLOW FOR FULL DRAINAGE OF TANK.
 7. 1" FLEXIBLE TUBING AT INLET AND OUTLET (TYP).
 8. HEAT TRACE CONTROLLER, TYP OF ALL TANKS. SEE SPECIFICATION SECTION 13206A - FIBERGLASS REINFORCED PLASTIC ABOVEGROUND STORAGE TANKS FOR DETAILS.


BID SET				DESIGNED SSB					JORDAN VALLEY WATER TREATMENT PLANT				VERIFY SCALES	JOB NO. 202001.10
				DRAWN RPW					FILTER AND CHEMICAL FEED UPGRADES				BAR IS ONE INCH ON ORIGINAL DRAWING	DRAWING NO. 65M04
				CHECKED ARL					MECHANICAL				0 1"	SHEET NO.
				DATE FEBRUARY 2025					CAUSTIC SODA BUILDING SECTIONS AND DETAILS 3				IF NOT ONE INCH ON THIS SHEET, ADJUST SCALES ACCORDINGLY	OF
REV	DATE	SSB BY	DESCRIPTION											
1														
2														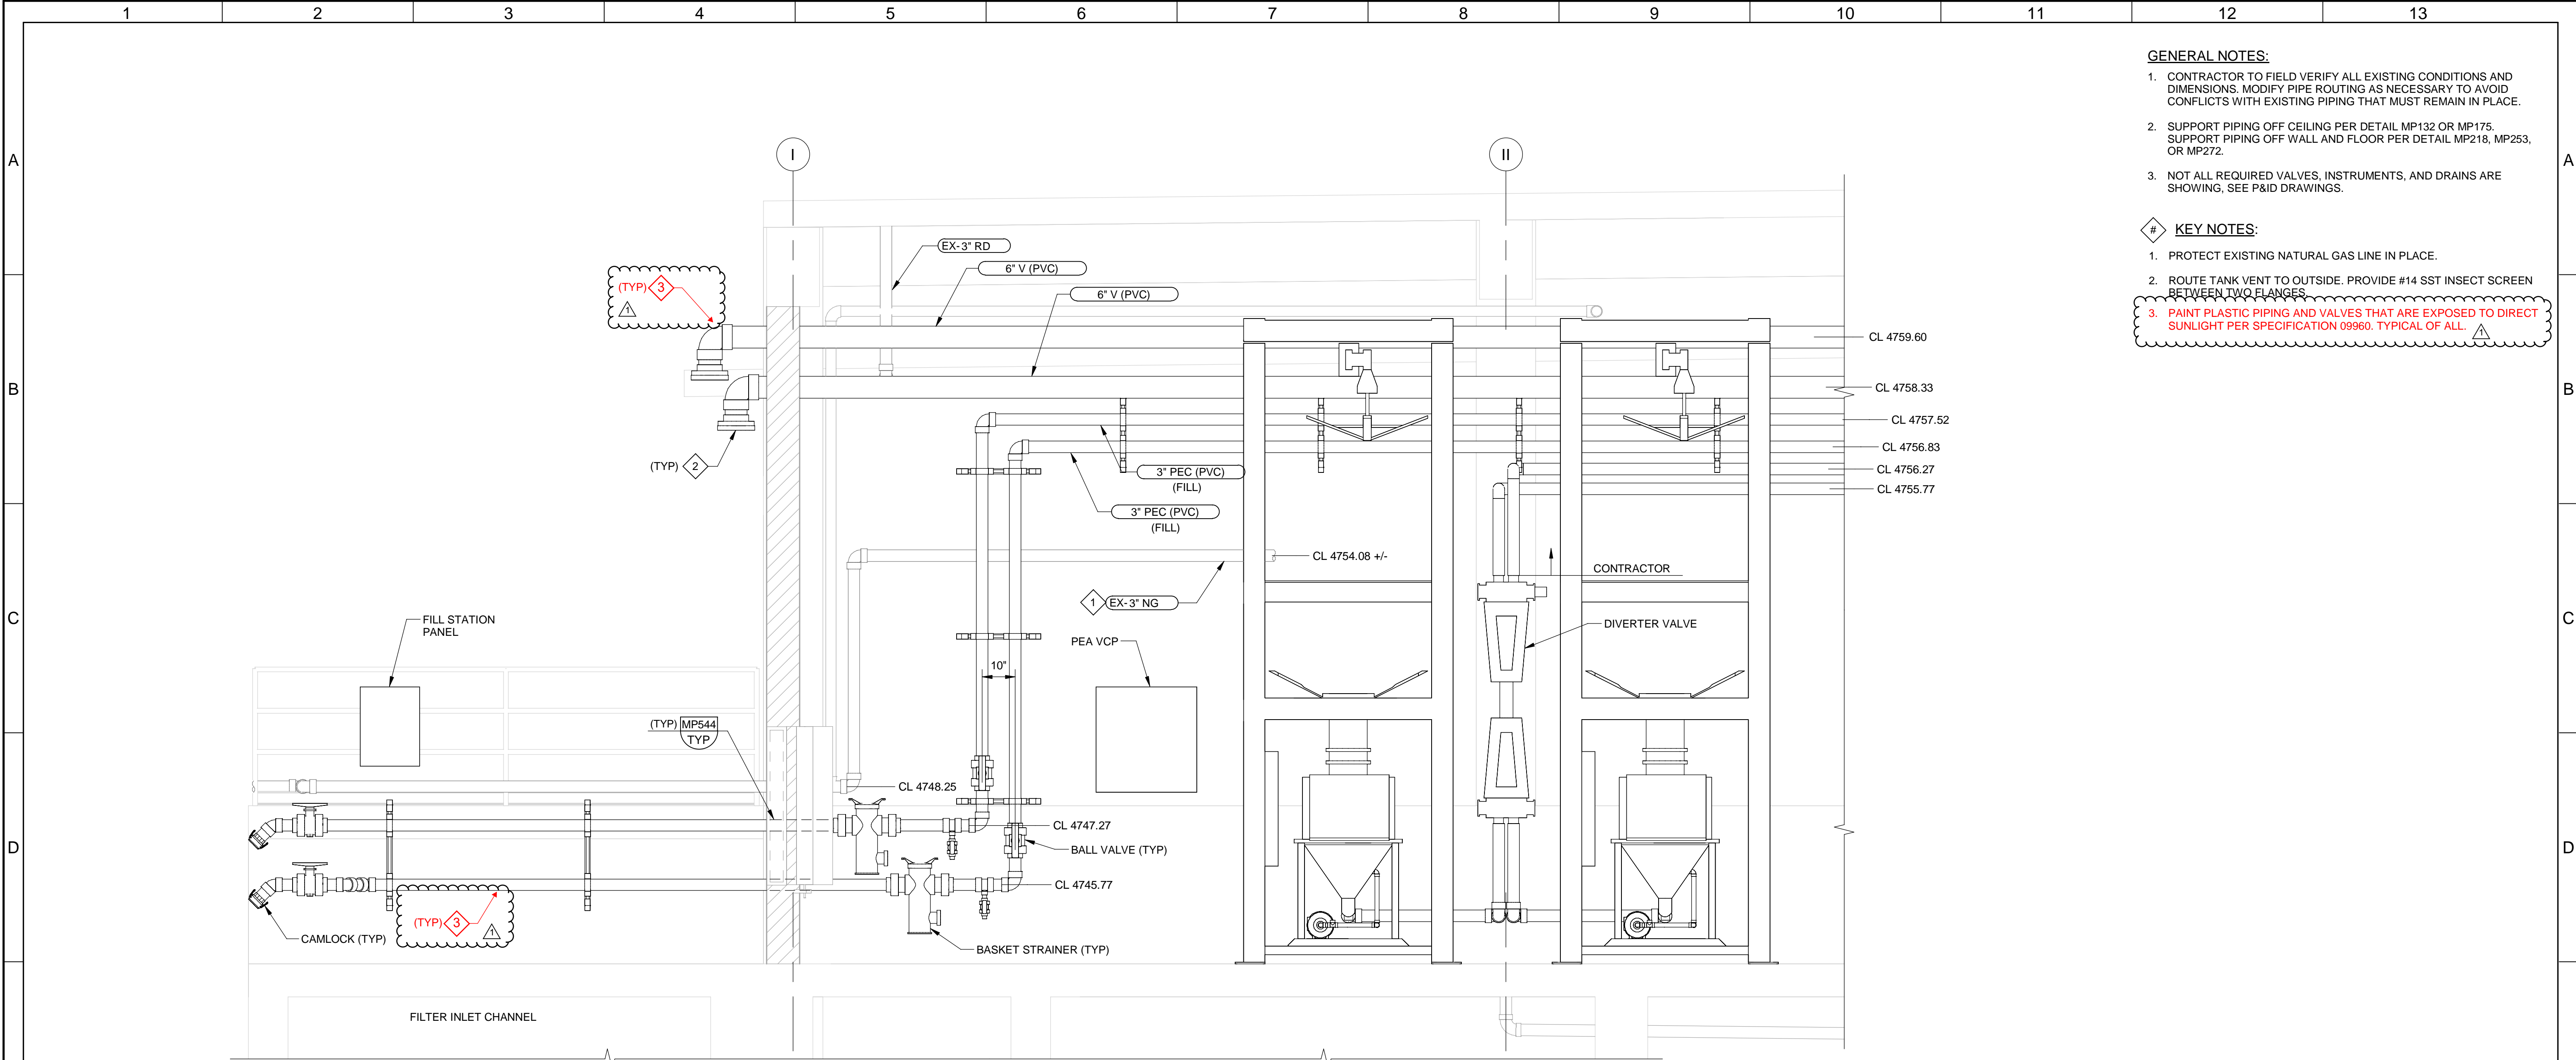
- GENERAL NOTES:**
- CONTRACTOR TO FIELD VERIFY ALL EXISTING CONDITIONS AND DIMENSIONS. MODIFY PIPE ROUTING AS NECESSARY TO AVOID CONFLICTS WITH EXISTING PIPING THAT MUST REMAIN IN PLACE.
 - SUPPORT PIPING OFF CEILING PER DETAIL MP132 OR MP175. SUPPORT PIPING OFF WALL AND FLOOR PER DETAIL MP218, MP253, OR MP272.
 - NOT ALL REQUIRED VALVES, INSTRUMENTS, AND DRAINS ARE SHOWING, SEE P&ID DRAWINGS.
- KEY NOTES:**
- PROTECT EXISTING NATURAL GAS LINE IN PLACE.
 - ROUTE TANK VENT TO OUTSIDE. PROVIDE #14 SST INSECT SCREEN BETWEEN TWO FLANGES.
 - PAIN PLASTIC PIPING AND VALVES THAT ARE EXPOSED TO DIRECT SUNLIGHT PER SPECIFICATION 09960. TYPICAL OF ALL.**

D SECTION
69M02 SCALE: 1/2" = 1'-0"

BID SET				DESIGNED SSB					JORDAN VALLEY WATER TREATMENT PLANT			VERIFY SCALES	JOB NO. 202001.10
				DRAWN CMC					FILTER AND CHEMICAL FEED UPGRADES			BAR IS ONE INCH ON ORIGINAL DRAWING	DRAWING NO.
				CHECKED ARL								0 1"	69M03
				DATE FEBRUARY 2025								IF NOT ONE INCH ON THIS SHEET, ADJUST SCALES ACCORDINGLY	SHEET NO. OF
REV	DATE	BY	DESCRIPTION										
1													
2													
3													
4													
5													
6													
7													
8													
9													
10													
11													
12													
13													

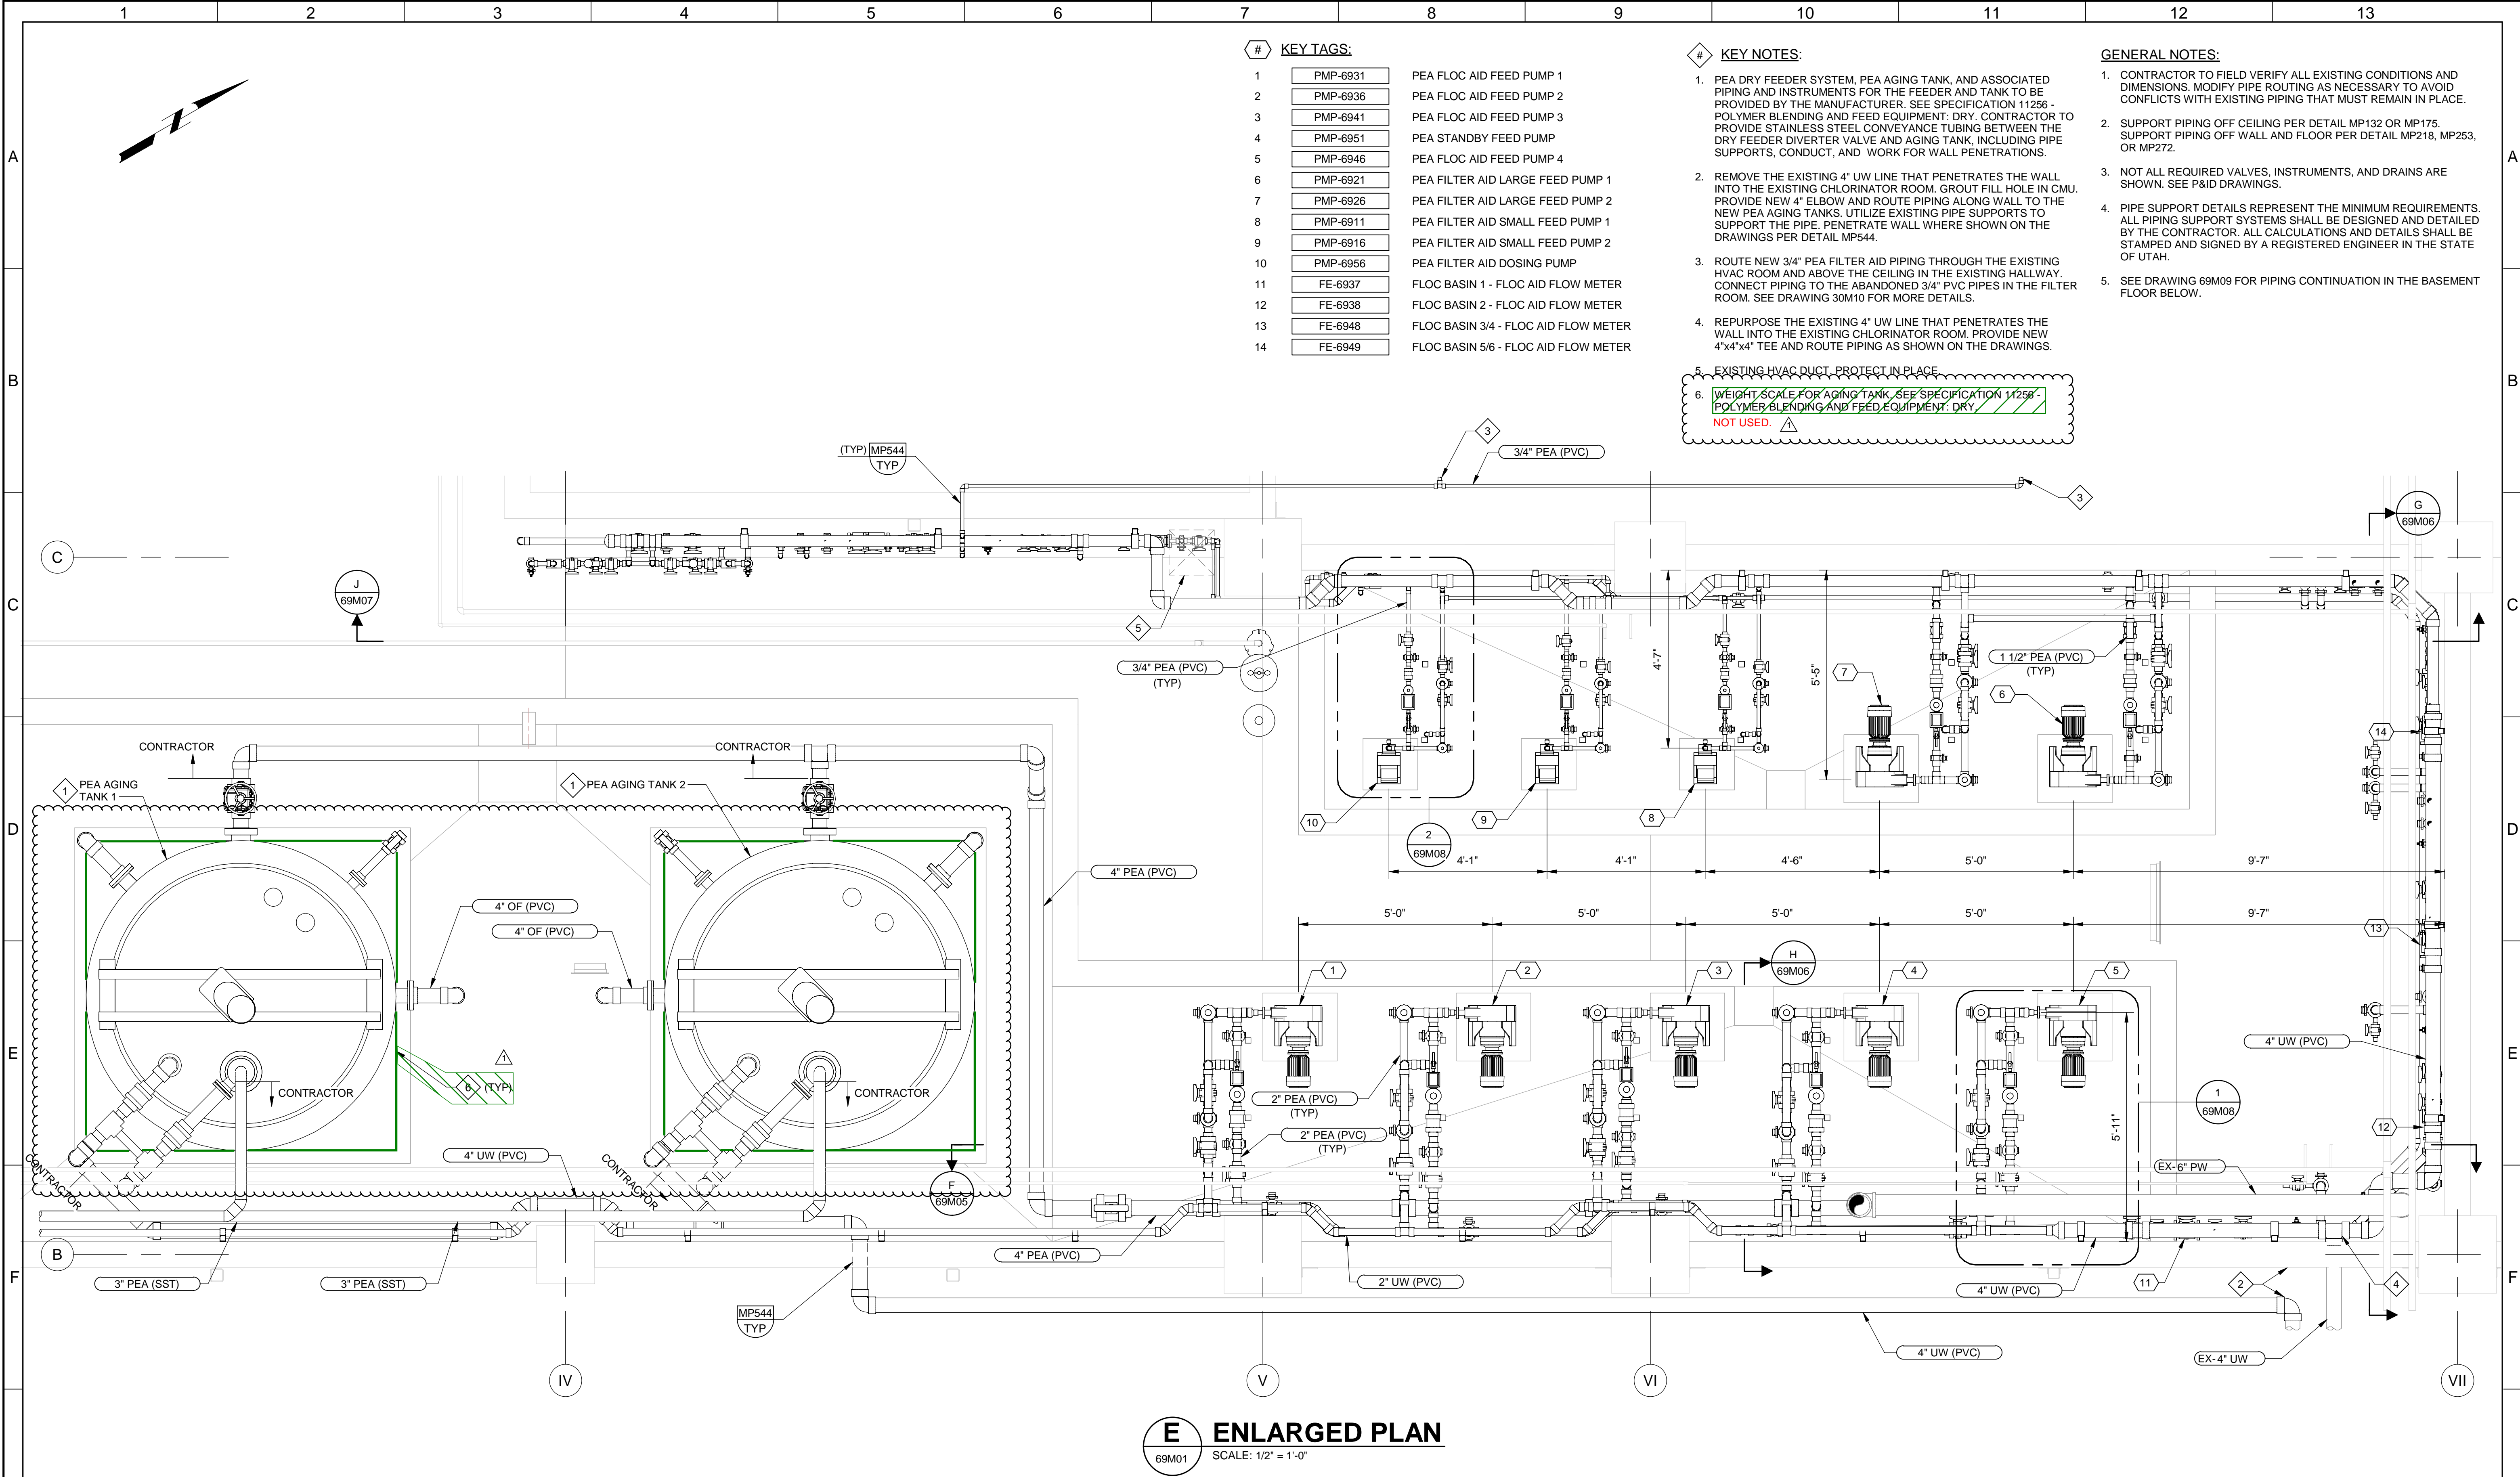

KEY TAGS:

- | | | |
|----|----------|--------------------------------------|
| 1 | PMP-6931 | PEA FLOC AID FEED PUMP 1 |
| 2 | PMP-6936 | PEA FLOC AID FEED PUMP 2 |
| 3 | PMP-6941 | PEA FLOC AID FEED PUMP 3 |
| 4 | PMP-6951 | PEA STANDBY FEED PUMP |
| 5 | PMP-6946 | PEA FLOC AID FEED PUMP 4 |
| 6 | PMP-6921 | PEA FILTER AID LARGE FEED PUMP 1 |
| 7 | PMP-6926 | PEA FILTER AID LARGE FEED PUMP 2 |
| 8 | PMP-6911 | PEA FILTER AID SMALL FEED PUMP 1 |
| 9 | PMP-6916 | PEA FILTER AID SMALL FEED PUMP 2 |
| 10 | PMP-6956 | PEA FILTER AID DOSING PUMP |
| 11 | FE-6937 | FLOC BASIN 1 - FLOC AID FLOW METER |
| 12 | FE-6938 | FLOC BASIN 2 - FLOC AID FLOW METER |
| 13 | FE-6948 | FLOC BASIN 3/4 - FLOC AID FLOW METER |
| 14 | FE-6949 | FLOC BASIN 5/6 - FLOC AID FLOW METER |

KEY NOTES:

- PEA DRY FEEDER SYSTEM, PEA AGING TANK, AND ASSOCIATED PIPING AND INSTRUMENTS FOR THE FEEDER AND TANK TO BE PROVIDED BY THE MANUFACTURER. SEE SPECIFICATION 11256 - POLYMER BLENDING AND FEED EQUIPMENT: DRY. CONTRACTOR TO PROVIDE STAINLESS STEEL CONVEYANCE TUBING BETWEEN THE DRY FEEDER DIVERter VALVE AND AGING TANK, INCLUDING PIPE SUPPORTS, CONDUCT, AND WORK FOR WALL PENETRATIONS.
- REMOVE THE EXISTING 4" UW LINE THAT PENETRATES THE WALL INTO THE EXISTING CHLORINATOR ROOM. GROUT FILL HOLE IN CMU. PROVIDE NEW 4" ELBOW AND ROUTE PIPING ALONG WALL TO THE NEW PEA AGING TANKS. UTILIZE EXISTING PIPE SUPPORTS TO SUPPORT THE PIPE. PENETRATE WALL WHERE SHOWN ON THE DRAWINGS PER DETAIL MP544.
- ROUTE NEW 3/4" PEA FILTER AID PIPING THROUGH THE EXISTING HVAC ROOM AND ABOVE THE CEILING IN THE EXISTING HALLWAY. CONNECT PIPING TO THE ABANDONED 3/4" PVC PIPES IN THE FILTER ROOM. SEE DRAWING 30M10 FOR MORE DETAILS.
- REPURPOSE THE EXISTING 4" UW LINE THAT PENETRATES THE WALL INTO THE EXISTING CHLORINATOR ROOM. PROVIDE NEW 4"x4"x4" TEE AND ROUTE PIPING AS SHOWN ON THE DRAWINGS.

- 5 - EXISTING HVAC DUCT, PROTECT IN PLACE
- 6 - WEIGHT SCALE FOR AGING TANK, SEE SPECIFICATION 11256 - POLYMER BLENDING AND FEED EQUIPMENT: DRY. NOT USED.

GENERAL NOTES:










- CONTRACTOR TO FIELD VERIFY ALL EXISTING CONDITIONS AND DIMENSIONS. MODIFY PIPE ROUTING AS NECESSARY TO AVOID CONFLICTS WITH EXISTING PIPING THAT MUST REMAIN IN PLACE.
- SUPPORT PIPING OFF CEILING PER DETAIL MP132 OR MP175. SUPPORT PIPING OFF WALL AND FLOOR PER DETAIL MP218, MP253, OR MP272.
- NOT ALL REQUIRED VALVES, INSTRUMENTS, AND DRAINS ARE SHOWN. SEE P&ID DRAWINGS.
- PIPE SUPPORT DETAILS REPRESENT THE MINIMUM REQUIREMENTS. ALL PIPING SUPPORT SYSTEMS SHALL BE DESIGNED AND DETAILED BY THE CONTRACTOR. ALL CALCULATIONS AND DETAILS SHALL BE STAMPED AND SIGNED BY A REGISTERED ENGINEER IN THE STATE OF UTAH.
- SEE DRAWING 69M09 FOR PIPING CONTINUATION IN THE BASEMENT FLOOR BELOW.

E ENLARGED PLAN
69M01 SCALE: 1/2" = 1'-0"

G				BID SET		DESIGNED SSB												JORDAN VALLEY WATER TREATMENT PLANT			VERIFY SCALES	JOB NO. 202001.10	G
						DRAWN CMC									FILTER AND CHEMICAL FEED UPGRADES			BAR IS ONE INCH ON ORIGINAL DRAWING	DRAWING NO. 69M04				
						CHECKED ARL									MECHANICAL			0 1"	SHEET NO.				
						DATE FEBRUARY 2025									PEA METERING PARTIAL PLAN			IF NOT ONE INCH ON THIS SHEET, ADJUST SCALES ACCORDINGLY	OF				
	05/20/2025	SSB	ADDENDUM NO. 4	DESCRIPTION	1	2	3	4	5	6	7	8	9	10	11	12	13						
REV	DATE	BY																					

PLOT DATE: 2/10/2025 4:04:27 PM


LAST SAVED BY: 0900

	1	2	3	4	5	6	7	8	9	10	11	12	13																																																																																																																																																																																																																																																																																																																																																																																																																		
A														A																																																																																																																																																																																																																																																																																																																																																																																																																	
B														B																																																																																																																																																																																																																																																																																																																																																																																																																	
C														C																																																																																																																																																																																																																																																																																																																																																																																																																	
D														D																																																																																																																																																																																																																																																																																																																																																																																																																	
E														E																																																																																																																																																																																																																																																																																																																																																																																																																	
F														F																																																																																																																																																																																																																																																																																																																																																																																																																	
G														G																																																																																																																																																																																																																																																																																																																																																																																																																	
<div><div><div>HEAT PUMP SCHEDULE</div><table><tr><th rowspan="2">EQUIPMENT TAG</th><th rowspan="2">AREA SERVED</th><th rowspan="2">AIRFLOW (CFM)</th><th rowspan="2">WEIGHT (LB)</th><th rowspan="2">ESP (IN. W.C.)</th><th colspan="6">COOLING DATA</th><th colspan="3">HEATING DATA</th><th>FILTER DATA</th><th colspan="4">ELECTRICAL DATA</th><th rowspan="2">BASIS OF DESIGN</th><th rowspan="2">NOTES</th></tr><tr><th>OA DB (°F)</th><th>EAT DB (°F)</th><th>EAT WB (°F)</th><th>LAT DB (°F)</th><th>LAT WB (°F)</th><th>NET TOTAL CAPACITY (MBH)</th><th>NET SENSIBLE CAPACITY (MBH)</th><th>OA DB (°F)</th><th>EAT DB (°F)</th><th>MECHANICAL HEATING CAPACITY (MBH)</th><th>TYPE</th><th>VOLTAGE</th><th>PHASE</th><th>MOCP (AMPS)</th><th>MCA (AMPS)</th></tr><tr><td>AHU-6351</td><td>CHLORINE BUILDING ELECTRICAL ROOM</td><td>775</td><td>50</td><td>PER MFR</td><td>99</td><td>80</td><td>67</td><td>56</td><td>55</td><td>24</td><td>20.6</td><td>9</td><td>70</td><td>13.6</td><td>WASHABLE</td><td>208</td><td>1</td><td>-</td><td>1</td><td>MTSUBISHI TPKA0A24</td><td>1, 3, 4, 5, 7</td></tr><tr><td>AHU-6352</td><td>CHLORINE BUILDING ELECTRICAL ROOM</td><td>810</td><td>60</td><td>PER MFR</td><td>99</td><td>80</td><td>67</td><td>56</td><td>55</td><td>24</td><td>20.6</td><td>9</td><td>70</td><td>13.6</td><td>WASHABLE</td><td>208</td><td>1</td><td>-</td><td>1</td><td>MTSUBISHI TPLA0A24</td><td>2, 3, 5, 7</td></tr><tr><td>AHU-6551</td><td>CAUSTIC BUILDING ELECTRICAL ROOM</td><td>775</td><td>50</td><td>PER MFR</td><td>99</td><td>80</td><td>67</td><td>56</td><td>55</td><td>24</td><td>20.6</td><td>9</td><td>70</td><td>13.6</td><td>WASHABLE</td><td>208</td><td>1</td><td>-</td><td>1</td><td>MTSUBISHI TPKA0A24</td><td>1, 3, 4, 5, 7</td></tr><tr><td>AHU-6552</td><td>CAUSTIC BUILDING ELECTRICAL ROOM</td><td>810</td><td>60</td><td>PER MFR</td><td>99</td><td>80</td><td>67</td><td>56</td><td>55</td><td>24</td><td>20.6</td><td>9</td><td>70</td><td>13.6</td><td>WASHABLE</td><td>208</td><td>1</td><td>-</td><td>1</td><td>MTSUBISHI TPLA0A24</td><td>2, 3, 5, 7</td></tr><tr><td>HP-6351</td><td>CHLORINE BUILDING ELECTRICAL ROOM</td><td>-</td><td>160</td><td>-</td><td>99</td><td>-</td><td>-</td><td>-</td><td>-</td><td>24</td><td>20.6</td><td>9</td><td>-</td><td>13.6</td><td>-</td><td>208</td><td>1</td><td>26</td><td>19</td><td>MTSUBISHI TRUZA024</td><td>6, 7, 8, 9</td></tr><tr><td>HP-6352</td><td>CHLORINE BUILDING ELECTRICAL ROOM</td><td>-</td><td>160</td><td>-</td><td>99</td><td>-</td><td>-</td><td>-</td><td>-</td><td>24</td><td>20.6</td><td>9</td><td>-</td><td>13.6</td><td>-</td><td>208</td><td>1</td><td>26</td><td>19</td><td>MTSUBISHI TRUZA024</td><td>6, 7, 8, 9</td></tr><tr><td>HP-6551</td><td>CAUSTIC BUILDING ELECTRICAL ROOM</td><td>-</td><td>160</td><td>-</td><td>99</td><td>-</td><td>-</td><td>-</td><td>-</td><td>24</td><td>20.6</td><td>9</td><td>-</td><td>13.6</td><td>-</td><td>208</td><td>1</td><td>26</td><td>19</td><td>MTSUBISHI TRUZA024</td><td>6, 7, 8, 9</td></tr><tr><td>HP-6552</td><td>CAUSTIC BUILDING ELECTRICAL ROOM</td><td>-</td><td>160</td><td>-</td><td>99</td><td>-</td><td>-</td><td>-</td><td>-</td><td>24</td><td>20.6</td><td>9</td><td>-</td><td>13.6</td><td>-</td><td>208</td><td>1</td><td>26</td><td>19</td><td>MTSUBISHI TRUZA024</td><td>6, 7, 8, 9</td></tr><tr><td colspan="11">NOTES: 1 WALL MOUNTED MINI SPLIT AIR HANDLER. 2 CEILING SUSPENDED MINI SPLIT AIR HANDLER. 3 THERMOSTAT PROVIDED BY UNIT MANUFACTURER. 4 MANUFACTURER TO PROVIDE WALL MOUNTING BRACKET KIT. 5 PROVIDE WITH INTEGRAL CONDENSATE DRAIN LIFT PUMP.</td><td colspan="5">6 GRADE MOUNTED MINI SPLIT SYSTEM HEAT PUMP. 7 MINI SPLIT HEAT PUMP UNIT TO POWER ASSOCIATED AIR HANDLER. 8 PROVIDE WITH COATING FOR MARINE ENVIRONMENTS. 9 ELECTRICAL CONTRACTOR WILL PROVIDE A NEMA 4X DISCONNECT FOR THE OUTDOOR HEAT PUMP. MANUFACTURER</td><td colspan="3"></td><td colspan="2"></td></tr></table></div></div>														EQUIPMENT TAG	AREA SERVED	AIRFLOW (CFM)	WEIGHT (LB)	ESP (IN. W.C.)	COOLING DATA						HEATING DATA			FILTER DATA	ELECTRICAL DATA				BASIS OF DESIGN	NOTES	OA DB (°F)	EAT DB (°F)	EAT WB (°F)	LAT DB (°F)	LAT WB (°F)	NET TOTAL CAPACITY (MBH)	NET SENSIBLE CAPACITY (MBH)	OA DB (°F)	EAT DB (°F)	MECHANICAL HEATING CAPACITY (MBH)	TYPE	VOLTAGE	PHASE	MOCP (AMPS)	MCA (AMPS)	AHU-6351	CHLORINE BUILDING ELECTRICAL ROOM	775	50	PER MFR	99	80	67	56	55	24	20.6	9	70	13.6	WASHABLE	208	1	-	1	MTSUBISHI TPKA0A24	1, 3, 4, 5, 7	AHU-6352	CHLORINE BUILDING ELECTRICAL ROOM	810	60	PER MFR	99	80	67	56	55	24	20.6	9	70	13.6	WASHABLE	208	1	-	1	MTSUBISHI TPLA0A24	2, 3, 5, 7	AHU-6551	CAUSTIC BUILDING ELECTRICAL ROOM	775	50	PER MFR	99	80	67	56	55	24	20.6	9	70	13.6	WASHABLE	208	1	-	1	MTSUBISHI TPKA0A24	1, 3, 4, 5, 7	AHU-6552	CAUSTIC BUILDING ELECTRICAL ROOM	810	60	PER MFR	99	80	67	56	55	24	20.6	9	70	13.6	WASHABLE	208	1	-	1	MTSUBISHI TPLA0A24	2, 3, 5, 7	HP-6351	CHLORINE BUILDING ELECTRICAL ROOM	-	160	-	99	-	-	-	-	24	20.6	9	-	13.6	-	208	1	26	19	MTSUBISHI TRUZA024	6, 7, 8, 9	HP-6352	CHLORINE BUILDING ELECTRICAL ROOM	-	160	-	99	-	-	-	-	24	20.6	9	-	13.6	-	208	1	26	19	MTSUBISHI TRUZA024	6, 7, 8, 9	HP-6551	CAUSTIC BUILDING ELECTRICAL ROOM	-	160	-	99	-	-	-	-	24	20.6	9	-	13.6	-	208	1	26	19	MTSUBISHI TRUZA024	6, 7, 8, 9	HP-6552	CAUSTIC BUILDING ELECTRICAL ROOM	-	160	-	99	-	-	-	-	24	20.6	9	-	13.6	-	208	1	26	19	MTSUBISHI TRUZA024	6, 7, 8, 9	NOTES: 1 WALL MOUNTED MINI SPLIT AIR HANDLER. 2 CEILING SUSPENDED MINI SPLIT AIR HANDLER. 3 THERMOSTAT PROVIDED BY UNIT MANUFACTURER. 4 MANUFACTURER TO PROVIDE WALL MOUNTING BRACKET KIT. 5 PROVIDE WITH INTEGRAL CONDENSATE DRAIN LIFT PUMP.											6 GRADE MOUNTED MINI SPLIT SYSTEM HEAT PUMP. 7 MINI SPLIT HEAT PUMP UNIT TO POWER ASSOCIATED AIR HANDLER. 8 PROVIDE WITH COATING FOR MARINE ENVIRONMENTS. 9 ELECTRICAL CONTRACTOR WILL PROVIDE A NEMA 4X DISCONNECT FOR THE OUTDOOR HEAT PUMP. MANUFACTURER																																																																																																																																																																																		
EQUIPMENT TAG	AREA SERVED	AIRFLOW (CFM)	WEIGHT (LB)	ESP (IN. W.C.)	COOLING DATA						HEATING DATA								FILTER DATA	ELECTRICAL DATA				BASIS OF DESIGN	NOTES																																																																																																																																																																																																																																																																																																																																																																																																						
					OA DB (°F)	EAT DB (°F)	EAT WB (°F)	LAT DB (°F)	LAT WB (°F)	NET TOTAL CAPACITY (MBH)	NET SENSIBLE CAPACITY (MBH)	OA DB (°F)	EAT DB (°F)	MECHANICAL HEATING CAPACITY (MBH)	TYPE	VOLTAGE	PHASE	MOCP (AMPS)	MCA (AMPS)																																																																																																																																																																																																																																																																																																																																																																																																												
AHU-6351	CHLORINE BUILDING ELECTRICAL ROOM	775	50	PER MFR	99	80	67	56	55	24	20.6	9	70	13.6	WASHABLE	208	1	-	1	MTSUBISHI TPKA0A24	1, 3, 4, 5, 7																																																																																																																																																																																																																																																																																																																																																																																																										
AHU-6352	CHLORINE BUILDING ELECTRICAL ROOM	810	60	PER MFR	99	80	67	56	55	24	20.6	9	70	13.6	WASHABLE	208	1	-	1	MTSUBISHI TPLA0A24	2, 3, 5, 7																																																																																																																																																																																																																																																																																																																																																																																																										
AHU-6551	CAUSTIC BUILDING ELECTRICAL ROOM	775	50	PER MFR	99	80	67	56	55	24	20.6	9	70	13.6	WASHABLE	208	1	-	1	MTSUBISHI TPKA0A24	1, 3, 4, 5, 7																																																																																																																																																																																																																																																																																																																																																																																																										
AHU-6552	CAUSTIC BUILDING ELECTRICAL ROOM	810	60	PER MFR	99	80	67	56	55	24	20.6	9	70	13.6	WASHABLE	208	1	-	1	MTSUBISHI TPLA0A24	2, 3, 5, 7																																																																																																																																																																																																																																																																																																																																																																																																										
HP-6351	CHLORINE BUILDING ELECTRICAL ROOM	-	160	-	99	-	-	-	-	24	20.6	9	-	13.6	-	208	1	26	19	MTSUBISHI TRUZA024	6, 7, 8, 9																																																																																																																																																																																																																																																																																																																																																																																																										
HP-6352	CHLORINE BUILDING ELECTRICAL ROOM	-	160	-	99	-	-	-	-	24	20.6	9	-	13.6	-	208	1	26	19	MTSUBISHI TRUZA024	6, 7, 8, 9																																																																																																																																																																																																																																																																																																																																																																																																										
HP-6551	CAUSTIC BUILDING ELECTRICAL ROOM	-	160	-	99	-	-	-	-	24	20.6	9	-	13.6	-	208	1	26	19	MTSUBISHI TRUZA024	6, 7, 8, 9																																																																																																																																																																																																																																																																																																																																																																																																										
HP-6552	CAUSTIC BUILDING ELECTRICAL ROOM	-	160	-	99	-	-	-	-	24	20.6	9	-	13.6	-	208	1	26	19	MTSUBISHI TRUZA024	6, 7, 8, 9																																																																																																																																																																																																																																																																																																																																																																																																										
NOTES: 1 WALL MOUNTED MINI SPLIT AIR HANDLER. 2 CEILING SUSPENDED MINI SPLIT AIR HANDLER. 3 THERMOSTAT PROVIDED BY UNIT MANUFACTURER. 4 MANUFACTURER TO PROVIDE WALL MOUNTING BRACKET KIT. 5 PROVIDE WITH INTEGRAL CONDENSATE DRAIN LIFT PUMP.											6 GRADE MOUNTED MINI SPLIT SYSTEM HEAT PUMP. 7 MINI SPLIT HEAT PUMP UNIT TO POWER ASSOCIATED AIR HANDLER. 8 PROVIDE WITH COATING FOR MARINE ENVIRONMENTS. 9 ELECTRICAL CONTRACTOR WILL PROVIDE A NEMA 4X DISCONNECT FOR THE OUTDOOR HEAT PUMP. MANUFACTURER																																																																																																																																																																																																																																																																																																																																																																																																																				
<div><div><div>FAN SCHEDULE</div><table><tr><th rowspan="2">EQUIPMENT TAG</th><th rowspan="2">AREA SERVED</th><th rowspan="2">FAN TYPE</th><th rowspan="2">AIR FLOW (CFM)</th><th rowspan="2">WEIGHT (LB)</th><th rowspan="2">ESP (IN. W.C.)</th><th rowspan="2">FAN RPM</th><th rowspan="2">NOISE (SONES)</th><th colspan="2">MOTOR</th><th rowspan="2">DRIVE TYPE</th><th colspan="2">ELECTRICAL DATA</th><th rowspan="2">BASIS OF DESIGN</th><th rowspan="2">NOTES</th></tr><tr><th>HP</th><th>AMPS</th><th>RPM</th><th>ENCLOSURE</th><th>VOLTAGE</th><th>PHASE</th></tr><tr><td>EF-4151</td><td>BACKWASH VAULT</td><td>TYPE 6</td><td>200</td><td>6</td><td>0.5</td><td>2632</td><td>PER MFR</td><td>-</td><td>0.59</td><td>PER MFR</td><td>PER MFR</td><td>PER MFR</td><td>120</td><td>1</td><td>FANTECH FR-150</td><td>11</td></tr><tr><td>EF-6355</td><td>CHLORINE BUILDING CHLORINE STORAGE ROOM</td><td>TYPE 2</td><td>15800</td><td>560</td><td>1</td><td>530</td><td>19</td><td>5</td><td>-</td><td>1725</td><td>TEFC</td><td>BELT</td><td>480</td><td>3</td><td>GREENHECK CUBE-420-50</td><td>1, 2, 3, 4, 5, 6, 8, 9</td></tr><tr><td>EF-6356</td><td>CHLORINE BUILDING CHLORINE STORAGE ROOM</td><td>TYPE 2</td><td>15800</td><td>540</td><td>0.5</td><td>454</td><td>16</td><td>3</td><td>-</td><td>1725</td><td>TEFC</td><td>BELT</td><td>480</td><td>3</td><td>GREENHECK CUBE-420-30</td><td>1, 2, 3, 4, 5, 6, 8, 9</td></tr><tr><td>EF-6357</td><td>CHLORINE BUILDING CHLORINATOR ROOM</td><td>TYPE 7</td><td>550</td><td>90</td><td>0.5</td><td>1774</td><td>15</td><td>1/4</td><td>-</td><td>1725</td><td>TEFC</td><td>BELT</td><td>208</td><td>1</td><td>GREENHECK BSQ-80</td><td>3, 4, 5, 8, 10, 9</td></tr><tr><td>EF-6554</td><td>CAUSTIC SODA STORAGE ROOM</td><td>TYPE 2</td><td>9400</td><td>280</td><td>1</td><td>778</td><td>20</td><td>3</td><td>-</td><td>1725</td><td>TEFC</td><td>BELT</td><td>480</td><td>3</td><td>GREENHECK CUBE-300-30</td><td>1, 2, 3, 4, 5, 6, 8, 9</td></tr><tr><td>EF-6555</td><td>CAUSTIC SODA STORAGE ROOM</td><td>TYPE 3</td><td>9400</td><td>250</td><td>0.375</td><td>648</td><td>17</td><td>2</td><td>-</td><td>1725</td><td>TEFC</td><td>BELT</td><td>480</td><td>3</td><td>GREENHECK CUBE-300-20</td><td>1, 2, 3, 4, 5, 6, 8, 9</td></tr><tr><td>SF-6368</td><td>CHLORINE BUILDING MECHANICAL ROOM</td><td>TYPE 7</td><td>250</td><td>90</td><td>0.5</td><td>1328</td><td>9.1</td><td>1/2</td><td>-</td><td>1725</td><td>TEFC</td><td>BELT</td><td>208</td><td>1</td><td>GREENHECK BSQ-80</td><td>3, 4, 5, 8, 10, 9</td></tr><tr><td>SF-6556</td><td>CAUSTIC SODA STORAGE ROOM</td><td>TYPE 3</td><td>8400</td><td>400</td><td>0.375</td><td>614</td><td>0</td><td>3</td><td>-</td><td>1725</td><td>TEFC</td><td>BELT</td><td>480</td><td>3</td><td>GREENHECK RSF-180-30</td><td>2, 3, 4, 5, 6, 7, 8, 9</td></tr><tr><td colspan="11">NOTES: 1 PROVIDE BIRD SCREEN. 2 PROVIDE LIFTING LUGS. 3 PROVIDE CONTROLS TO INTERLOCK WITH EQUIPMENT AS SPECIFIED IN SECTION 15936. 4 PROVIDE VIBRATION ISOLATORS. 5 PROVIDE ADJUSTABLE BELT SHEAVES AND BELT GUARD. 6 PROVIDE 36-INCH 304 STAINLESS STEEL MANUFACTURER CONSTRUCTED ROOF CURB.</td><td colspan="5">7 PROVIDE ALUMINUM WASHABLE TYPE FILTERS. 8 PROVIDE PROTECTIVE COATING PER SECTION 15830. 9 MANUFACTURER TO PROVIDE DISCONNECT SWITCH AT FAN, NEMA TYPE 4X. 10 ELECTRICAL CONTRACTOR TO PROVIDE DISCONNECT SWITCH AT FAN, NEMA TYPE 4X. 11 PROVIDE BACKDRAFT DAMPER, COUNTERBALANCED FOR MINIMUM PRESSURE LOSS.</td><td colspan="2"></td></tr></table></div></div>														EQUIPMENT TAG	AREA SERVED	FAN TYPE	AIR FLOW (CFM)	WEIGHT (LB)	ESP (IN. W.C.)	FAN RPM	NOISE (SONES)	MOTOR		DRIVE TYPE	ELECTRICAL DATA		BASIS OF DESIGN	NOTES	HP	AMPS	RPM	ENCLOSURE	VOLTAGE	PHASE	EF-4151	BACKWASH VAULT	TYPE 6	200	6	0.5	2632	PER MFR	-	0.59	PER MFR	PER MFR	PER MFR	120	1	FANTECH FR-150	11	EF-6355	CHLORINE BUILDING CHLORINE STORAGE ROOM	TYPE 2	15800	560	1	530	19	5	-	1725	TEFC	BELT	480	3	GREENHECK CUBE-420-50	1, 2, 3, 4, 5, 6, 8, 9	EF-6356	CHLORINE BUILDING CHLORINE STORAGE ROOM	TYPE 2	15800	540	0.5	454	16	3	-	1725	TEFC	BELT	480	3	GREENHECK CUBE-420-30	1, 2, 3, 4, 5, 6, 8, 9	EF-6357	CHLORINE BUILDING CHLORINATOR ROOM	TYPE 7	550	90	0.5	1774	15	1/4	-	1725	TEFC	BELT	208	1	GREENHECK BSQ-80	3, 4, 5, 8, 10, 9	EF-6554	CAUSTIC SODA STORAGE ROOM	TYPE 2	9400	280	1	778	20	3	-	1725	TEFC	BELT	480	3	GREENHECK CUBE-300-30	1, 2, 3, 4, 5, 6, 8, 9	EF-6555	CAUSTIC SODA STORAGE ROOM	TYPE 3	9400	250	0.375	648	17	2	-	1725	TEFC	BELT	480	3	GREENHECK CUBE-300-20	1, 2, 3, 4, 5, 6, 8, 9	SF-6368	CHLORINE BUILDING MECHANICAL ROOM	TYPE 7	250	90	0.5	1328	9.1	1/2	-	1725	TEFC	BELT	208	1	GREENHECK BSQ-80	3, 4, 5, 8, 10, 9	SF-6556	CAUSTIC SODA STORAGE ROOM	TYPE 3	8400	400	0.375	614	0	3	-	1725	TEFC	BELT	480	3	GREENHECK RSF-180-30	2, 3, 4, 5, 6, 7, 8, 9	NOTES: 1 PROVIDE BIRD SCREEN. 2 PROVIDE LIFTING LUGS. 3 PROVIDE CONTROLS TO INTERLOCK WITH EQUIPMENT AS SPECIFIED IN SECTION 15936. 4 PROVIDE VIBRATION ISOLATORS. 5 PROVIDE ADJUSTABLE BELT SHEAVES AND BELT GUARD. 6 PROVIDE 36-INCH 304 STAINLESS STEEL MANUFACTURER CONSTRUCTED ROOF CURB.											7 PROVIDE ALUMINUM WASHABLE TYPE FILTERS. 8 PROVIDE PROTECTIVE COATING PER SECTION 15830. 9 MANUFACTURER TO PROVIDE DISCONNECT SWITCH AT FAN, NEMA TYPE 4X. 10 ELECTRICAL CONTRACTOR TO PROVIDE DISCONNECT SWITCH AT FAN, NEMA TYPE 4X. 11 PROVIDE BACKDRAFT DAMPER, COUNTERBALANCED FOR MINIMUM PRESSURE LOSS.																																																																																																																																																																																																																																									
EQUIPMENT TAG	AREA SERVED	FAN TYPE	AIR FLOW (CFM)	WEIGHT (LB)	ESP (IN. W.C.)	FAN RPM	NOISE (SONES)	MOTOR		DRIVE TYPE	ELECTRICAL DATA		BASIS OF DESIGN									NOTES																																																																																																																																																																																																																																																																																																																																																																																																									
								HP	AMPS		RPM	ENCLOSURE		VOLTAGE	PHASE																																																																																																																																																																																																																																																																																																																																																																																																																
EF-4151	BACKWASH VAULT	TYPE 6	200	6	0.5	2632	PER MFR	-	0.59	PER MFR	PER MFR	PER MFR	120	1	FANTECH FR-150	11																																																																																																																																																																																																																																																																																																																																																																																																															
EF-6355	CHLORINE BUILDING CHLORINE STORAGE ROOM	TYPE 2	15800	560	1	530	19	5	-	1725	TEFC	BELT	480	3	GREENHECK CUBE-420-50	1, 2, 3, 4, 5, 6, 8, 9																																																																																																																																																																																																																																																																																																																																																																																																															
EF-6356	CHLORINE BUILDING CHLORINE STORAGE ROOM	TYPE 2	15800	540	0.5	454	16	3	-	1725	TEFC	BELT	480	3	GREENHECK CUBE-420-30	1, 2, 3, 4, 5, 6, 8, 9																																																																																																																																																																																																																																																																																																																																																																																																															
EF-6357	CHLORINE BUILDING CHLORINATOR ROOM	TYPE 7	550	90	0.5	1774	15	1/4	-	1725	TEFC	BELT	208	1	GREENHECK BSQ-80	3, 4, 5, 8, 10, 9																																																																																																																																																																																																																																																																																																																																																																																																															
EF-6554	CAUSTIC SODA STORAGE ROOM	TYPE 2	9400	280	1	778	20	3	-	1725	TEFC	BELT	480	3	GREENHECK CUBE-300-30	1, 2, 3, 4, 5, 6, 8, 9																																																																																																																																																																																																																																																																																																																																																																																																															
EF-6555	CAUSTIC SODA STORAGE ROOM	TYPE 3	9400	250	0.375	648	17	2	-	1725	TEFC	BELT	480	3	GREENHECK CUBE-300-20	1, 2, 3, 4, 5, 6, 8, 9																																																																																																																																																																																																																																																																																																																																																																																																															
SF-6368	CHLORINE BUILDING MECHANICAL ROOM	TYPE 7	250	90	0.5	1328	9.1	1/2	-	1725	TEFC	BELT	208	1	GREENHECK BSQ-80	3, 4, 5, 8, 10, 9																																																																																																																																																																																																																																																																																																																																																																																																															
SF-6556	CAUSTIC SODA STORAGE ROOM	TYPE 3	8400	400	0.375	614	0	3	-	1725	TEFC	BELT	480	3	GREENHECK RSF-180-30	2, 3, 4, 5, 6, 7, 8, 9																																																																																																																																																																																																																																																																																																																																																																																																															
NOTES: 1 PROVIDE BIRD SCREEN. 2 PROVIDE LIFTING LUGS. 3 PROVIDE CONTROLS TO INTERLOCK WITH EQUIPMENT AS SPECIFIED IN SECTION 15936. 4 PROVIDE VIBRATION ISOLATORS. 5 PROVIDE ADJUSTABLE BELT SHEAVES AND BELT GUARD. 6 PROVIDE 36-INCH 304 STAINLESS STEEL MANUFACTURER CONSTRUCTED ROOF CURB.											7 PROVIDE ALUMINUM WASHABLE TYPE FILTERS. 8 PROVIDE PROTECTIVE COATING PER SECTION 15830. 9 MANUFACTURER TO PROVIDE DISCONNECT SWITCH AT FAN, NEMA TYPE 4X. 10 ELECTRICAL CONTRACTOR TO PROVIDE DISCONNECT SWITCH AT FAN, NEMA TYPE 4X. 11 PROVIDE BACKDRAFT DAMPER, COUNTERBALANCED FOR MINIMUM PRESSURE LOSS.																																																																																																																																																																																																																																																																																																																																																																																																																				
<div><div><div>MAKE-UP AIR UNIT SCHEDULE</div><table><tr><th rowspan="3">EQUIPMENT TAG</th><th rowspan="3">AREA SERVED</th><th rowspan="3">WEIGHT (LB)</th><th rowspan="3">HEAT/COOL TYPE</th><th rowspan="3">SA DISCHARGE LOCATION</th><th colspan="4">SUPPLY FAN</th><th colspan="5">HEATING</th><th colspan="2">FILTER</th><th colspan="4">ELECTRICAL DATA</th><th rowspan="3">BASIS OF DESIGN</th><th rowspan="3">NOTES</th></tr><tr><th rowspan="2">AIRFLOW (CFM)</th><th rowspan="2">ESP (IN. W.C.)</th><th rowspan="2">MOTOR HP</th><th rowspan="2">MOTOR ENCLOSURE</th><th rowspan="2">EAT (°F)</th><th rowspan="2">LAT (°F)</th><th rowspan="2">AIRFLOW (CFM)</th><th colspan="3">GAS HEATING</th><th rowspan="2">TYPE</th><th rowspan="2">THICKNESS (IN.)</th><th rowspan="2">MCA (AMPS)</th><th rowspan="2">MOP (AMPS)</th><th rowspan="2">VOLTAGE</th><th colspan="2">PHASE</th></tr><tr><th>MODULATING TURNDOWN RATIO</th><th>INPUT CAPACITY (MBH)</th><th>OUTPUT CAPACITY (MBH)</th></tr><tr><td>MAU-6354</td><td>CHLORINE BUILDING</td><td>5850</td><td>HEATING</td><td>BOTTOM</td><td>15400</td><td>1</td><td>10</td><td>TEFC</td><td>9</td><td>75</td><td>14000</td><td>15:01</td><td>1123</td><td>910</td><td>MERV 8</td><td>2</td><td>23.2</td><td>35</td><td>480</td><td>3</td><td>ENGINEERED AIR DJS140/O</td><td>1, 2, 3, 4, 5, 6, 7, 8, 9</td></tr><tr><td>MAU-6560</td><td>CAUSTIC SODA BUILDING</td><td>4750</td><td>HEATING</td><td>BOTTOM</td><td>9240</td><td>1</td><td>10</td><td>TEFC</td><td>9</td><td>75</td><td>8400</td><td>15:01</td><td>656</td><td>531</td><td>MERV 8</td><td>2</td><td>23.2</td><td>35</td><td>480</td><td>3</td><td>ENGINEERED AIR DJS100/O</td><td>1, 2, 3, 4, 5, 6, 7, 8, 9</td></tr><tr><td colspan="11">NOTES: 1 PROVIDE 36-INCH 304 STAINLESS STEEL MANUFACTURER CONSTRUCTED ROOF CURB. 2 PROVIDE WEATHER INTAKE HOOD. 3 PROVIDE INTEGRAL SMOKE DETECTOR WITH UNIT. SMOKE DETECTOR SHALL BE POWERED BY MAU. 4 UNIT SHALL BE CAPABLE OF PROVIDING ERROR FAULT CODES TO DIAGNOSE FAILURES. SHALL BE LOCATED AT UNIT. 5 BOTTOM DISCHARGE FOR SUPPLY AIR.</td><td colspan="5">6 UNIT TO BE ALL 316 STAINLESS STEEL CONSTRUCTION. 7 PROVIDE GAS REGULATOR AT UNIT. SET DISCHARGE PRESSURE PER MFR REQUIRI 8 NEMA 4X DISCONNECT SHALL BE PROVIDED BY MANUFACTURER. 9 MANUFACTURER TO PROVIDE NEMA TYPE 4X CONTROL PANEL.</td><td colspan="7"></td></tr></table></div></div>														EQUIPMENT TAG	AREA SERVED	WEIGHT (LB)	HEAT/COOL TYPE	SA DISCHARGE LOCATION	SUPPLY FAN				HEATING					FILTER		ELECTRICAL DATA				BASIS OF DESIGN	NOTES	AIRFLOW (CFM)	ESP (IN. W.C.)	MOTOR HP	MOTOR ENCLOSURE	EAT (°F)	LAT (°F)	AIRFLOW (CFM)	GAS HEATING			TYPE	THICKNESS (IN.)	MCA (AMPS)	MOP (AMPS)	VOLTAGE	PHASE		MODULATING TURNDOWN RATIO	INPUT CAPACITY (MBH)	OUTPUT CAPACITY (MBH)	MAU-6354	CHLORINE BUILDING	5850	HEATING	BOTTOM	15400	1	10	TEFC	9	75	14000	15:01	1123	910	MERV 8	2	23.2	35	480	3	ENGINEERED AIR DJS140/O	1, 2, 3, 4, 5, 6, 7, 8, 9	MAU-6560	CAUSTIC SODA BUILDING	4750	HEATING	BOTTOM	9240	1	10	TEFC	9	75	8400	15:01	656	531	MERV 8	2	23.2	35	480	3	ENGINEERED AIR DJS100/O	1, 2, 3, 4, 5, 6, 7, 8, 9	NOTES: 1 PROVIDE 36-INCH 304 STAINLESS STEEL MANUFACTURER CONSTRUCTED ROOF CURB. 2 PROVIDE WEATHER INTAKE HOOD. 3 PROVIDE INTEGRAL SMOKE DETECTOR WITH UNIT. SMOKE DETECTOR SHALL BE POWERED BY MAU. 4 UNIT SHALL BE CAPABLE OF PROVIDING ERROR FAULT CODES TO DIAGNOSE FAILURES. SHALL BE LOCATED AT UNIT. 5 BOTTOM DISCHARGE FOR SUPPLY AIR.											6 UNIT TO BE ALL 316 STAINLESS STEEL CONSTRUCTION. 7 PROVIDE GAS REGULATOR AT UNIT. SET DISCHARGE PRESSURE PER MFR REQUIRI 8 NEMA 4X DISCONNECT SHALL BE PROVIDED BY MANUFACTURER. 9 MANUFACTURER TO PROVIDE NEMA TYPE 4X CONTROL PANEL.																																																																																																																																																																																																																																																																																																														
EQUIPMENT TAG	AREA SERVED	WEIGHT (LB)	HEAT/COOL TYPE	SA DISCHARGE LOCATION	SUPPLY FAN				HEATING										FILTER		ELECTRICAL DATA				BASIS OF DESIGN	NOTES																																																																																																																																																																																																																																																																																																																																																																																																					
					AIRFLOW (CFM)	ESP (IN. W.C.)	MOTOR HP	MOTOR ENCLOSURE	EAT (°F)	LAT (°F)	AIRFLOW (CFM)	GAS HEATING							TYPE	THICKNESS (IN.)	MCA (AMPS)	MOP (AMPS)	VOLTAGE	PHASE																																																																																																																																																																																																																																																																																																																																																																																																							
												MODULATING TURNDOWN RATIO	INPUT CAPACITY (MBH)	OUTPUT CAPACITY (MBH)																																																																																																																																																																																																																																																																																																																																																																																																																	
MAU-6354	CHLORINE BUILDING	5850	HEATING	BOTTOM	15400	1	10	TEFC	9	75	14000	15:01	1123	910	MERV 8	2	23.2	35	480	3	ENGINEERED AIR DJS140/O	1, 2, 3, 4, 5, 6, 7, 8, 9																																																																																																																																																																																																																																																																																																																																																																																																									
MAU-6560	CAUSTIC SODA BUILDING	4750	HEATING	BOTTOM	9240	1	10	TEFC	9	75	8400	15:01	656	531	MERV 8	2	23.2	35	480	3	ENGINEERED AIR DJS100/O	1, 2, 3, 4, 5, 6, 7, 8, 9																																																																																																																																																																																																																																																																																																																																																																																																									
NOTES: 1 PROVIDE 36-INCH 304 STAINLESS STEEL MANUFACTURER CONSTRUCTED ROOF CURB. 2 PROVIDE WEATHER INTAKE HOOD. 3 PROVIDE INTEGRAL SMOKE DETECTOR WITH UNIT. SMOKE DETECTOR SHALL BE POWERED BY MAU. 4 UNIT SHALL BE CAPABLE OF PROVIDING ERROR FAULT CODES TO DIAGNOSE FAILURES. SHALL BE LOCATED AT UNIT. 5 BOTTOM DISCHARGE FOR SUPPLY AIR.											6 UNIT TO BE ALL 316 STAINLESS STEEL CONSTRUCTION. 7 PROVIDE GAS REGULATOR AT UNIT. SET DISCHARGE PRESSURE PER MFR REQUIRI 8 NEMA 4X DISCONNECT SHALL BE PROVIDED BY MANUFACTURER. 9 MANUFACTURER TO PROVIDE NEMA TYPE 4X CONTROL PANEL.																																																																																																																																																																																																																																																																																																																																																																																																																				
<div><div><div>BID SET</div><table><tr><td></td><td></td><td></td><td></td><td>DESIGNED TPL</td><td rowspan="4"></td><td></td><td></td><td></td><td></td><td></td><td></td><td></td><td></td><td></td><td>JORDAN VALLEY WATER TREATMENT PLANT</td><td>VERIFY SCALES</td><td>JOB NO. 202001.10</td></tr><tr><td></td><td></td><td></td><td></td><td>DRAWN CY</td><td></td><td></td><td></td><td></td><td></td><td></td><td></td><td></td><td></td><td></td><td>FILTER AND CHEMICAL FEED UPGRADES</td><td>BAR IS ONE INCH ON ORIGINAL DRAWING</td><td>DRAWING NO. 00GH02</td></tr><tr><td></td><td></td><td></td><td></td><td>CHECKED CAG</td><td></td><td></td><td></td><td></td><td></td><td></td><td></td><td></td><td></td><td></td><td>HVAC</td><td>0  1"</td><td>SHEET NO. OF</td></tr><tr><td></td><td></td><td></td><td></td><td>DATE FEBRUARY 2025</td><td></td><td></td><td></td><td></td><td></td><td></td><td></td><td></td><td></td><td></td><td>EQUIPMENT SCHEDULES 1</td><td>IF NOT ONE INCH ON THIS SHEET, ADJUST SCALES ACCORDINGLY</td><td></td></tr><tr><td></td><td>05/15/2025</td><td>AID</td><td>ADDENDUM NO. 4</td><td></td><td></td><td></td><td></td><td></td><td></td><td></td><td></td><td></td><td></td><td></td><td></td><td></td><td></td><td></td><td></td><td></td><td></td></tr><tr><td>REV</td><td>DATE</td><td>BY</td><td>DESCRIPTION</td><td></td><td></td><td></td><td></td><td></td><td></td><td></td><td></td><td></td><td></td><td></td><td></td><td></td><td></td><td></td><td></td><td></td><td></td></tr><tr><td>1</td><td></td><td></td><td></td><td></td><td></td><td></td><td></td><td></td><td></td><td></td><td></td><td></td><td></td><td></td><td></td><td></td><td>td><td></td><td></td></tr></table></div></div>																		DESIGNED TPL											JORDAN VALLEY WATER TREATMENT PLANT	VERIFY SCALES	JOB NO. 202001.10					DRAWN CY											FILTER AND CHEMICAL FEED UPGRADES	BAR IS ONE INCH ON ORIGINAL DRAWING	DRAWING NO. 00GH02					CHECKED CAG											HVAC	0  1"	SHEET NO. OF					DATE FEBRUARY 2025											EQUIPMENT SCHEDULES 1	IF NOT ONE INCH ON THIS SHEET, ADJUST SCALES ACCORDINGLY			05/15/2025	AID	ADDENDUM NO. 4																			REV	DATE	BY	DESCRIPTION																			1																						2																						3																						4																						5																						6																						7																						8																						9																						10																						11																						12																						13																					
				DESIGNED TPL											JORDAN VALLEY WATER TREATMENT PLANT	VERIFY SCALES	JOB NO. 202001.10																																																																																																																																																																																																																																																																																																																																																																																																														
				DRAWN CY												FILTER AND CHEMICAL FEED UPGRADES	BAR IS ONE INCH ON ORIGINAL DRAWING	DRAWING NO. 00GH02																																																																																																																																																																																																																																																																																																																																																																																																													
				CHECKED CAG												HVAC	0  1"	SHEET NO. OF																																																																																																																																																																																																																																																																																																																																																																																																													
				DATE FEBRUARY 2025												EQUIPMENT SCHEDULES 1	IF NOT ONE INCH ON THIS SHEET, ADJUST SCALES ACCORDINGLY																																																																																																																																																																																																																																																																																																																																																																																																														
	05/15/2025	AID	ADDENDUM NO. 4																																																																																																																																																																																																																																																																																																																																																																																																																												
REV	DATE	BY	DESCRIPTION																																																																																																																																																																																																																																																																																																																																																																																																																												
1																																																																																																																																																																																																																																																																																																																																																																																																																															
2																																																																																																																																																																																																																																																																																																																																																																																																																															
3																																																																																																																																																																																																																																																																																																																																																																																																																															
4																																																																																																																																																																																																																																																																																																																																																																																																																															
5																																																																																																																																																																																																																																																																																																																																																																																																																															
6																																																																																																																																																																																																																																																																																																																																																																																																																															
7																																																																																																																																																																																																																																																																																																																																																																																																																															
8																																																																																																																																																																																																																																																																																																																																																																																																																															
9																																																																																																																																																																																																																																																																																																																																																																																																																															
10																																																																																																																																																																																																																																																																																																																																																																																																																															
11																																																																																																																																																																																																																																																																																																																																																																																																																															
12																																																																																																																																																																																																																																																																																																																																																																																																																															
13																																																																																																																																																																																																																																																																																																																																																																																																																															
<div><div><div>PROJECT NO. 202001-100000</div><div>FILE NAME: 20200100GH02.dgn</div></div></div>																																																																																																																																																																																																																																																																																																																																																																																																																															




Plot Date: 9/12/2022 7:29:07 AM

LAST SAVED BY: jdbiriones

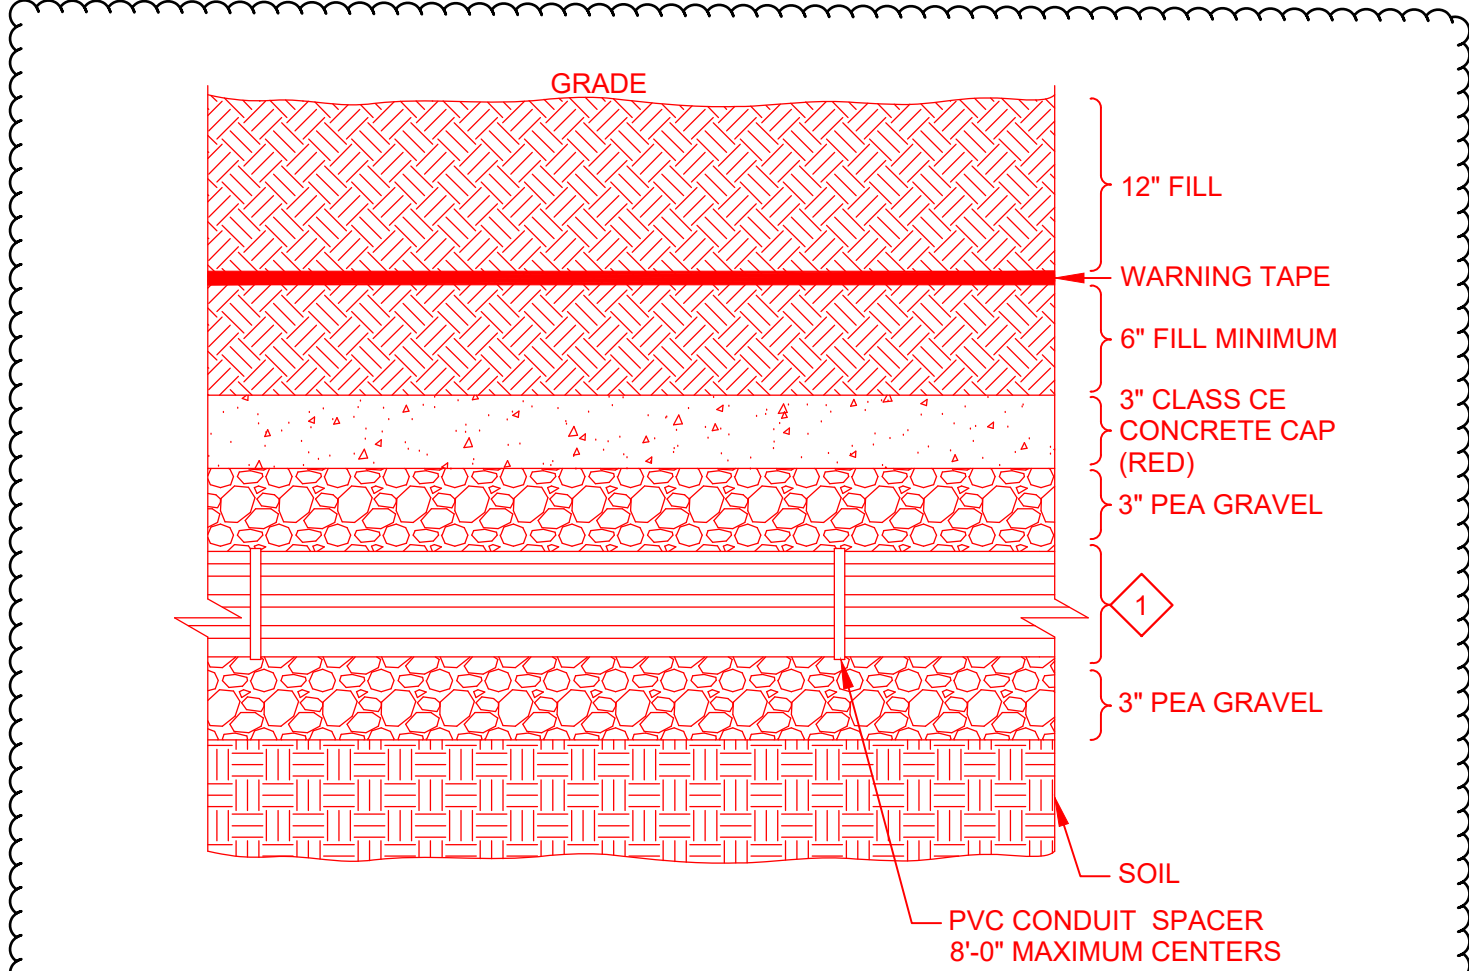


- GENERAL NOTES:**
- ALL DIMENSIONS ARE MINIMUM UNLESS OTHERWISE INDICATED ON THE DRAWINGS.
 - REFER TO THE SPECIFICATIONS FOR TRENCH BACKFILL REQUIREMENTS.
 - PROVIDE CONCRETE CAP ON ALL DUCT BANKS UNLESS OTHERWISE INDICATED ON THE DRAWINGS.
 - REFER TO THE SPECIFICATIONS FOR MATERIAL REQUIREMENTS.
- KEY NOTES:**
- REFER TO DUCT BANK AND CONDUIT SCHEDULES FOR CONDUIT REQUIREMENTS.

EM015 PEA GRAVEL EMBEDDED DUCT BANK
TYP
01/23/25

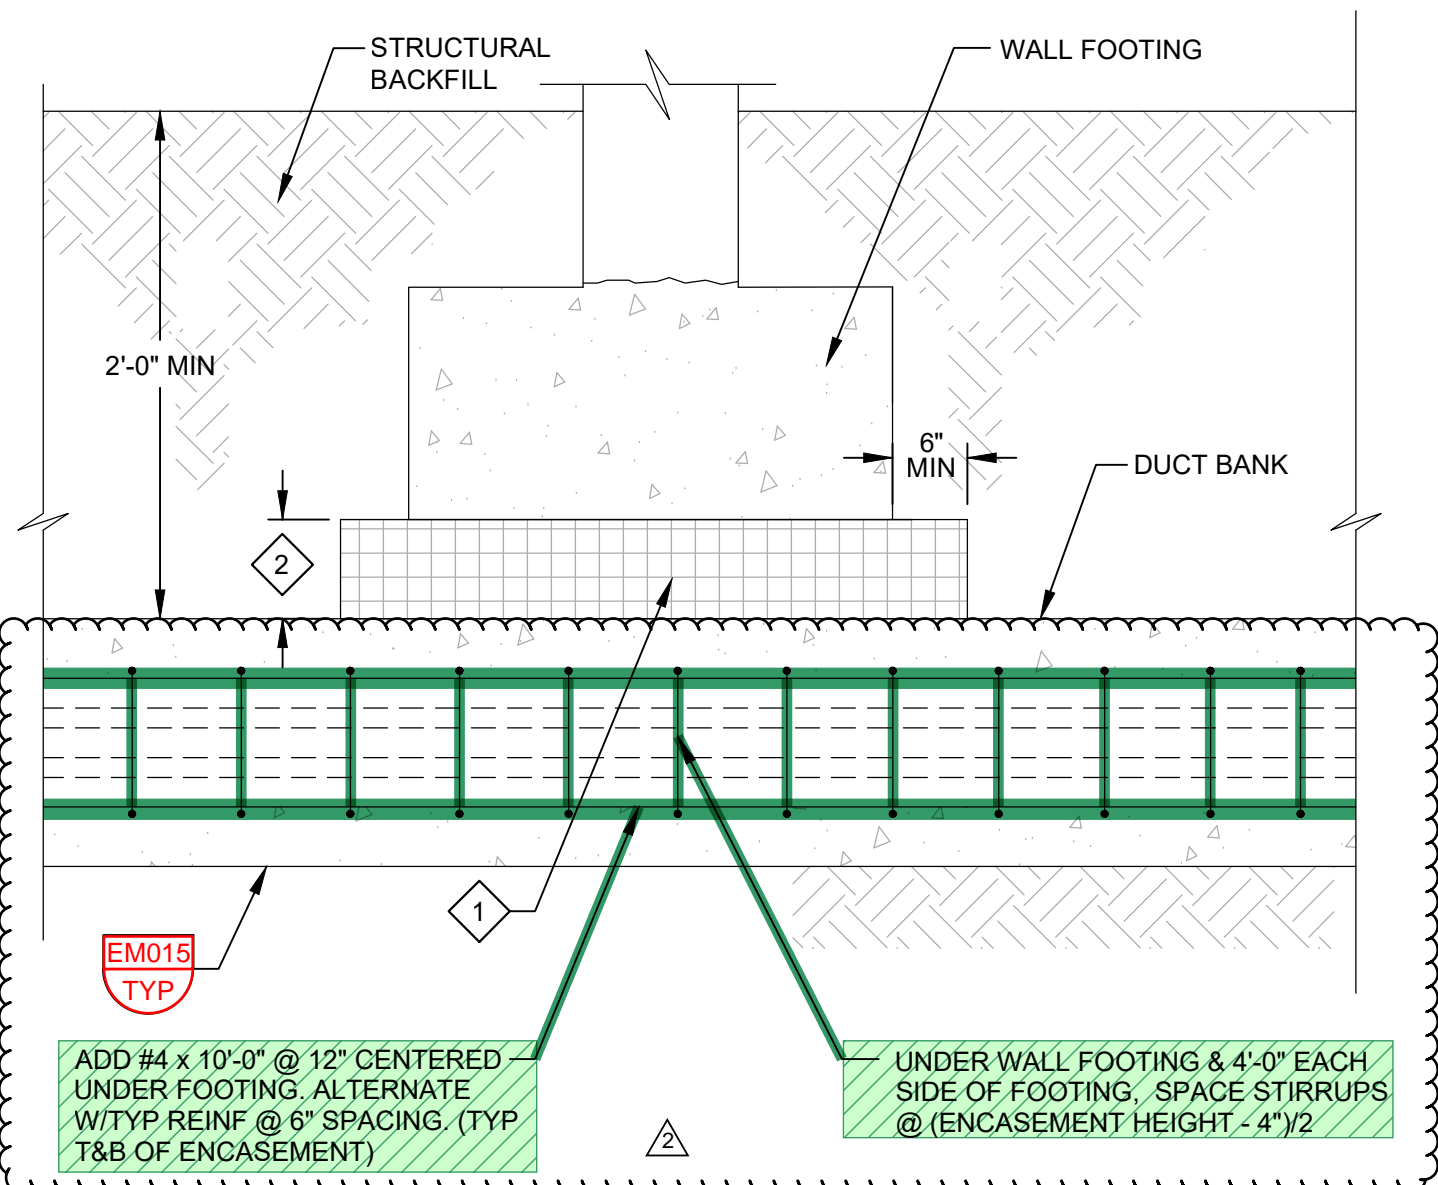


- KEY NOTES:**
- EXPANDED POLYPROPYLENE OR SIMILAR ENERGY ABSORBING COMPRESSIBLE MATERIAL.
 - REFER TO SPECIFICATIONS FOR REQUIRED MINIMUM DISTANCE BETWEEN TOP OF DUCT BANK AND BOTTOM FOOTER.

EM021 DUCT BANK CROSSING UNDER FOOTER
TYP

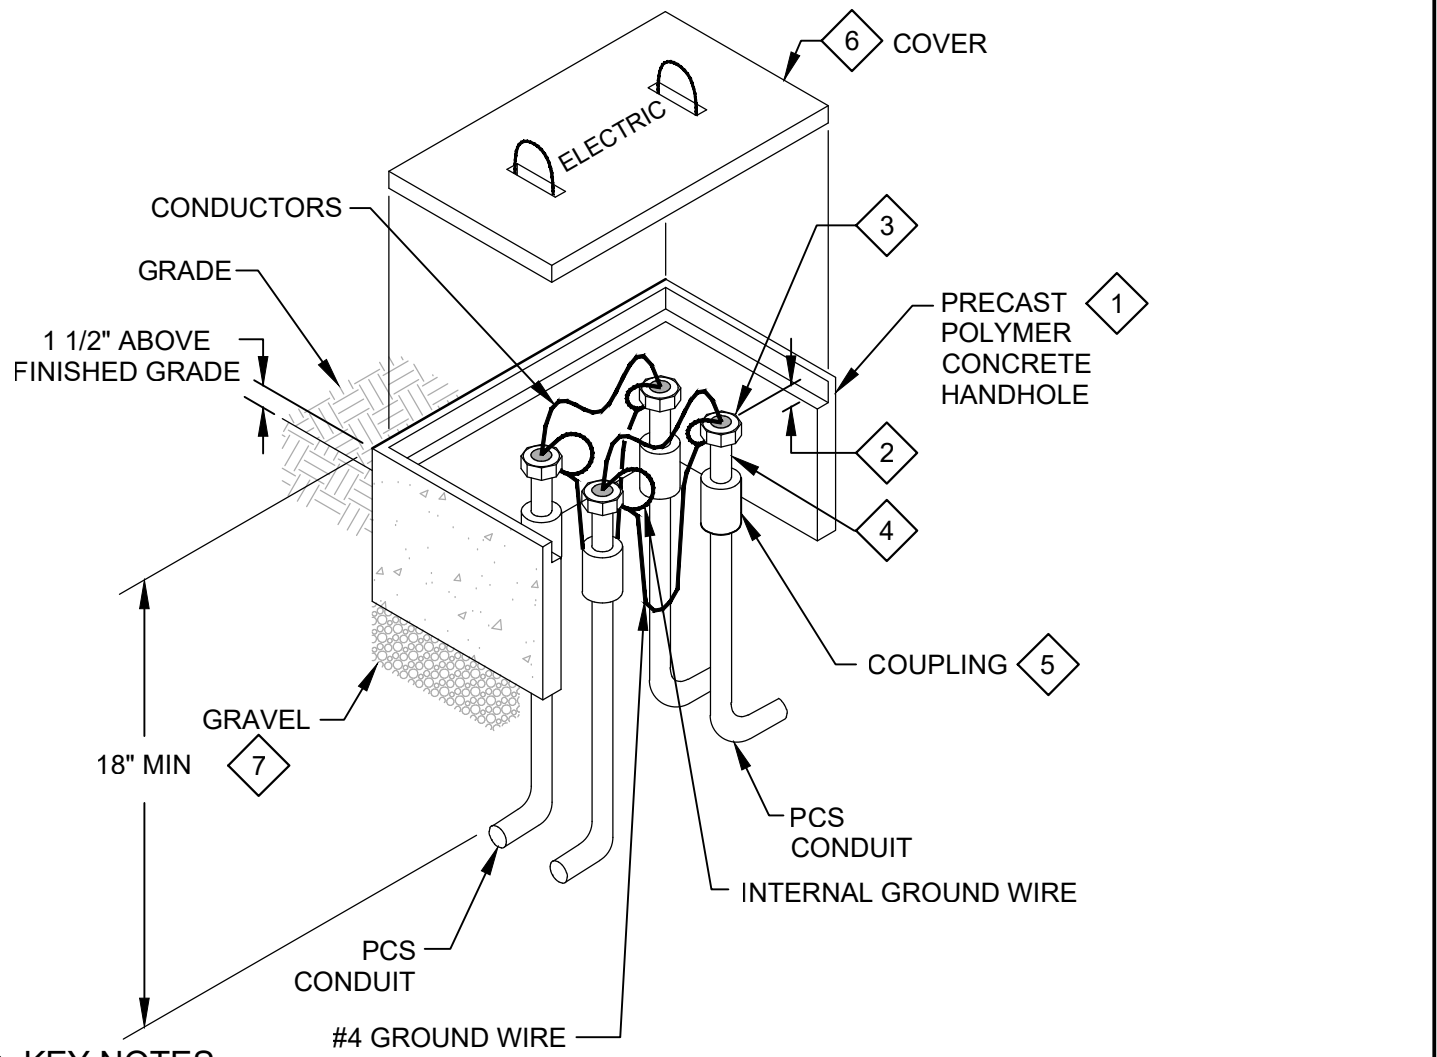

- KEY NOTES:**
- PRECAST POLYMER CONCRETE HANDHOLE WITH OPEN BOTTOM FOR DRAINAGE. DO NOT INSTALL POLYMER CONCRETE HANDHOLES IN ROADWAYS.
 - ALLOW SUFFICIENT SPACE BETWEEN THE CONDUIT AND HANDHOLE LID FOR BENDING RADIUS OF WIRES AND CABLES.
 - INSULATED GROUNDING BUSHINGS. BOND BUSHINGS TO EACH OTHER WITH #4 WIRE AND TO GROUND CONDUCTORS IN EACH CONDUIT.
 - NIPPLE (USED TO COMPACT DUCT SEAL IN COUPLING).
 - PACK COUPLING AREA WITH DUCT SEAL BY MANVILLE OR APPROVED EQUAL.
 - PROVIDE "TIER"-RATED COVER PER MANHOLE AND HANDHOLE SCHEDULE.
 - GRAVEL BED FOR LEVELING & DRAINAGE. MINIMUM 12" DEEP & EXTENDING AT LEAST 6" EACH WAY PAST OUTSIDE LIMITS OF HANDHOLE.


EM052 ELECTRICAL HANDHOLE: PRECAST POLYMER CONCRETE
TYP
S

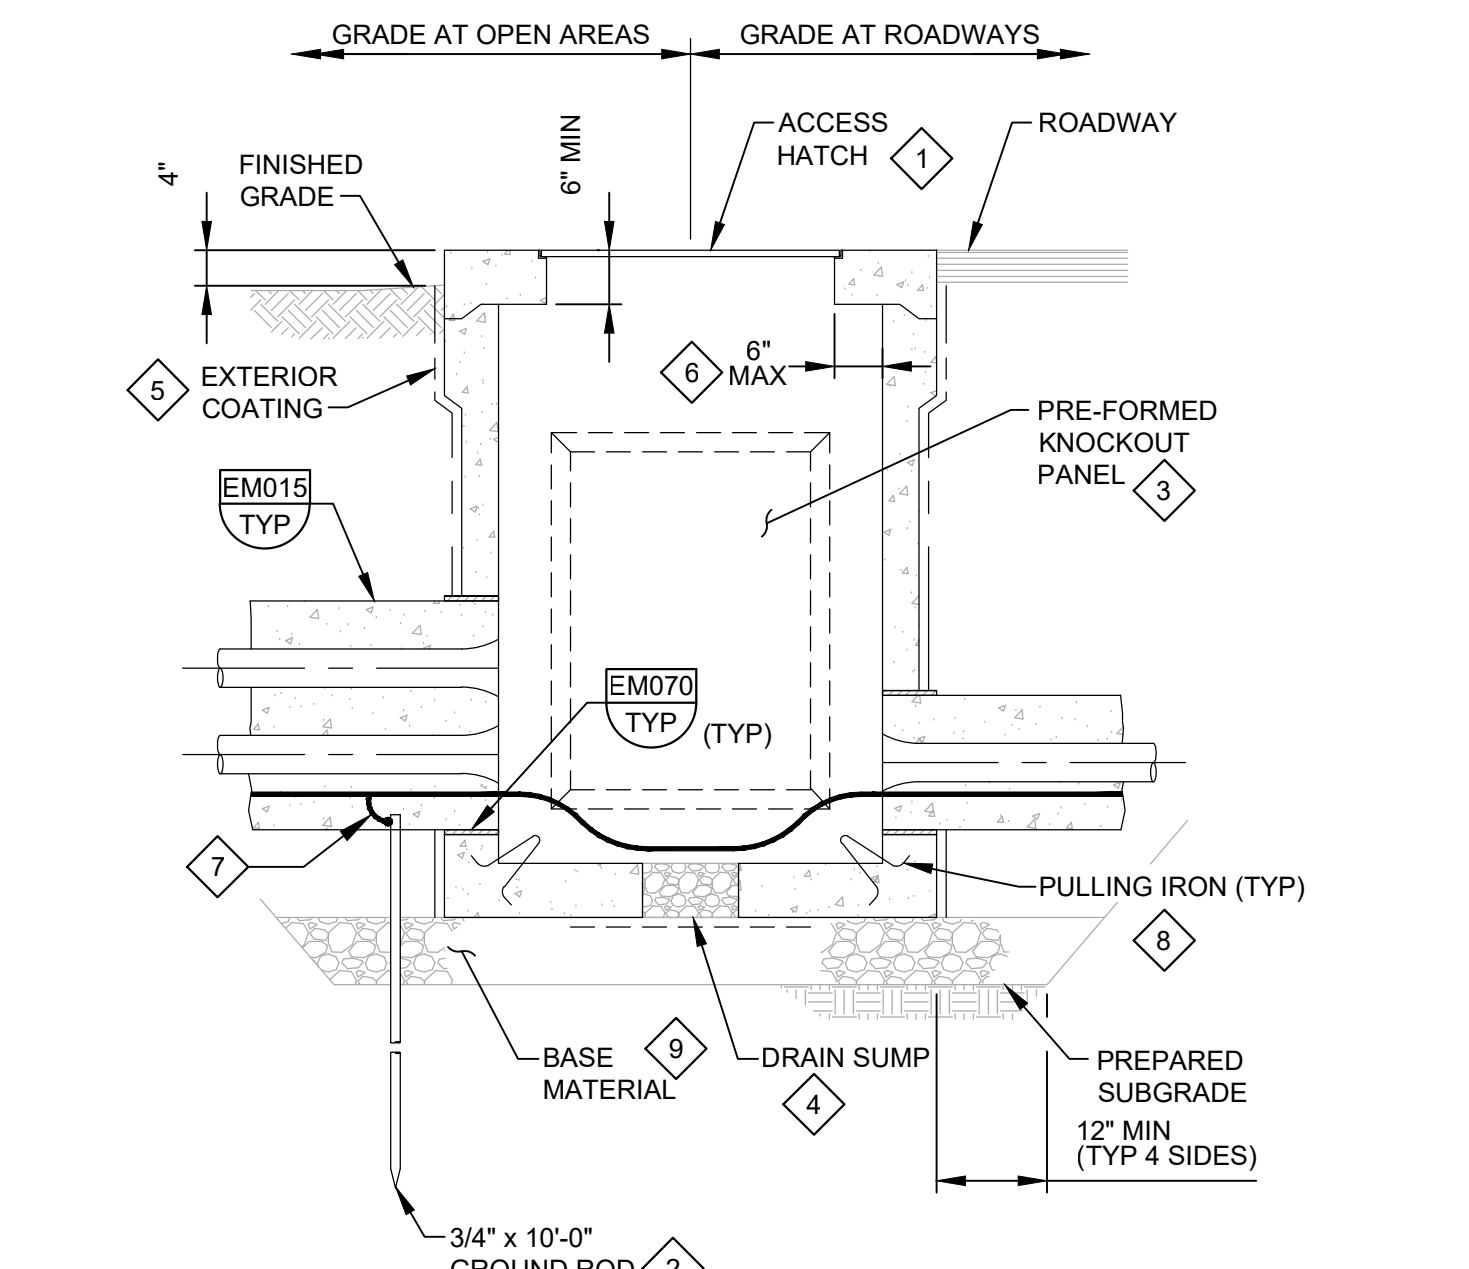

EM056 ELECTRICAL HANDHOLE PRECAST CONCRETE W/HATCH
TYP
01/23/25


- GENERAL NOTES:**
- PROVIDE MINIMUM INTERIOR DIMENSIONS AS SHOWN IN THE ELECTRICAL HANDHOLE AND MANHOLE SCHEDULE.
 - BOND ALL METALLIC ITEMS INSIDE HANDHOLE TO GROUND ROD USING #4 AWG BARE COPPER CABLE.
 - SEE DRAWINGS FOR ORIENTATION, NUMBER, AND SIZE OF DUCT BANKS AT EACH HANDHOLE.

- KEY NOTES:**
- SEE THE MANHOLE AND HANDHOLE SCHEDULE FOR REQUIRED LOAD RATING OF HATCH.
 - BOND DUCT BANK GROUND CABLE TO GROUND ROD. REFER TO THE SPECIFICATIONS FOR CONNECTION REQUIREMENTS.
 - INSTALL DUCT BANKS ONLY THROUGH CAST-IN OPENINGS, OR PREFORMED KNOCKOUT PANELS. PROVIDE KNOCKOUTS ON EACH WALL AROUND HANDHOLE.
 - PROVIDE MINIMUM 4 INCH DIAMETER, GRAVEL FILLED PENETRATION THROUGH FLOOR OF HANDHOLE. SET SUMP OPENING OVER MINIMUM 18" SQUARE FILTER FABRIC TO ISOLATE GRAVEL FROM BASE MATERIAL BELOW.
 - COAT EXTERIOR WALLS BELOW GRADE WITH BITUMINOUS DAMP PROOFING.
 - MAXIMUM TOP SLAB OVERHANG IS TYPICAL AROUND 4 SIDES OF HANDHOLE.
 - GROUNDING CABLE CONNECTION. REFER TO THE SPECIFICATIONS FOR CONNECTION REQUIREMENTS.
 - PROVIDE ONE PULLING IRON ON EACH WALL OF HANDHOLE.
 - BASE MATERIAL: PROVIDE MIN 12" COMPACTED AGGREGATE BASE COURSE.

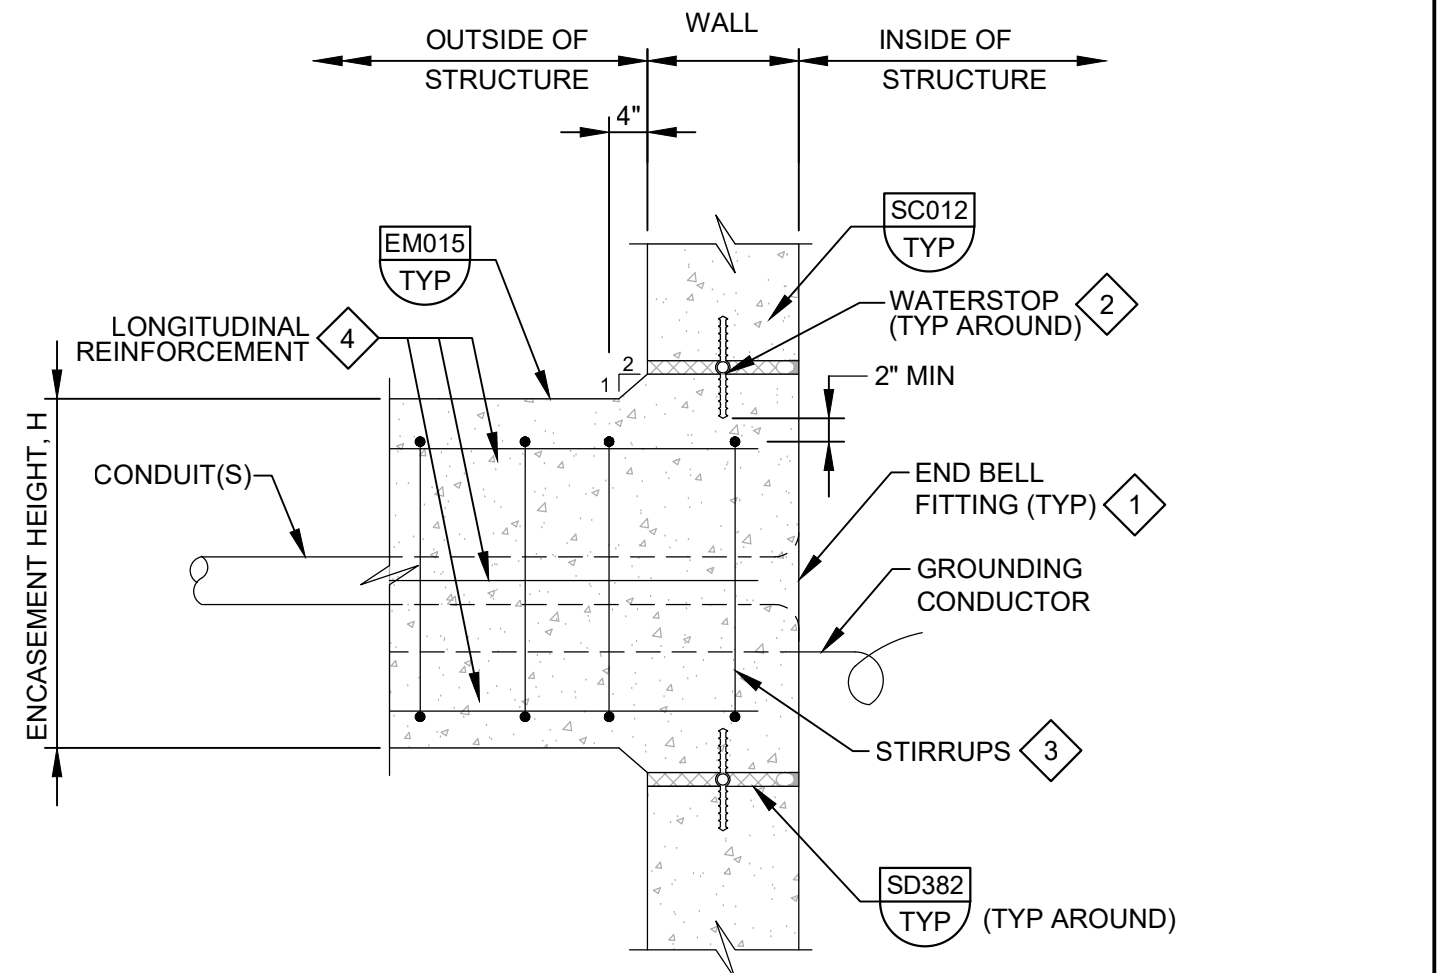

- KEY NOTES:**
- PROVIDE GROUNDING FITTING FOR METALLIC CONDUITS ENTERING MANHOLE. BOND GROUNDING FITTING TO DUCTBANK GROUNDING CONDUCTOR.
 - 6" PVC CENTERBULB WATERSTOP TYPICAL AROUND PERIMETER OF ENCASEMENT.
 - FOR FIRST 12'-0" FROM INSIDE FACE OF STRUCTURE, STIRRUP SPACING, IN INCHES = (H-4)/2, WHERE H = CONCRETE ENCASEMENT HEIGHT IN INCHES.
 - ADDITIONAL #4 x 12'-0" @ 12" ON ALL FOUR FACES OF ENCASEMENT. ALTERNATE WITH TYPICAL REINFORCEMENT FOR 6" SPACING.


EM071 ENCASED CONDUITS AT MANHOLES OR STRUCTURES - WITH WATERSTOP
TYP
01/23/25

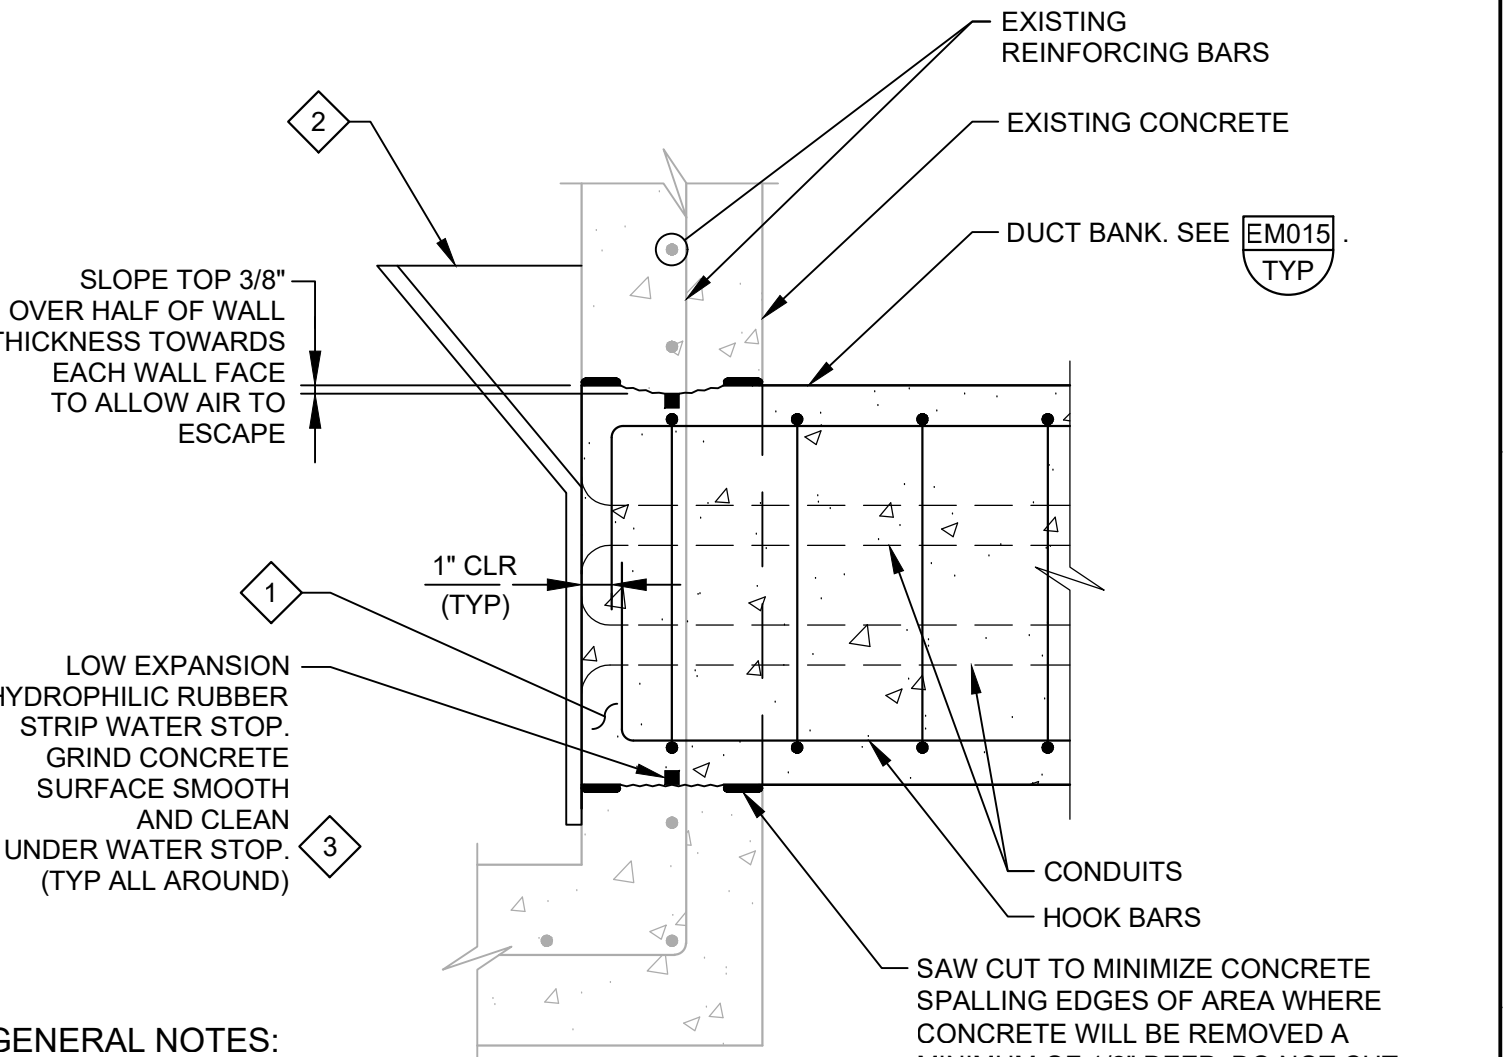


- GENERAL NOTES:**
- ADJUST LOCATION OF CONDUITS IN DUCT BANK TO MISS EXISTING REINFORCING BARS IN WALL.
 - ROUGHEN CONCRETE TO 1/4" AMPLITUDE AND COAT WITH EPOXY RESIN/PORTLAND CEMENTS BONDING AGENT.
- KEY NOTES:**
- REMOVE CONCRETE AS SHOWN FOR NEW DUCT BANK PENETRATION THROUGH WALL. DO NOT CUT EXISTING REINFORCING BARS.
 - USE THE "BIRDS BEAK" FORM FOR ACCESS FOR VIBRATOR AND TO ALLOW CONCRETE TO BE PLACED UNDER SLIGHT PRESSURE. AFTER FORMS ARE REMOVED, REMOVE PROJECTING CONCRETE AND FINISH TO MATCH FINISH OF EXISTING CONCRETE.
 - SIKA SWELLSTOP OR EQUAL. FOLLOW MANUFACTURER'S INSTALLATIONS DETAILS. MINIMUM 2" CONCRETE COVER ON EITHER SIDE.

EM072 DUCT BANK CONNECTION TO EXISTING HANDHOLE, PULL BOX, OR WALL
TYP
01/23/25

BID SET				DESIGNED
				CE
				DRAWN
				CE
				CHECKED
				GCE
				DATE
				FEBRUARY 2025
REV	DATE	SKB	BY	DESCRIPTION
1	05/08/2025	SKB		ADDENDUM NO. 4
2	04/30/2025	SKB		ADDENDUM NO. 2

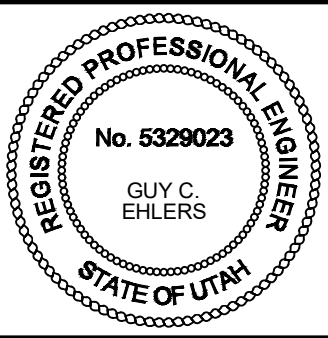

JORDAN VALLEY WATER TREATMENT PLANT				VERIFY SCALES	JOB NO.
FILTER AND CHEMICAL FEED UPGRADES				BAR IS ONE INCH ON ORIGINAL DRAWING	202001.10
ELECTRICAL				0 1"	DRAWING NO.
TYPICAL DETAILS 4				IF NOT ONE INCH ON THIS SHEET, ADJUST SCALES ACCORDINGLY	00GE06
					SHEET NO.
					OF

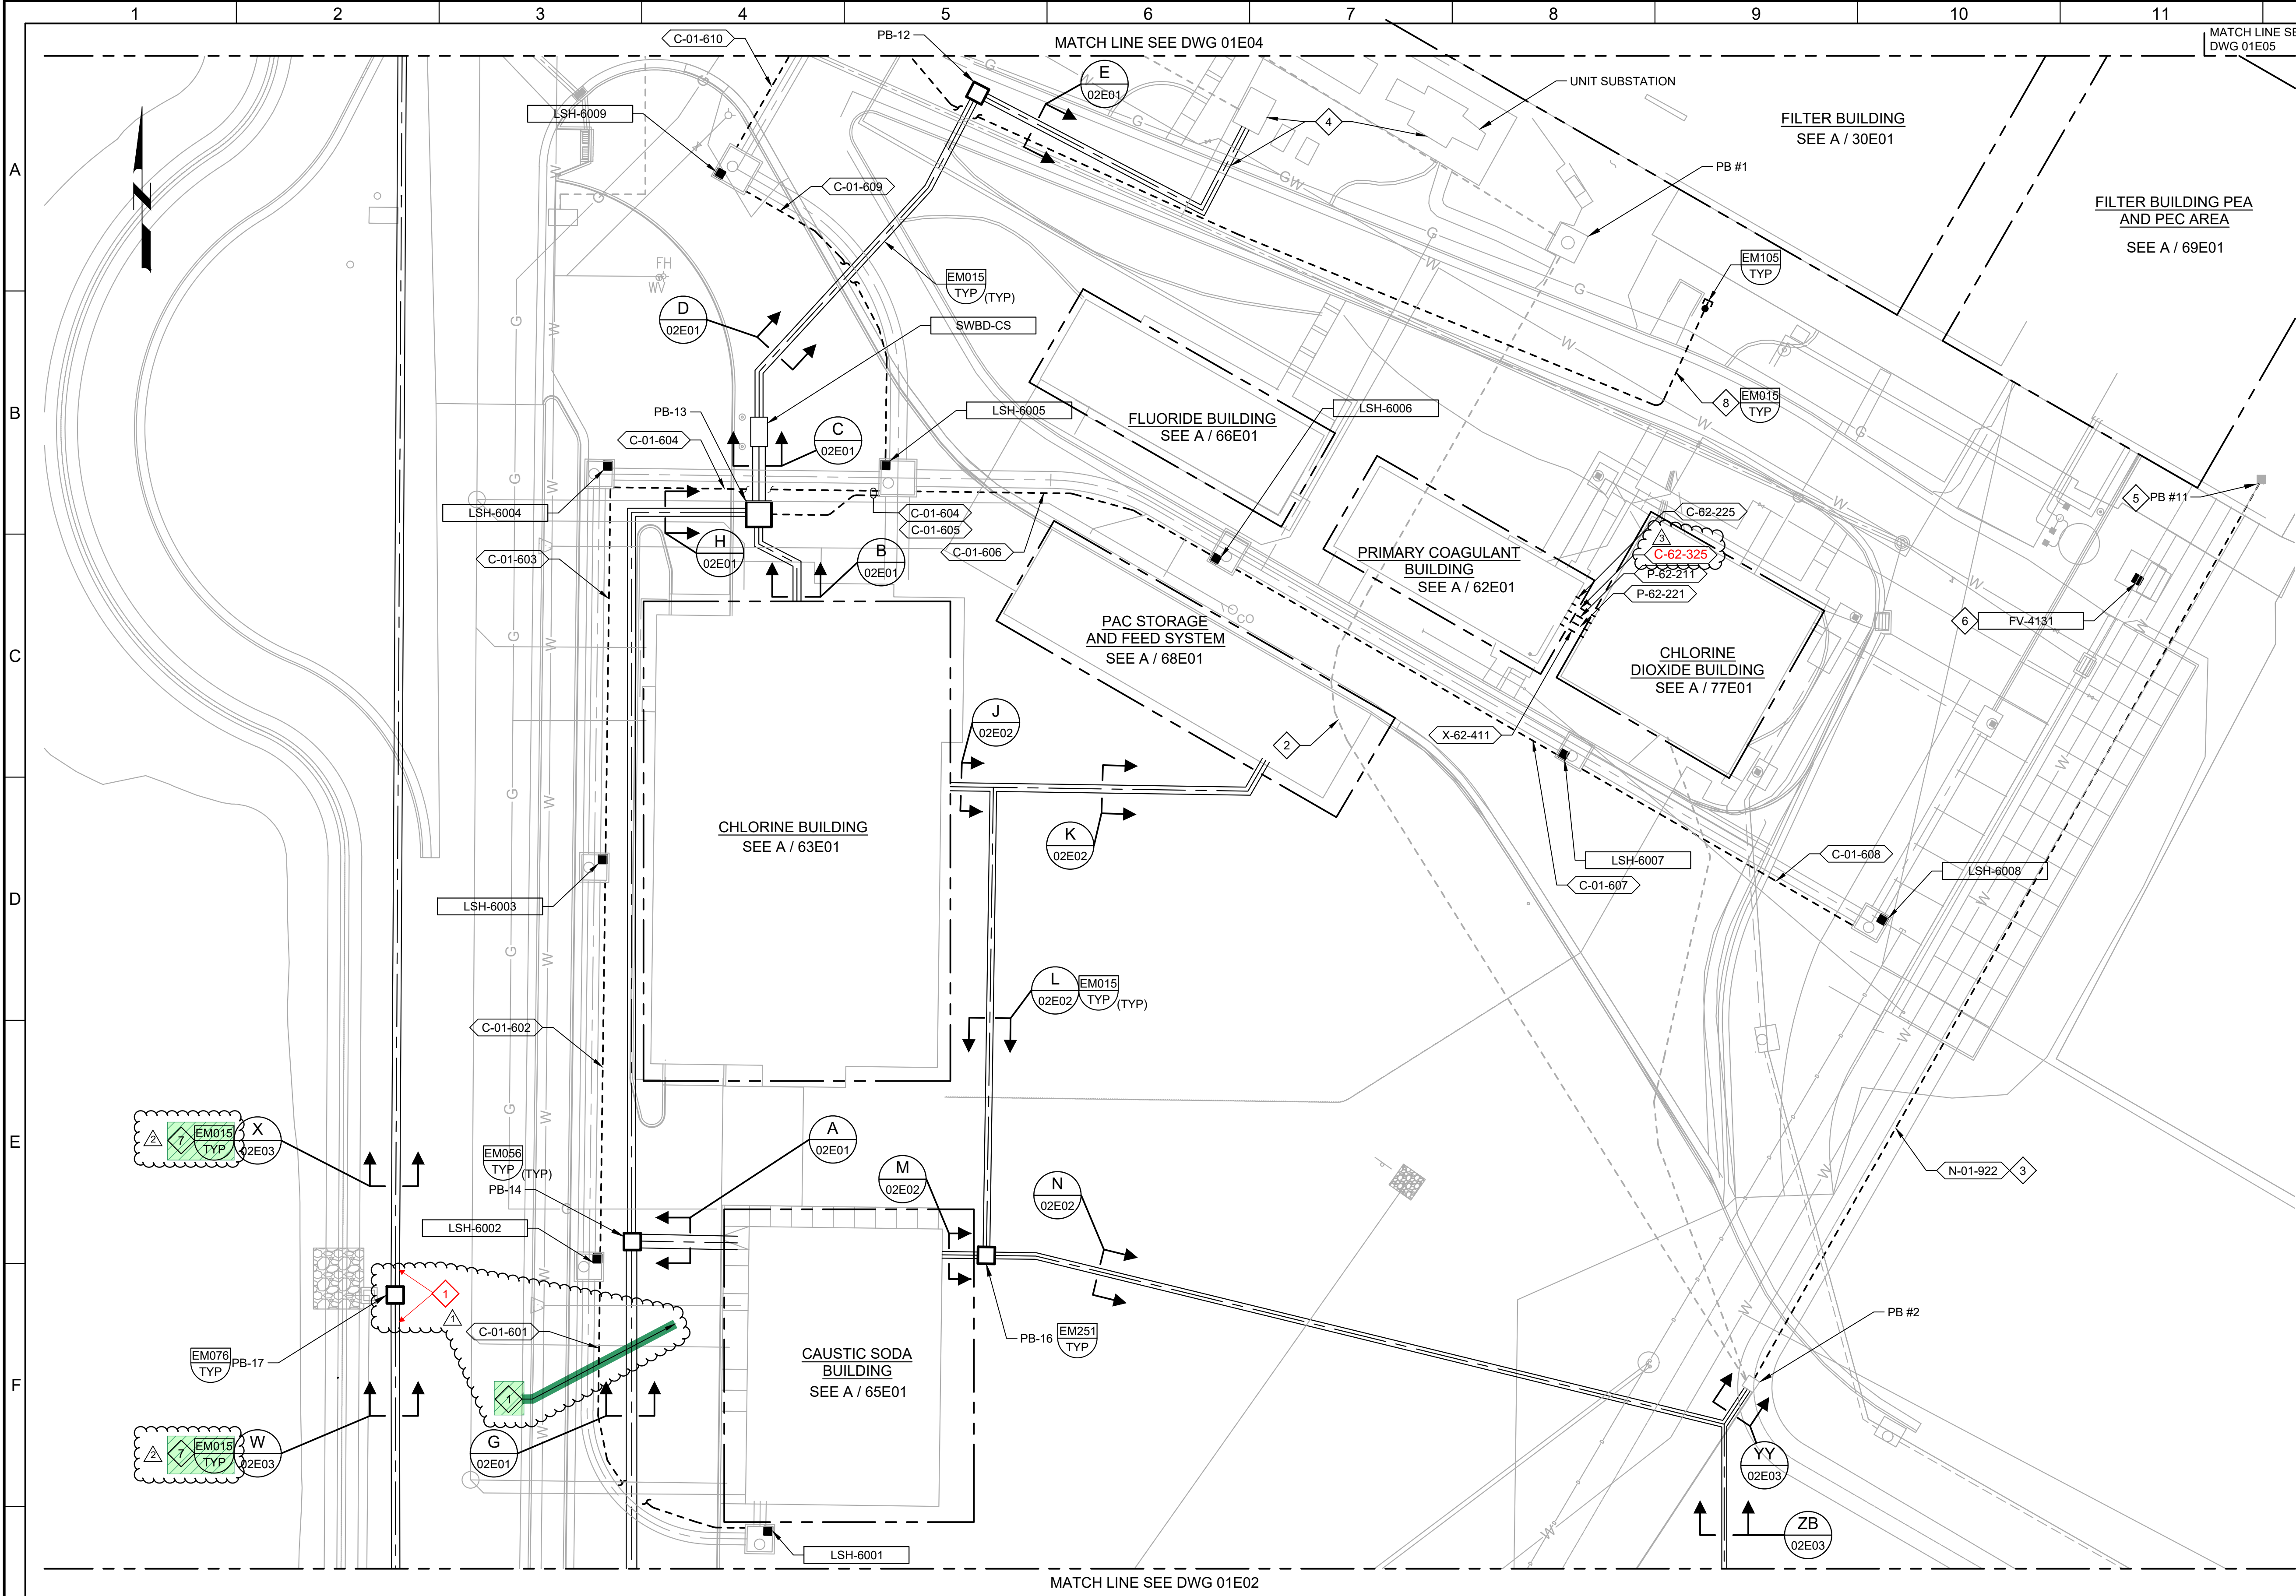


- GENERAL NOTES:**
- SEE OVERALL SITE PLAN ON DRAWING 01E01.
 - SEE DRAWING 00DE02 FOR DEMOLITION IN THIS AREA.
 - PROVIDE 120VAC, 1 POLE INSTRUMENT DISCONNECT PER DETAIL NA900/TYP FOR ALL 4-WIRE INSTRUMENTS.
- KEY NOTES:**
- XFMR CELL**

 - REROUTE EXISTING 12.47KV SINGLE PHASE CIRCUIT BETWEEN **HANDHOLE** AND SECTIONALIZER 4 FOR THE CELL TOWER. REFER TO ONE-LINE DIAGRAM ON DRAWING 03E02 FOR CABLE SIZE. **SPLICE IN HANDHOLE AND** PROVIDE NEW CABLES TO MATCH EXISTING CABLES.
 - PROTECT EXISTING DUCT BANK IN PLACE BELOW THE NEW PAC AREA.
 - USE EXISTING SPARE CONDUIT TO ROUTE FIBER OPTIC WIRING THROUGH EXISTING DUCT BANK FROM PB #2 TO PB #11.
 - USE EXISTING VAULT BELOW THE TRANSFORMER TO ROUTE NEW 480V CIRCUIT FROM UNIT SUBSTATION TO NEW SWBD-CS THROUGH TWO EXISTING CONDUITS AND NEW DUCT BANK.
 - SEE DRAWING 30E10 FOR CONTINUATION.
 - RECONNECT NEW VALVE ACTUATOR TO EXISTING POWER AND I/O CONDUCTORS.
 - NOT USED.**
 - INSTALL 5-INCH PVC CONDUIT. USE EXISTING SPARE CONDUIT IN EXISTING DUCT BANK.


Know what's below.
Call 811 before you dig.

BLUE STAKES OF UTAH
UTILITY NOTIFICATION CENTER, INC.
www.bluestakes.org
1-800-662-4111

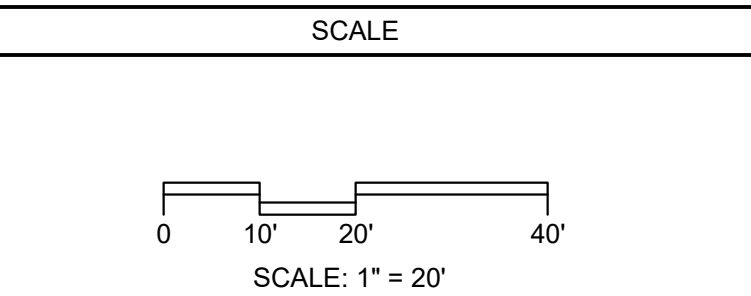


G				BID SET		DESIGNED SKB							JORDAN VALLEY WATER TREATMENT PLANT		VERIFY SCALES BAR IS ONE INCH ON ORIGINAL DRAWING 0 1" IF NOT ONE INCH ON THIS SHEET, ADJUST SCALES ACCORDINGLY	JOB NO. 202001.10
					DRAWN NKK				FILTER AND CHEMICAL FEED UPGRADES				DRAWING NO.			
		5/08/2025	SKB	ADDENDUM NO. 4	CHECKED GCE				ELECTRICAL				01E03			
		04/30/2025	SKB	ADDENDUM NO. 2	DATE FEBRUARY 2025				ENLARGED SITE PLAN 3				SHEET NO.			
		04/15/2025	SKB	ADDENDUM NO. 1									OF			
REV	DATE	BY	DESCRIPTION													

LAST SAVED BY: NKKlian

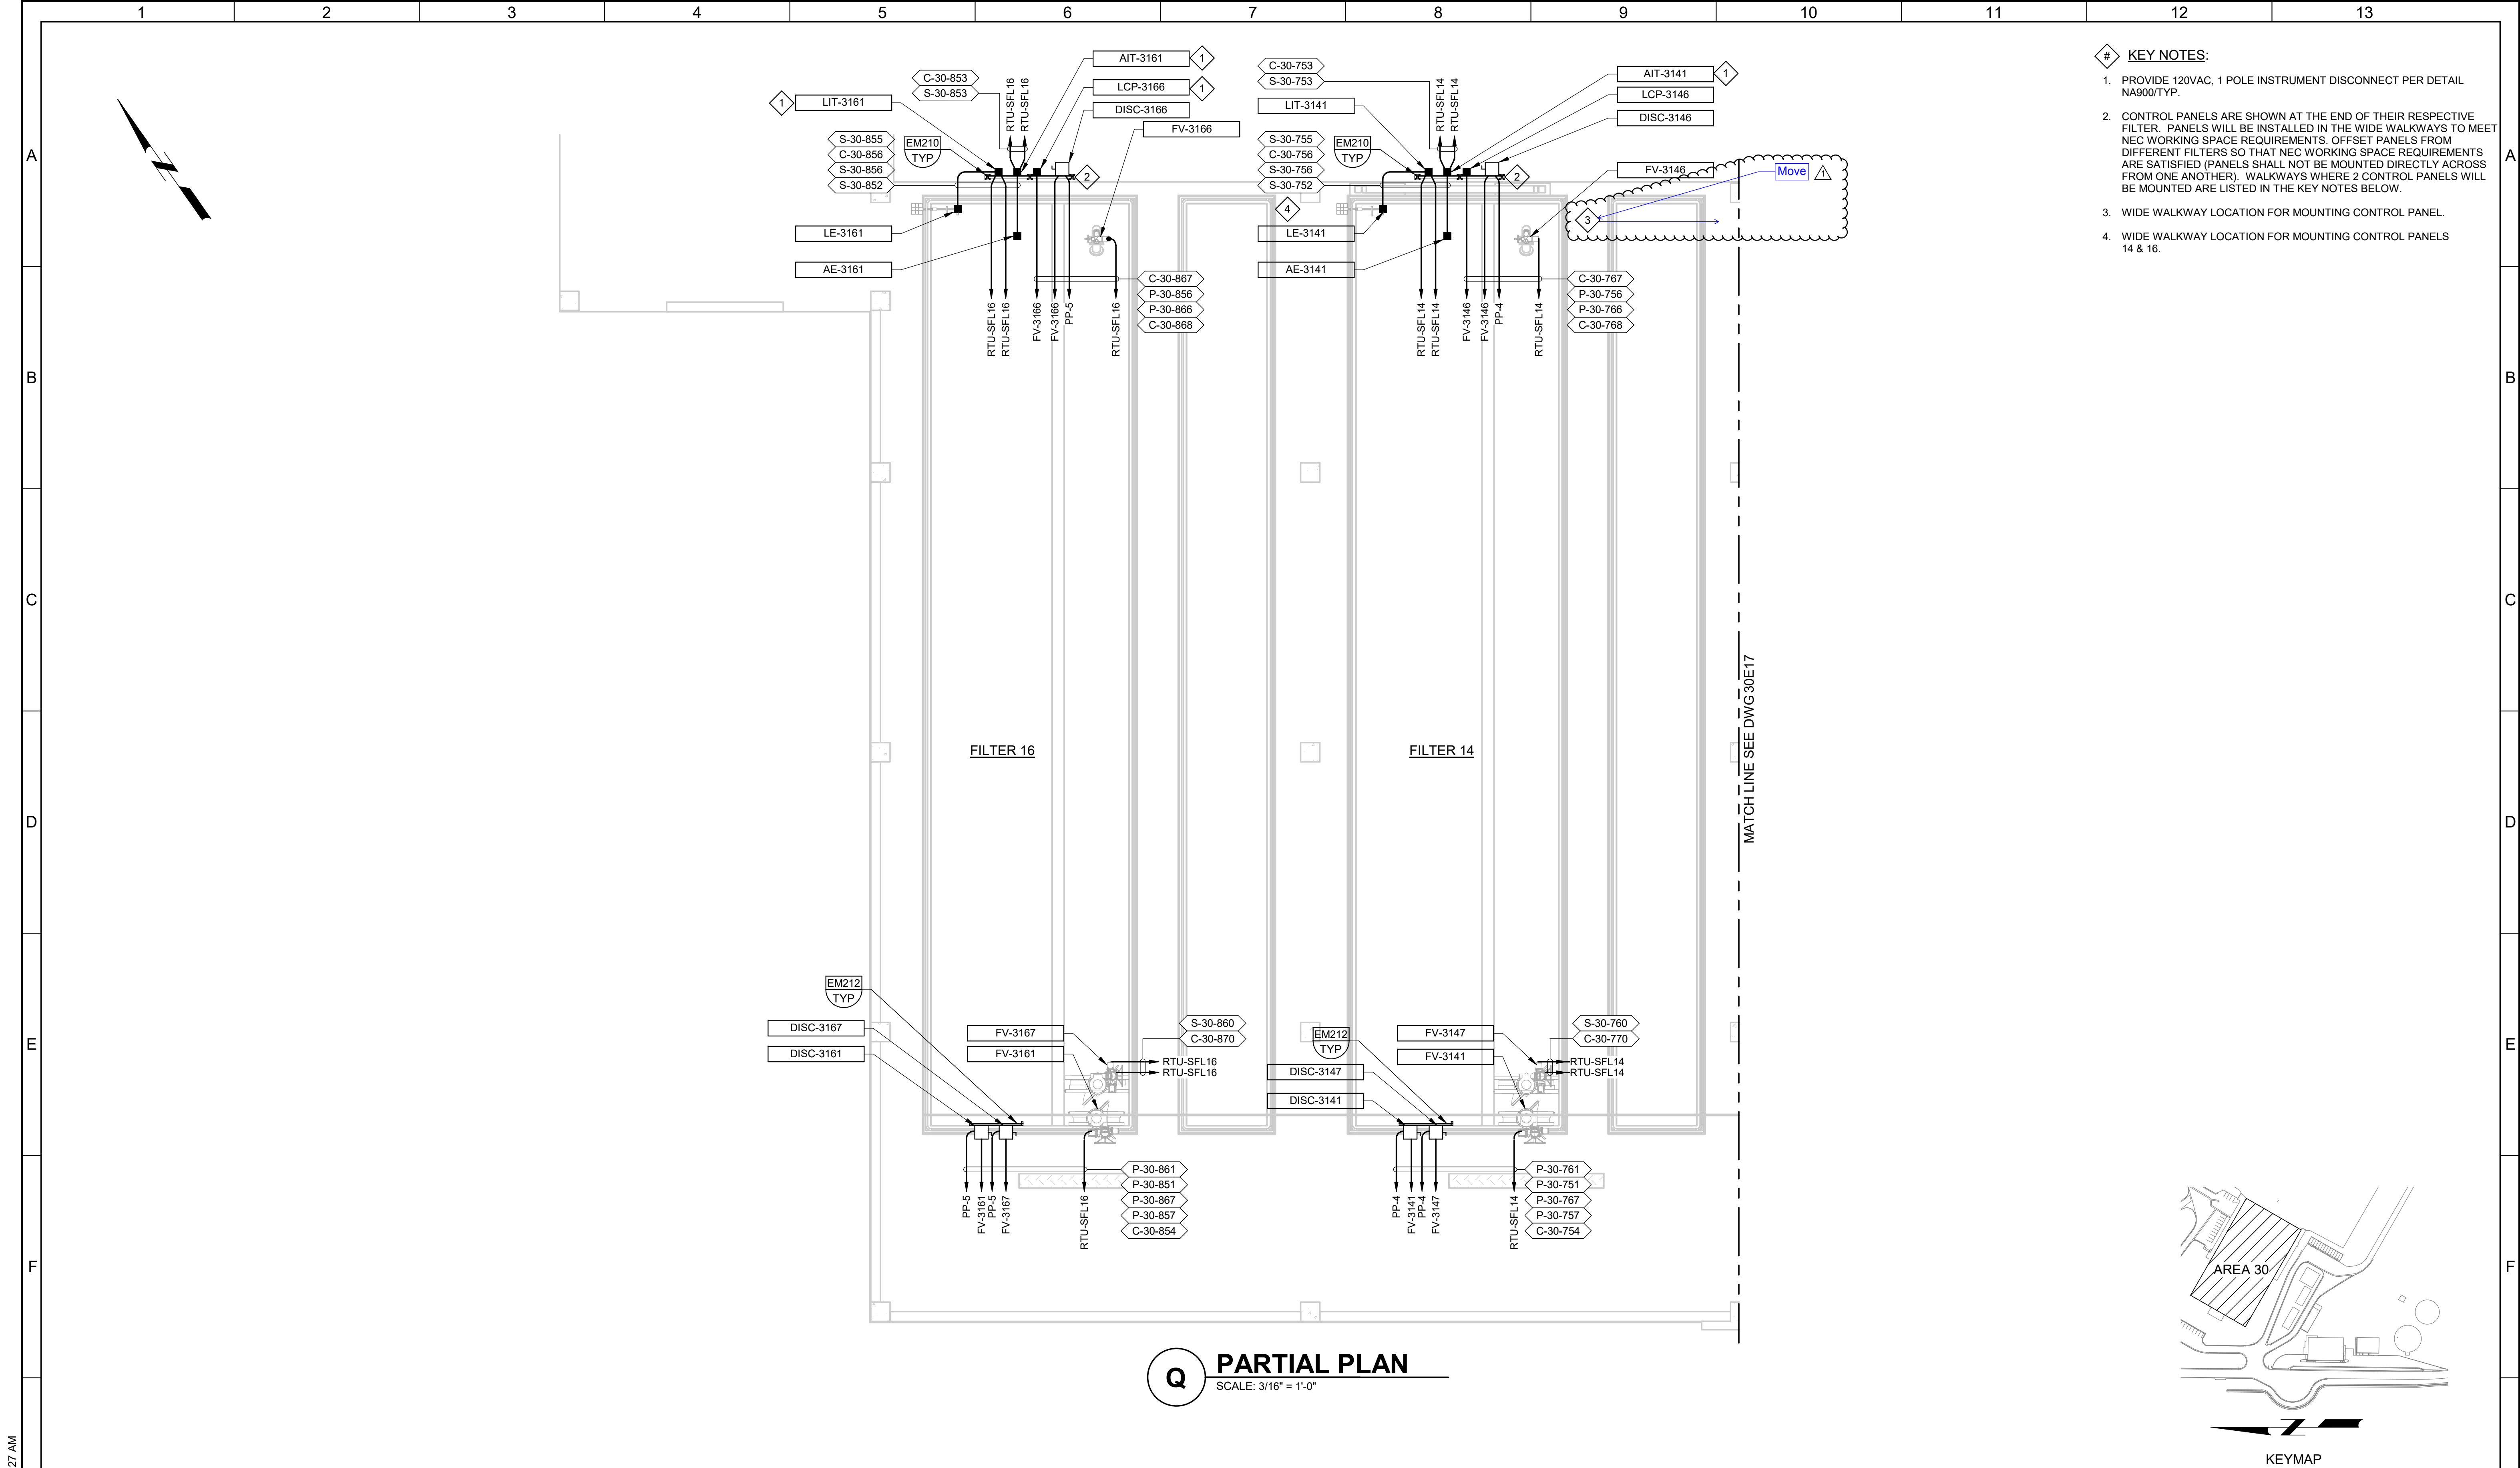

- # KEY NOTES:
1. PROVIDE 120VAC, 1 POLE INSTRUMENT DISCONNECT PER DETAIL NA900/TYP.
 2. CONTROL PANELS ARE SHOWN AT THE END OF THEIR RESPECTIVE FILTER. PANELS WILL BE INSTALLED IN THE WIDE WALKWAYS TO MEET NEC WORKING SPACE REQUIREMENTS. OFFSET PANELS FROM DIFFERENT FILTERS SO THAT NEC WORKING SPACE REQUIREMENTS ARE SATISFIED (PANELS SHALL NOT BE MOUNTED DIRECTLY ACROSS FROM ONE ANOTHER). WALKWAYS WHERE 2 CONTROL PANELS WILL BE MOUNTED ARE LISTED IN THE KEY NOTES BELOW.
 3. WIDE WALKWAY LOCATION FOR MOUNTING CONTROL PANEL.
 4. WIDE WALKWAY LOCATION FOR MOUNTING CONTROL PANELS 14 & 16.


Q PARTIAL PLAN
SCALE: 3/16" = 1'-0"

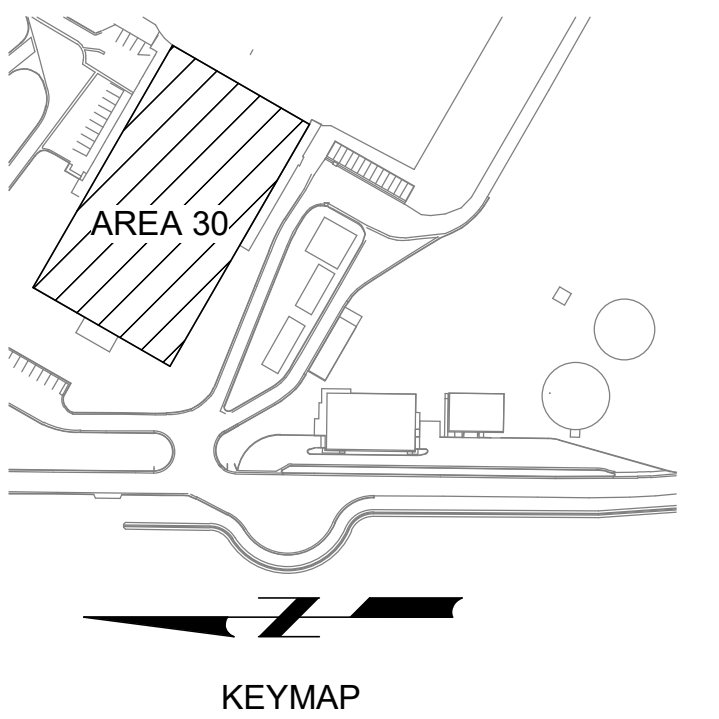

PLOT DATE: 2/11/2025 10:36:27 AM

BID SET			
REV	DATE	SKB	DESCRIPTION
1	05/08/2025	SKB	ADDENDUM NO. 4


DESIGNED CLM
DRAWN PLU
CHECKED GCE
DATE FEBRUARY 2025

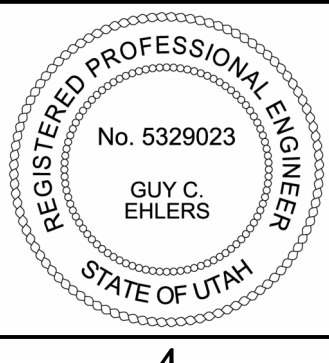






JORDAN VALLEY WATER TREATMENT PLANT
FILTER AND CHEMICAL FEED UPGRADES
ELECTRICAL
FILTER BUILDING AREA Q UPPER LEVEL POWER AND CONTROL PLAN

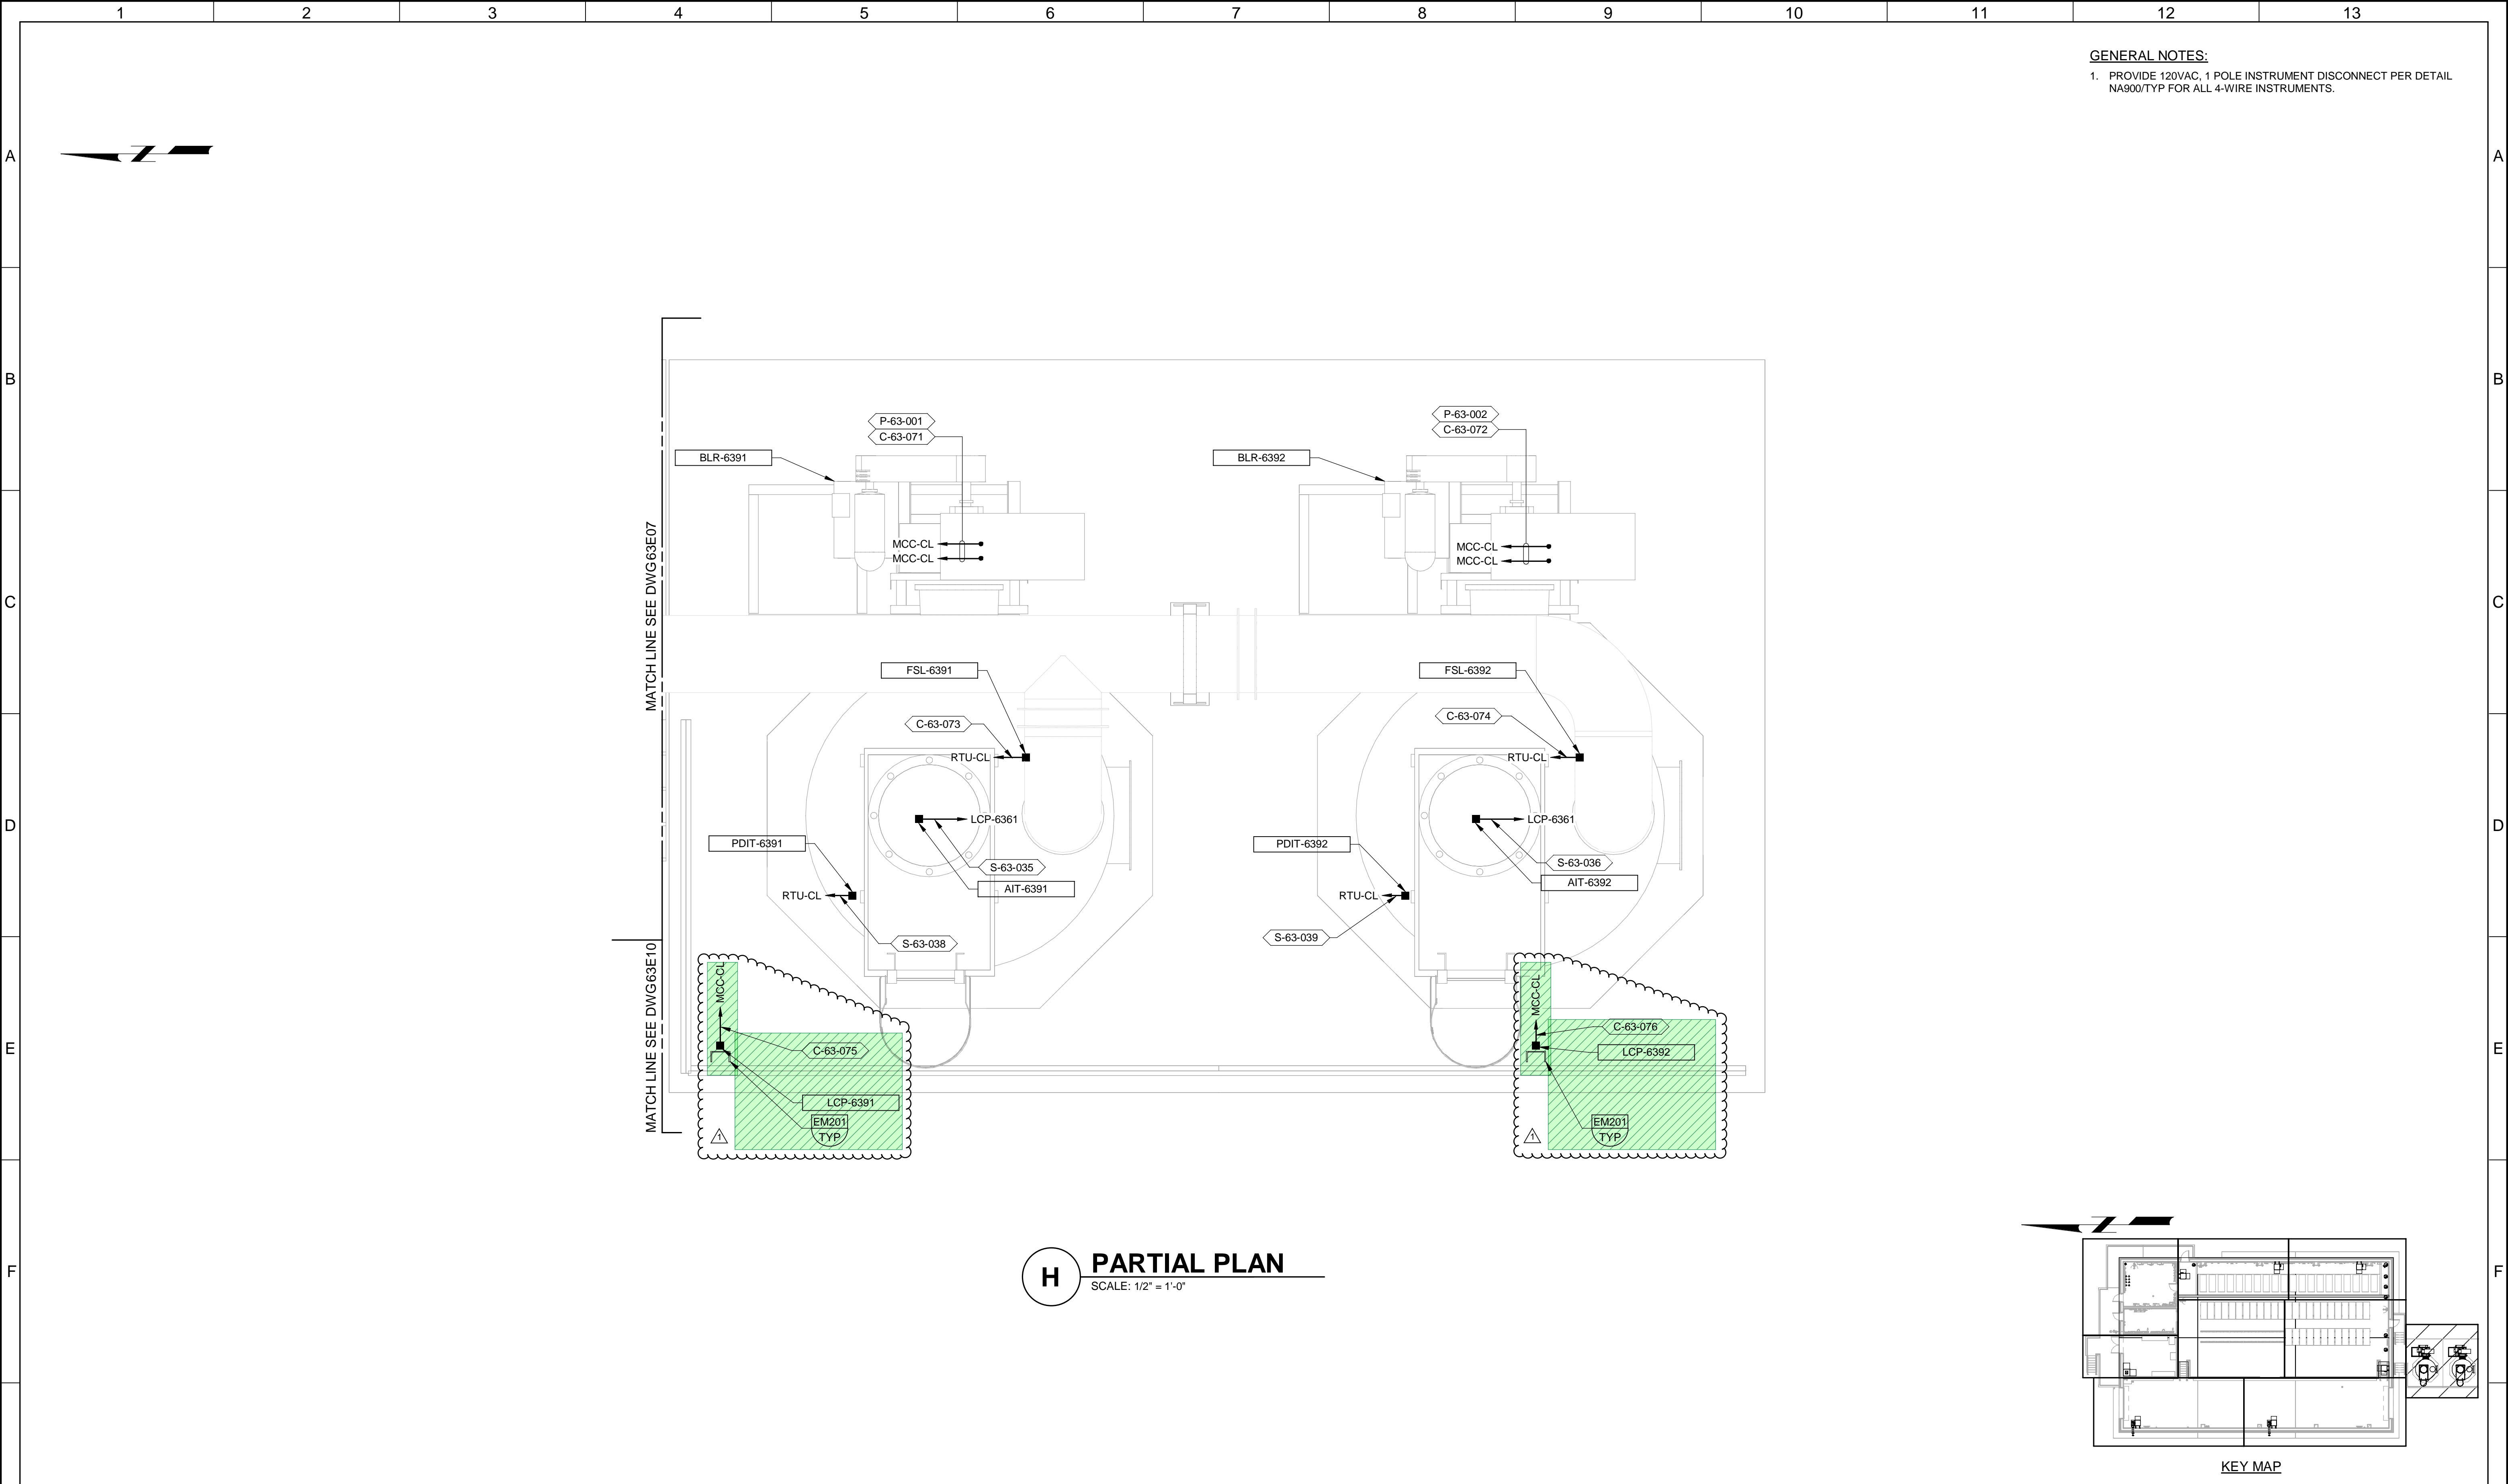
VERIFY SCALES BAR IS ONE INCH ON ORIGINAL DRAWING 0 1"
IF NOT ONE INCH ON THIS SHEET, ADJUST SCALES ACCORDINGLY

JOB NO. 202001.10
DRAWING NO. 30E16
SHEET NO. OF



G				BID SET		DESIGNED MJG						JORDAN VALLEY WATER TREATMENT PLANT			VERIFY SCALES	JOB NO. 202001.10
					DRAWN MNH				FILTER AND CHEMICAL FEED UPGRADES			BAR IS ONE INCH ON ORIGINAL DRAWING	DRAWING NO.			
					CHECKED GCE				ELECTRICAL			0  1"	63E08			
					DATE FEBRUARY 2025				CHLORINE BUILDING SCRUBBERS AREA POWER AND CONTROL PLAN			IF NOT ONE INCH ON THIS SHEET, ADJUST SCALES ACCORDINGLY	SHEET NO.			
		05/19/2025	SKB	ADDENDUM NO. 4									OF			
REV	DATE	BY	DESCRIPTION													
	1		2	3	4	5	6	7	8	9	10	11	12	13		

PLOT DATE: 2/11/2025 7:25:15 AM

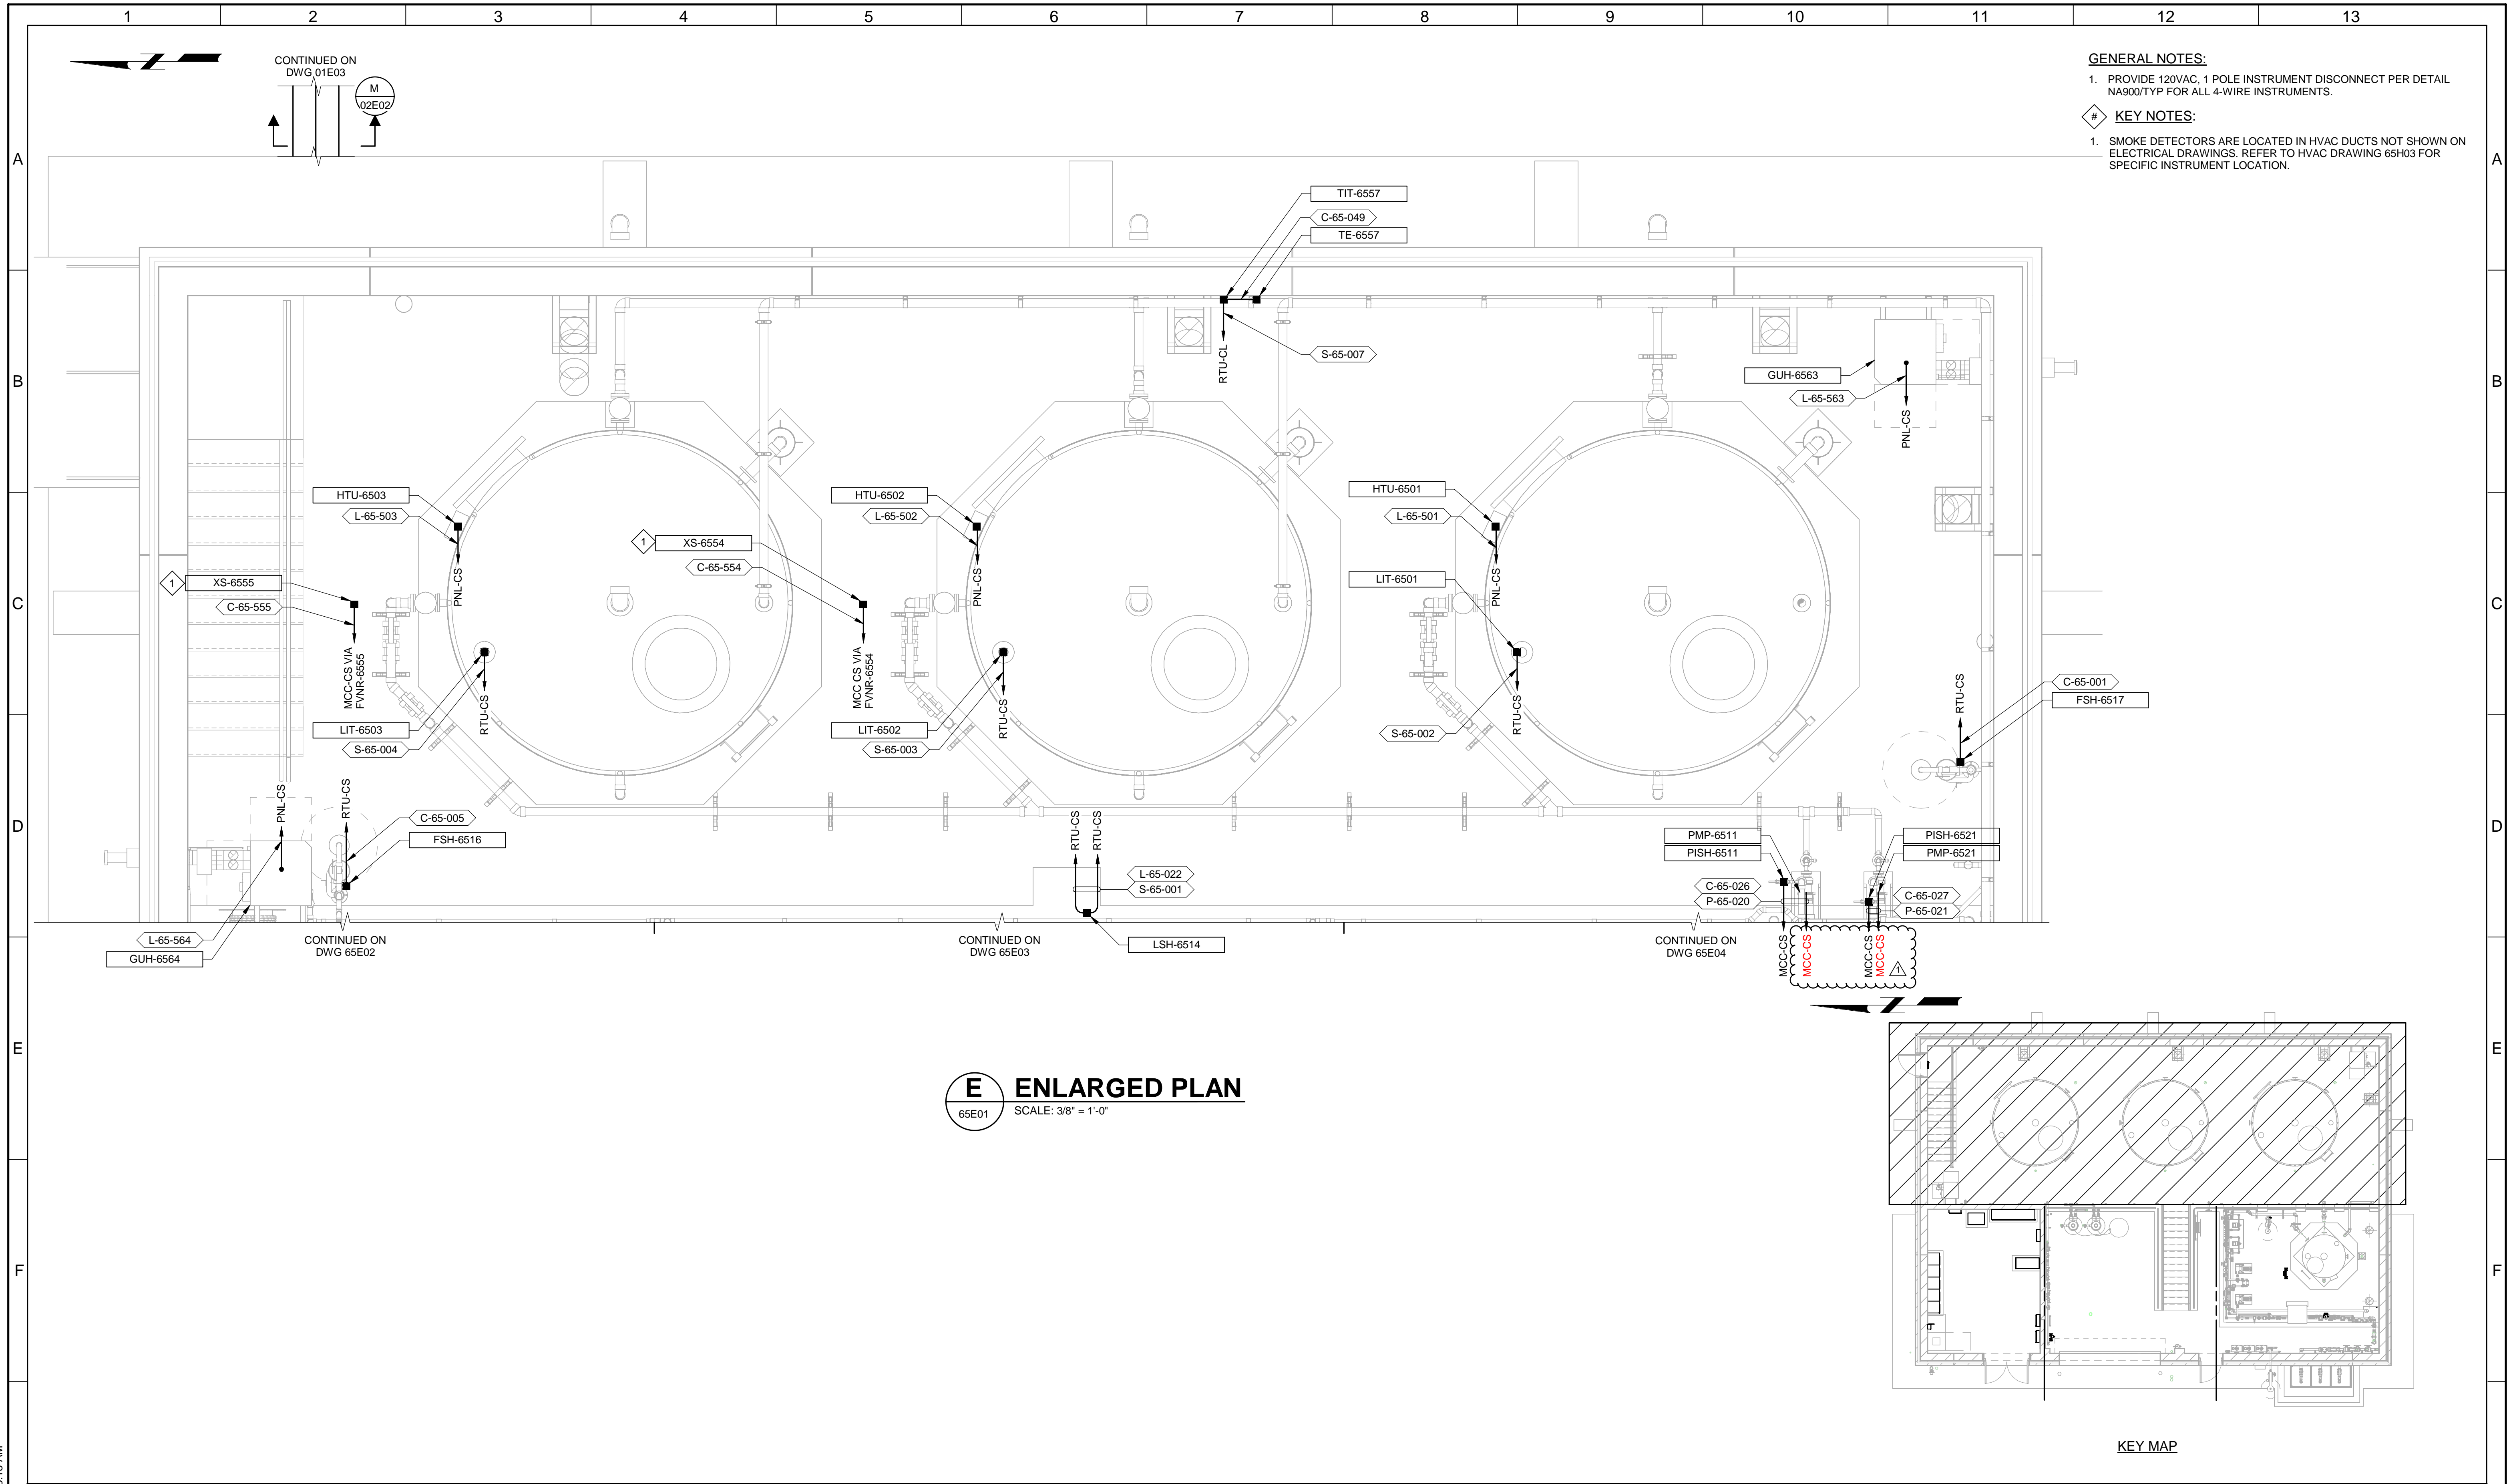


- GENERAL NOTES:**
- PROVIDE 120VAC, 1 POLE INSTRUMENT DISCONNECT PER DETAIL NA900/TYP FOR ALL 4-WIRE INSTRUMENTS.
- KEY NOTES:**
- SMOKE DETECTORS ARE LOCATED IN HVAC DUCTS NOT SHOWN ON ELECTRICAL DRAWINGS. REFER TO HVAC DRAWING 65H03 FOR SPECIFIC INSTRUMENT LOCATION.


E ENLARGED PLAN
65E01 SCALE: 3/8" = 1'-0"

KEY MAP

BID SET				DESIGNED SKB												JORDAN VALLEY WATER TREATMENT PLANT										VERIFY SCALES	JOB NO. 202001.10							
				DRAWN NCS												FILTER AND CHEMICAL FEED UPGRADES										BAR IS ONE INCH ON ORIGINAL DRAWING	DRAWING NO.							
				CHECKED GCE												ELECTRICAL CAUSTIC SODA BUILDING BULK AREA										0 1"	65E05							
				DATE FEBRUARY 2025												LOWER LEVEL POWER AND CONTROL PLAN										IF NOT ONE INCH ON THIS SHEET, ADJUST SCALES ACCORDINGLY	SHEET NO. OF							
	05/19/2025	SKB	ADDENDUM NO. 4	DESCRIPTION																														
REV	DATE	BY																																

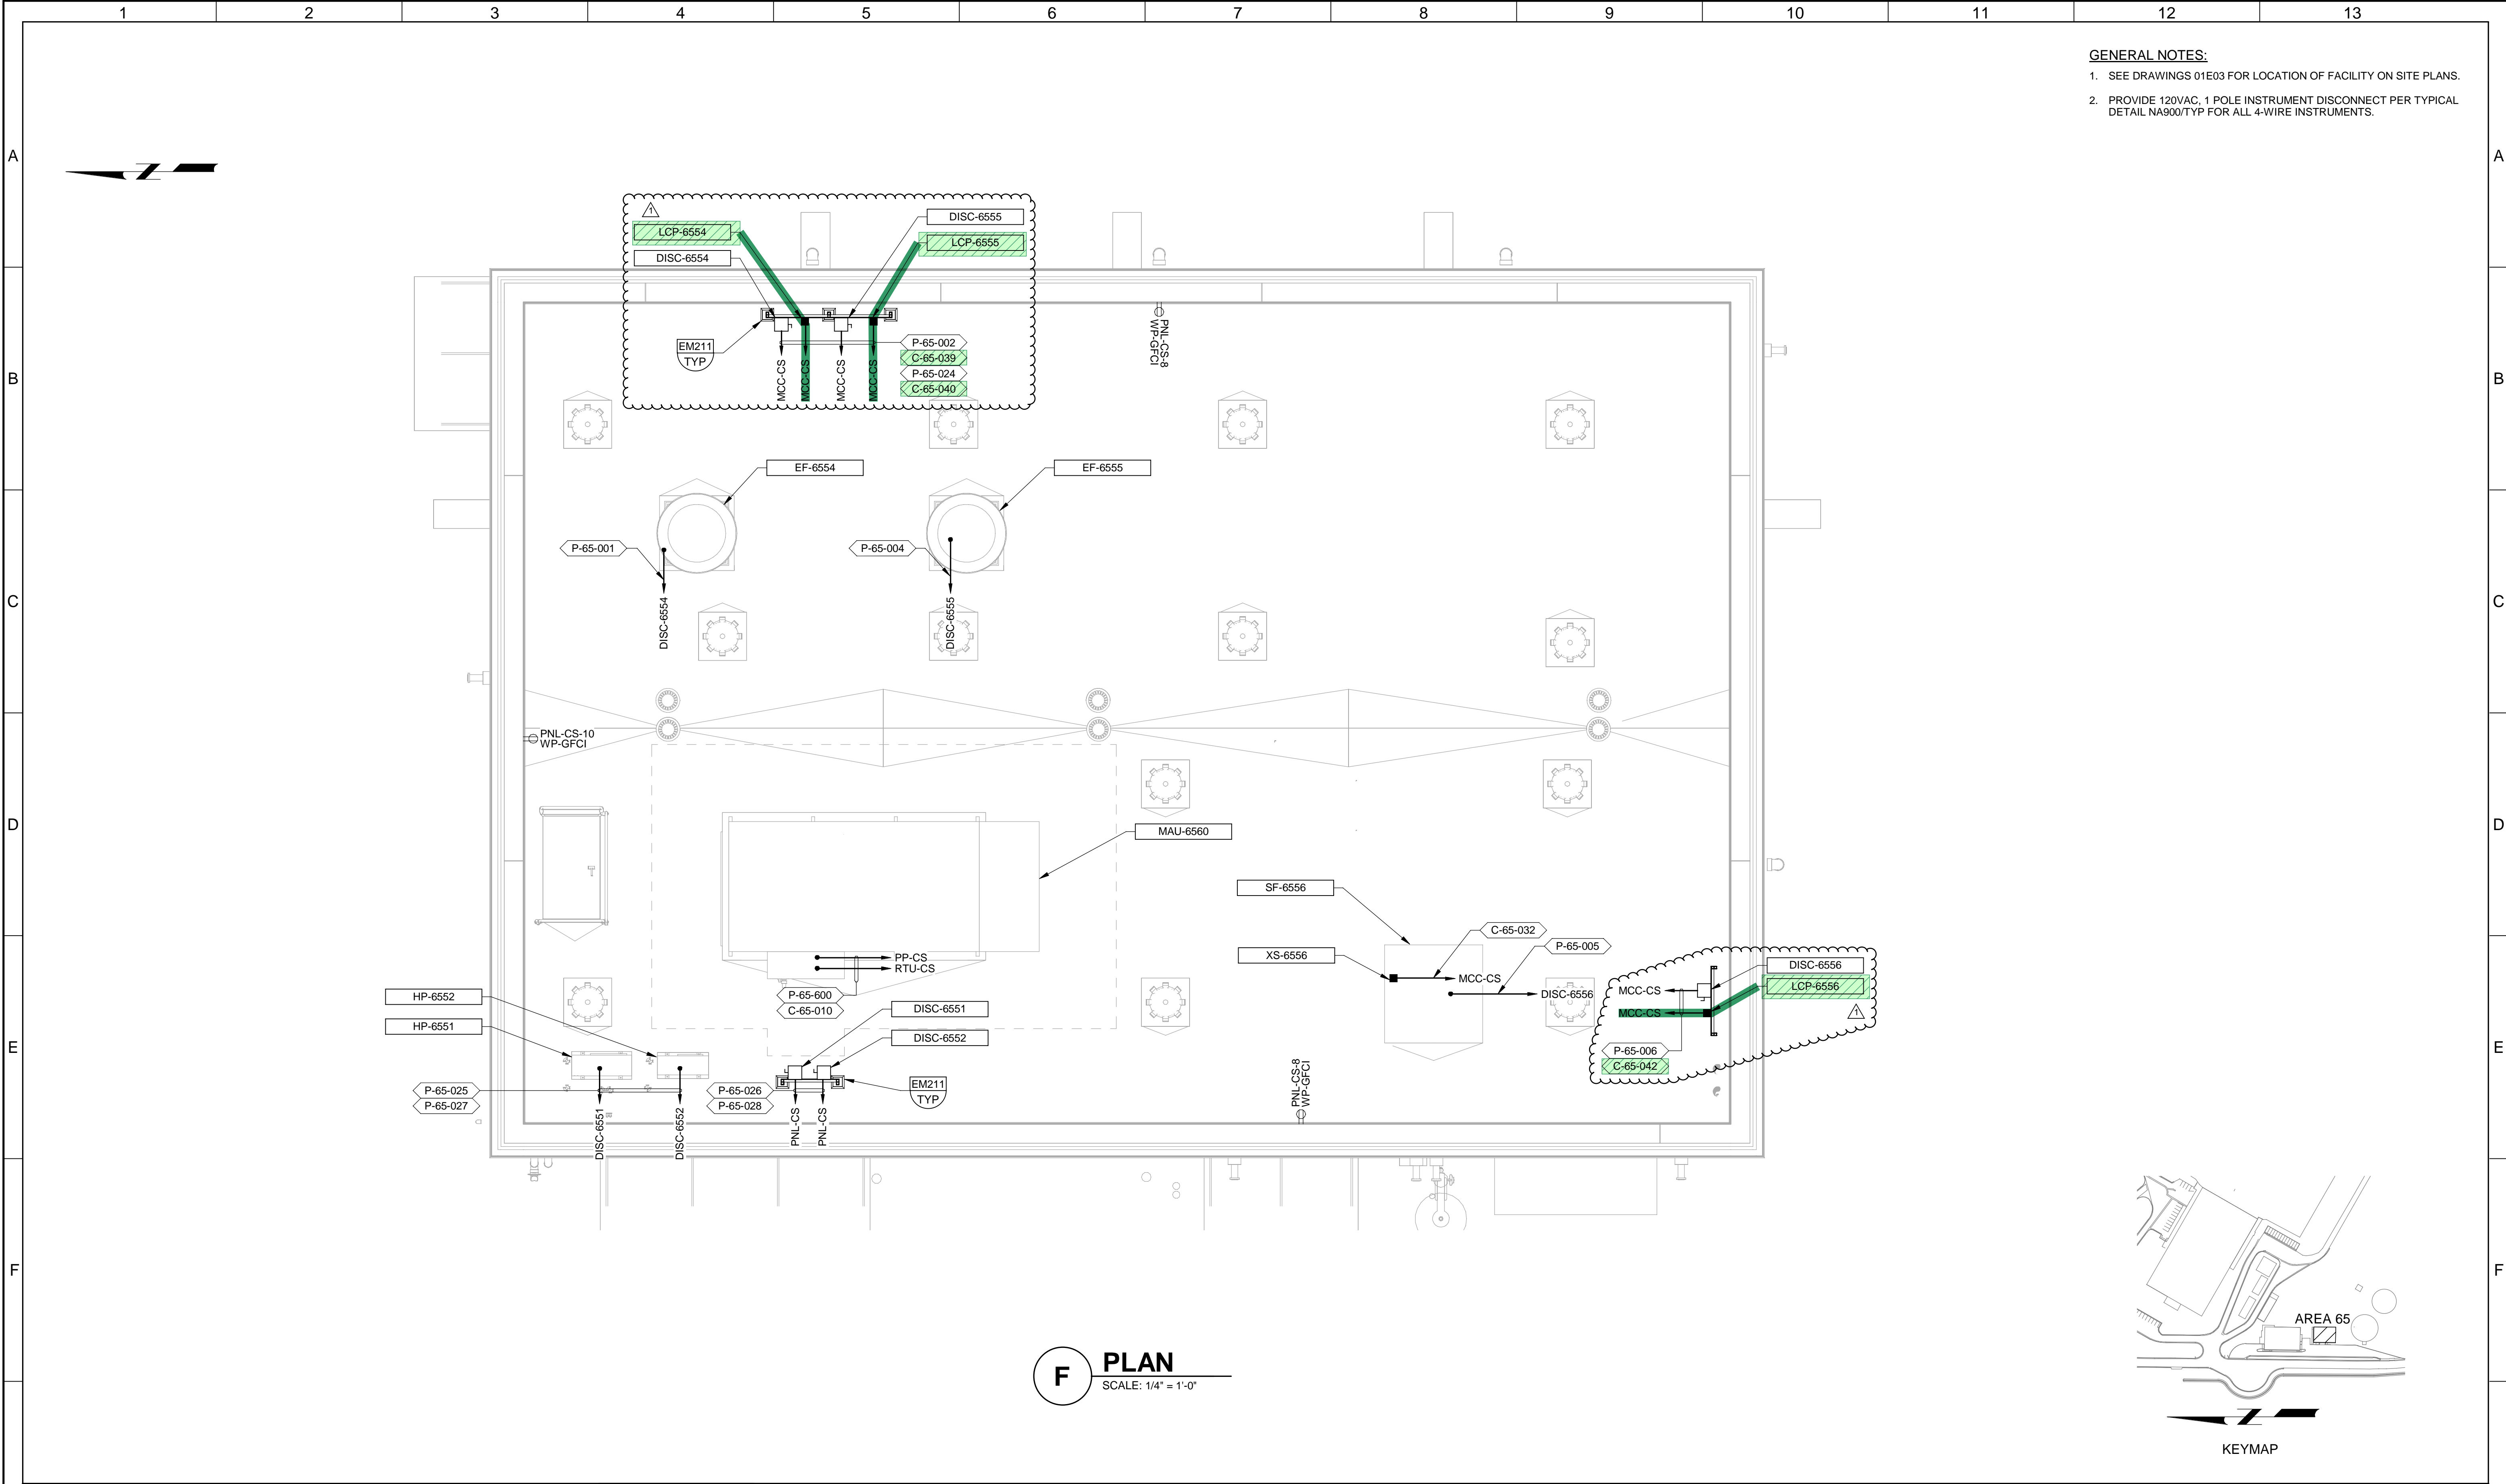


G				BID SET	DESIGNED SKB						JORDAN VALLEY WATER TREATMENT PLANT	VERIFY SCALES	JOB NO. 202001.10	G
					DRAWN NCS						FILTER AND CHEMICAL FEED UPGRADES	BAR IS ONE INCH ON ORIGINAL DRAWING	DRAWING NO.	
					CHECKED GCE						ELECTRICAL	0  1"	65E06	
					DATE FEBRUARY 2025						CAUSTIC SODA BUILDING ROOF POWER AND CONTROL PLAN	IF NOT ONE INCH ON THIS SHEET, ADJUST SCALES ACCORDINGLY	SHEET NO.	
		05/19/2025	SKB	ADDENDUM NO. 4	DESCRIPTION									

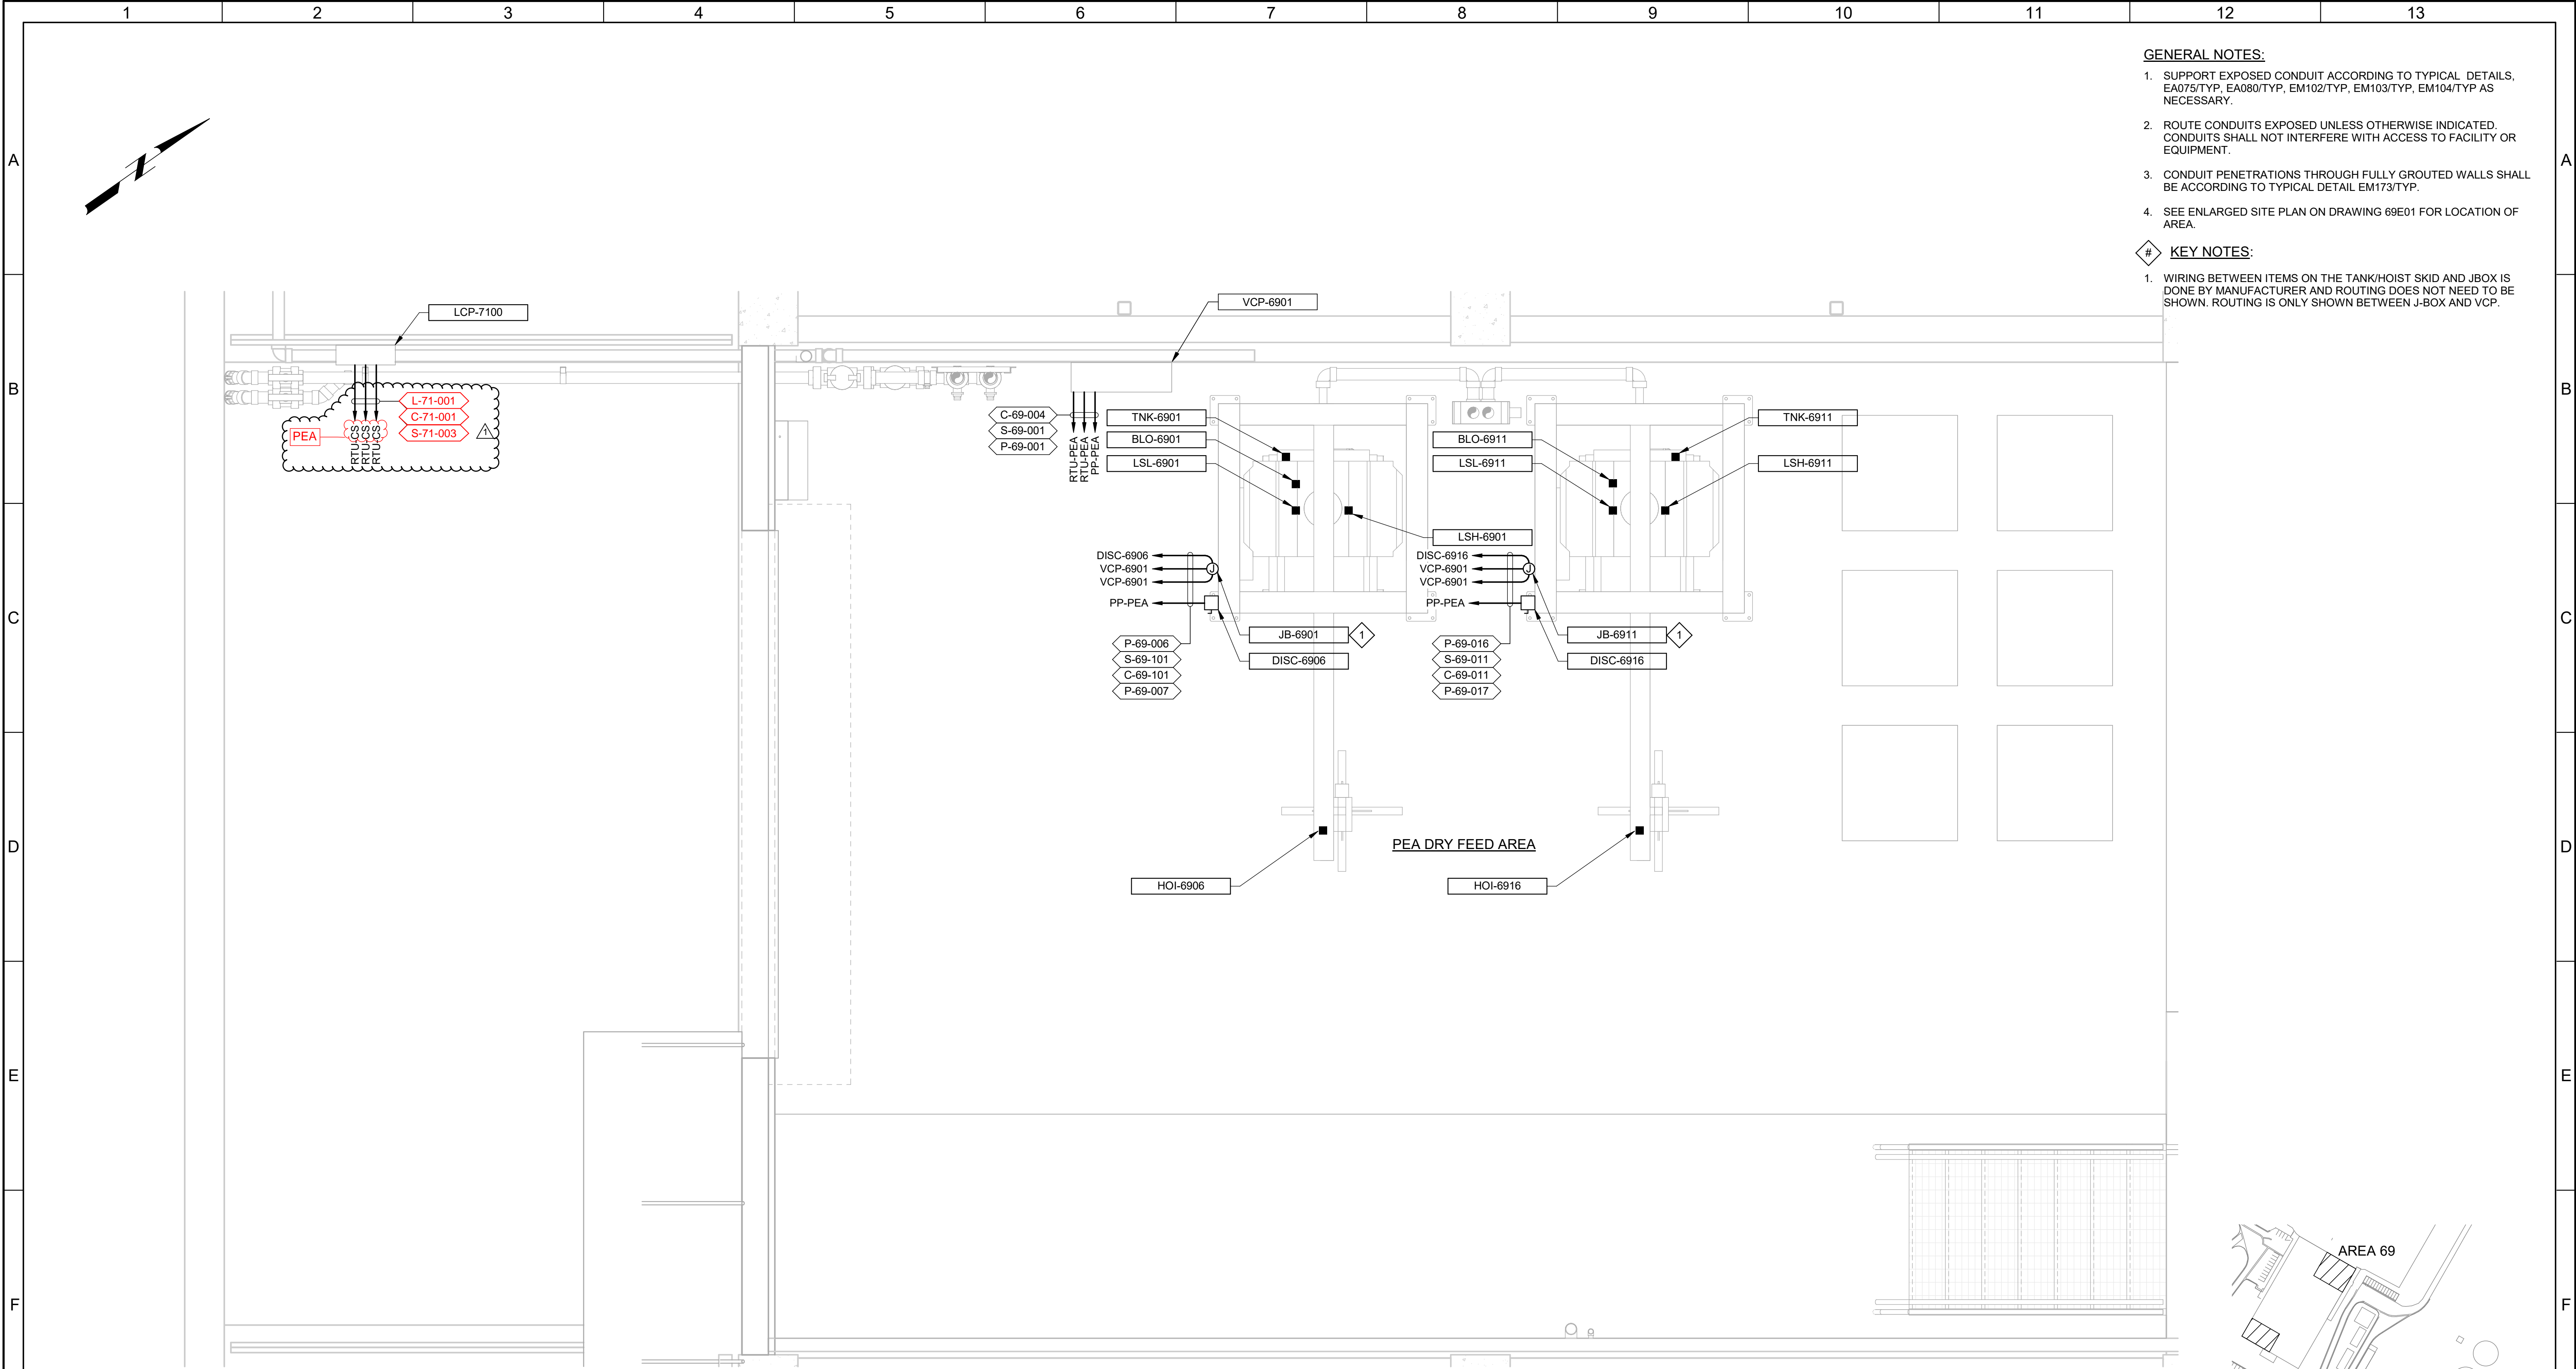


- GENERAL NOTES:**
- SUPPORT EXPOSED CONDUIT ACCORDING TO TYPICAL DETAILS, EA075/TYP, EA080/TYP, EM102/TYP, EM103/TYP, EM104/TYP AS NECESSARY.
 - ROUTE CONDUITS EXPOSED UNLESS OTHERWISE INDICATED, CONDUITS SHALL NOT INTERFERE WITH ACCESS TO FACILITY OR EQUIPMENT.
 - CONDUIT PENETRATIONS THROUGH FULLY GROUTED WALLS SHALL BE ACCORDING TO TYPICAL DETAIL EM173/TYP.
 - SEE ENLARGED SITE PLAN ON DRAWING 69E01 FOR LOCATION OF AREA.
- KEY NOTES:**
- WIRING BETWEEN ITEMS ON THE TANK/HOIST SKID AND JBOX IS DONE BY MANUFACTURER AND ROUTING DOES NOT NEED TO BE SHOWN. ROUTING IS ONLY SHOWN BETWEEN J-BOX AND VCP.

B ENLARGED PLAN
69E01 SCALE: 1/2" = 1'-0"

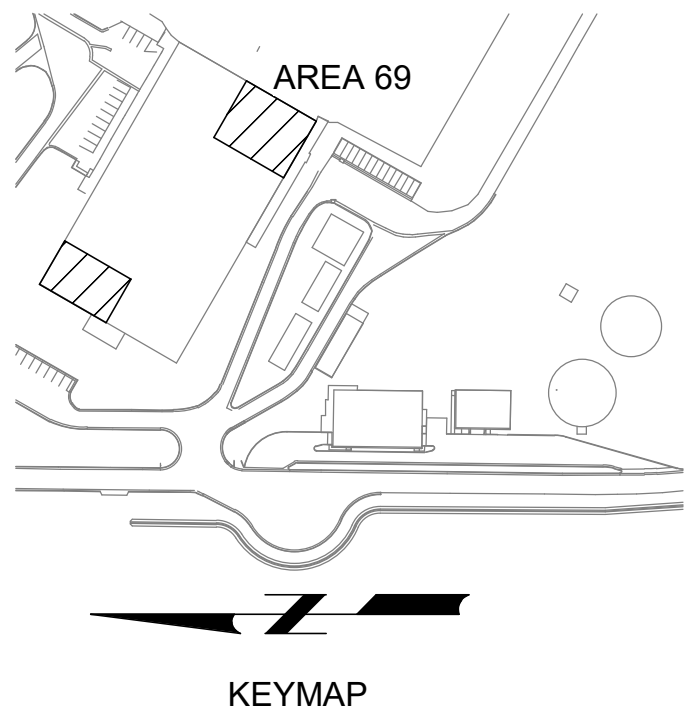

G				BID SET			DESIGNED SKB					JORDAN VALLEY WATER TREATMENT PLANT			VERIFY SCALES	JOB NO. 202001.10	G										
							DRAWN DJB					FILTER AND CHEMICAL FEED UPGRADES			BAR IS ONE INCH ON ORIGINAL DRAWING	DRAWING NO.											
							CHECKED GCE					ELECTRICAL			0 1"	69E02											
							DATE FEBRUARY 2025					PEA DRY FEED ENLARGED POWER AND CONTROL PLAN			IF NOT ONE INCH ON THIS SHEET, ADJUST SCALES ACCORDINGLY	SHEET NO.											
																OF											
		05/08/2025	SKB	ADDENDUM NO. 4																							
	REV	DATE	BY	DESCRIPTION																							
		1			2		3		4		5		6		7		8		9		10		11		12		13

PLOT DATE: 2/11/2025 8:58:40 AM

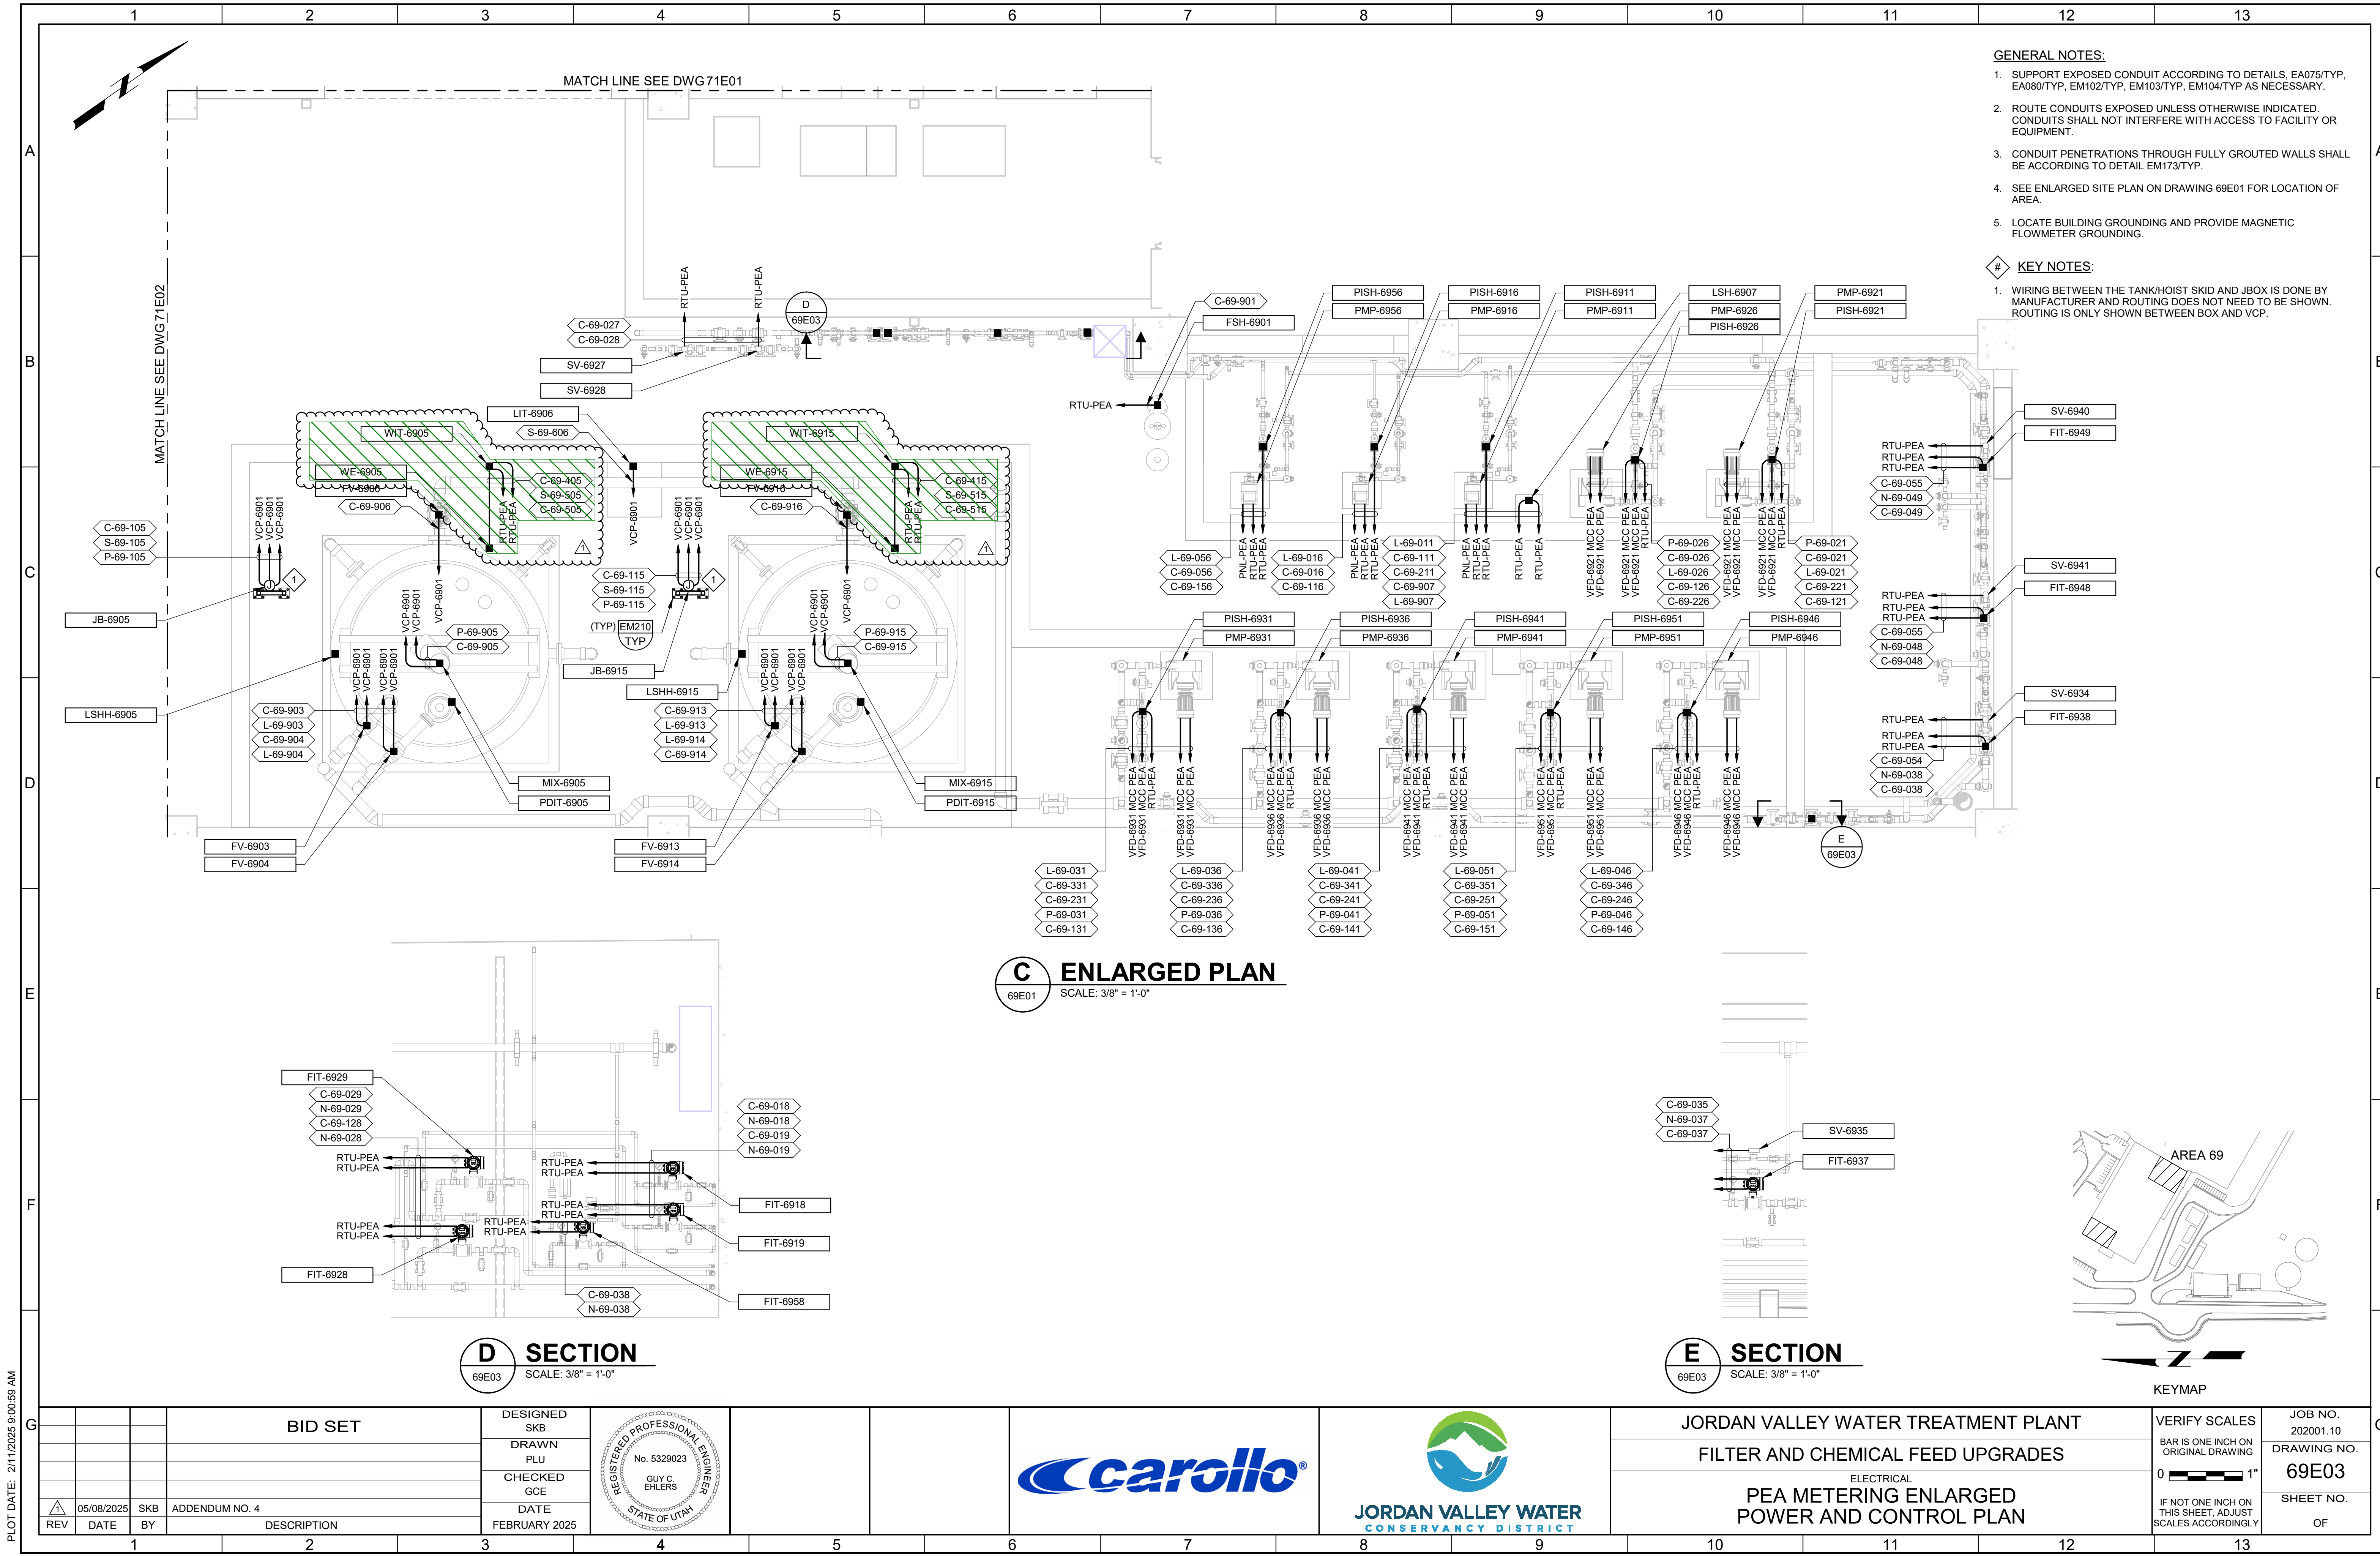


- GENERAL NOTES:**
1. SUPPORT EXPOSED CONDUIT ACCORDING TO DETAILS, EA075/TYP, EA080/TYP, EM102/TYP, EM103/TYP, EM104/TYP AS NECESSARY.
 2. ROUTE CONDUITS EXPOSED UNLESS OTHERWISE INDICATED. CONDUITS SHALL NOT INTERFERE WITH ACCESS TO FACILITY OR EQUIPMENT.
 3. CONDUIT PENETRATIONS THROUGH FULLY GROUTED WALLS SHALL BE ACCORDING TO DETAIL EM173/TYP.
 4. SEE ENLARGED SITE PLAN ON DRAWING 69E01 FOR LOCATION OF AREA.
 5. LOCATE BUILDING GROUNDING AND PROVIDE MAGNETIC FLOWMETER GROUNDING.

- # KEY NOTES:**
1. WIRING BETWEEN THE TANK/HOIST SKID AND JBOX IS DONE BY MANUFACTURER AND ROUTING DOES NOT NEED TO BE SHOWN. ROUTING IS ONLY SHOWN BETWEEN BOX AND VCP.

C ENLARGED PLAN
69E01 SCALE: 3/8" = 1'-0"


D SECTION
69E03 SCALE: 3/8" = 1'-0"

E SECTION
69E03 SCALE: 3/8" = 1'-0"

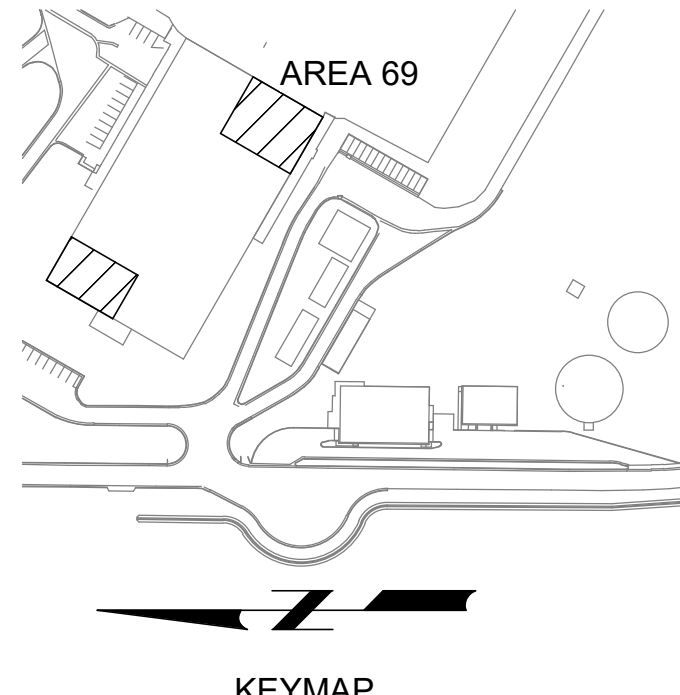


PLOT DATE: 2/11/2025 9:00:59 AM

G				BID SET		DESIGNED SKB						JORDAN VALLEY WATER TREATMENT PLANT			VERIFY SCALES	JOB NO. 202001.10									
						DRAWN PLU						FILTER AND CHEMICAL FEED UPGRADES			BAR IS ONE INCH ON ORIGINAL DRAWING	DRAWING NO. 69E03									
						CHECKED GCE						ELECTRICAL			0 1"	SHEET NO. OF									
						DATE FEBRUARY 2025						PEA METERING ENLARGED POWER AND CONTROL PLAN			IF NOT ONE INCH ON THIS SHEET, ADJUST SCALES ACCORDINGLY										
		05/08/2025	SKB	ADDENDUM NO. 4																					
REV	DATE	BY	DESCRIPTION																						
	1		2		3		4		5		6		7		8		9		10		11		12		13

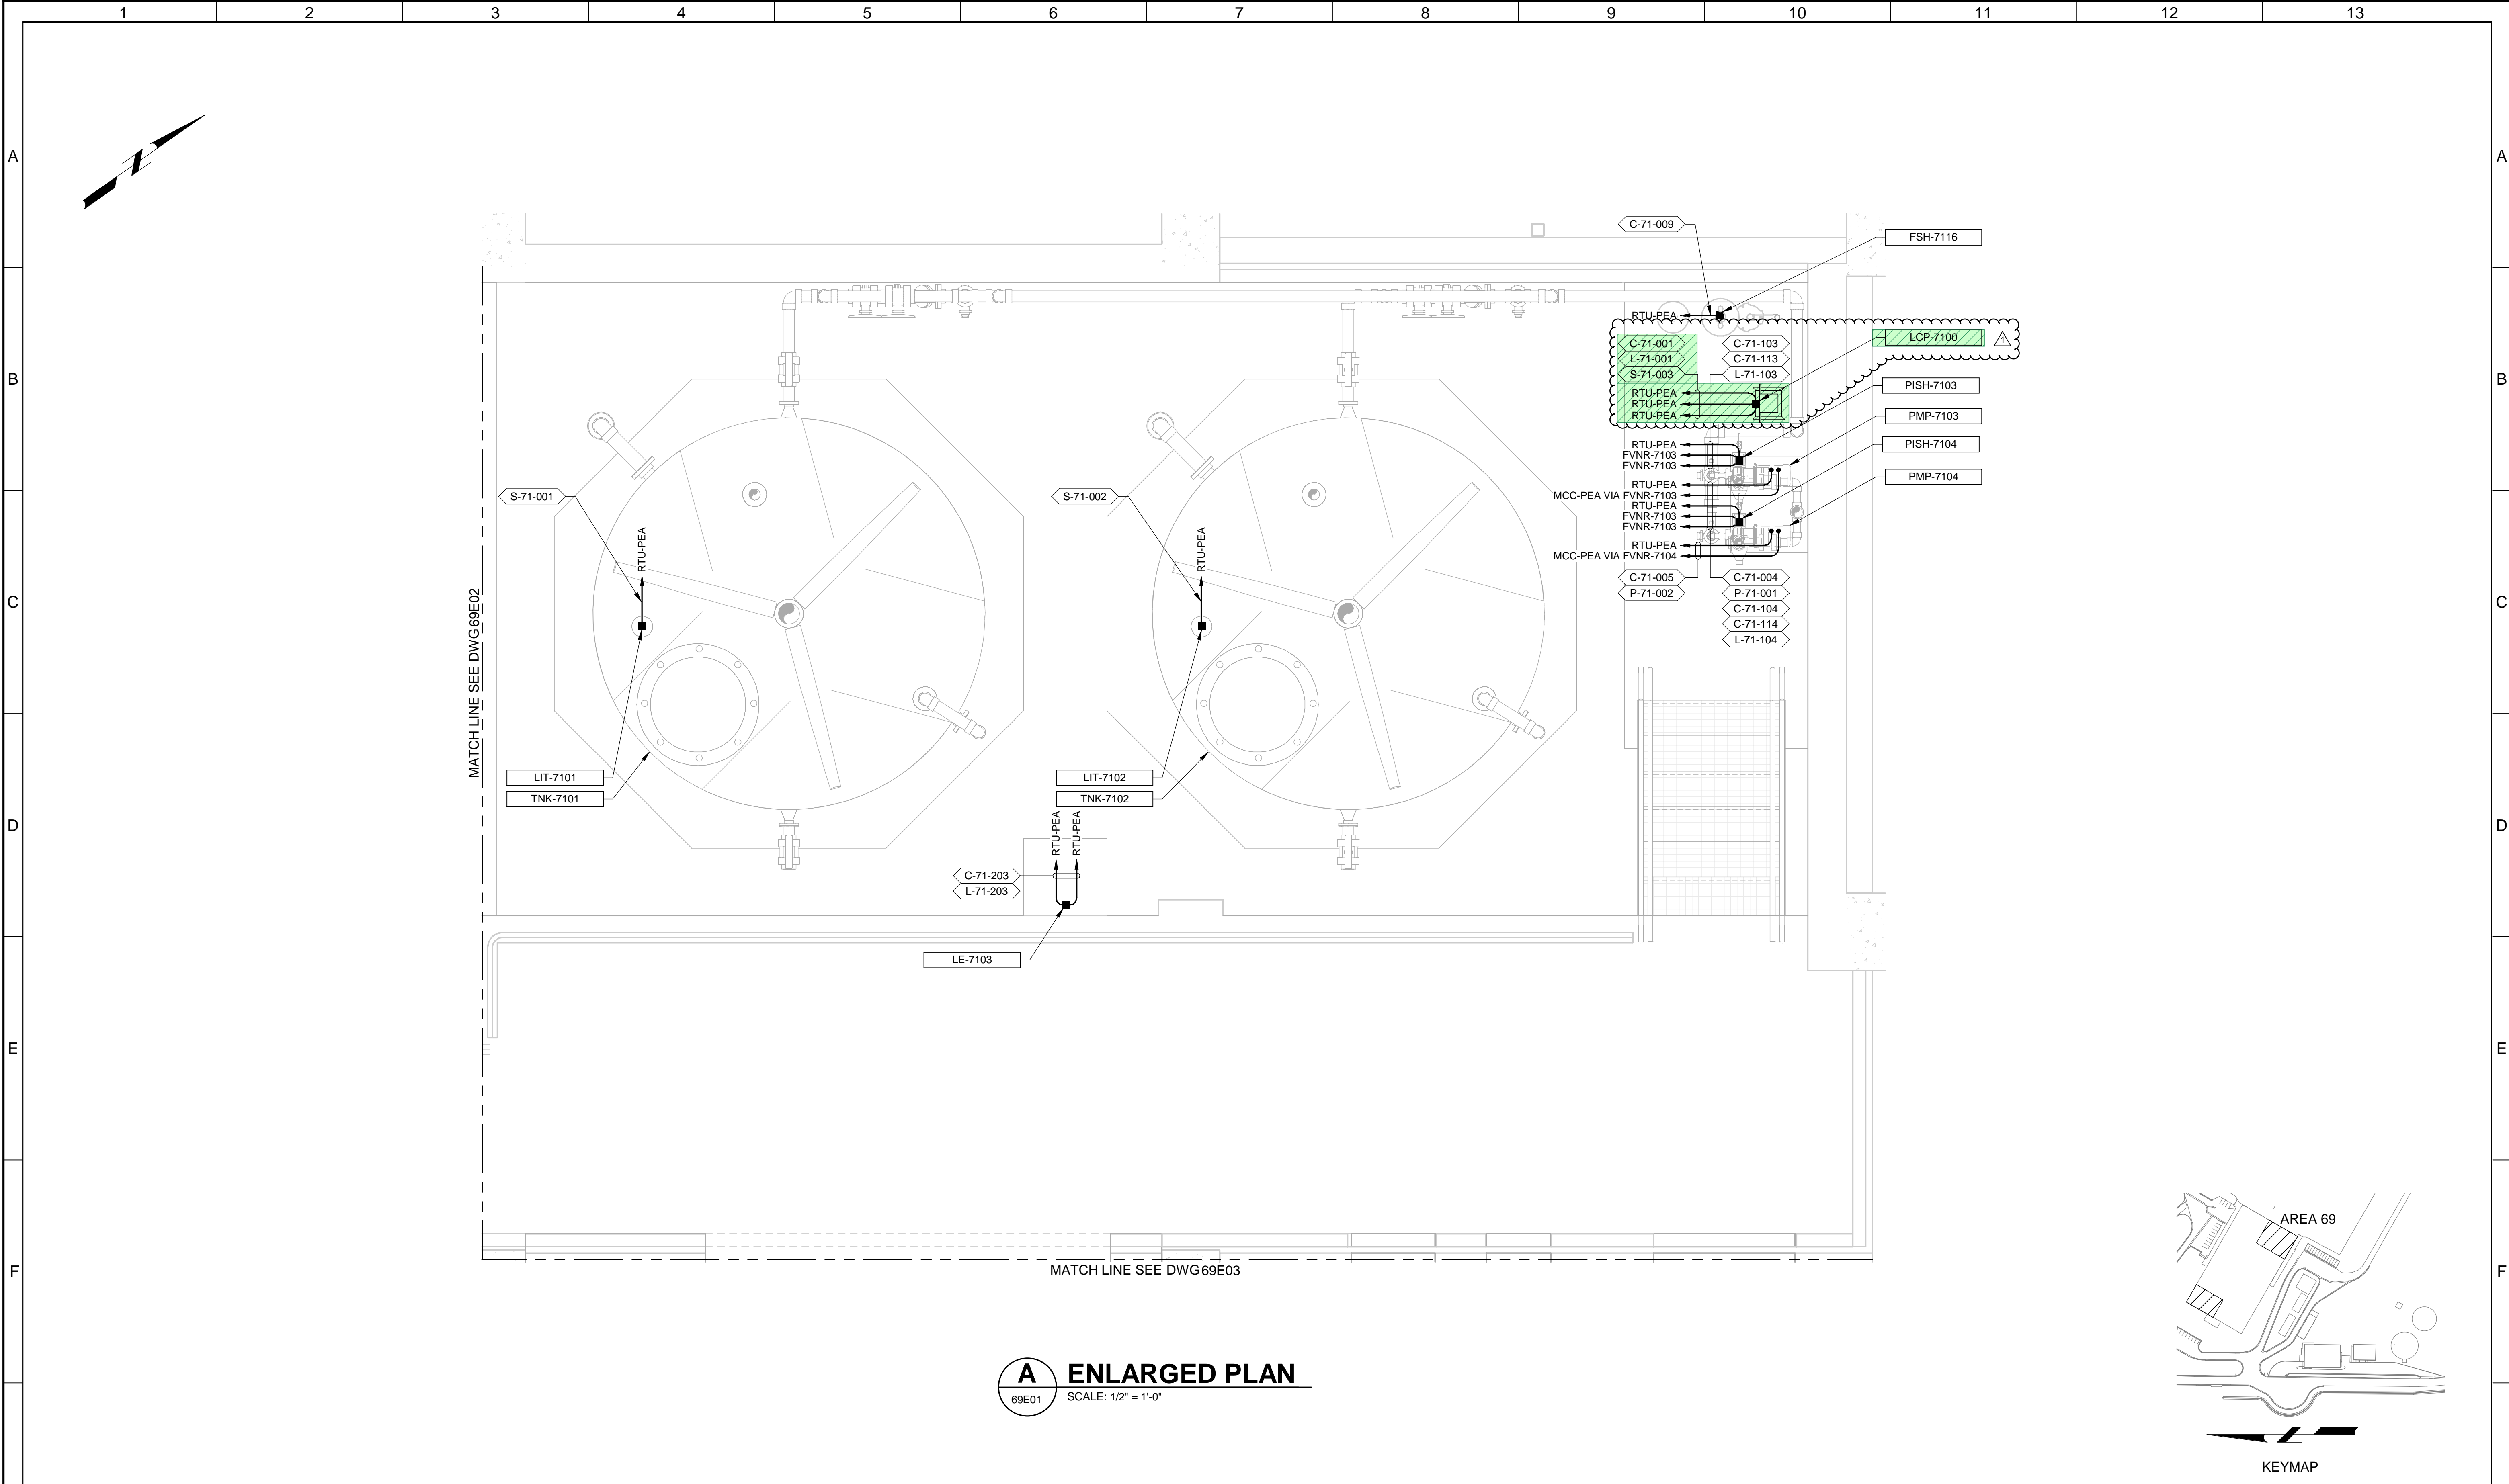


A ENLARGED PLAN
69E01 SCALE: 1/2" = 1'-0"


G				BID SET	DESIGNED SKB						JORDAN VALLEY WATER TREATMENT PLANT	VERIFY SCALES	JOB NO. 202001.10	G
					DRAWN MNH						FILTER AND CHEMICAL FEED UPGRADES	BAR IS ONE INCH ON ORIGINAL DRAWING	DRAWING NO.	
					CHECKED GCE							0 1"	71E01	
					DATE FEBRUARY 2025						ELECTRICAL PEC BULK STORAGE ENLARGED POWER AND CONTROL PLAN	IF NOT ONE INCH ON THIS SHEET, ADJUST SCALES ACCORDINGLY	SHEET NO.	
	△	05/08/2025	SKB	ADDENDUM NO. 4										
REV	DATE	BY	DESCRIPTION											OF

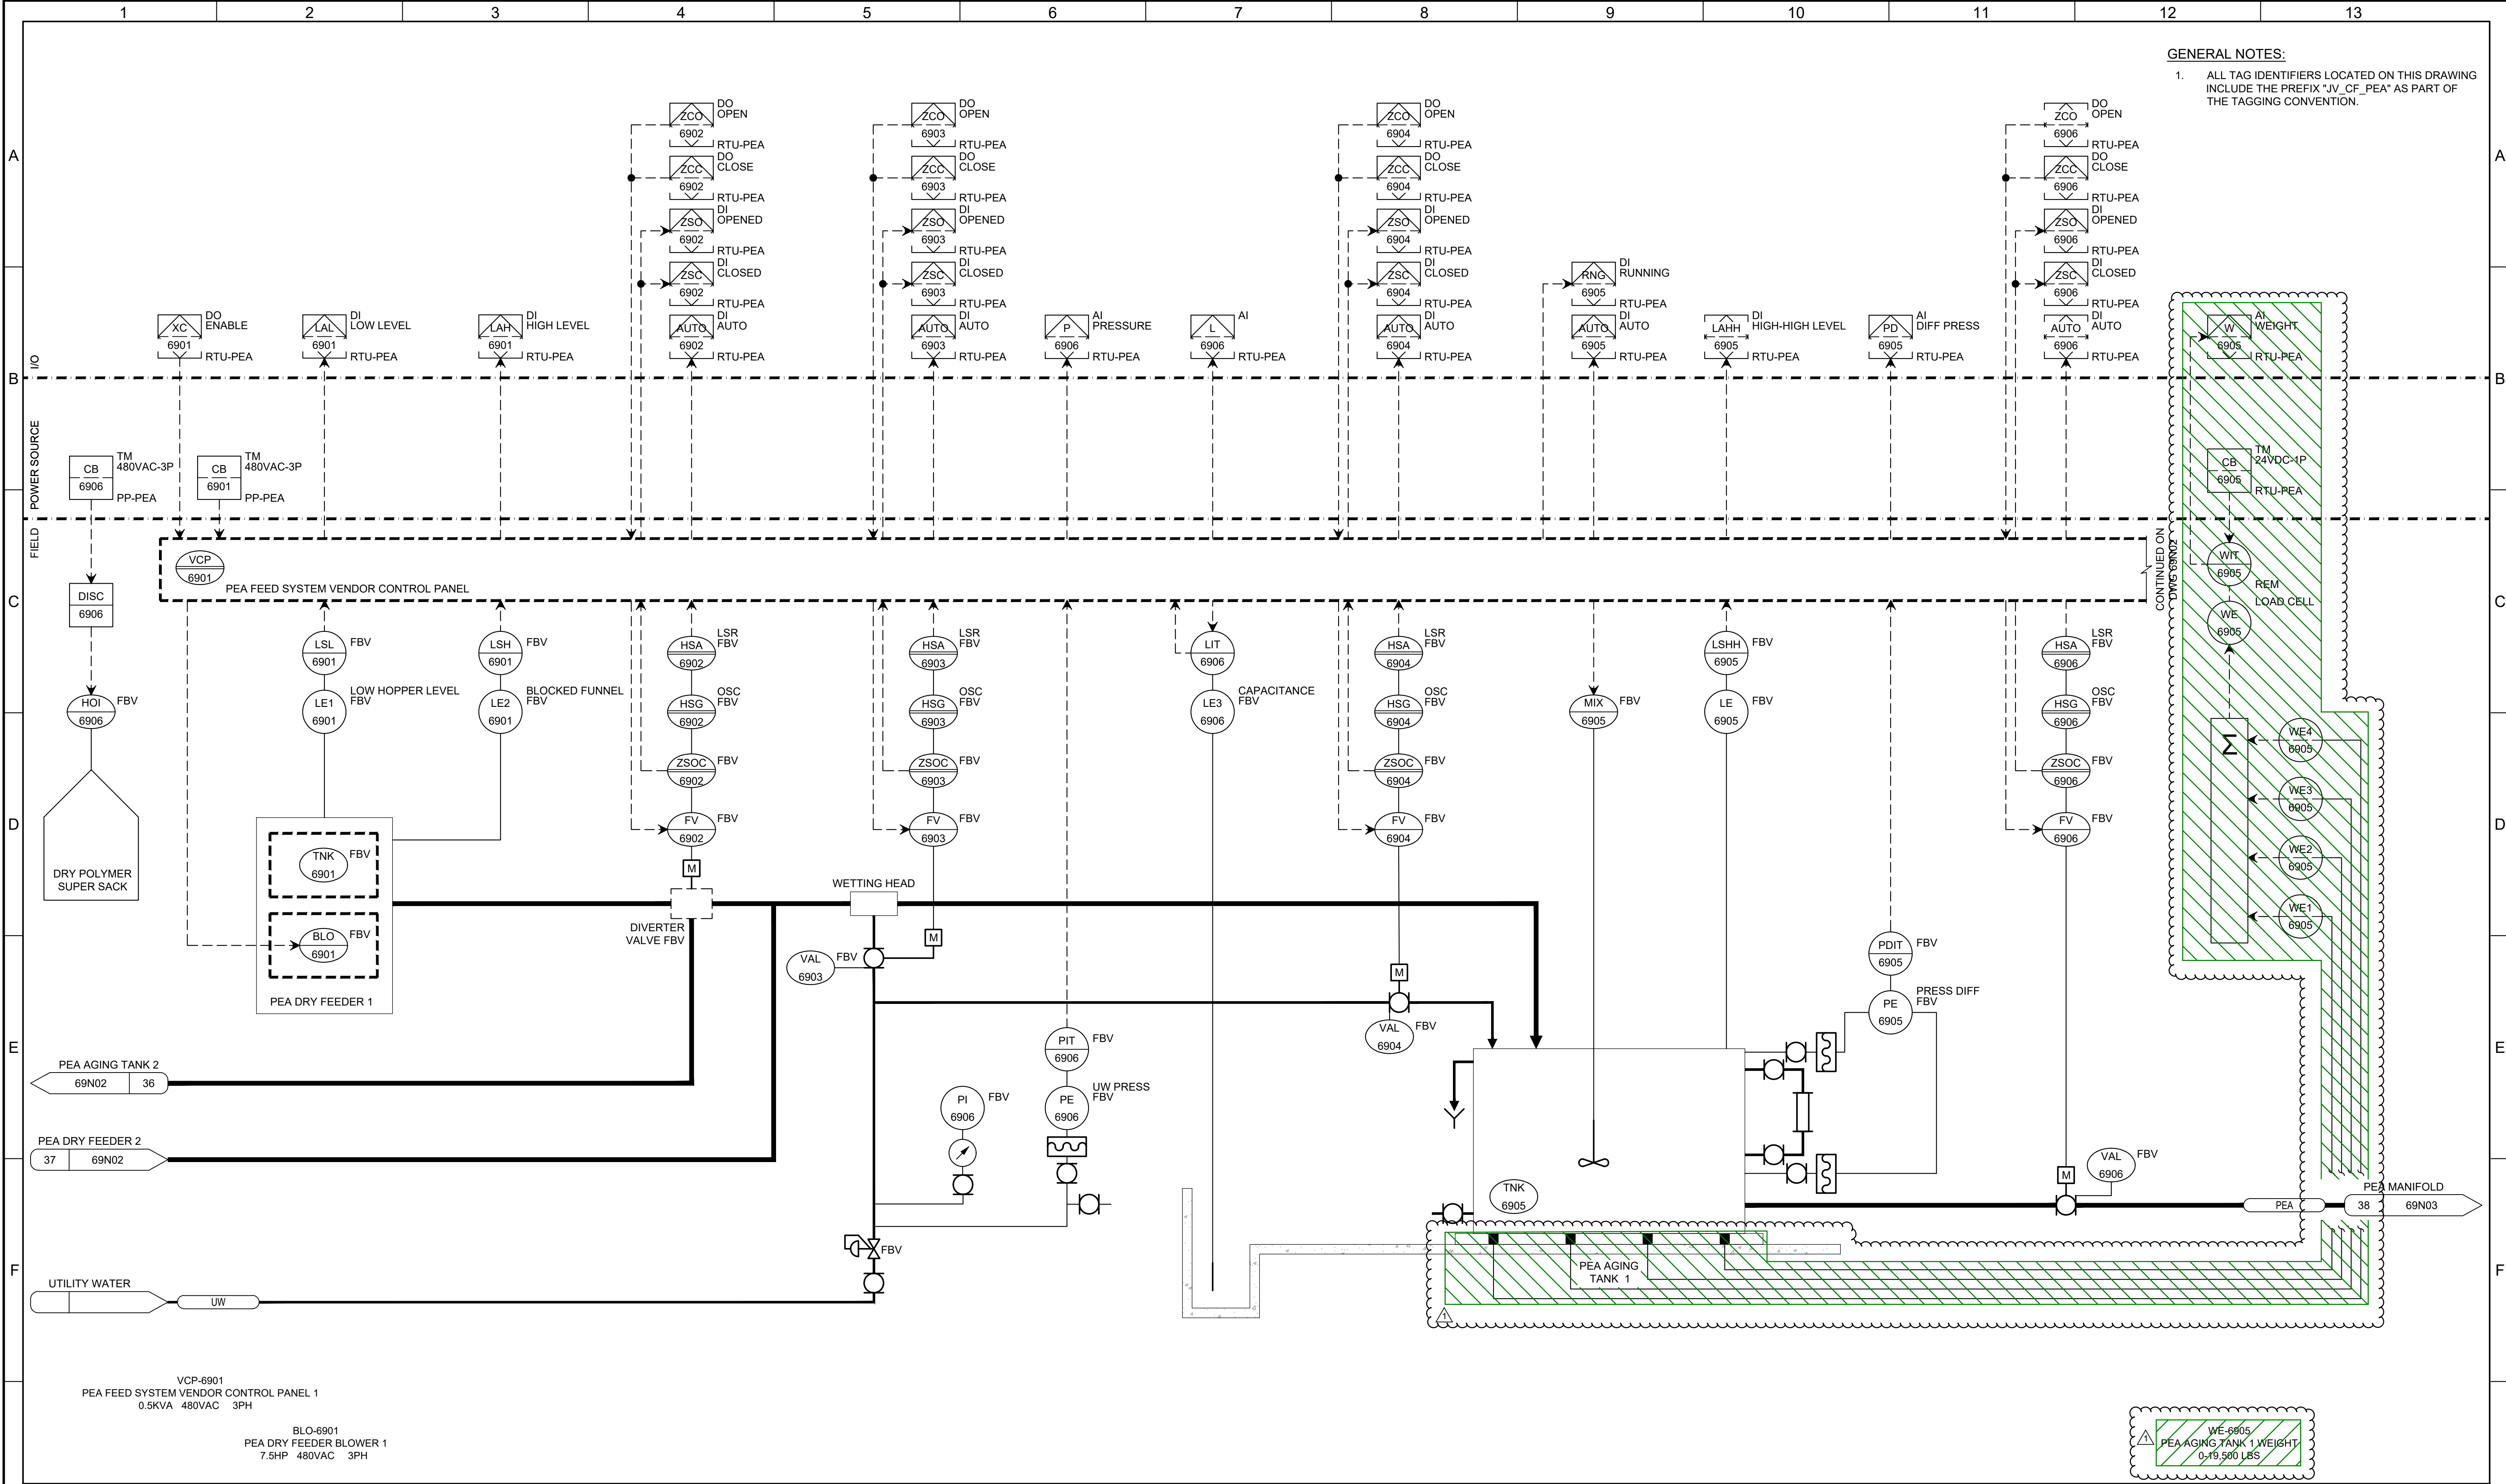

G				BID SET	DESIGNED GEB				JORDAN VALLEY WATER TREATMENT PLANT	VERIFY SCALES	JOB NO. 202001.10	G
					DRAWN LMB				FILTER AND CHEMICAL FEED UPGRADES	BAR IS ONE INCH ON ORIGINAL DRAWING	DRAWING NO. 69N01	
					CHECKED GCE				INSTRUMENTATION	0 1"	SHEET NO.	
					DATE FEBRUARY 2025				P&ID PEA BATCHING 1	IF NOT ONE INCH ON THIS SHEET, ADJUST SCALES ACCORDINGLY	OF	
		05/20/2025	ERB	ADDENDUM NO. 4								
REV	DATE	BY	DESCRIPTION									

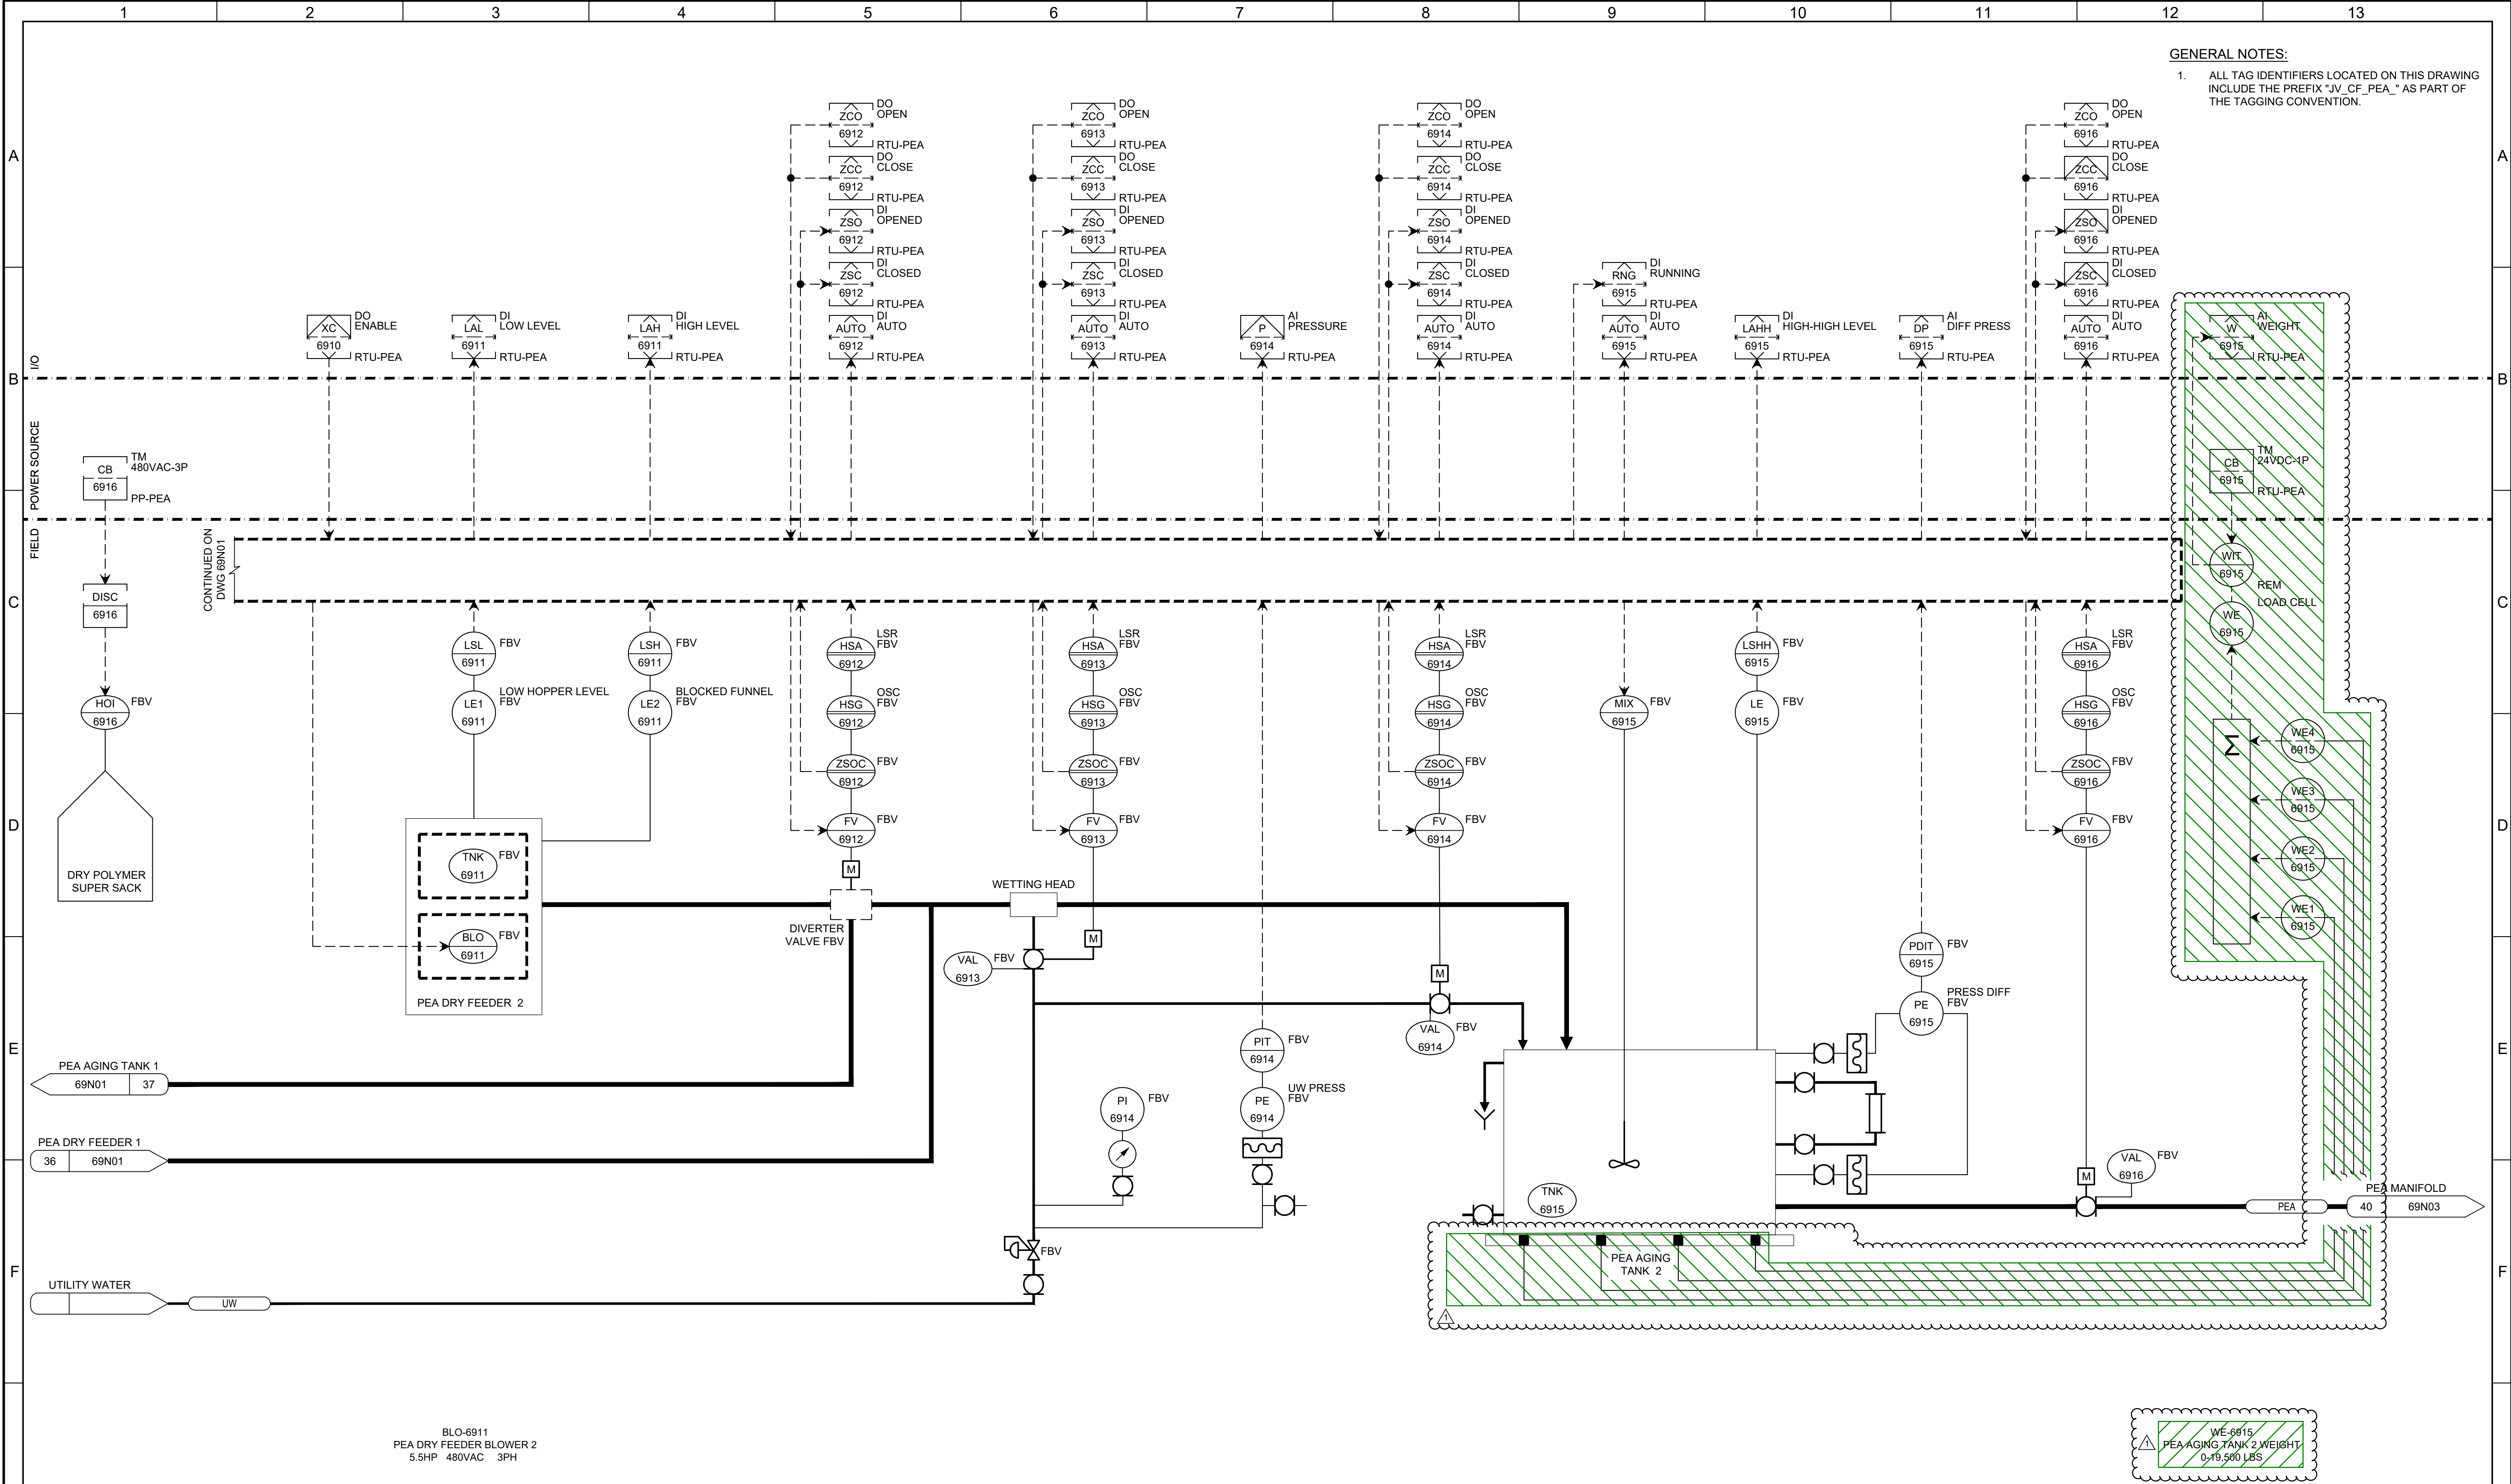

BID SET			DESIGNED GEB								JORDAN VALLEY WATER TREATMENT PLANT			VERIFY SCALES	JOB NO. 202001.10
			DRAWN LMB								FILTER AND CHEMICAL FEED UPGRADES			BAR IS ONE INCH ON ORIGINAL DRAWING	DRAWING NO. 69N02
			CHECKED GCE								INSTRUMENTATION			0 1"	SHEET NO.
			DATE FEBRUARY 2025								P&ID PEA BATCHING 2			IF NOT ONE INCH ON THIS SHEET, ADJUST SCALES ACCORDINGLY	OF
REV	DATE	BY	DESCRIPTION												
1															
2															
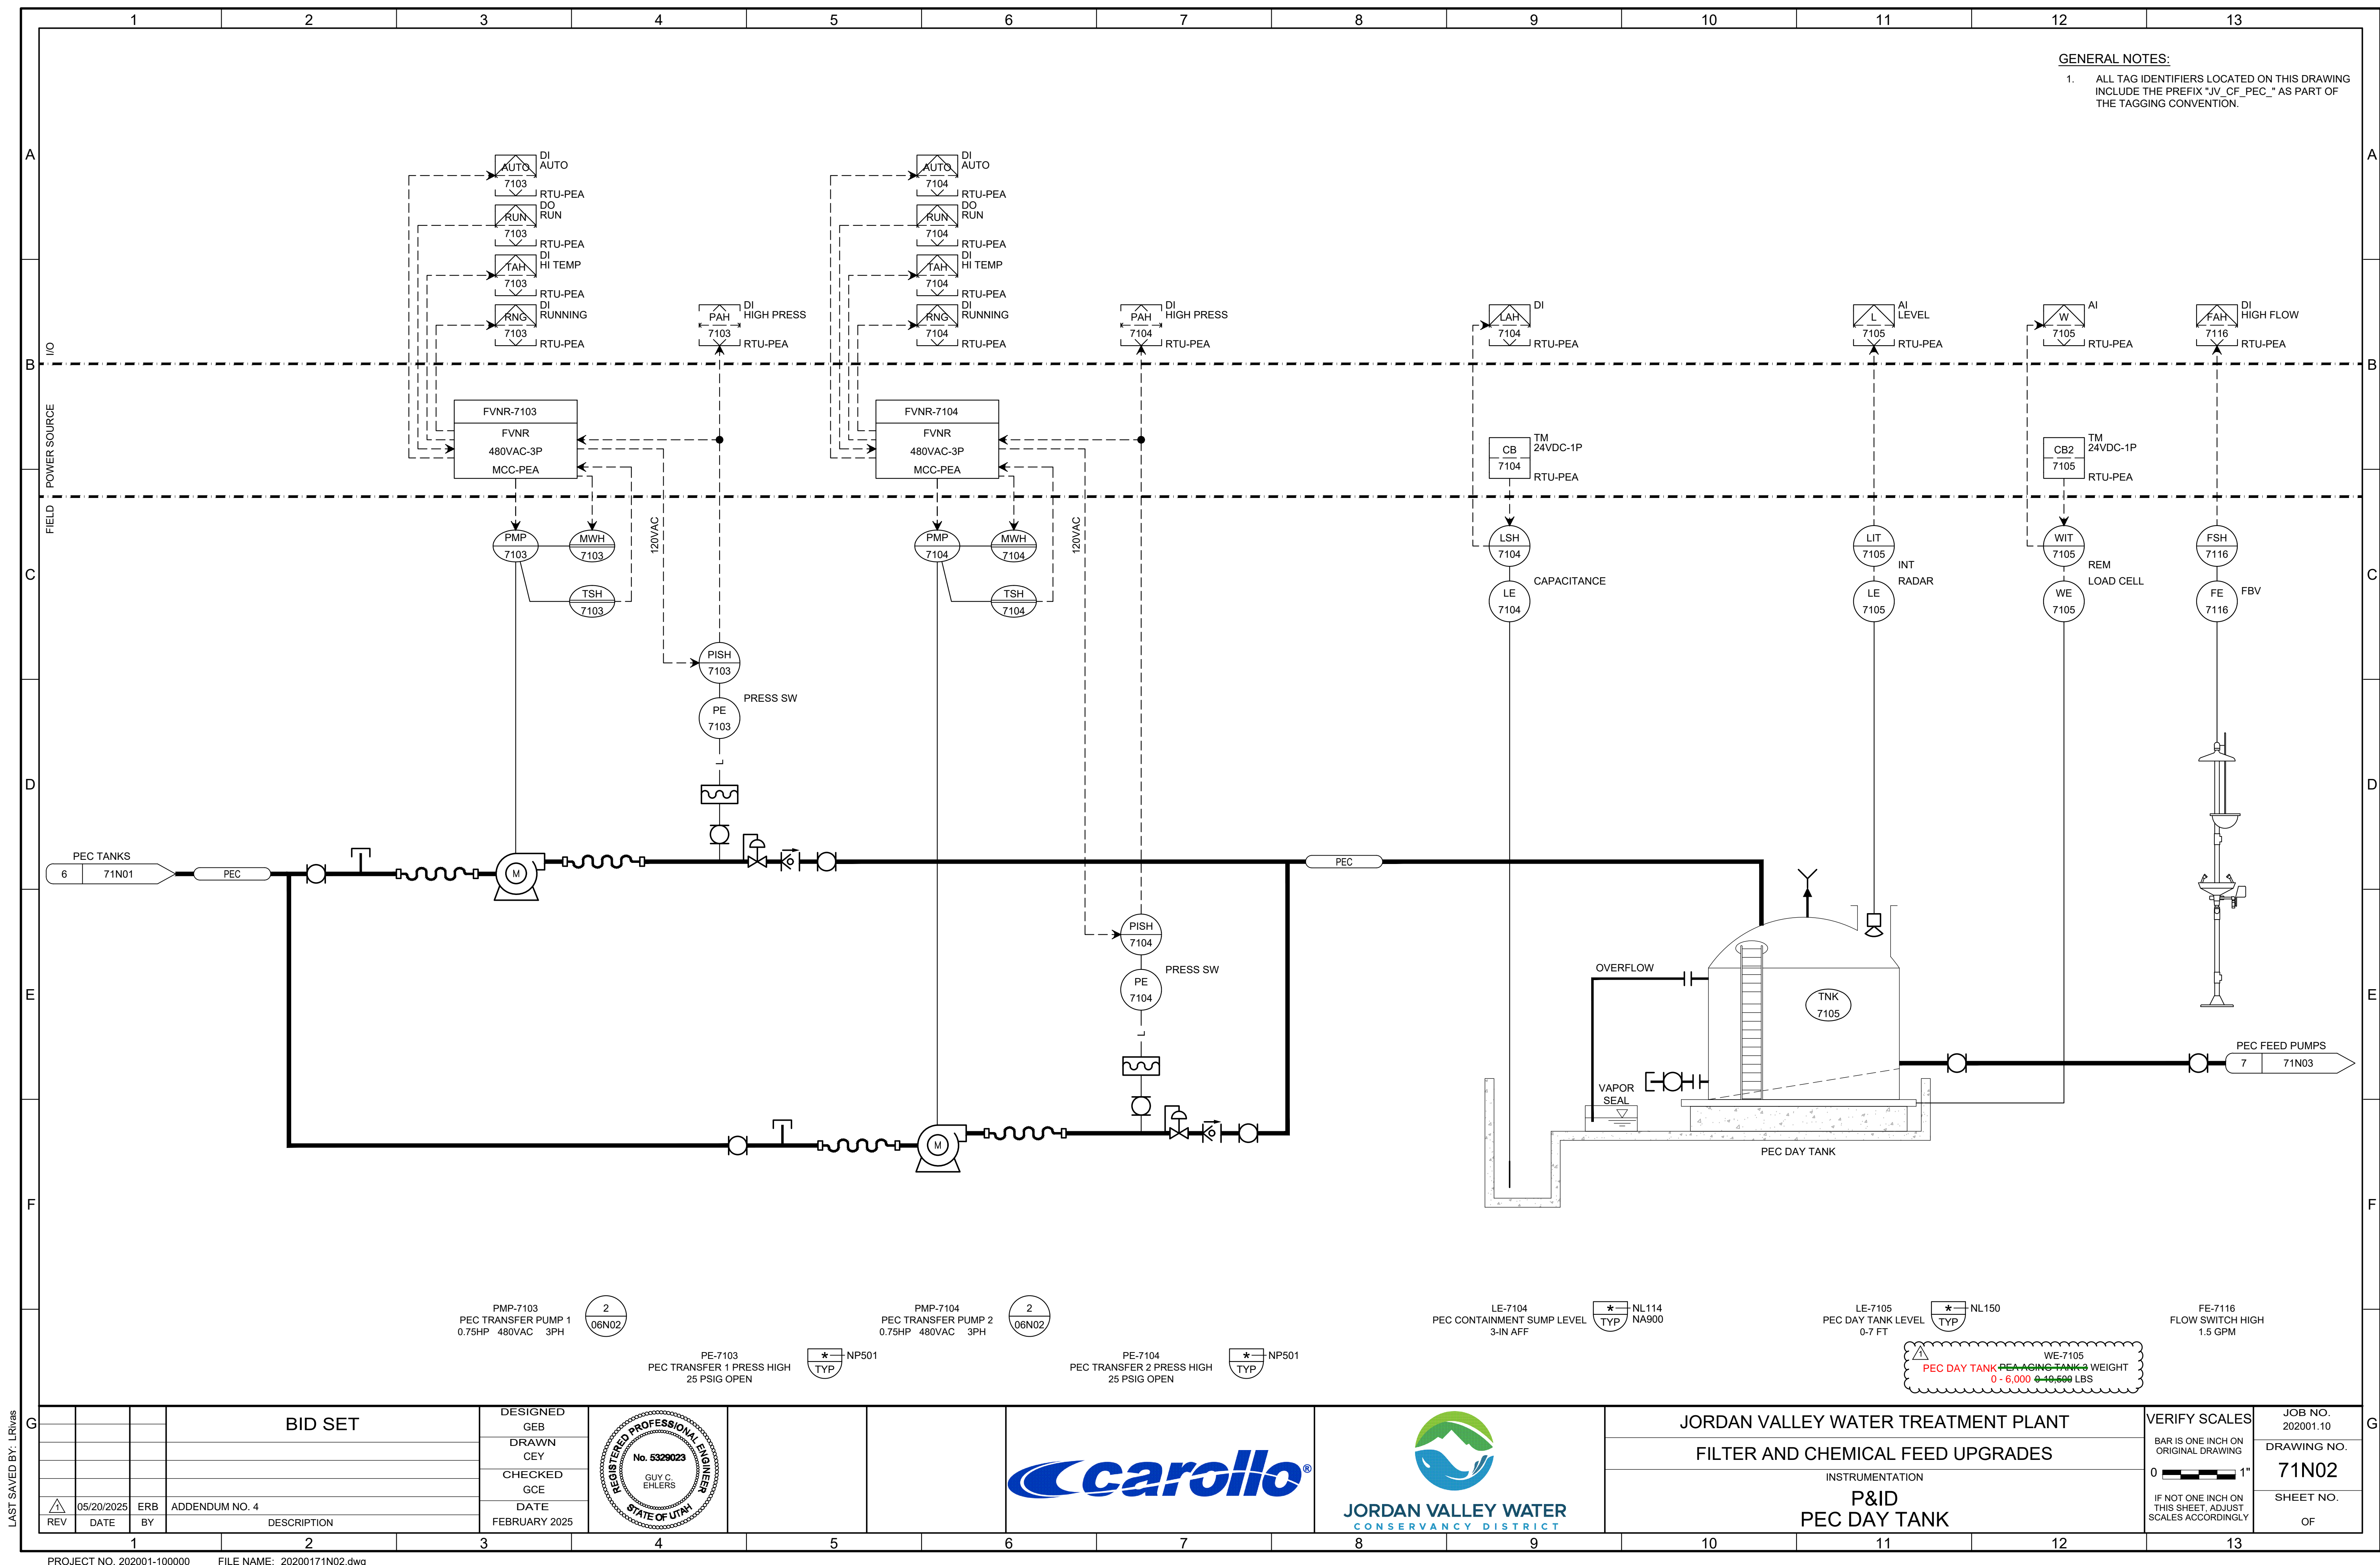

REPLACE ATTACHMENTS A AND B IN THEIR ENTIRETY

ATTACHMENT A Schedule of Surfaces to be Coated

- A. The following schedule is incomplete. Coat unlisted surfaces with same coating system as similar listed surfaces. Contact Engineer for clarification.

EPU-M-1	Metals, exterior, non-immersed
EPX-M-2	Metals, interior, non-immersed
EPX-M-2-PWS	Metals: immersed and in contact with water being treated for domestic use (potable water).
EPX-M-6-BG	Metals, below grade or buried pipes
VE-C-1	All concrete surfaces inside the caustic chemical containment areas and tank offloading/fill sump, as shown on the structural drawings, including inside of containment wall surfaces (up to 3 ft above finished floor where indicated), top of containment wall surfaces, sump area, equipment pads, and tank pads
ACR-PVC-1	PVC or CPVC piping subject to direct sunlight
Notes:	
<p>1: Non-immersed ferrous metal surfaces include:</p> <ul style="list-style-type: none"> a. Doors, doorframes, ventilators, louvers, grilles, exposed sheet metal, and flashing. b. Pipe, valves, pipe hangers, supports and saddles, conduit, cable tray hangers, and supports. c. Motors and motor accessory equipment. d. Drive gear, drive housing, coupling housings, and miscellaneous gear drive equipment. e. Valve and gate operators and stands. f. Structural steel. g. Crane and hoist rails. h. Exterior of tanks and other containment vessels. i. Mechanical equipment supports, drive units, and accessories. j. Bare electrical equipment: boxes, exposed conduit, and accessories. k. Pumps not submerged. l. Other miscellaneous metals. m. Exposed (underside) of galvanized roof decking. <p>2: Immersed ferrous metal surfaces include:</p> <ul style="list-style-type: none"> a. Interior surfaces of ferrous metal tanks. b. Field priming of ferrous metal surfaces with defective shop-prime coat; including non-submerged service. c. Bell rings, underside of manhole covers and frames. d. Sump pumps, including underside of base plates and submerged suction and discharge piping. e. Exterior of submerged piping and valves other than stainless steel or PVC piping. f. Submerged pipe supports and hangers. g. Stem guides. h. Other submerged iron and steel metal unless specified otherwise. 	

Attachment B			
Coating Detail Sheet			
Coating System	EPU-M-1		
Coating Material	Two coats epoxy with polyurethane finish coat		
Substrate	Metal		
Products: One of the following or equal:	Primer	Intermediate Coat	Finish Coat
Carboline	Carboguard 890	Carboguard 890	Carbothane 134 VOC
International Paint	Devran 224V	Devran 224V	Devthane 379
PPG	Amercoat 385	Amercoat 385	Amercoat 450H
Sherwin Williams	Macropoxy 646	Macropoxy 646	Hi Solids Polyurethane
Tnemec	Series 69	Series 69	Series 1095
Service Condition	Interior or Exterior, subject to direct sunlight. Non-immersion.		
Surface Preparation			
General	Prepare surfaces as specified in this Section and as follows.		
Ferrous Metal	Bare surfaces: SSPC-SP10, Near-White Blast Cleaning. Shop primed surfaces: SSPC-SP2, Hand Tool Cleaning or SSPC-SP3, Power Tool Cleaning. Damaged primer or rust: SSPC-SP10, Near White Blast Cleaning and spot prime.		
Nonferrous Metal	SSPC-SP16, Brush Blast Cleaning.		
Galvanized Metal	SSPC-SP16, Brush Blast Cleaning. Test for surface contaminants.		
Surface Profile			
Ferrous Metal	2.5 to 3.0 mils		
Nonferrous Metal	1.5 to 2.0 mils		
Galvanized Metal	1.5 to 2.0 mils		
System Thickness (Dry Film)			
Total	10 to 13 mils		
Primer	4 to 5 mils		
Intermediate Coat	4 to 5 mils		
Finish Coat	2 to 3 mils		
Application			
Special CTR Training	Not required.		

Attachment B			
Coating Detail Sheet			
Coating System	EPX-M-2		
Coating Material	Epoxy		
Substrate	Metal		
Products: One of the following or equal:	Primer	Intermediate Coat	Finish Coat
Carboline	Carboguard 890	Carboguard 890	Carboguard 890
International Paint	Bar-Rust 236	Bar-Rust 236	Bar-Rust 236
PPG	Amerlock 2/400 Series	Amerlock 2/400 Series	Amerlock 2/400 Series
Sherwin Williams	Tank Clad HS	Tank Clad HS	Tank Clad HS
Tnemec	Series 69	Series 69	Series 69
Service Condition	Immersed, non-immersed, moderately corrosive environment.		
Surface Preparation			
General	Prepare surfaces as specified in this Section and as follows.		
Ferrous Metal	Bare surfaces: SSPC-SP5, White Metal Blast Cleaning. Shop primed surfaces: SSPC-SP7, Brush-Off Blast Cleaning. Damaged primer or rust: SSPC-SP5, White Metal Blast Cleaning and spot prime.		
Nonferrous Metal	SSPC-SP16, Brush-Off Blast Cleaning.		
Galvanized Metal	SSPC-SP16, Brush-Off Blast Cleaning.		
Surface Profile			
Ferrous Metal	2 to 4 mils		
Nonferrous Metal	1.0 to 1.5 mils		
Galvanized Metal	1.0 to 1.5 mils		
System Thickness (Dry Film)			
Total	12 to 16 mils		
Primer	4 to 6 mils		
Intermediate Coat	4 to 6 mils		
Finish Coat	4 to 6 mils		
Application			
Special CTR Training	Not required.		

Attachment B			
Coating Detail Sheet			
Coating System	EPX-M-2-PWS		
Coating Material	Ultra-high Solids Epoxy		
Substrate	Metal		
Products: One of the following or equal:	Primer	Intermediate Coat	Finish Coat
Carboline	Plasite 4500	None Applied	Plasite 4500
International Paint	No product specified	No product specified	No product specified
PPG	No product specified	No product specified	No product specified
Sherwin Williams	Sher-Plate	None Applied	Sher-Plate
Tnemec	Series 22	None Applied	Series 22
Service Condition	Immersed, moderately corrosive environment in contact with Potable Water.		
Surface Preparation			
General	Prepare surfaces as specified in this Section and as follows.		
Ferrous Metal	Bare surfaces: SSPC-SP5, White Metal Blast Cleaning. Shop primed surfaces: SSPC-SP7, Brush-Off Blast Cleaning. Damaged primer or rust: SSPC-SP5, White Metal Blast Cleaning and spot prime.		
Surface Profile			
Ferrous Metal	2.0 to 2.5 mils		
Primed surfaces	1.0 to 1.5 mils on the intact primer.		
System Thickness (Dry Film)			
Total	16 to 25 mils		
Application			
Special CTR Training	Required.		

Attachment B			
Coating Detail Sheet			
Coating System	EPX-M-6-BG		
Coating Material	Epoxy		
Substrate	Metal		
Products: One of the following or equal:	Primer	Intermediate Coat	Finish Coat
Carboline	Carboguard 890	Carboguard 890	Carboguard 890
International Paint	Bar-Rust 236	Bar-Rust 236	Bar-Rust 236
PPG	Amerlock 2/400 Series	Amerlock 2/400 Series	Amerlock 2/400 Series
Sherwin Williams	Tank Clad HS	Tank Clad HS	Tank Clad HS
Tnemec	Series 69	Series 69	Series 69
Service Condition	Below grade in contact with soil.		
Surface Preparation			
General	Prepare surfaces as specified in this Section and as follows.		
Ferrous Metal	SSPC-SP10, Near White Metal Blast Cleaning.		
Nonferrous Metal	SSPC-SP16, Brush-Off Blast Cleaning.		
Galvanized Metal	SSPC-SP16, Brush-Off Blast Cleaning.		
Surface Profile			
Ferrous Metal	2.5 to 3.0 mils		
Nonferrous Metal	1.5 to 2.0 mils		
Galvanized Metal	1.5 to 2.0 mils		
System Thickness (Dry Film)			
Total	16 mils		
Primer	4 to 6 mils		
Intermediate Coat	4 to 6 mils		
Finish Coat	4 to 6 mils		
Application			
General	Fill all bugholes with a filler/surfacer compatible with the coating.		
Special CTR Training	Not required.		

Attachment B			
Coating Detail Sheet			
Coating System	VE-C-1		
Coating Material	Vinyl Ester - fiber reinforced with flexible basecoat		
Substrate	Concrete		
Products: One of the following or equal:	Primer	Intermediate Coat	Finish Coat
International Paint	Manufacturer's recommended	Ceilcote Flakeline 232.	Ceilcote Flakeline 232.
PPG	Manufacturer's recommended	Nova Rez 370	Nova Rez 370
Sherwin Williams	Manufacturer's recommended	CorCote VEN	CorCote VEN
Tnemec	Manufacturer's recommended	Series 252 SC	Series 252 SC
Service Condition	Immersed, non-immersed, very corrosive environment, color not required, new or existing construction. Primary or secondary containment indoors or exterior. Provide flexible base coat and fiberglass reinforcing to bridge concrete cracks up to 50 mils.		
General	Prepare surfaces as specified in this Section and as follows.		
Concrete	Apply flexible complete parge coat over all concrete surfaces after surface preparation is accepted. Completely fill all bugholes with the same material. Brush blast clean, if parge coat is non-polymer modified, after adequate cure per CSM's instructions to produce a uniform anchor pattern. Let concrete substrate cure under warm conditions (minimum of 75 degrees F) for at least 5 days before coating application if using wet abrasive or water jet surface preparation. Sawcut 1/4" minimum deep groove and provide coating termination and transition details as shown on the drawings and in accordance with CSM's standard details including terminations, transitions at corners, cracks, pipe penetrations, terminations at metal embedments, and other details. Vacuum all surfaces to be coated after surface preparation and curing to remove all loose dirt, dust, or other loose materials.		
Existing Coated Concrete	Prepare as for new concrete. Apply a skim coat of a surfacer or filler material to restore the substrate to a coatable condition.		
Surface Profile			
Concrete	ICRI CSP 5.		
Existing Coated Concrete	ICRI CSP 5.		
System Thickness (Dry Film)			
Parge Coat	Completely cover the substrate with flexible parge coat above filled voids by 1/8 inch (125 mils) of thickness.		
Total	60 to 65 mils in addition to the parge coat.		
Primer	Per CSM's recommendations.		
Intermediate Coat	25 to 30 mils with 1.5 oz fiberglass cloth. Saturate fiberglass and roll flat with a wet ribbed roller. Sand all seams flat and remove protruding fiberglass strands.		
Finish Coat	25 to 30 mils. Broadcast 20 to 40 mesh silica sand or aluminum oxide into the wet finish coat to saturation. Remove excess with stiff bristle broom after curing.		
Application			
General	Trowel-apply surfacers or filler materials CSM's recommendations. Work surfacer/filler into all voids to displace air and fill bugholes.		
Special CTR Training	Required.		

Attachment B			
Coating Detail Sheet			
Coating System	ACR-PVC-1		
Coating Material	Acrylic		
Substrate	PVC and CPVC pipe		
Products: One of the following or equal:	Primer	Intermediate Coat	Finish Coat
Carboline	Carbocrylic 120	None Applied	Carbocrylic 3359
International Paint	Devcryl 1440	None Applied	Devcryl 1448
PPG	Pitt Tech Primer	None Applied	Pitt Tech
Sherwin Williams	Sher Cryl HPA	None Applied	Sher Cryl HPA
Tnemec	Series 1028 or 1029	None Applied	Series 1028 or 1029
Service Condition	Exterior, exposed to direct sunlight, non-immersed.		
Surface Preparation	Prepare surfaces as specified in this Section and as follows.		
General	Clean to remove loose dirt, dust, or other contaminants. Sand surfaces to achieve a uniform, roughened surface profile. Solvent clean and vacuum to remove loose debris.		
Surface Profile	1.5 to 2.0 mils		
System Thickness (Dry Film)			
Total	4 to 8 mils		
Primer	2 to 4 mils		
Finish Coat	2 to 4 mils		
Application			
Special CTR Training	Not required.		



JORDAN VALLEY WATER TREATMENT PLANT FILTER AND CHEMICAL UPGRADES
JORDAN VALLEY WATER CONSERVANCY DISTRICT
WEST JORDAN, UTAH

Bidder RFI Responses
May 22, 2025

No.	Question	Response
1	Paragraph 2.13 Mix/Age Tank: Paragraph 2.13.A States the tanks shall be vertically oriented with a diameter of 8' and a sidewall height of 6 feet. Paragraph 2.13.B States the tanks shall be on Force Flow Procell load cells per Section 17622. Paragraph 2.13.C States Mix tank shall be constructed of fiberglass and shall be cylindrical, sloped flat, open top. Being the tank is 8' diameter and located on Procell load cells it will be required to have a Dish/Dome bottom with 4 FRP legs, not a cylindrical slope flat bottom design. Note 8' foot Platform scales are not commercially available. Please review and confirm that Dish/Dome bottom with 4 FRP legs is acceptable.	The scales under the PEA aging/mix tanks have been removed from the project, see Addendum 4. Tanks should remain cylindrical, sloped flat, open top per Specification 11256 and conform to the anchor requirements outlined in 13206A 1.03.B. Other scales on the project should remain and must conform to the seismic anchorage requirements outlined in Specification 17622 1.03.D.
2	Paragraph 1.01.D.3 – This paragraph references as specified in Section 13206A - Fiberglass Reinforced Plastic. Upon review of section 13206A – Fiberglass Reinforced Plastic Tanks there appears to be no specific details for the Polymer Mix/age tanks, only other chemicals. Please review and confirm if this section 13206A pertains to the polymer mix /age tanks or if the Polymer Blending and Feed equipment supplier shall provide their design standard for the application.	Specification 13206A has been updated to include details for the Polymer Mix/age tanks in this addendum.
3	Spec 16130 3.03 A 17 a 1 states to install all underground conduit in concrete-reinforced duct bank as specified in 16133. 16133 2.02 C states to provide reinforced concrete duct banks unless otherwise indicated on the drawings. These conduits can be PVC Sch 40 per 16130 3.03 E 2. Every electrical site plan (01E02 - 01E06) that shows duct bank is labeled as typical detail EM015 which is direct buried, sand encased conduit, not concrete reinforced. Spec 16130 3.03 E 3 states that direct buried and sand-bedded duct bank conduits are to be PCS conduit. That's a lot of large diameter PCS conduit. Please confirm that all duct banks on the site drawings are to be a direct buried duct banks per detail EM015 with PVC coated rigid conduit per the specs. If so, does 16130 I 2 for expansion/deflection fittings for straight runs of 200' of metallic conduit apply to direct buried PCS conduit	Refer to Addendum 2. New duct banks are to be pea-gravel bedded duct banks. Duct banks are to be concrete capped unless otherwise indicated. Per specification 16130 3.03 E.4, conduits in these duct banks are to be PVC40.
4	We request access to the 3D files in Navisworks. We would sign a waiver acknowledging that they are not part of the contract documents and are not to be relied upon for bidding purposes.	A link has been provided to download the 3D files. A waiver must be signed acknowledgings tha they are not part of the contract documents and are not to be relied upon for bidding purposes to access the file.
5	Can new wiring be routed on existing cable trays?	New wiring may be routed on existing cable trays provided that NEC requirements are met.
6	Drawing 63E08 shows LCP's 6391 and 6392. These LCP's do not appear in the P&ID's. Please provide additional information.	LCP-6391 and LCP-6392 will be removed by a markup.
7	Drawing 65E03 shows LCP 6560. This LCP does not appear in the P&ID's. Please provide additional information.	This will be addressed by a markup.
8	Drawing 63E06 shows LCP's 6554, 6555 and 6556. These LCP's do not appear in the P&ID's. Please provide additional information.	Engineer assumes that the bidder meant drawing 65E06. LCPs will be addressed by a markup.
9	P&ID 71N01 shows LCP 7100. This LCP appears in the layout drawings on 71E01 as well as 69E02. Please clarify.	The LCP-7100 shown on drawing 69E02 is the correct location. Conduit tags and destinations will be clarified with markups.
10	AIT's 3131 and 3151 are shown on drawings 30E04 and 30E12. Please clarify.	AIT-3131 and AIT-3151 have been removed from drawing 30E04 and are only shown on drawings 30E12.
11	AIT's 3141 and 3161 are shown on drawings 30E04 and 30E16. Please clarify.	AIT-3141 and AIT-3161 have been removed from drawing 30E04 and are only shown on drawing 30E16.
12	LCP 3106 and AIT's 3101 and 3081 are show on drawings 30E05 and 30E17. Please clarify.	AITs -3111 and -3081 have been removed from Drawing 30E05 and are only shown on 30E17.
13	AIT's 3071, 3111, 3091 and 3121 are shown on drawings 30E05 and 30E13. Please clarify.	AITs -3071, -3091, -3111 and -3121 have been removed from Drawing 30E05. AITs -3071, -3091 and -3111 are only shown on drawing 30E13 and AIT-3121 is only shown on drawing 30E17
14	Typical Detail EM021 refers to Typical Detail EM001. This detail has not been provided. Please provide detail EM001.	Typical Detail EM021 should refer to EM015. This has been addressed by markup.
15	Tag # C-62-235 runs between the Primary Coagulant Building and the Chlorine Dioxide Building on sheet 01E03 but has not been included with the Conduit schedule. Please clarify the conduit size, conductors, and connections for this run.	Conduit C-62-235 on drawing 01E03 should be C-62-325.
16	There is some conflict in the drawings regarding the electrical disconnects for HVAC equipment. There are notes in the electrical drawings that state to connect power to the integral disconnect at the HVAC equipment, but the equipment schedules in the HVAC drawings state that the electrical contractor is to provide the disconnect. EF-6357 & SF-6368 (00GH02 & 63E11) are some examples. Please clarify whose scope the disconnects fall under to avoid scope gaps or double coverage.	HVAC manufacturer to provide electrical disconnects for HVAC equipment.
17	For the existing panels in the filter building (PP-1 thru PP-8) is the intent to reuse the existing circuit breakers, or are we to supply new circuit breakers?	The intent is to reuse the existing circuit breakers.
18	Are there any ISA data sheets for weigh scales WE6301 through WE6320?	Weigh scales are vendor supplied and as such do not come with ISA data sheets.
19	Can the filter media specification (13226) be relaxed as follows: • The Hardgrove Grindability would need to be < 45 in lieu of < 38. • The Specific Gravity needs to be > 1.6 in lieu of 1.4- 1.7. • Particle Diameter 2.0 mm to be < 1% greater than 2.00 mm and Particle Diameter .65 mm to be < 1% less than .65 mm.	These criteria are not acceptable. Contractor shall supply filter media as indicated in specification 13226 Filter Media. As indicated in 13226.1.04.D.3, media received at the project site that does not meet the specified requirements, certified test results, or acceptance criteria may be rejected at the sole discretion of the Engineer and shall be replaced with approved media at no additional cost to the Owner.
20	Filter media requires a lot of storage space, since you cannot stack pallets, is that something there is a contingency for?	Filter media may be stored on-site, within the Contractors allocated staging area or off-site in a secure facility acceptable to the Owner as indicated in the general conditions and amended by Addendum 2. Storage conditions shall be as specified, including off the ground, protected from weather and covered to prevent contamination. Storage space within existing plant facilities is not generally available and should not be relied upon by the Contractor. The Contractor is also reminded that storage of super sacks outside may cause premature failure due to UV degradation. Per 132263.02.B.1 any filter media which has become contaminated, either before or after placement, shall be removed and replaced.
21	Are hold down straps required for extra storage roller trunnions, or only on scales that have in operation ton containers?	Please provide hold down straps for each trunnion and scale, totaling 68, per the drawings.
22	Regarding question and response #3 from Addendum 1. Will the cost for the Herriman City Building permit be negotiated and covered by JVVCD?	Per General Conditions 6.06, the contractor will be responsible for all permitting costs.
23	What is the status of the plan review process for the Herriman City Building Permit?	Plan review occurs during the permit application process.
24	On sheet 41S05/AC Section, it references detail 4/41S04 for the over-excavation and bedding requirement under the Backwash Tank Vault. This detail 4 on sheet 41S04 shows roughly a 10' over-excavation with a Membrane Liner to 10' around the perimeter, ~10' of ABC bedding to 10' around the perimeter, 4" Perforated Drain Pipe/Leak Detection 5' around the perimeter, a Capillary Barrier under the structural concrete, and sloped up to from subgrade to existing grade. Will you clarify this is the extent you want bedded under this vault? This would make the over-excavated nearly 30' deep and put the sloping well past the limits of excavation shown on the	This issue has been addressed by markup in addendum #2. This now references detail 3 on 00GS02.
25	Specification 02050-2.02-B describes what requirements the "Native Soil Select" must meet, specifically fines between 5% and 15%, Liquid Limit less than 20, Plasticity Index of less than 10, and Resistivity a minimum of 5,000 ohm-cm. In the Geotechnical Report, Table 5 on page 16 of 36, it shows the Resistivity of these materials be far less than the required 5,000 ohm-cm (aside from a 2.5' section of B-01). Also in the Laboratory Results section, Minimum Laboratory Soil Resistivity, pH of Soil for Use in Corrosion Testing, and Ions in Water by Chemically Suppressed Ion Chromatography it shows the Resistivity of most of the materials tested from the bore holes to be well below the 5,000 ohm-cm requirements laid out in Specification 02050-2.02-B. In the Laboratory Results section, Liquid Limit, Plastic Limit, and Plasticity Index of Soils for each bore hole shows we are with almost double the Liquid Limit allowed per Specification 02050-2.02-B. In the Geotechnical Report, section 7.1.5 it states the "soils are considered suitable or practical for reuse onsite as grading or structural fill."Will you please clarify, based on the low resistivity and higher Liquid Limits shown in the soils report, if these materials are suitable, or based on these factors, if they are actually not suitable as the Geotechnical report states? This would require a significant export/import on this project if they are in fact, not suitable.	The soil resistivity requirement has been removed in addendum #2. Laboratory results for the soil borings apply specifically to layers of the profile that contain small enough particles to warrant testing (i.e. clay layers). These clay lenses in the soil profile do not meet liquid limit criteria for native select fill and should be set aside during excavation. The rest of the native soil is suitable for use as fill material, as stated in the geotechnical report. Furthermore, borrow material from the area west of the drainage ditch are subject to engineer approval as stated in specification section 2300 3.03 A, and will require testing to ensure that it also meets these requirements.
26	On Drawing 65M04 Sections G & H the 3" CD line is shown as PVC in one section and CPVC in the other. Please clarify.	The CD lines should all be CPVC in the Caustic Soda Building. This has been updated in Addendum 4.
27	On Drawing 65M04 detail F the vapor seal and overflow piping are called out as PVC, please confirm material types for these chemicals are suitable for PVC.	Vapor seal shall be PVC per detail MC106, but overflow piping in the Caustic Soda Building should be CPVC. This has been updated in Addendum 4.
28	On Drawing 69M03 do the vent and fill lines from the PES tanks need to transition to steel outside the building?	No, they should remain PVC. However, they should be painted to protect from sunlight exposure. This has been updated in Addendum 4.

29	Sample panel detail on 30M17 shows a rotameter dedicated to each of the 2 instruments, this does not match with the P&ID shown on 30N03 which has a single rotameter with both instruments in series after the meter. Please provide guidance to which is right and if the correct number of rotameters is captured in the specification list of instruments.	The P&ID is correct, showing a single rotameter with integrated flow switch per filter (i.e., one per pair of instruments). The number of rotameters is correctly captured in the list of instruments. A note has been added to 30M17 as part of Addendum 4.
30	On sheet 30M13 there is a typical callout for a 30" filter backwash isolation valve. Should this be a 36"?	The typical callout for the filter backwash isolation valve on 30M13 should be 36". The backwash isolation valves for Filters 1-6 are 36", whereas the backwash isolation valves for Filters 7-16 are 30". The typical callout on 30M13 has been updated as part of Addendum 4.
31	There is a Tag #C-62-2235 that runs between the primary coagulant building and the chlorine dioxide building on Sheet 01E03 but has not been but has not been included in the conduit schedule. Please clarify conduit size, conductors, and connections for this run.	Conduit C-62-235 on drawing 01E03 should be C-62-325.
32	Addendum 2 downsized the generator to 200KW. The specification for the generator is requiring a Dual Fuel Natural Gas / Propane unit with automatic switchover. Caterpillar does not offer a product that does dual fuel in this size range. Additionally, Caterpillar has only one dual fuel offering but it is in the 450KW size range. Would it be acceptable for Caterpillar to quote a 200KW natural gas generator without the dual fuel option?	Yes, a natural gas only generator will be acceptable. Specification language has been adjusted to allow this.