



PROVO WATER RECLAMATION FACILITY PHASE 1 PACKAGE 2 2020 CONSTRUCTION

VOLUME 2

FOR CONSTRUCTION: PHASE 1, ELECTRICAL UPGRADES PACKAGE A: PRIMARY SLUDGE PUMP STATION NO. 2 S2 RE-FEED FEBRUARY 2025

PROVO CITY

MAYOR

MICHELLE KAUFUSI

CITY COUNCIL


KATRICE MACKAY
GARY GARRETT
CRAIG CHRISTENSEN
GEORGE HANDLEY
BECKY BOGDIN
TRAVIS HOBAN
RACHEL WHIPPLE

CITY STAFF




GORDON HAIGHT - PUBLIC WORKS DIRECTOR
GARY CALDER, PE - WATER RESOURCES DIRECTOR
DAVID TORGENSEN, PE - PROJECT MANAGER

DESIGN TEAM

JOHN MATTA PE, PRINCIPAL - WATER WORKS ENGINEERS
JENNY CALDERON PE, PROJECT MANAGER - WATER WORKS ENGINEERS

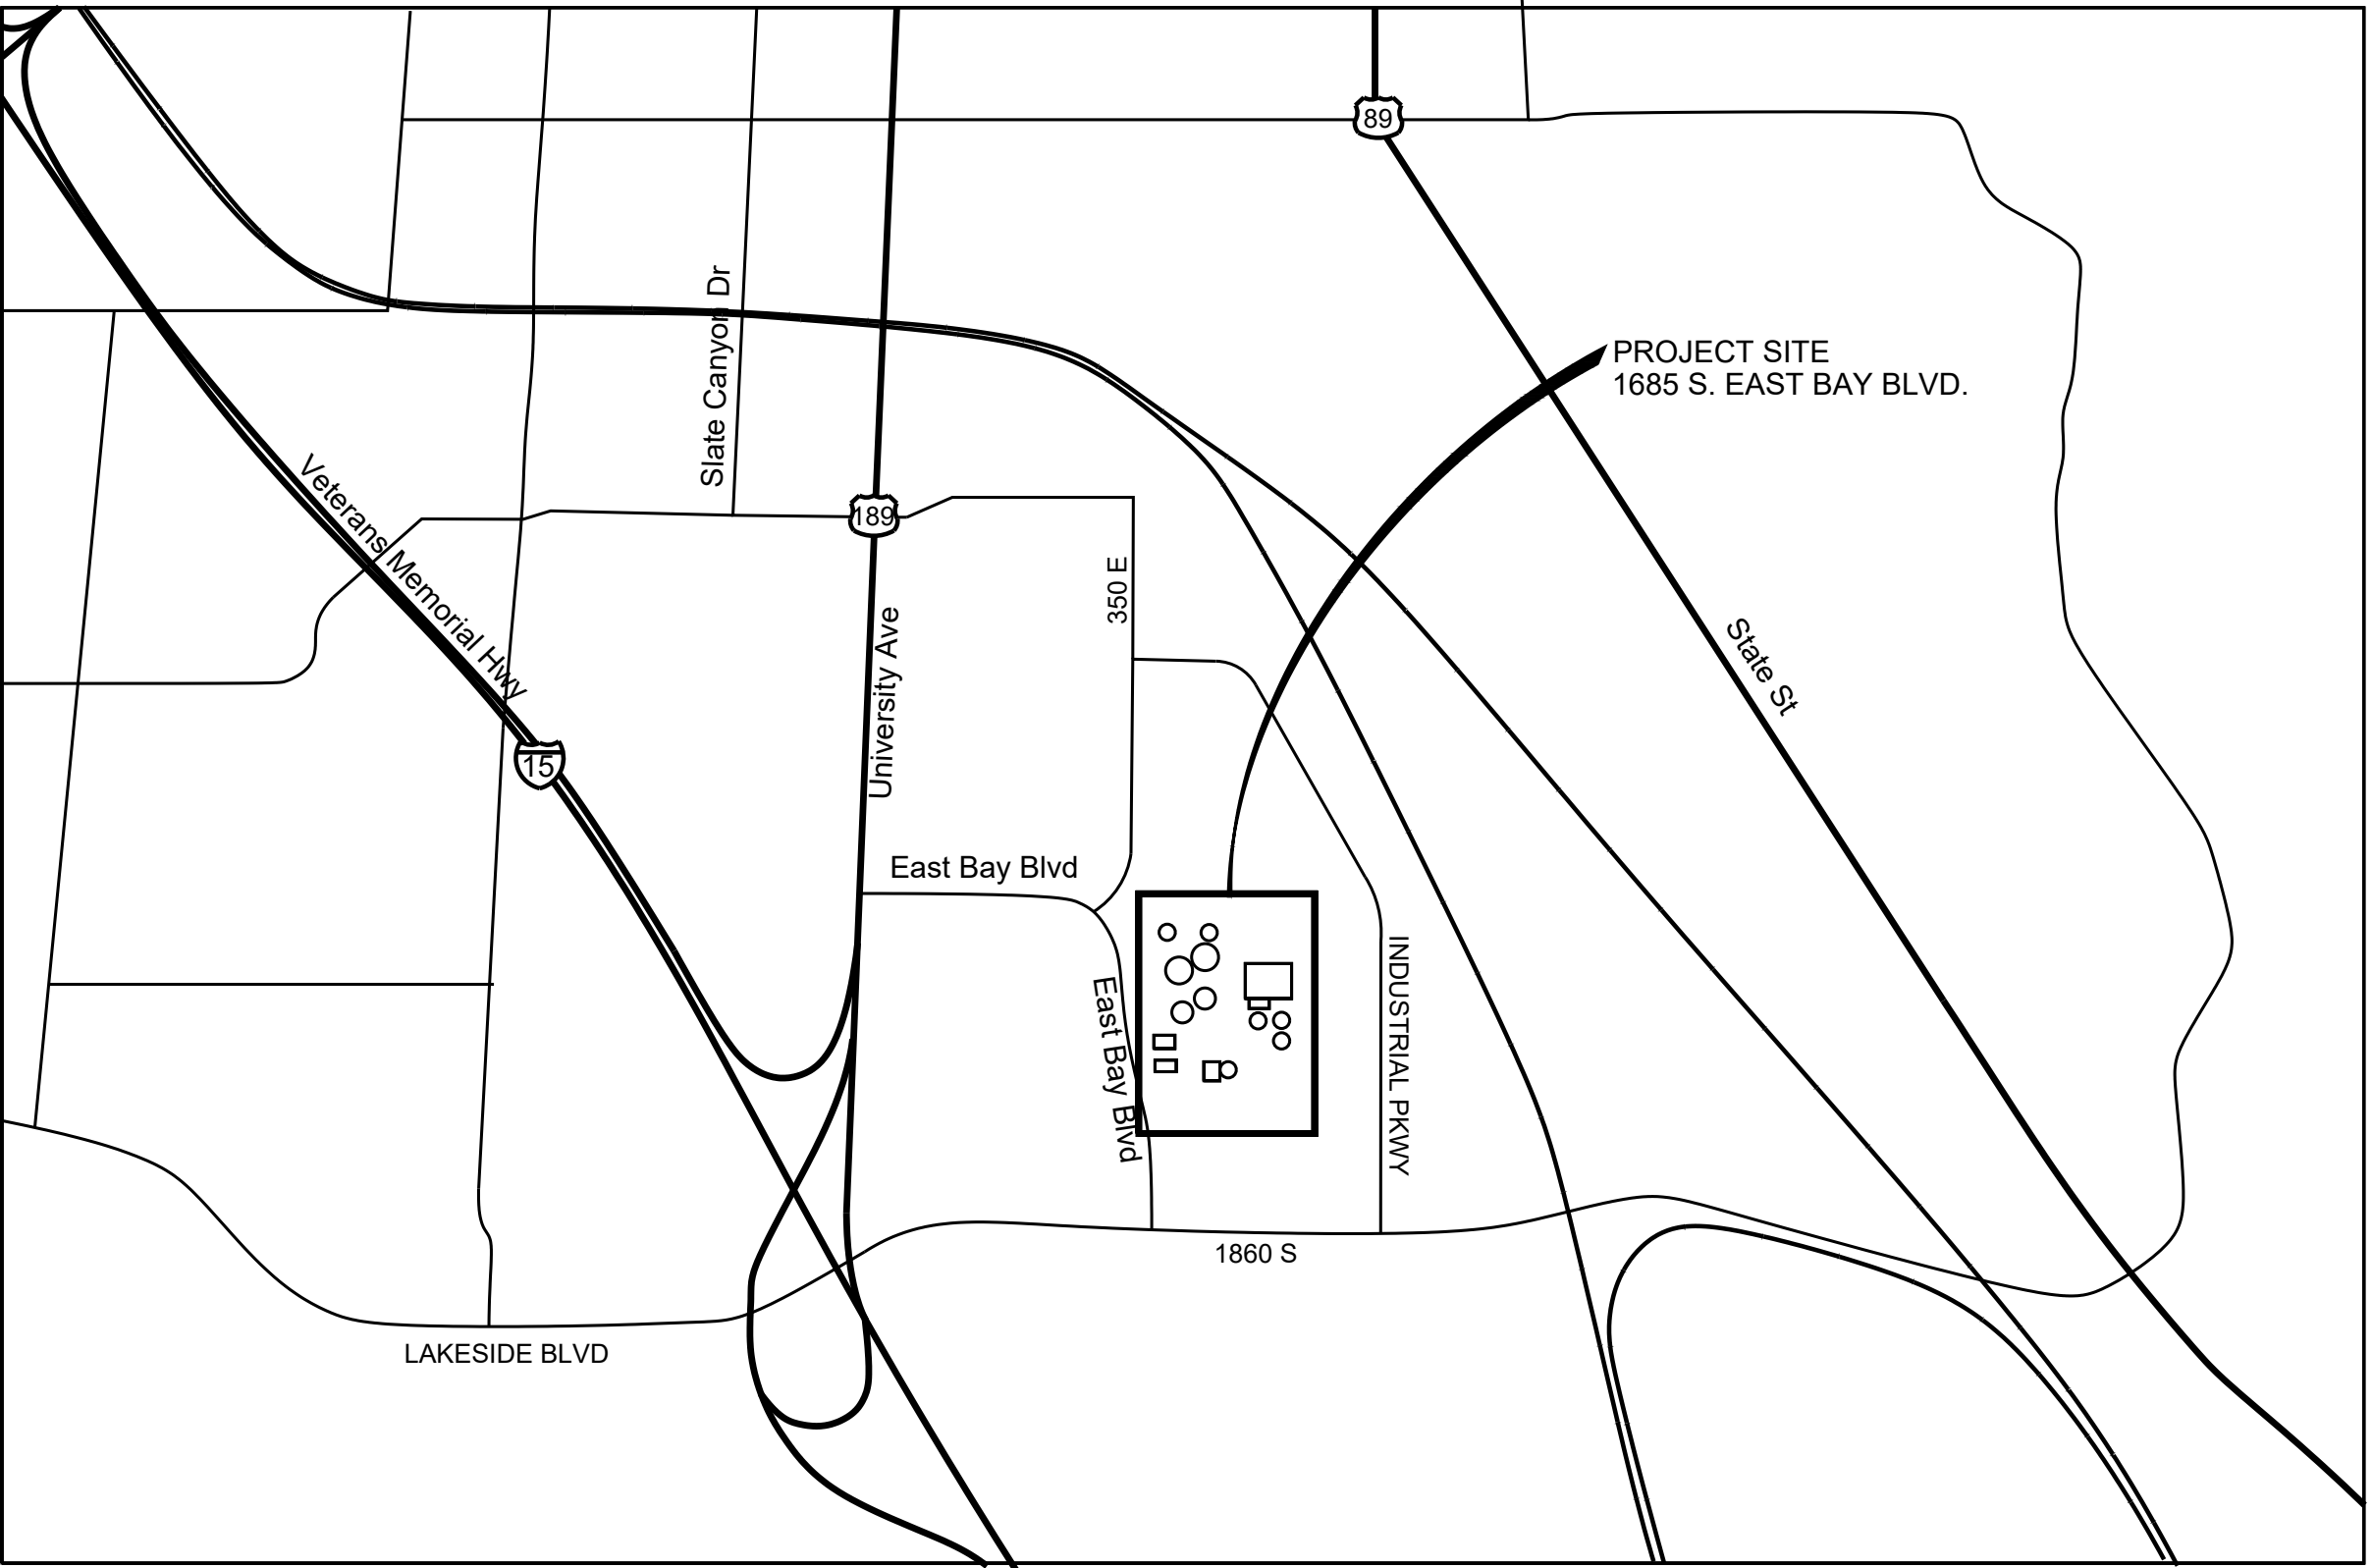

LOCATION MAP
NTS

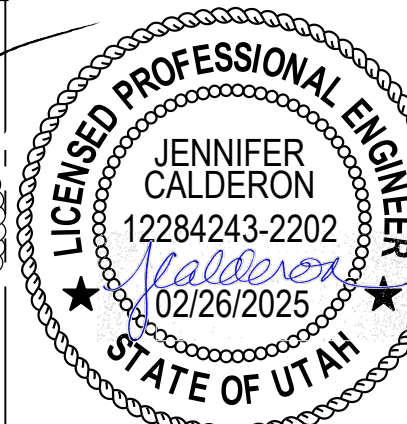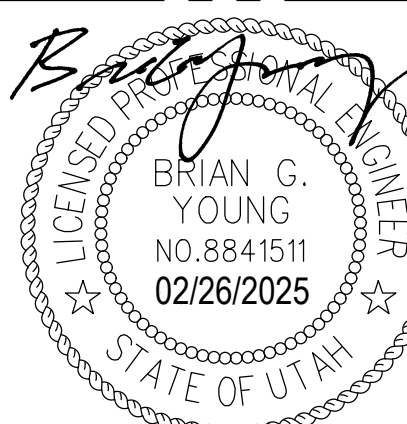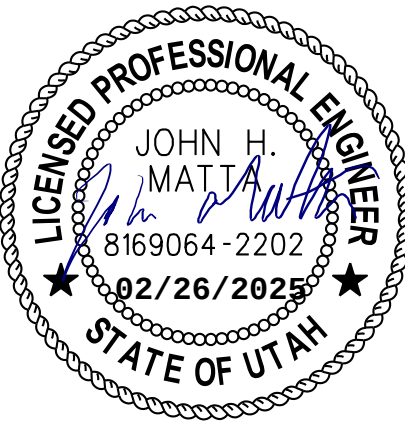


NO.	DATE	REVISION	BY	APVD

[illegible]

ABBREVIATIONS

@	AT	CL	CENTERLINE	°F	DEGREE FAHRENHEIT			PROP	PROPERTY	SYMM	SYMMETRICAL
AB	ANCHOR BOLT, AGGREGATE BASE	CLDIP	CEMENT-LINED DUCTILE IRON PIPE	FB	FLAT BAR	JT	JOINT	PRV	PRESSURE RELEASE VALVE		
AC	ASPHALTIC CONCRETE	CLG	CEILING	FC	FLEXIBLE COUPLING			PS	PUMP STATION	T	TANGENT, TELEPHONE LINE, TOP
ACI	AMERICAN CONCRETE INSTITUTE	CLR	CLEAR, CLEARANCE	FCA	FLANGED COUPLING ADAPTER	KIP	THOUSAND POUNDS	PSF	POUNDS PER SQUARE FOOT	t, T	THICKNESS
ADD	ADDITIONAL	CLSM	CONTROLLED LOW STRENGTH MATERIAL	FCO	FLOOR CLEAN OUT	KW	KILOWATT	PSI	POUNDS PER SQUARE INCH	T&B	TOP AND BOTTOM
ADH AB	ADHESIVE ANCHOR BOLT	CML, CSP	CONCRETE MORTAR LINED AND COATED	FD	FLOOR DRAIN			PSIG	POUNDS PER SQUARE INCH, GAUGE	T&G	TONGUE AND GROOVE
ADJ	ADJACENT, ADJUSTABLE		STEEL PIPE	FDA	FLOOR DRAIN W/INTEGRAL TRAP	L	LEFT, ANGLE, LENGTH	PT	POINT OF TANGENCY	TBG	TUBING
AFF	ABOVE FINISH FLOOR	CMLSP	CEMENT MORTAR LINED STEEL PIPE	FDN	FOUNDATION	LAB	LABORATORY	P.U.E.	PUBLIC UTILITY EASEMENT	TC	TOP OF CONCRETE
AFG	ABOVE FINISH GRADE	CMP	CORRUGATED METAL PIPE	FDV	FILTER DRAIN VALVE	LAT'L	LATERAL	PV	PLUG VALVE	TCE	TEMPORARY CONSTRUCTION EASEMENT
AHP	AIR: HIGH PRESSURE	CMU	CONCRETE MASONRY UNIT	FES	FLARED END SECTION	LB	POUNDS	PVC	POLYVINYL CHLORIDE PLASTIC \ POINT OF	TDH	TOTAL DYNAMIC HEAD
AIR	COMPRESSED AIR	CO	CLEANOUT	FEXT	FIRE EXTINGUISHER	LB/CU FT	POUNDS PER CUBIC FOOT		VERTICAL CURVE	TECH	TECHNICAL
AISC	AMERICAN INSTITUTE OF STEEL	COL	COLUMN	FF	FINISH FLOOR	LF	LINEAR FEET	PVCGS	POLYVINYL CHLORIDE PLASTIC-GRAVITY	TEL	TELEPHONE
	CONSTRUCTION	COM	COMMUNICATION	FG	FINISH GRADE, FLUE GAS	LG	LONG		SEWER TYPE	TEMP	TEMPORARY, TEMPERATURE
AL	ALUMINUM SULFATE	COMB	COMBINED	FHY	FIRE HYDRANT	LONG	LONGITUDINAL	PVCW	POLYVINYL CHLORIDE PLASTIC-	TF	TOP FACE
ALP	AIR LOW PRESSURE	CONC	CONCRETE	FI	FLOW INDICATOR	LP	LOW POINT		WATER DISTRIBUTION SERVICE TYPE	THD	THREAD
ALTN	ALTERNATE	CONN	CONNECTION	FIG	FIGURE	LR	LONG RADIUS	PVI	POINT OF VERTICAL INTERSECTION	THK	THICK
AMH	AMMONIUM HYDROXIDE	CONT	CONTINUOUS, CONTINUATION	FIL	FILTRATE	LS	LOW PRESSURE STREAM	PVMT	PAVEMENT	TNK	TANK
ANSI	AMERICAN NATIONAL STANDARDS	COORD	COORDINATE	FL	FLOOR, FLOW LINE			PVT	POINT OF VERTICAL TANGENCY, PRIVATE	TOB	TOP OF BAFFLE
	INSTITUTE	CPLG	COUPLING	FLG	FLANGE	MAX	MAXIMUM			TOC	TOP OF CURB
APPROX	APPROXIMATE	CTR'D, CTD	CENTERED	FLH	FLAT HEAD	MCC	MOTOR CONTROL CENTER	R, RAD	RADIUS	TG	TOP OF GRATING
APVD	APPROVED	CTR	CENTER	FLI	FLOW LINE	MCJ	MASONRY CONTROL JOINT	RC	REINFORCED CONCRETE	TOW	TOP OF WALL
APWA	AMERICAN PUBLIC WORKS ASSOCIATION	CU	COPPER	FLTR	FILTER	MECH	MECHANICAL	RCP	REINFORCED CONCRETE PIPE	TP	TURNING POINT, TEST PIT
AR	AERATION	CU FT	CUBIC FOOT	FM	FLOW METER	MFR	MANUFACTURER	RD	ROAD, ROOF DRAIN	TRANS	TRANSITION
ARCH, A	ARCHITECTURAL	CU IN	CUBIC INCH	FNSH	FINISH	MGD	MILLION GALLONS PER DAY	RDCR	REDUCER	TRANSV	TRANSVERSE
ARV	AIR RELEASE VALVE	CU YD	CUBIC YARD	FO	FUEL OIL	MH	MANHOLE	REF	REFER OR REFERENCE	TS	TUBE STEEL
ASTM	AMERICAN SOCIETY FOR TESTING AND	CULV	CULVERT	FOC	FACE OF CONCRETE	MIN	MINIMUM, MINUTE	REINF	REINFORCED, REINFORCING, REINFORCE	TST	TOP OF STEEL
	MATERIALS	CV	CHECK VALVE	FRP	FIBERGLASS REINFORCED PLASTIC	MISC	MISCELLANEOUS	REQD	REQUIRED	TT	THRUST TIE
AUTO	AUTOMATIC	CW	CIRCULATING WATER	FSPS	FINE SCREEN PUMP STATION	MJ	MECHANICAL JOINT	RJ	RESTRAINED JOINT	TW	TREATED GROUND WATER
AUX	AUXILIARY			FT	FOOT OR FEET	MOV	MOTOR OPERATED VALVE	RLS	RUBBER LINED STEEL	TWS	TRACER WIRE STATION
AV	AIR/VACUUM ASSEMBLY	D	PENNY	FTG	FOOTING	MPH	MILES PER HOUR	RM	ROOM	TYP	TYPICAL
AVE	AVENUE	DBA	DEFORMED BAR ANCHOR	FWD	FORWARD	MSNRY	MASONRY	RMJ	RESTRAINED MECHANICAL JOINT		
AWG	AMERICAN WIRE GAGE	DBL	DOUBLE			MSP	MILL STEEL PIPE, MANUAL OF STANDARD	RNG	RENEWABLE NATURAL GAS	UBC	UNIFORM BUILDING CODE
AWWA	AMERICAN WATER WORKS ASSOCIATION	DEC	DECANT	G	GAS			RO	ROUGH OPENING OR	UD	UNDERDRAIN
AX	ANOXIC	DET	DETAIL	GA	GAGE	MT	MEMBRANE TANKS		REVERSE OSMOSIS	UG	UNDERGROUND
		DI	DROP INLET, DUCTILE IRON	GALV	GALVANIZED	MTL	MATERIAL	RP	RADIUS POINT	UH	UNIT HEATER
B	BORING	DIA	DIAMETER	GB	GRADE BREAK	MV	MUD VALVE	R/R	REMOVE AND REPLACE	UNK	UNKNOWN
BAV	BALL VALVE	DIAG	DIAGONAL	GC	GROOVED COUPLING	MW	MAKE UP WATER	RST	REINFORCING STEEL	UNO	UNLESS NOTED OTHERWISE
BC	BEGIN CURVE, BOTTOM OF CURB	DIL	DILUTE	GCF	GROOVED COUPLING FITTING	MWS	MAXIMUM WATER SURFACE	RT	RIGHT		
BD	BLOW DOWN	DIM	DIMENSION	GCO	GRADE CLEAN OUT	N	NORTH	RTN	RETURN WATER	V	VENT, VOLT, VALVE
BDP	BACKDRAFT DAMPER	DIMJ	DUCTILE IRON MECHANICAL JOINT	GD	GENERAL DRAINAGE	NC	NORMALLY CLOSED	RV	ROOF VENT	VAC	VACUUM
BF	BLIND FLANGE, BOTTOM FACE	DIP	DUCTILE IRON PIPE	GE	GROOVED END	NE	NORTHEAST	RW	RAW WATER	VDP	VOLUME DAMPER
BFD	BUTTERFLY VALVE DAMPER	DIPPL	DUCTILE IRON PIPE, POLYETHYLENE	GL	GLASS	NG	NATURAL GAS	R/W	RIGHT-OF-WAY	VAR	VENT ACID RESISTANT
BFP	BACKFLOW PREVENTER ASSEMBLY		LINED	GPD	GALLONS PER DAY	NH3	AMMONIA			VC	VERTICAL CURVE
BFV	BUTTERFLY VALVE	DIR	DIRECTION	GPH	GALLONS PER HOUR	NIC	NOT IN CONTRACT	S	I-BEAM, SOUTH, SLOPE	VERT	VERTICAL
BLDG	BUILDING	DIST	DISTANCE	GPM	GALLONS PER MINUTE	NO.	NUMBER, NUMBERING	S =	SLOPE EQUALS	VM	VM VALVE MODULE
BLM	BUREAU OF LAND MANAGEMENT	DN	DOWN	GRTG	GRATING	NPT	NATIONAL PIPE THREAD	SA	SERVICE AIR	VPI	VERTICAL POINT OF INTERSECTION
BM	BENCH MARK, BEAM	DO	DITTO	GSP	GALVANIZED STEEL PIPE	NPW	NON POTABLE WATER	SAT	SUSPENDE ACOUSTIC TILE	VPS	VENEER PLASTER SYSTEM
BO	BLOW OFF	DR	DRAIN	GT	GAS TURBINE	NTS	NOT TO SCALE	SCFH	STANDARD CUBIC FEET PER HOUR	VTR	VENT THRU ROOF
BOC	BACK OF CURB	DWG	DRAWING	GV	GATE VALVE	NW	NORTHWEST	SCFM	STANDARD CUBIC FEET PER MINUTE		
BOO	BOTTOM OF OPENING			GVL	GRAVEL			SCH	SCHEDULE	W/	WITH
BOG	BACK OF GUTTER	E	EAST, ELECTRIC, ELECTRICAL	GW	GROUND WATER			SE	SOUTHEAST	W	WIDE FLANGE (BEAM), WEST, WATER
BOT	BOTTOM	EA	EACH			OC	ON CENTER, ODOR CONTROL	SEC	SECONDARY	WATRR	WATER ADVANCED TREATMENT AND
BRG	BEARING	EC	END CURVE	HB	HOSE BIB	OD	OUTSIDE DIAMETER, OVERFLOW DRAIN	SECT	SECTION		RESOURCE RECOVERY
BWI	BACKWASH IN	ECC	ECCENTRIC	HD	HUB DRAIN	OF	OUTSIDE FACE	SH	SHEET	WC	WATER CLOSET
BWO	BACKWASH OUT	EF	EACH FACE, EXHAUST FAN	HDR	HEADER	OFR	OVERFLOW RETURN	SHC	SODIUM HYPOCHLORITE	WD	WOOD
BYP	BYPASS	EFL	EFFLUENT	HDW	HARDWARE	OHE	OVERHEAD ELECTRIC	SLD	SLUDGE	WM	WATER METER
		EG	EXHAUST GAS	HF	HIGH PRESSURE FEEDWATER	OMRF	ORDINARY MOMENT RESISTING FRAME	SLG	SLIDE GATE	WR	WATER RESISTANT
°C	DEGREE CELSIUS	EJ	EXPANSION JOINT	HGT	HEIGHT	O TO O	OUT TO OUT	SLP	SLOPE	WS	WATER SURFACE, WATER STOP
C TO C, CC	CENTER TO CENTER	EL	ELEVATION	HM	HOLLOW METAL	OP	OPERATING	SMP	SAMPLE	W SH ST	WEATHERING SHEET STEEL
C	CHANNEL (BEAM)	ELB, ELL	ELBOW	HORIZ	HORIZONTAL	OPNG	OPENING	SOLN	SOLUTION	WSP	WELDED STEEL PIPE
CAA/ARV	COMBINATION AIR ADMISSION/	ELC	ELECTRICAL LOAD CENTER	HP	HIGH POINT, HORSEPOWER	OPP	OPPOSITE	SP	SPACE OR SPACES	WT	WATER TIGHT
	AIR RELEASE VALVE	ELEC	ELECTRIC, ELECTRICAL	HPS	HIGH PRESSURE STREAM	OZ	OUNCE	SPD	SUMP PUMP DRAIN	WTR	WATER
CARV	COMBINATION AIR RELEASE VALVE	EM	EMISSION MEASUREMENT	HR	HANDRAIL			SPEC	SPECIFICATIONS	WW	WASHWATER OR
CATH	CATHODIC PROTECTION	ENGR	ENGINEER	HSS	HOLLOW STRUCTURE STEEL	PC	POINT OF CURVE	SPLY	SUPPLY		WASTEWATER
CATV	CABLE TELEVISION	EO	EMERGENCY OVERFLOW	HV	HOSE VALVE	PE	PLAIN END, POLYETHYLENE OR	SQ	SQUARE	WWF	WELDED WIRE FABRIC
CB	CATCH BASIN	EP	EDGE OF PAVEMENT	HWY	HIGHWAY		PERMANENT EASEMENT	SQ FT	SQUARE FOOT		
CCP	CONCRETE CYLINDER PIPE	EQL SP	EQUALLY SPACED	HYD	HYDRANT	PENT	PENETRATION	SQ IN	SQUARE INCH	YD	YARD
CCS	CENTRAL CONTROL SYSTEM	EQPT	EQUIPMENT			PI	POINT OF INTERSECTION		SAMPLING SYSTEM	YH	YARD HYDRANT
CE	CONDENSATE	ERW	EFFLUENT REUSE WATER			PJF	PREMOLDED JOINT FILLER	SSH	SAFETY SHOWER		
CF	CUBIC FEET	ESA	ENVIRONMENTALLY SENSITIVE AREA	IA	INSTRUMENT AIR	PL	PLATE, PROPERTY LINE	SST	STAINLESS STEEL		
CFM	CUBIC FEET PER MINUTE	ESC	EROSION SEDIMENT CONTROL	ID	INSIDE DIAMETER	PLYWD	PLYWOOD	ST	SAMPLE TAP		
CFS	CUBIC FEET PER SECOND	ESEW	EMERGENCY SHOWER/EYE WASH	IF	INSIDE FACE	PLV	PLUG VALVE	STA	STATION		
CHEM	CHEMICAL	EVC	END OF VERTICAL CURVE	IMLR	INTERNAL MIXED LIQUOR RETURN	POB	POINT OF BEGINNING	STD	STANDARD		
CI	CAST IRON	EW	EACH WAY	IN	INCH	POC	POINT OF CONNECTION	STIF	STIFFENER		
CIGC	CAST IRON GROOVED COUPLING	EWEF	EACH WAY, EACH FACE	INFL	INFLUENT	POE	POINT OF ENDING	STL	STEEL, STEEL PIPE		
CIMJ	CAST IRON MECHANICAL JOINT	EXC	EXCAVATE	INSTM	INSTRUMENTATION	PP, P&P	PLAN AND PROFILE, POWER POLE	STLS	STEEL PIPE (SPECIAL)		
CIP	CAST IRON PIPE	EXH	EXHAUST	INSUL	INSULATE, INSULATION	PPM	PARTS PER MILLION	STR	STRAIGHT		
CIRJ	CAST IRON RESTRAINED JOINT	EXP	EXPOSED, EXPANSION	INV	INVERT	PRC	POINT OF REVERSE CURVE	STRL	STRUCTURAL		
CISP	CAST IRON SOIL PIPE	EXP JT	EXPANSION JOINT	IP	IRON PIPE	PRCST	PRECAST	STRUCT	STRUCTURE		
CJ	CONSTRUCTION JOINT, CONTRACTION	EXST	EXISTING	IR	IRON ROD	PREFAB	PREFABRICATED	SUBFL	SUBFLOOR		
	JOINT			IW	INJECTION WATER	PRESS	PRESSURE	SUSP	SUSPEND		
CKV	CHECK VALVE					PRI	PRIMARY	SW	SERVICE WATER, SOUTHWEST		

NO.	DATE	REVISION	BY	APVD

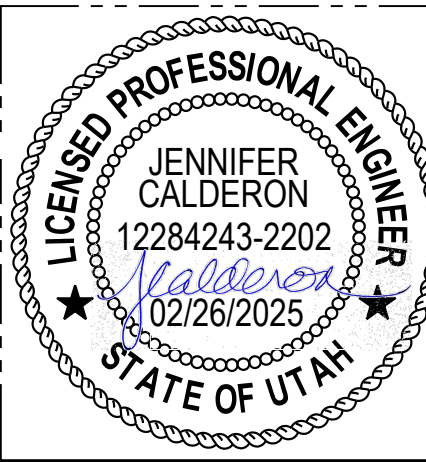

DRAWING NUMBER

DISCIPLINE

M-BC-101

DRAWING SERIES NUMBER

FACILITY DESIGNATION

DISCIPLINE

LETTER	DISCIPLINE
G	GENERAL
D	DEMOLITION
C	CIVIL
A	ARCHITECTURAL
S	STRUCTURAL
M	MECHANICAL
H	HEATING, VENTILATION AND COOLING
P	PLUMBING
E	ELECTRICAL
N	INSTRUMENTATION

FACILITY DESIGNATION

FACILITY	AREA
GENERAL	GN
CIVIL GRADING AND DRAINAGE	CD
YARD PIPING	YP
SITE ELECTRICAL	SE
EXISTING HEADWORKS	HW
EXISTING INFLUENT PUMP STATION	IP
EXISTING PRIMARY CLARIFIERS	EC
EXISTING PRIMARY SLUDGE PUMP STATION NO. 1	S1
EXISTING PRIMARY SLUDGE PUMP STATION NO. 2	S2
COARSE SCREENS & GRIT	CG
PRIMARY CLARIFIERS	PC
PRIMARY SLUDGE PUMP STATION	P1
EXISTING AERATION BASINS (AB)	EA
BIOREACTOR COMPLEX (INCLUDES THE FOLLOWING SUB-AREAS)	BC
FINE SCREEN PUMP STATION	FP
FINE SCREENS BUILDING	FS
BIOREACTORS	BR
MEMBRANE BUILDING	MB
EXISTING BLOWER BUILDING	EB
BLOWER BUILDING	BL
ODOR CONTROL BIOFILTER	OC
EQUALIZATION AND SURGE BASINS	EQ
EXISTING CHLORINE BUILDING	CB
EXISTING FILTER BUILDING	FB
EXISTING UV BUILDING	UV
PLANT LIFT STATION	LS
EXISTING PRIMARY DIGESTERS	1D
WASTE GAS BURNER	GS
EXISTING DAF THICKENER	DT
EXISTING SECONDARY DIGESTERS	2D
EXISTING SECONDARY SLUDGE PUMP STATION	P2
EXISTING DEWATERING BUILDING	DB
STRUVITE CONTROL	ST
POWER DISTRIBUTION BUILDING	PB
EXISTING POWER DISTRIBUTION BUILDING	PE
STANDBY GENERATORS	SG
NORTH LOAD CENTER BUILDING	L1
OPERATIONS BUILDING	OP
MAINTENANCE BUILDING	MN

DRAWING SERIES

NUMBER SERIES	DRAWING TYPE
000	GENERAL
100	PLANS
200	SECTIONS
300	DETAILS
400	ELEVATIONS/ISOMETRICS
500	SCHEMATICS
600	SCHEDULES AND P&IDs
700	DEMOLITION ELEVATIONS
800	POINT TABLES
900	NOT USED

NO.	DATE	REVISION	BY	APVD

PROCESS IDENTIFICATION

PROCESS	AREA
PLANT LIFT STATION	09
COARSE SCREENS AND COARSE SCREENINGS HANDLING	10
GRIT REMOVAL AND GRIT PUMPS	11
GRIT WASHER/CLASSIFIER	12
FINE SCREEN PUMP STATION	13
EQUALIZATION AND SURGE	14
COMPRESSED AIR MIXING SYSTEM-EQUALIZATION	15
PRIMARY CLARIFIER 1	20
PRIMARY CLARIFIER 2	21
PRIMARY SLUDGE PUMP STATION 1	22
PRIMARY SLUDGE PUMP STATION 2	23
PRIMARY SCUM PUMPS	24
PRIMARY SLUDGE THICKENER 1 (FUTURE)	25
PRIMARY SLUDGE THICKENER 2 (FUTURE)	26
THICKENER DECANT PUMP STATION (FUTURE)	27
THICKENED SLUDGE PUMP STATION (FUTURE)	28
FINE SCREENS, FINE SCREENINGS HANDLING AND ODOR CONTROL	29
BIOREACTOR VALVE GALLERY A – BIOREACTORS 1 AND 2	30
BIOREACTOR VALVE GALLERY B – BIOREACTORS 3 AND 4 (FUTURE)	31
BIOREACTOR VALVE GALLERY C – BIOREACTORS 5 AND 6 (FUTURE)	32
BIOREACTOR 1	33
BIOREACTOR 2	34
BIOREACTOR 3 (FUTURE)	35
BIOREACTOR 4 (FUTURE)	36
BIOREACTOR 5 (FUTURE)	37
BIOREACTOR 6 (FUTURE)	38
PROCESS AIR BLOWERS	39
MIXED LIQUOR CHANNEL	40
RAS CHANNEL, RAS PUMPS, AND DO DEPLETION CHANNELS	41
BASIN DRAIN PUMP STATION	42
MEMBRANE TANK 1	43
MEMBRANE TANK 2	44
MEMBRANE TANK 3	45
MEMBRANE TANK 4	46
MEMBRANE TANK 5	47
MEMBRANE TANK 6	48
MEMBRANE TANK 7	49
MEMBRANE TANK 8	50
MEMBRANE TANK 9 (FUTURE)	51
MEMBRANE TANK 10 (FUTURE)	52
MEMBRANE TANK 11 (FUTURE)	53
MEMBRANE TANK 12 (FUTURE)	54
PERMEATE WEIR BOX	55
COMPRESSED AIR MIXING SYSTEM - BIOREACTORS	56
WAS PUMP STATION – MEMBRANE TANKS 1 - 8	57
WAS PUMP STATION – MEMBRANE TANKS 9 – 12 (FUTURE)	58
PLANT COMPRESSED AIR SYSTEM	59
AIR SCOUR BLOWERS	60
MEMBRANE BACKPULSE PUMPS	61
COMPRESSED AIR SYSTEM - MEMBRANES	62
SODIUM HYPOCHLORITE STORAGE AND FEED	63
CITRIC ACID STORAGE AND FEED	64
ALUM STORAGE AND FEED	65
UV DISINFECTION SYSTEM	67
IMPURE WATER PUMP STATION	68
PLANT DRAIN SYSTEM	69
ANAEROBIC DIGESTER CONTROL SYSTEM	70
ANAEROBIC DIGESTER 1	71
ANAEROBIC DIGESTER 2	72
RNG PROCESSING (FUTURE)	73
WASTE GAS BURNER	74
STRUVITE CONTROL - AERATED SLUDGE SYSTEM	75
DAF THICKENER	80
DAF SYSTEM	81
SECONDARY DIGESTER 1	82
SECONDARY DIGESTER 2	83
SECONDARY DIGESTER TRANSFER/CENTRIFUGE FEED PUMPS	84
DEWATERING	90
CENTRIFUGES AND DEWATERED SOLIDS CONVEYORS	91
POLYMER STORAGE AND FEED	92
TRUCK LOADING SYSTEM	93
CENTRATE EQUALIZATION SYSTEM	94

FLOW STREAM ID LEGEND

ID	FLOWSTREAM	ID	FLOWSTREAM
AF	ANTI-FOAMING AGENT	MLR	MIXED LIQUOR RETURN
ALUM	ALUMINUM SULFATE	ML	MIXED LIQUOR
AS	AIR SCOUR	NG	NATURAL GAS
BD	BASIN DRAIN	NGH	HIGH PRESSURE NATURAL GAS
BP	MEMBRANE BACKPULSE	NGL	LOW PRESSURE NATURAL GAS
BYP	BYPASS	NPW	NON POTABLE WATER
CA	COMPRESSED AIR	OF	OVERFLOW
CEN	CENTRATE	PA	PROCESS AIR
CIPS	CLEAN IN PLACE SOLUTION	PD	PLANT DRAIN
CIT	CITRIC ACID	PE	PRIMARY EFFLUENT
CK	SLUDGE CAKE	PI	PRIMARY INFLUENT
CW	COLD WATER	PRM	PERMEATE
DAFI	DAF INFLUENT	POL	POLYMER
DAFR	DAF RECYCLE	PS	PRIMARY SLUDGE
DAFU	DAF UNDERFLOW	PW	POTABLE WATER
DEC	DECANT	RAS	RETURN ACTIVATED SLUDGE
DG	DIGESTER GAS	RF	RETURN FLOW
DR	DRAIN	SA	SAMPLE
DSL	DIGESTED SLUDGE	SC	SCUM
EQ	EQUALIZATION	SHC	SODIUM HYPOCHLORITE
EQR	EQUALIZATION BASIN RETURN	SCR	SCREENINGS
FA	FOUL AIR	SD	STORM DRAIN
FO	FOAM	SL	SAMPLE LINE
FE	FINAL EFFLUENT	SPD	SUMP DISCHARGE
GTO	GRAVITY THICKENER OVER FLOW	SPE	SCREENED PRIMARY EFFLUENT
GRT	GRIT	SPS	STRUVITE PRECIPITATED SLUDGE
HPA	HIGH PRESSURE AIR	SS	SANITARY SEWER
HW	HOT WATER	SW	SEAL WATER
INF	INFLUENT	TG	TAIL GAS
IPW	IMPURE WATER	TSL	THICKENED SLUDGE
IRR	IRRIGATION	V	DRAIN VENT
LUB	LUBRICATION	WAS	WASTE ACTIVATED SLUDGE
MGCL2	MAGNESIUM CHLORIDE		

STANDARD DETAIL

AS SHOWN ON DRAWING

12345

DETAIL NUMBER

AS SHOWN ON STANDARD DETAIL

12345

NOTES:

1. STANDARD DETAIL CALLOUTS ARE SHOWN TO INDICATE DETAIL REQUIRED AT SPECIFIC LOCATIONS. DETAILS ARE NOT CALLED OUT AT ALL LOCATIONS. WHERE A STANDARD DETAIL CALLOUT IS NOT SHOWN, THE CONTRACTOR SHALL USE THE STANDARD DETAIL MOST APPLICABLE AND CONSISTENT WITH OTHER WORK UNDER THIS CONTRACT.

UNIQUE VALVE AND OPERATOR

NEW PLANT DESIGNATION

PROCESS DESIGNATION

P08-BFV-XXX

UNIQUE NUMBER

VALVE TYPE

EQUIPMENT DESIGNATION

NEW PLANT DESIGNATION

PROCESS DESIGNATION

EQUIPMENT TYPE

UNIQUE NUMBER

P08-P-101

LINE TYPE APPEARANCE

—	BLACK	NEW 'ON' DISCIPLINE
—	LIGHT OR MEDIUM GRAY OR SCREENED	EXISTING 'ON' OR 'OFF' DISCIPLINE
—	DARK GRAY	NEW 'OFF' DISCIPLINE
—	FUTURE	FUTURE 'ON' DISCIPLINE

GENERAL SYMBOLOGY

STRUCTURE OR EQUIPMENT TO BE REMOVED OR DEMOLISHED

LICENSED PROFESSIONAL ENGINEER

JENNIFER CALDERON

12284243-2202

02/26/2025

STATE OF UTAH

VERIFY SCALE

BAR IS ONE INCH ON ORIGINAL DRAWING.

0 1"

IF NOT ONE INCH ON THIS SHEET, ADJUST SCALES ACCORDINGLY.

DESIGN

JEN

DRAWN

JAM

CHECKED

JEN

APPROVED

JHM

WATERWORKS

ENGINEERS

PROVO CITY

PUBLIC WORKS DEPT

PROVO WRF

PHASE 1, ELEC. UPGRADES

PACKAGE A - S2 RE-FEED

GENERAL

STANDARD DESIGNATIONS

DATE

FEBRUARY 2025

PROJECT NUMBER

19-002

DRAWING NUMBER

G-GN-004

SHEET

OF

REUSE OF DOCUMENTS: THIS DOCUMENT, AND THE IDEAS AND DESIGNS INCORPORATED HEREIN, AS AN INSTRUMENT OF PROFESSIONAL SERVICE, IS THE PROPERTY OF WATER WORKS ENGINEERS, LLC. AND IS NOT TO BE USED, IN WHOLE OR IN PART, FOR ANY OTHER PROJECT WITHOUT THE WRITTEN AUTHORIZATION OF WATER WORKS ENGINEERS, LLC.

FILENAME: W:\CAD\PROJECTS\19-002 PROVO WATRR PHASE 1_(S)\PROJECT FILES_PHASE 1 ELECTRICAL UPGRADES\07 DRAWINGS\PACKAGE A - S2 RE-FEED\PA-1902D-GN-G004.DWG

PLOT DATE: February 26, 2025


PLOT TIME: 11:15 AM

- GENERAL DEMOLITION NOTES:
- DE-ENERGIZE AND MAKE SAFE AT SOURCE ALL EQUIPMENT SCHEDULED FOR DEMOLITION PRIOR TO BEGINNING WORK.
 - COORDINATE ALL SHUT-DOWNS WITH OWNER PRIOR TO BEGINNING DEMOLITION.


INDICATES EQUIPMENT TO BE DEMOLISHED

SCOPE OF WORK KEY NOTES:

A PACKAGE A - S2 RE-FEED

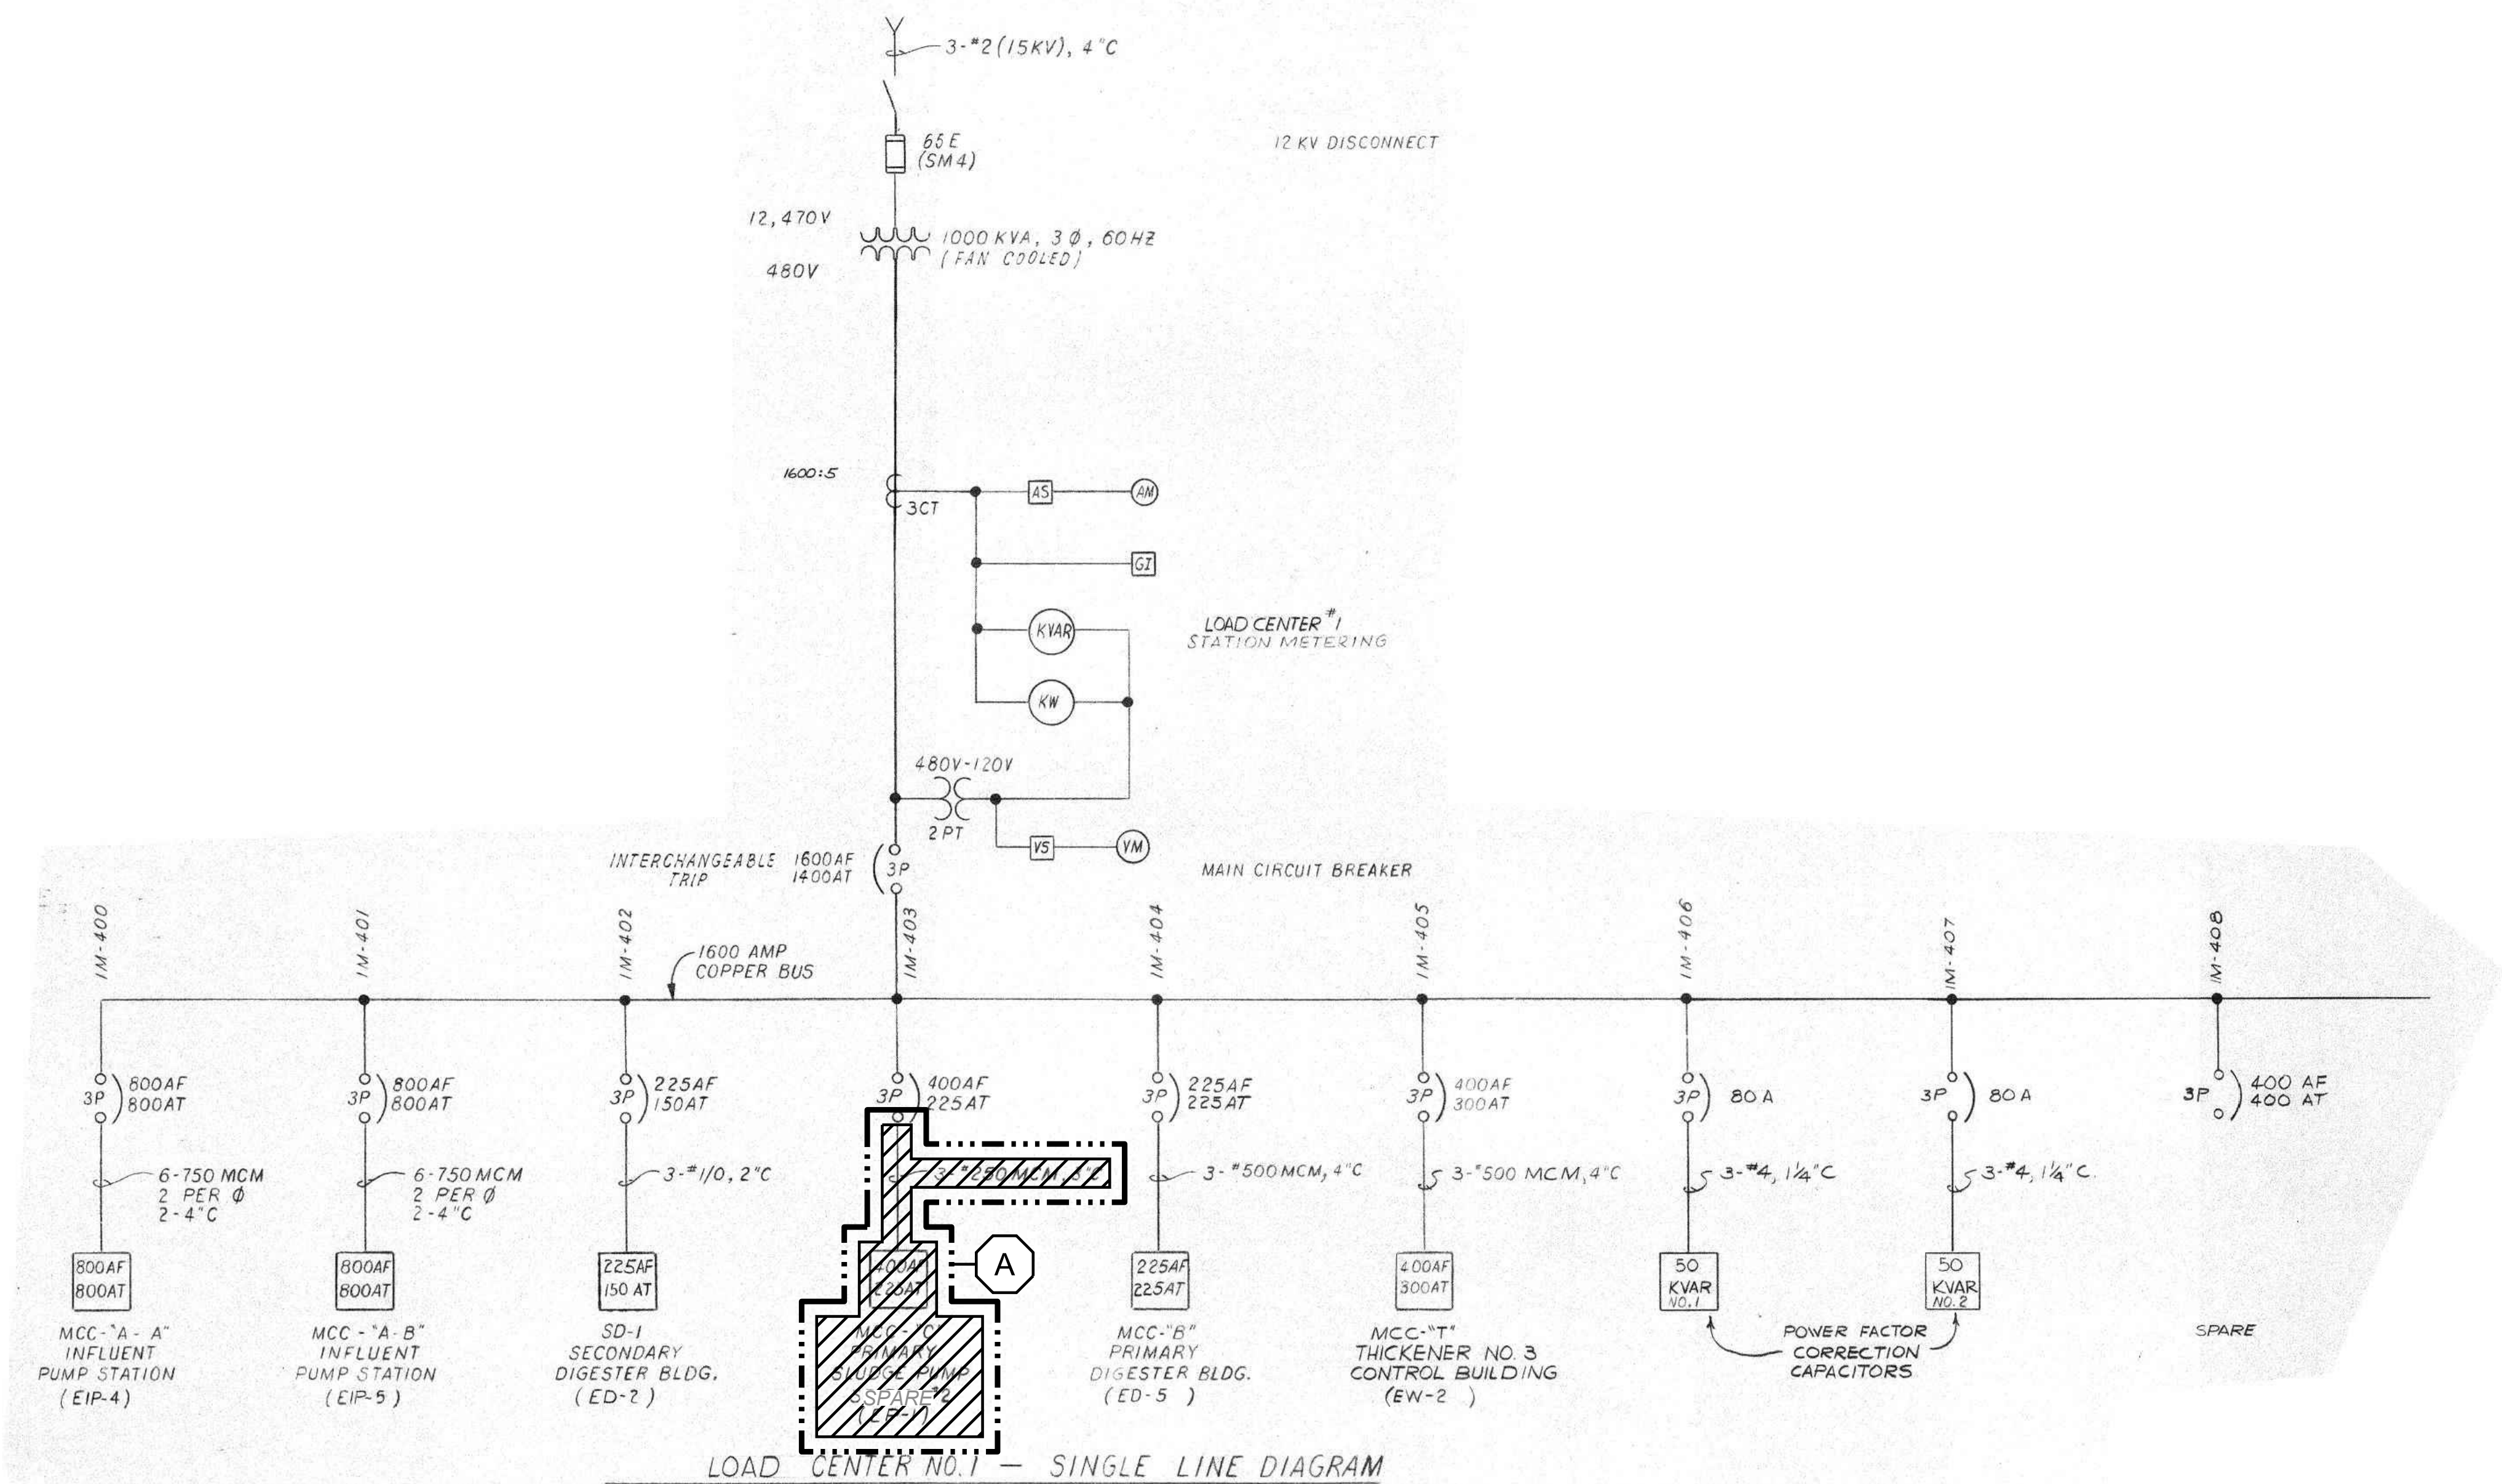


LOAD CENTER NO.1 - SINGLE LINE DIAGRAM

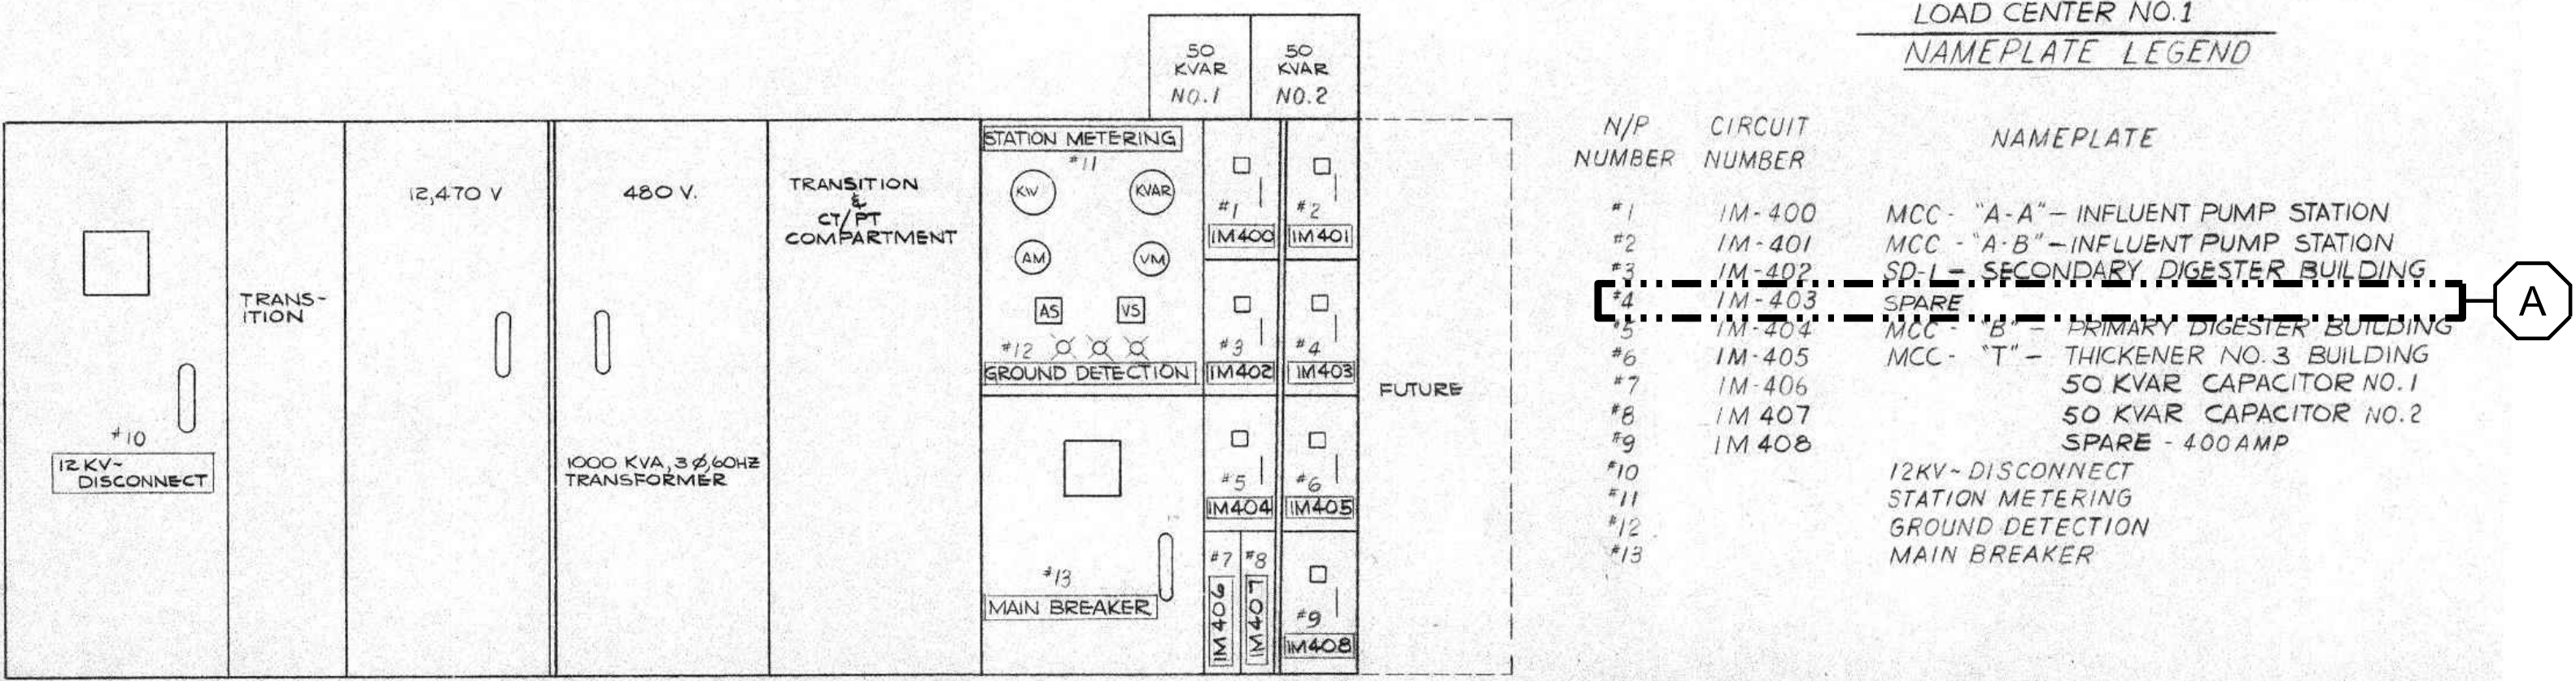

LOAD CENTER NO.1
NAMEPLATE LEGEND

NO.	DATE	REVISION	BY	APVD

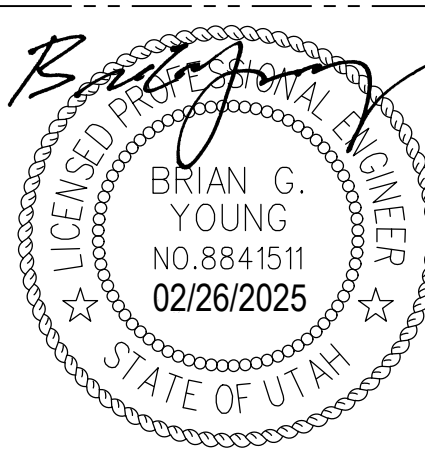

VERIFY SCALE
BAR IS ONE INCH ON ORIGINAL DRAWING.
0 1"
IF NOT ONE INCH ON THIS SHEET, ADJUST SCALES ACCORDINGLY.

DESIGN
TCA
DRAWN
TCA
CHECKED
BGY
APPROVED
JHM

WATERWORKS
ENGINEERS

PROVO CITY
PUBLIC WORKS DEPT
PROVO WRF
PHASE 1, ELEC. UPGRADES
PACKAGE A - S2 RE-FEED



DEMOLITION
LC-1
LOAD CENTER
ONE LINE DIAGRAM

DATE
FEBRUARY 2025
PROJECT NUMBER
19-002
DRAWING NUMBER
D-GN-001
SHEET
OF


GENERAL HVAC NOTES:

- SIZES OF EQUIPMENT PADS INDICATED ON THE DRAWINGS ARE APPROXIMATE. EXACT DIMENSIONS SHALL BE DETERMINED BY THE CONTRACTOR FOR THE EQUIPMENT FURNISHED. ALL FLOOR MOUNTED EQUIPMENT SHALL BE SET ON CONCRETE PADS CONFORMING TO DETAILS SHOWN ON THE TYPICAL STRUCTURAL DRAWINGS AND STANDARD DETAILS.
- DIELECTRIC COUPLINGS, FLANGES, OR UNIONS SHALL BE INSTALLED AT ALL CONNECTIONS OF COPPER PIPE TO OTHER TYPES OF METALLIC PIPING.
- HVAC PIPING AND DUCTWORK DRAWINGS DO NOT SHOW ALL DRAINS, VENTS, OFFSETS, AND FITTINGS ETC. REQUIRED FOR THE COMPLETE SYSTEM. SMALL PIPING IS SHOWN APPROXIMATELY TO SCALE, BUT NOT EVERY FITTING AND OFFSET IS SHOWN.
- THE CONTRACTOR SHALL FURNISH, INSTALL, AND TEST ALL HVAC SYSTEMS TO PROVIDE THE COMPLETE SYSTEM.
- UNLESS OTHERWISE SHOWN ON THE DRAWINGS ALL FLOOR SLABS AND WALL PENETRATIONS SHALL BE AS SHOWN ON THE TYPICAL DETAILS.
- NOT ALL AND ONLY CERTAIN TYPES OF SUPPORTS ARE SHOWN ON THE HVAC DRAWINGS. UNLESS OTHERWISE DETAILED ON THE DRAWINGS ALL PIPE AND DUCT SUPPORTS SHALL BE DESIGNED, FURNISHED AND INSTALLED BY THE CONTRACTOR AS SPECIFIED.
- TYPICAL DETAILS SHALL BE USED FOR ALL PERMANENT WORK EVEN THOUGH THEY ARE NOT CALLED OUT AT ALL LOCATIONS WHERE THEY APPLY.
- PROVIDE TURNING VANES IN ALL ELBOWS. (SHOWN OR NOT).
- PROVIDE FLEXIBLE CONNECTION TO HVAC EQUIPMENT, UNLESS OTHERWISE NOTED ON DRAWINGS OR SPECIFICATIONS.
- DUCTWORK DIMENSIONS NOTED ARE FOR INSIDE DUCT MEASUREMENTS.
- PROVIDE A COPY OF A CERTIFIED AIR BALANCE REPORT TO THE OWNER PRIOR TO THE FINAL INSPECTION. THIS REPORT NEEDS TO BE CONDUCTED BY A THIRD PARTY CERTIFIED TO CONDUCT AN AIR BALANCE AND IS APPROVED BY THE ENGINEER OF RECORD. THE REPORT SHALL DEMONSTRATE THAT THE MECHANICAL SYSTEM WILL MEET THE DESIGN CALCULATIONS AS INDICATED IN THE CONTRACT DOCUMENTS.
- ALL HVAC WORK SHALL BE COORDINATED WITH OTHER DISCIPLINES.
- ALL CUTTING AND PATCHING OF WALLS, FLOORS AND ROOFS, AS REQUIRED TO INSTALL DUCTWORK, EQUIPMENT, ETC. SHALL BE THE RESPONSIBILITY OF THE CONTRACTOR.
- THE CONTRACTOR SHALL PROVIDE ALL METHODS AND MATERIALS FOR SUPPORTING ALL EQUIPMENT AND DUCTWORK FURNISHED UNDER THIS CONTRACT. IN AREAS OF BAR JOIST CONSTRUCTION ALL PIPING, DUCTWORK, AND SUSPENDED EQUIPMENT WITH A CONCENTRATED LOAD (I.E. HANGERS IN EXCESS OF 150 LBS SHALL BE SUPPORTED FROM THE TOP CHORD OF THE BAR JOIST. DO NOT HANG ANY PIPING OR DUCTWORK FROM THE ROOF DECK.
- VERIFY THE FINAL MOUNTING HEIGHTS AND LOCATIONS OF LOUVERS, BRICK VENTS, CABINET HEATERS, SIDEWALL GRILLES AND RESISTERS, AND ALL OTHER VISIBLE EQUIPMENT WITH THE ARCHITECTURAL INTERIOR AND EXTERIOR ELEVATIONS.
- ALL ADJUSTABLE THERMOSTATS, SENSORS AND SWITCHES INTENDED FOR NORMAL USE BY THE BUILDING'S OCCUPANTS SHALL BE MOUNTED 48 INCHES AT FINISHED FLOOR TO THE TOP OF THE DEVICE IN ACCORDANCE WITH ADA REQUIREMENTS.
- DO NOT UTILIZE HVAC EQUIPMENT FURNISHED UNDER THIS CONTRACT AS A MEANS OF TEMPORARY HEAT DURING CONSTRUCTION. OBTAIN WRITTEN APPROVAL FROM THE ENGINEER OR OWNER PRIOR TO PLACING EQUIPMENT IN SUSTAINED OPERATION.
- PROVIDED ELEVATIONS ARE FOR REFERENCE ONLY. FINAL ELEVATIONS ARE SUBJECT TO ACTUAL FIELD CONDITIONS. FIELD VERIFY CLEARANCES AND DIMENSIONS PRIOR TO FABRICATING AND INSTALLING DUCTWORK AND EQUIPMENT. COORDINATE DUCT AND EQUIPMENT INSTALLATIONS WITH ALL OTHER TRADES TO AVOID INTERFERENCE WITH LIGHT FIXTURES, STRUCTURES, ETC.
- PROVIDE SECURITY BARS ON PENETRATIONS 18 INCHES AND LARGER AS INDICATED ON DRAWINGS.
- FIRE SYSTEM CONTROLS: THE CERTIFIED FIRE PROTECTION ALARM SYSTEM SUPPLIER / INSTALLER SHALL PROVIDE ALL NECESSARY PROGRAMMING, CONDUIT AND WIRE, CONTACTS/RELAYS AND ANY ADDITIONAL EQUIPMENT NECESSARY TO PROVIDE A COMPLETE SHUTDOWN OF ALL HVAC EQUIPMENT IN THE EVENT OF AN ALARM EVENT.
- THIS SCOPE WILL INCLUDE ANY REQUIRED MODIFICATIONS OF AN EXISTING OR NEW FACP PANELS AND FIRE ALARM SYSTEM TO INTERFACE WITH HVAC EQUIPMENT STARTERS AND CONTROLLERS.
- THE FIRE ALARM SYSTEM SUPPLIER SHALL COORDINATE WITH THE HVAC CONTRACTOR TO ENSURE A COMPLETE SHUTDOWN OF THEIR EQUIPMENT DURING A FIRE ALARM EVENT.
- THE HVAC CONTRACTOR WILL INSURE THAT A SHUTDOWN SIGNAL RECEIVED AT ALL HVAC EQUIPMENT ARE EFFECTIVELY SHUT DOWN WITH ALL COMPONENTS OF THAT EQUIPMENT.


HVAC SYMBOLS

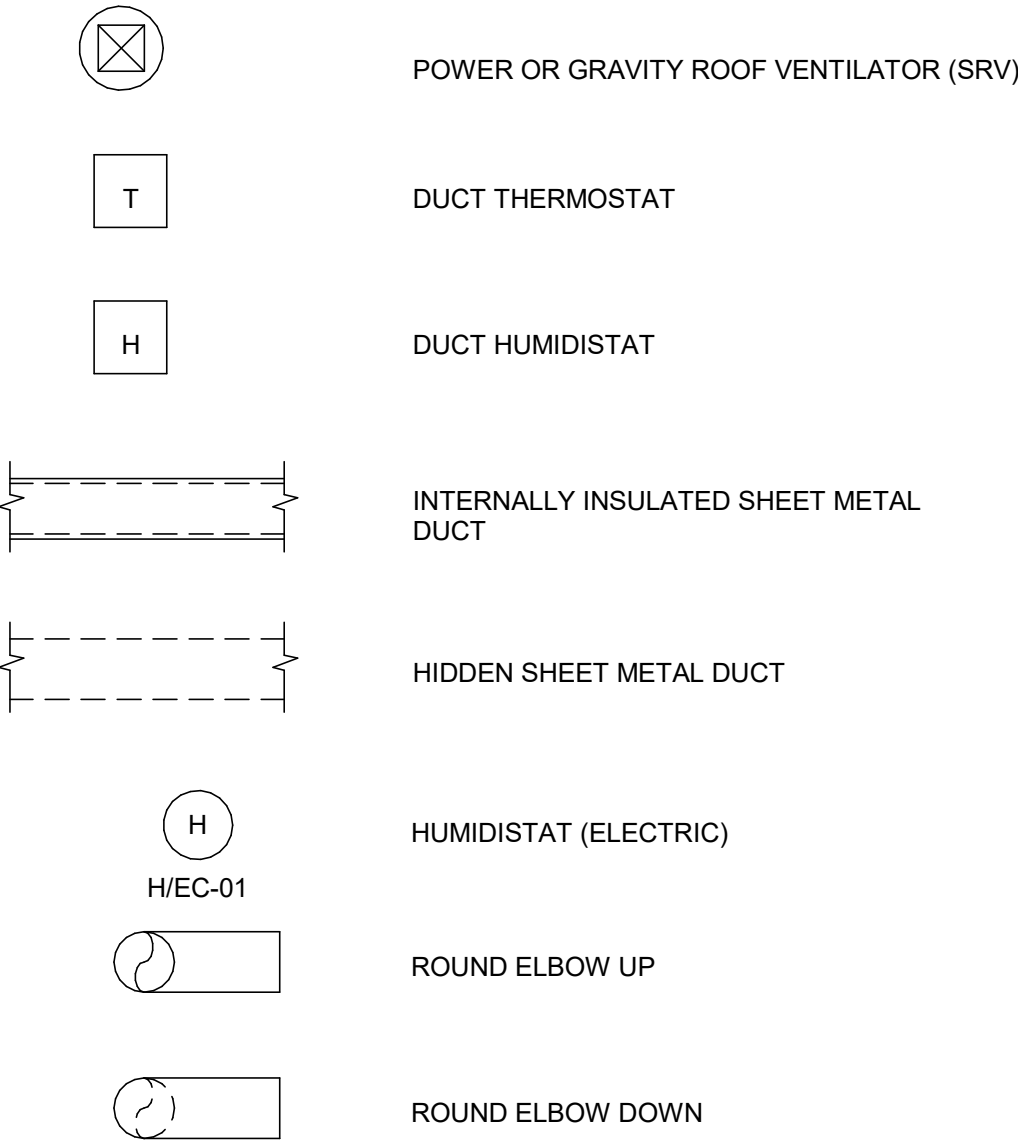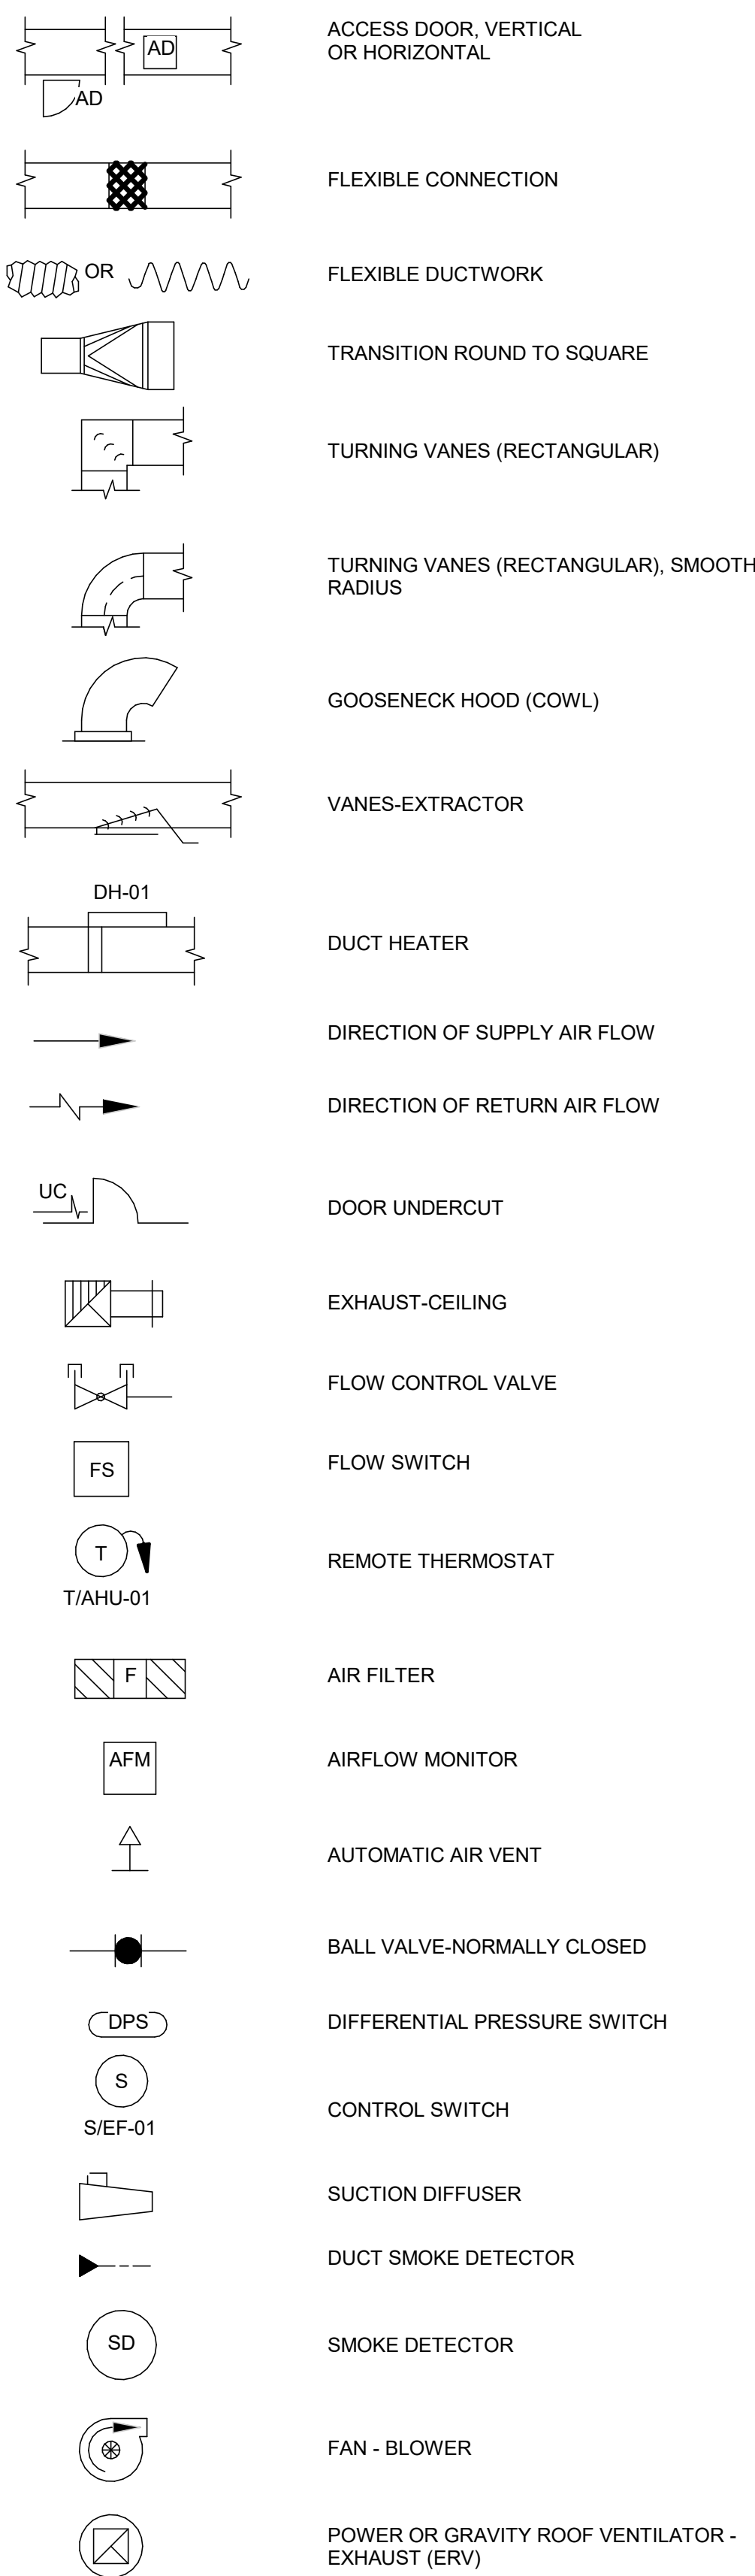



DUCT LINEWORK LEGEND

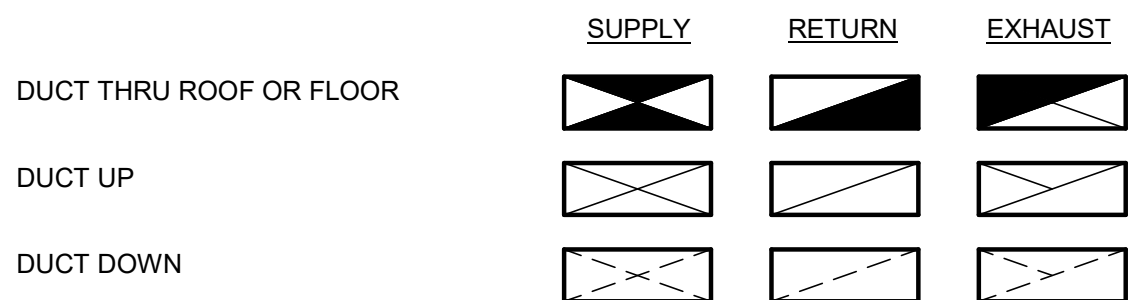


DAMPERS

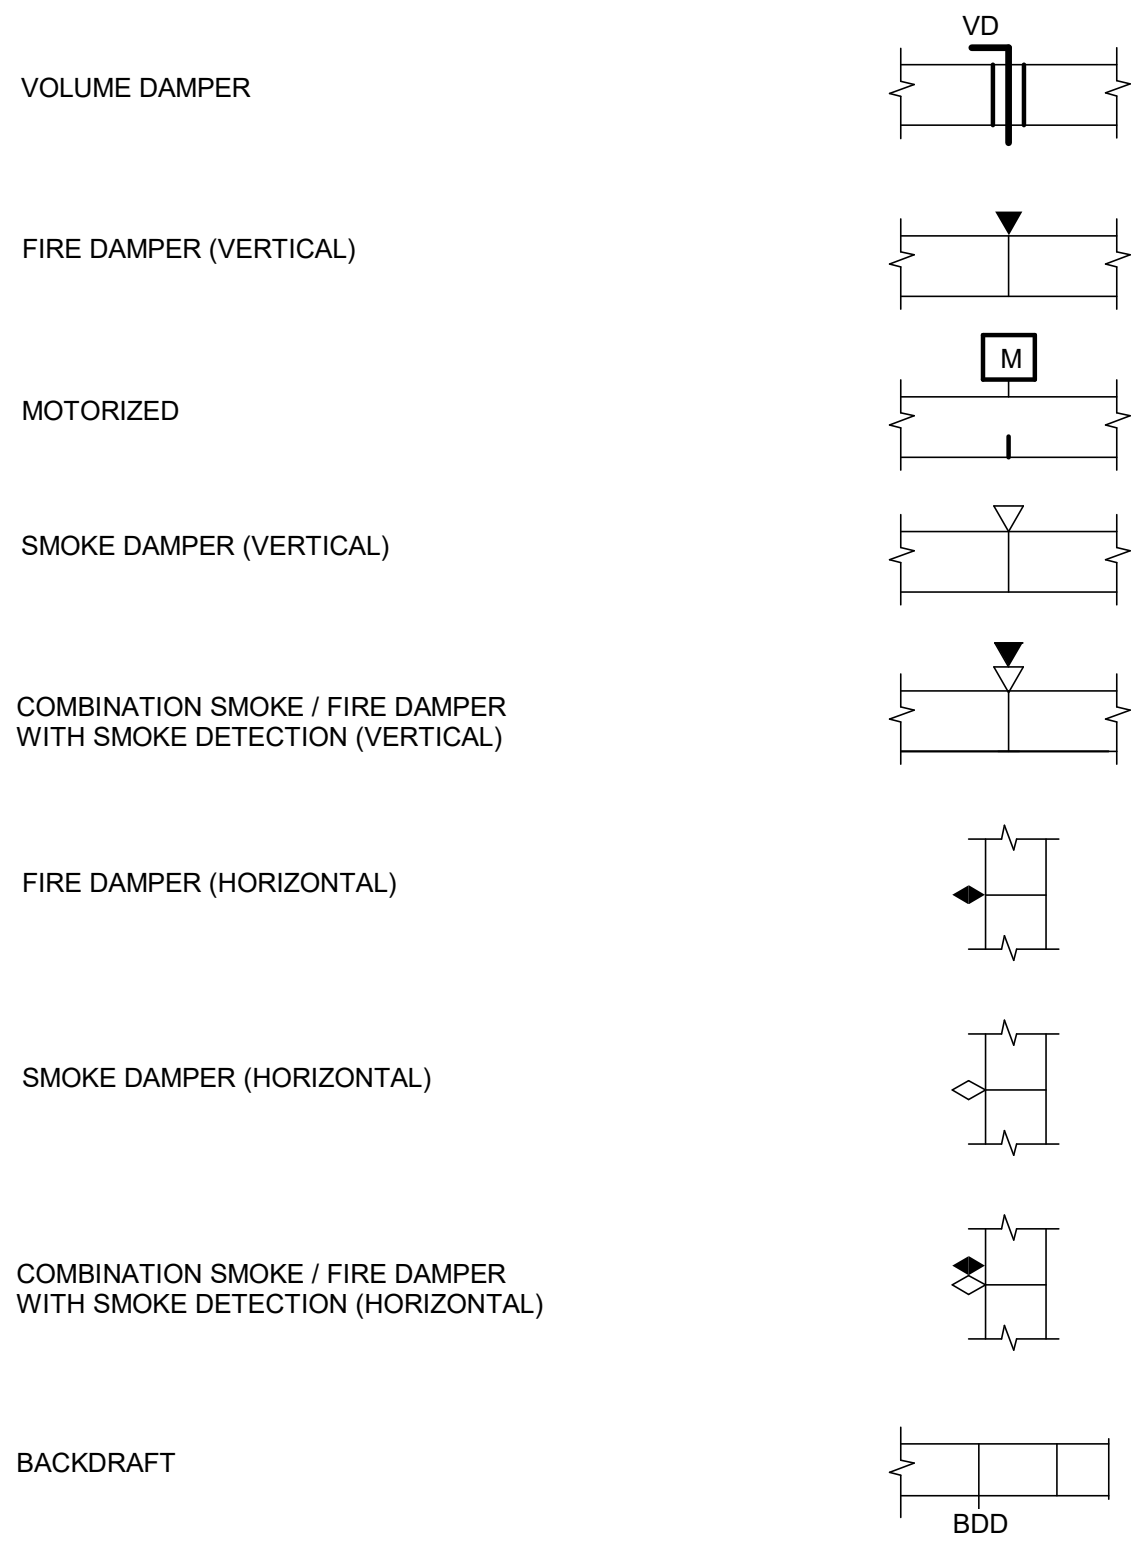



REGISTERS OR GRILLES

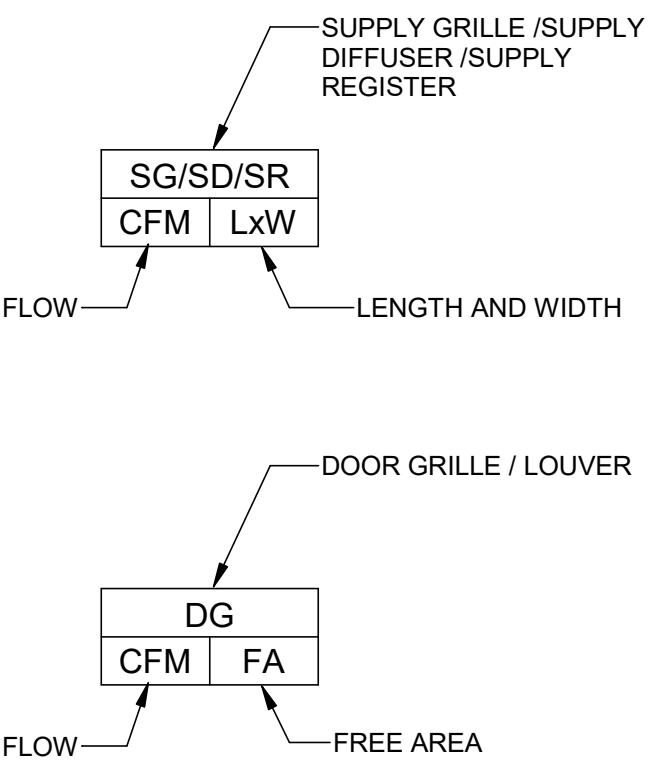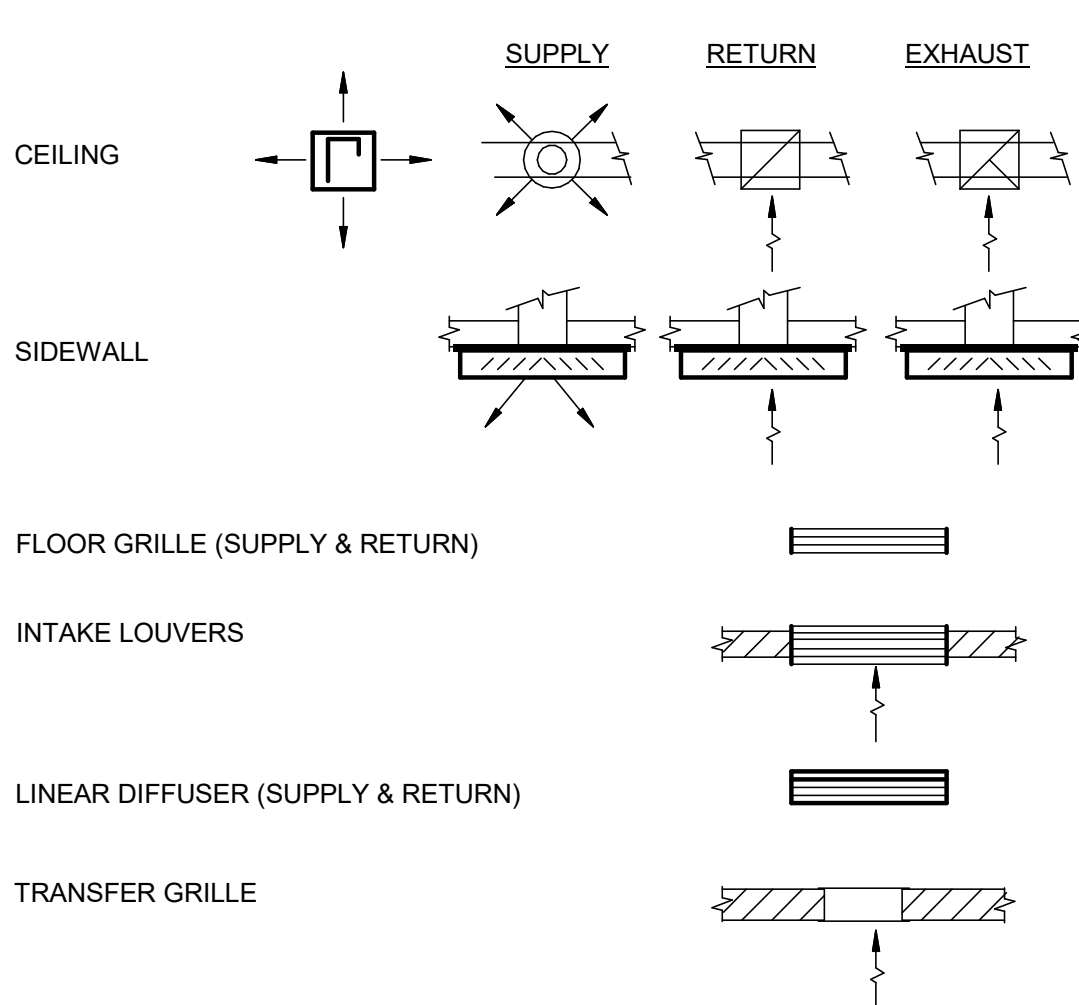

DUCT DIMENSIONS

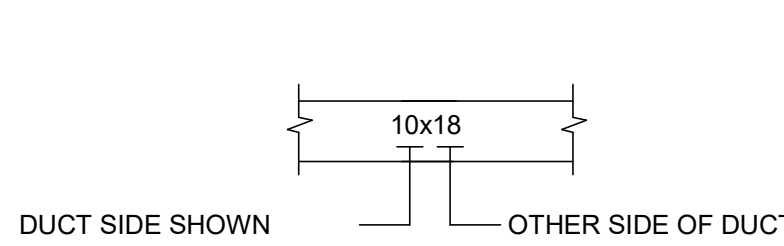

DUCT HEIGHT

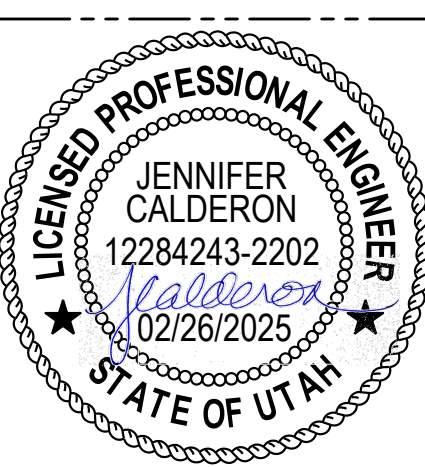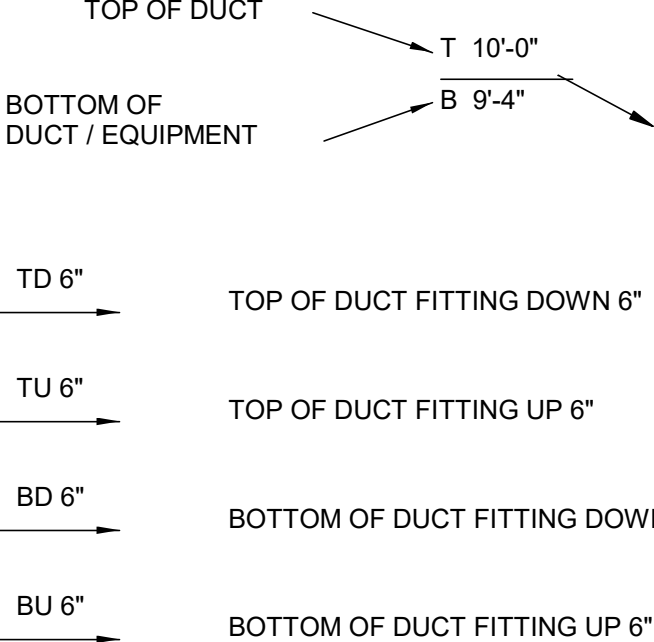

NO.	DATE	REVISION	BY	APVD
-	-	-	-	-
-	-	-	-	-

VERIFY SCALE
BAR IS ONE INCH ON
ORIGINAL DRAWING
IF NOT ONE INCH ON
THIS SHEET, ADJUST
SCALES
ACCORDINGLY.

DESIGN
MC
DRAWN
NCR
CHECKED
MC
APPROVED
JHM



WATERWORKS
ENGINEERS

WELCOME HOME

PROVO CITY
PUBLIC WORKS DEPT
PROVO WRF
PHASE 1, ELEC. UPGRADES
PACKAGE A - S2 RE-FEED



HVAC
HVAC LEGEND

DATE
FEBRUARY 2025
PROJECT NUMBER
19-002
DRAWING NUMBER
H-GN-001
SHEET: OF

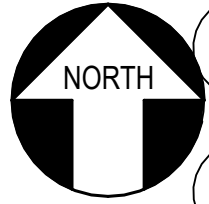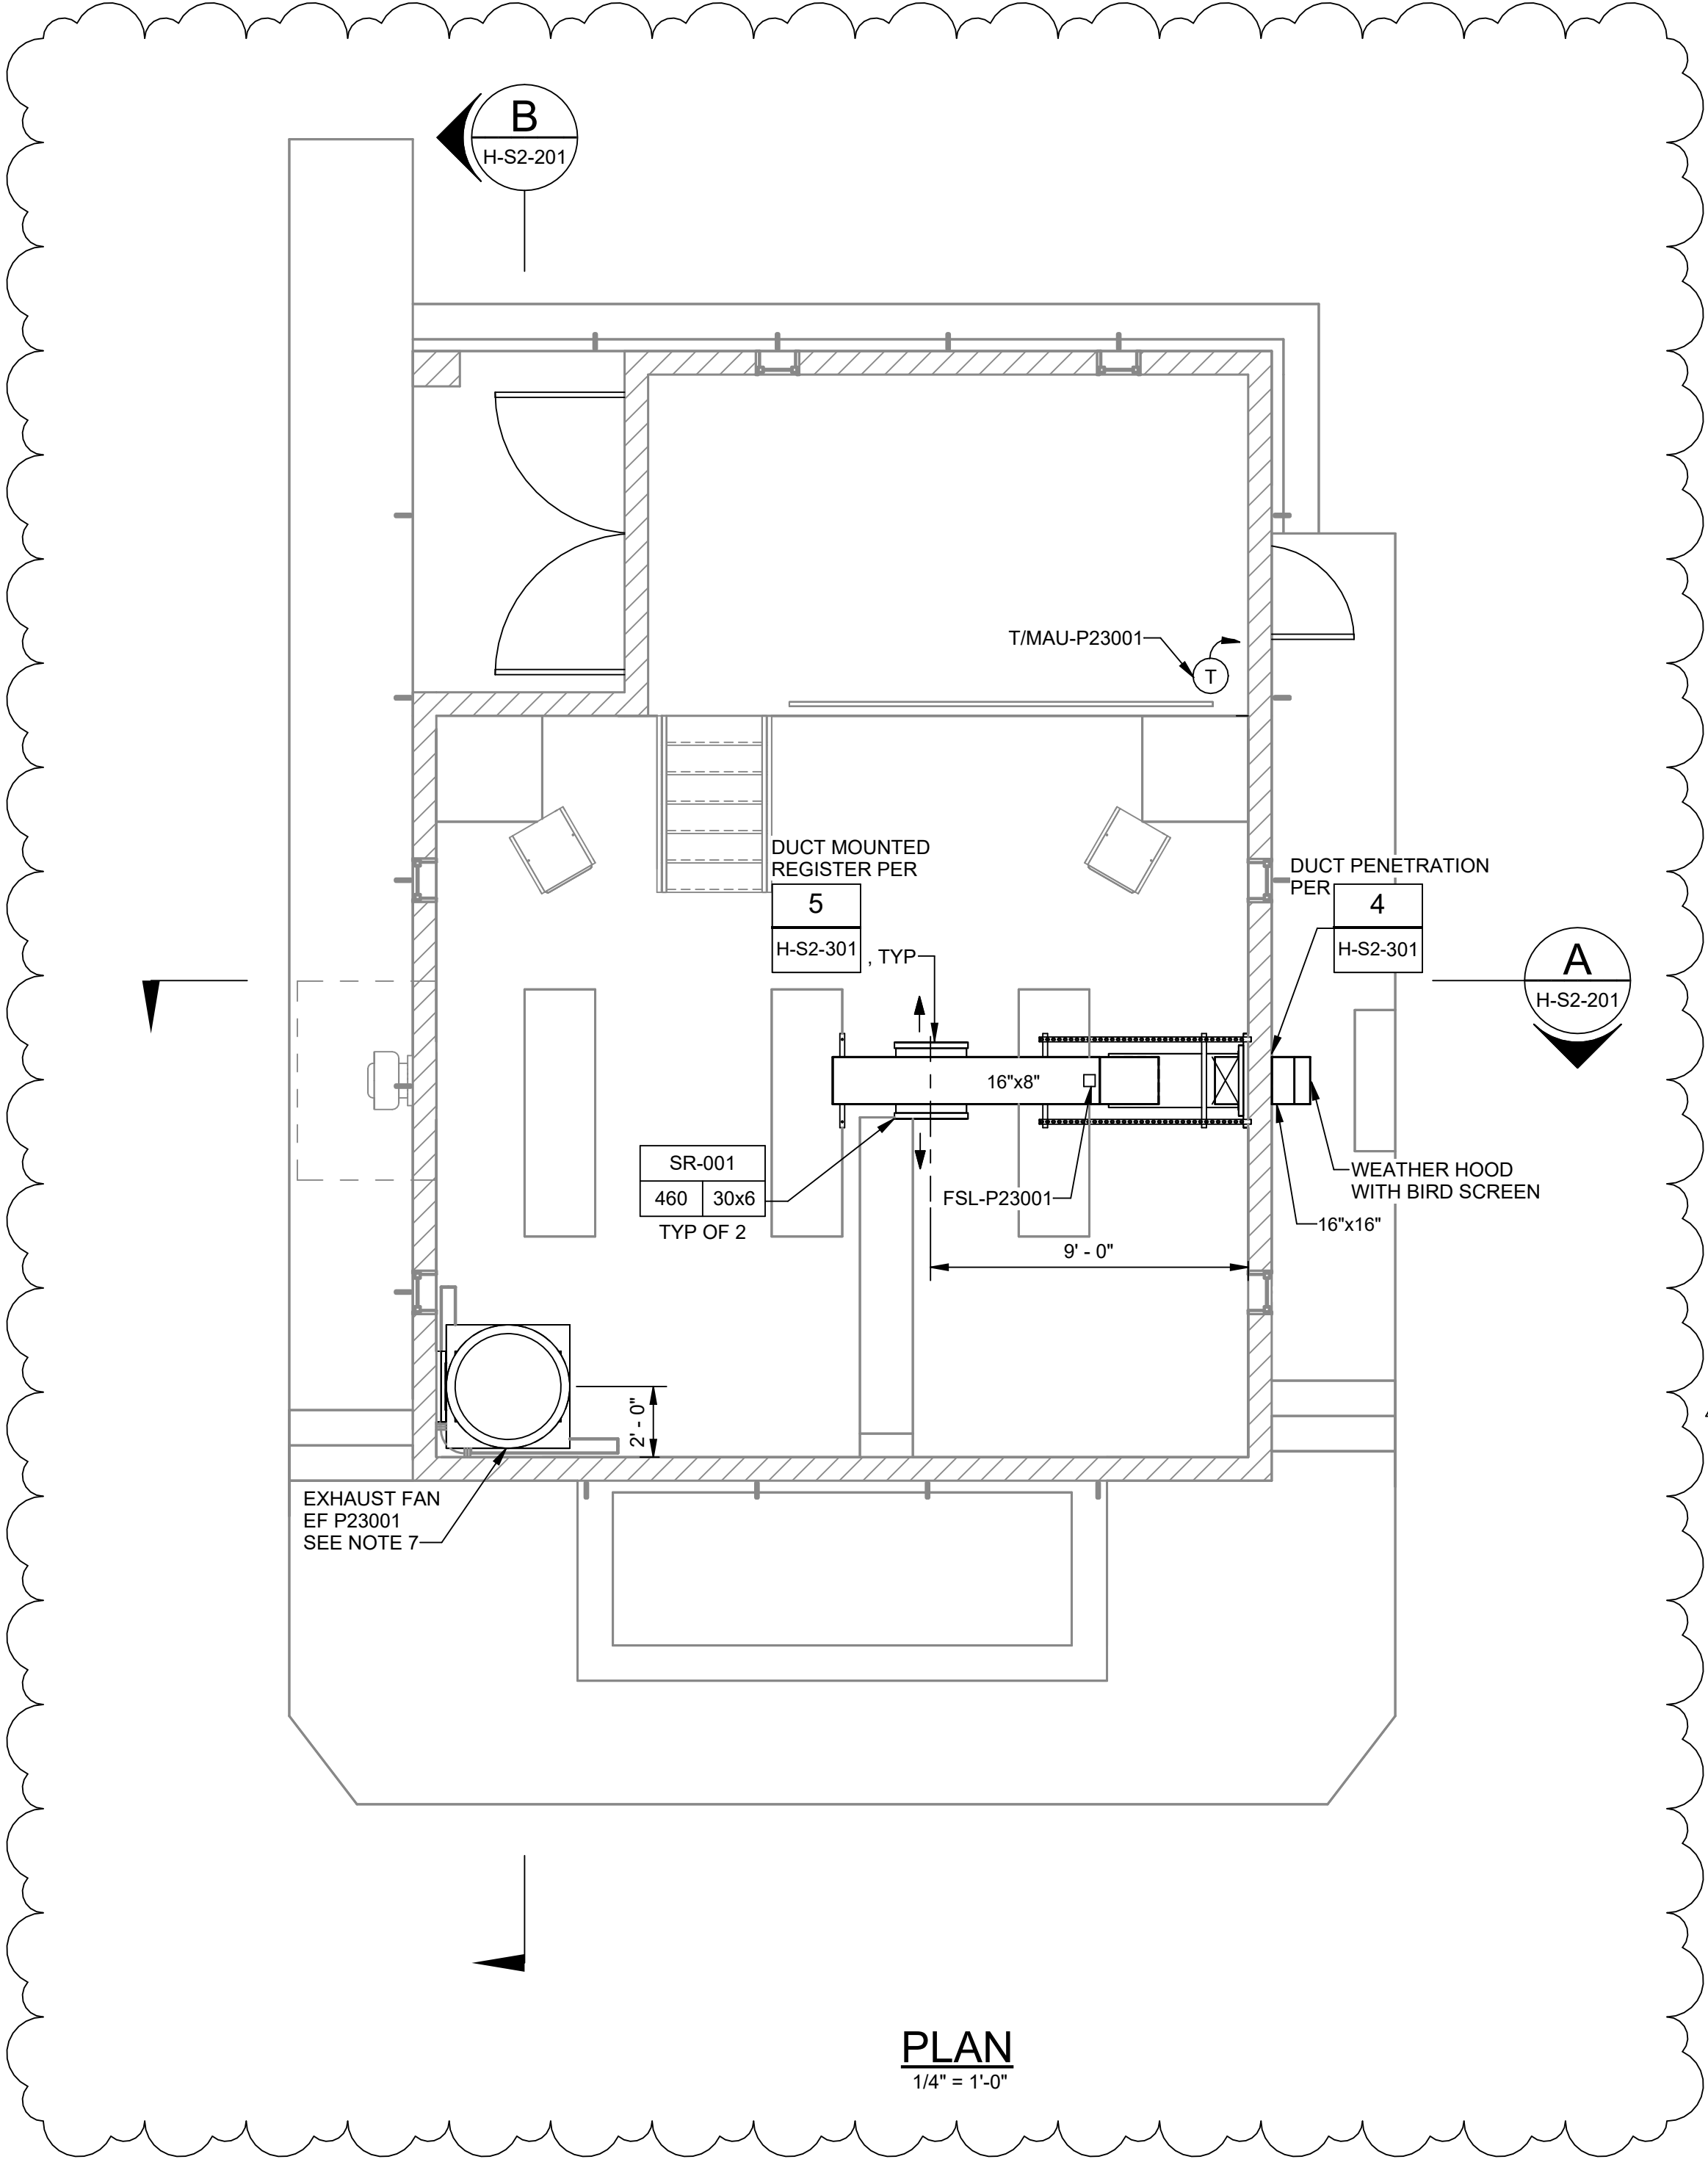

NOTES:

1. DEMOLISH CURRENT WALL EXHAUST FANS. COORDINATE WITH ELECTRICAL FOR THE ELECTRICAL CONNECTIONS TO THESE EXHAUST FANS.
2. ALL DUCTWORKS SHOULD BE MADE OF ALUMINUM. OUTDOOR DUCTS SHOULD BE INSULATED.
3. SUPPLY FAN SF-P23001 SHOULD HAVE INTERLOCK WITH THE EXHAUST FAN (EF-P23001).
4. WHEN BALANCING THE SYSTEM, ENSURE THAT THE PRESSURE INSIDE THE BUILDING IS NEGATIVE PRESSURE BUT DOES NOT EXCEED -0.1 IN WG.
5. DEMOLISH EXISTING DOORS AND INSTALL NEW METAL DOORS THAT MEET THE SPECIFIED CRITERIA:
 - NEW DOORS SHOULD HAVE A SITE LIGHT.
 - NO LOUVERS SHOULD BE PRESENT ON THE DOORS.
 - PROVIDE PANIC BAR FOR EACH DOOR FOR EASY EXIT DURING EMERGENCIES.
6. THE DIMENSIONS AND ELEVATIONS DEPICTED ARE DERIVED FROM THE RECORD DRAWINGS; THE CONTRACTOR IS RESPONSIBLE FOR ON-SITE VERIFICATION OF ELEVATIONS AND DIMENSIONS.
7. SECURE THE CURB TO THE ROOF AND INTEGRATE IT WITH THE EXISTING ROOFING SYSTEM USING FLASHING AND SEALANT. APPLY NEW ROOFING MATERIALS AROUND THE CURB, PROPERLY SEAL ALL EDGES, AND ENSURE PROPER DRAINAGE TO PREVENT LEAKS.

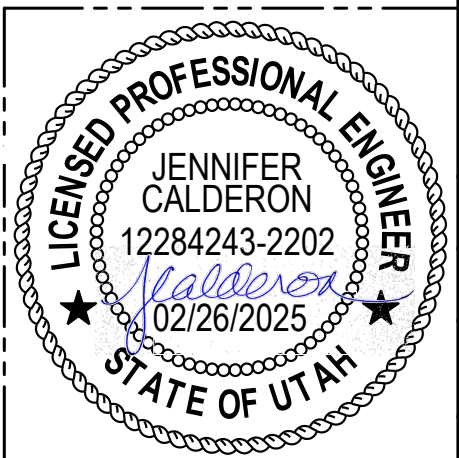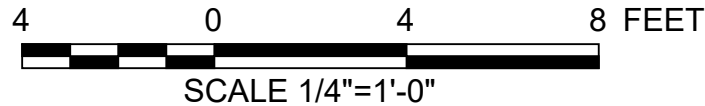


NO.	DATE	REVISION	BY	APVD
1	2/26/24	CHANGES AFTER 90% DESIGN	-	-

REUSE OF DOCUMENTS: THIS DOCUMENT, AND THE IDEAS AND DESIGN INCORPORATED HEREIN, AS AN INSTRUMENT OF PROFESSIONAL SERVICE, IS THE PROPERTY OF WATER WORKS ENGINEERS, LLC. AND IS NOT TO BE USED, IN WHOLE OR PART, FOR ANY OTHER PROJECT WITHOUT THE WRITTEN AUTHORIZATION OF WATER WORKS ENGINEERS, LLC.


FILE PATH: C:\Temp\Revit\19-02 HVAC_detached_jesumAT356.rvt

PLOT DATE AND TIME: 2/26/2025 1:05:27 PM

VERIFY SCALE		DESIGN		WATERWORKS ENGINEERS		PROVO CITY PUBLIC WORKS DEPT PROVO WRF PHASE 1, ELEC. UPGRADES PACKAGE A - S2 RE-FEED	H-VAC PRIMARY SLUDGE PUMP STATION NO. 2 PLAN	DATE	PROJECT NUMBER	DRAWING NUMBER	SHEET
BAR IS ONE INCH ON ORIGINAL DRAWING. 0.1" NOT ONE INCH. 1" THIS SHEET, ADJUST SCALES ACCORDINGLY.		MC	DS					FEBRUARY 2025	19-002	H-S2-101	OF
		MC	MC								
		JHM	JHM								


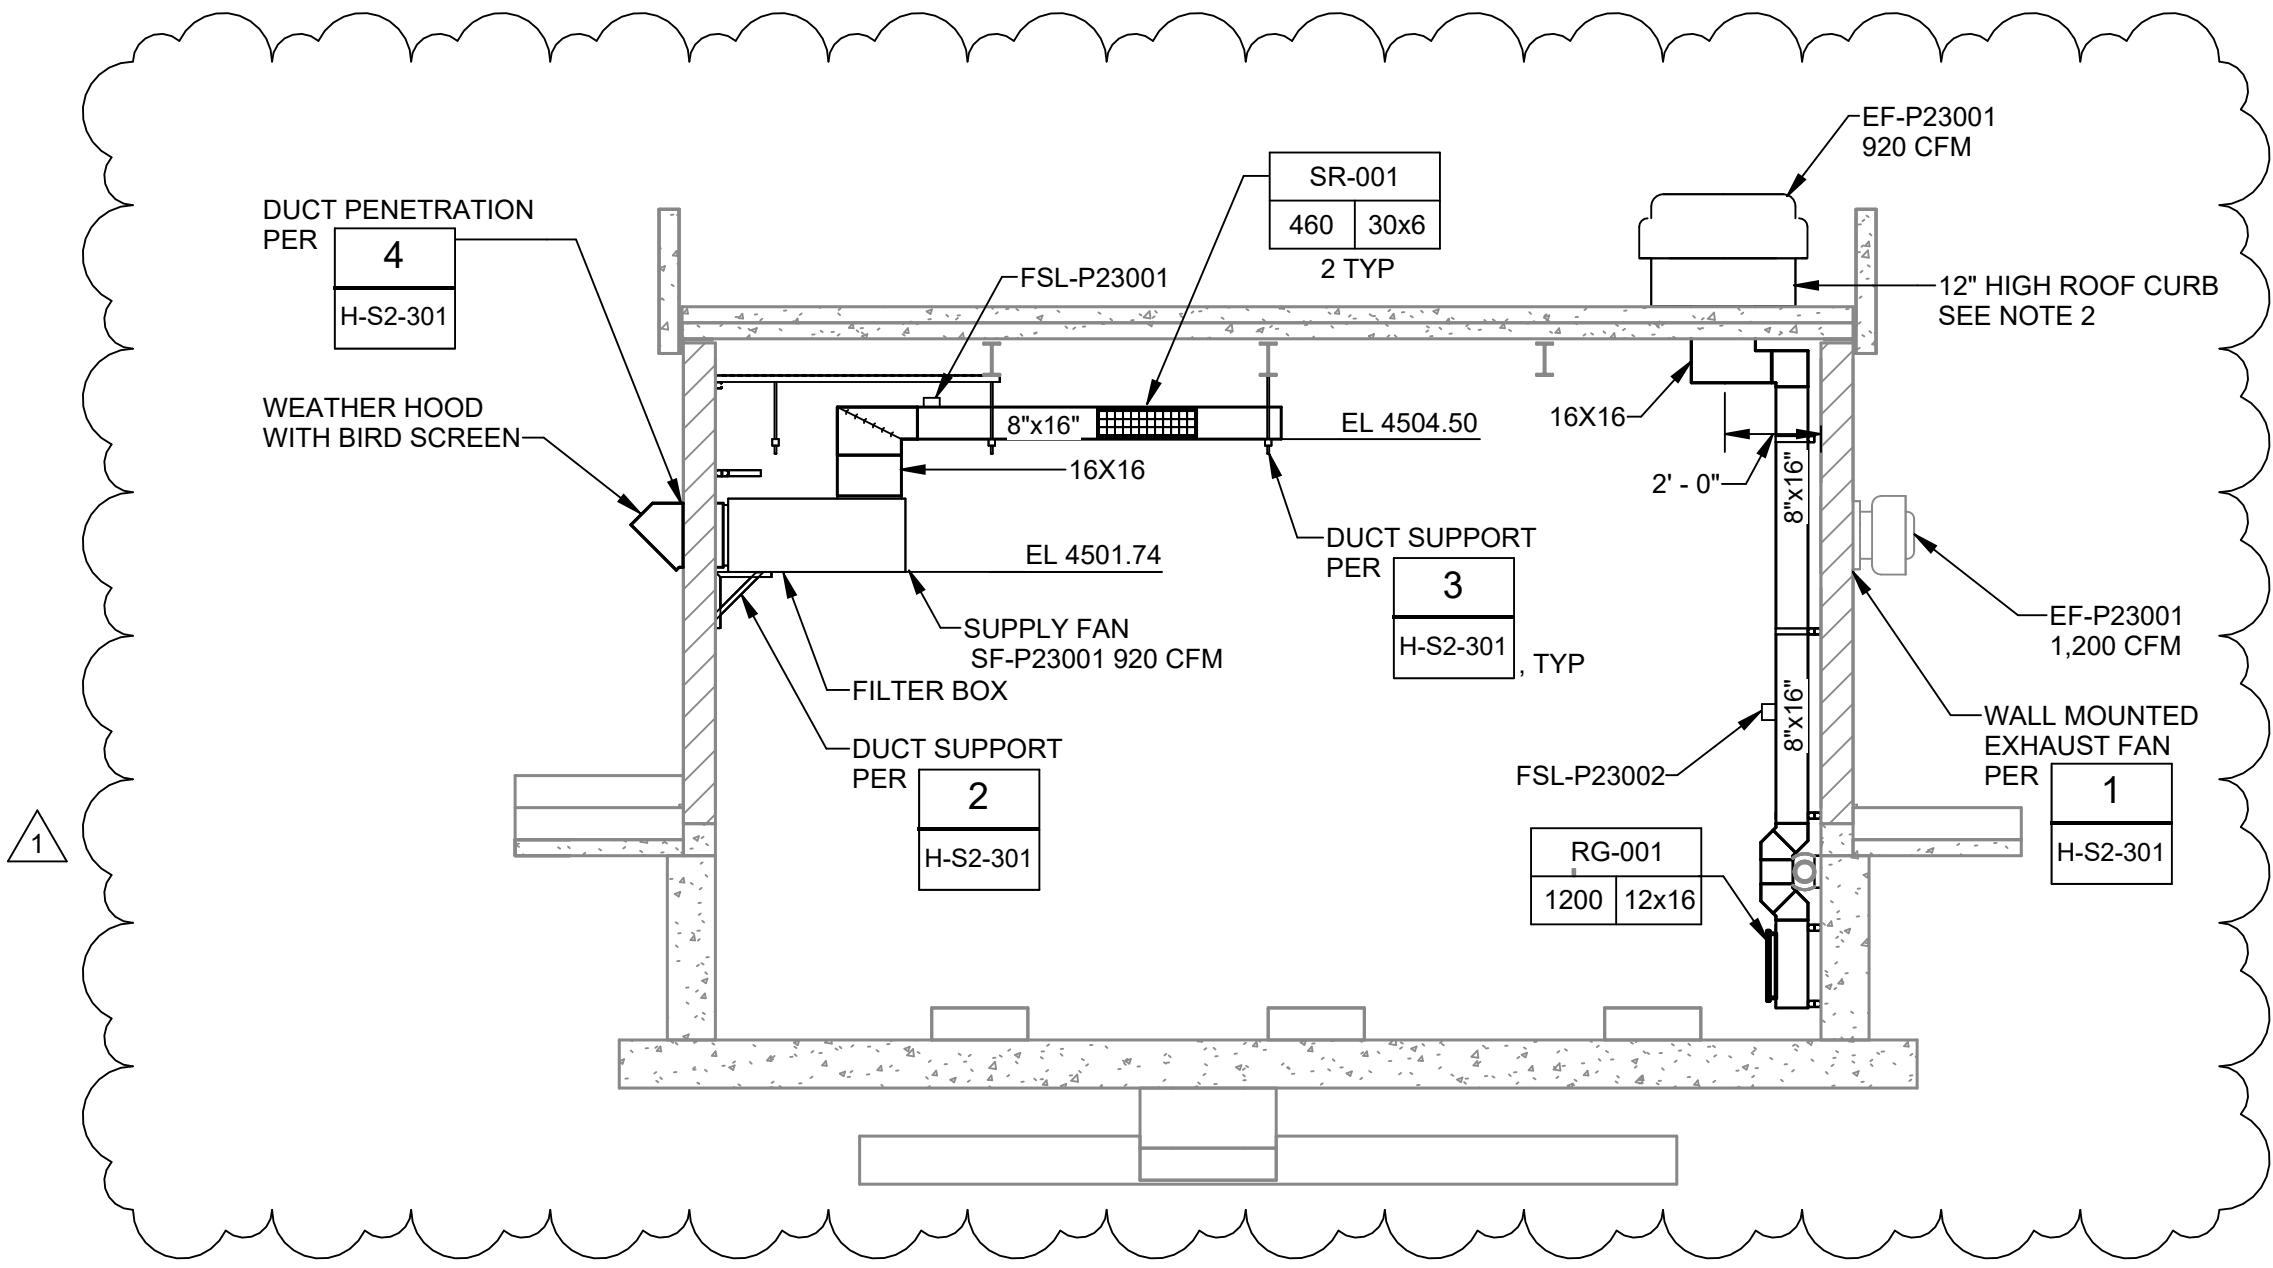


A SECTION
H-S2-101 1/4" = 1'-0"

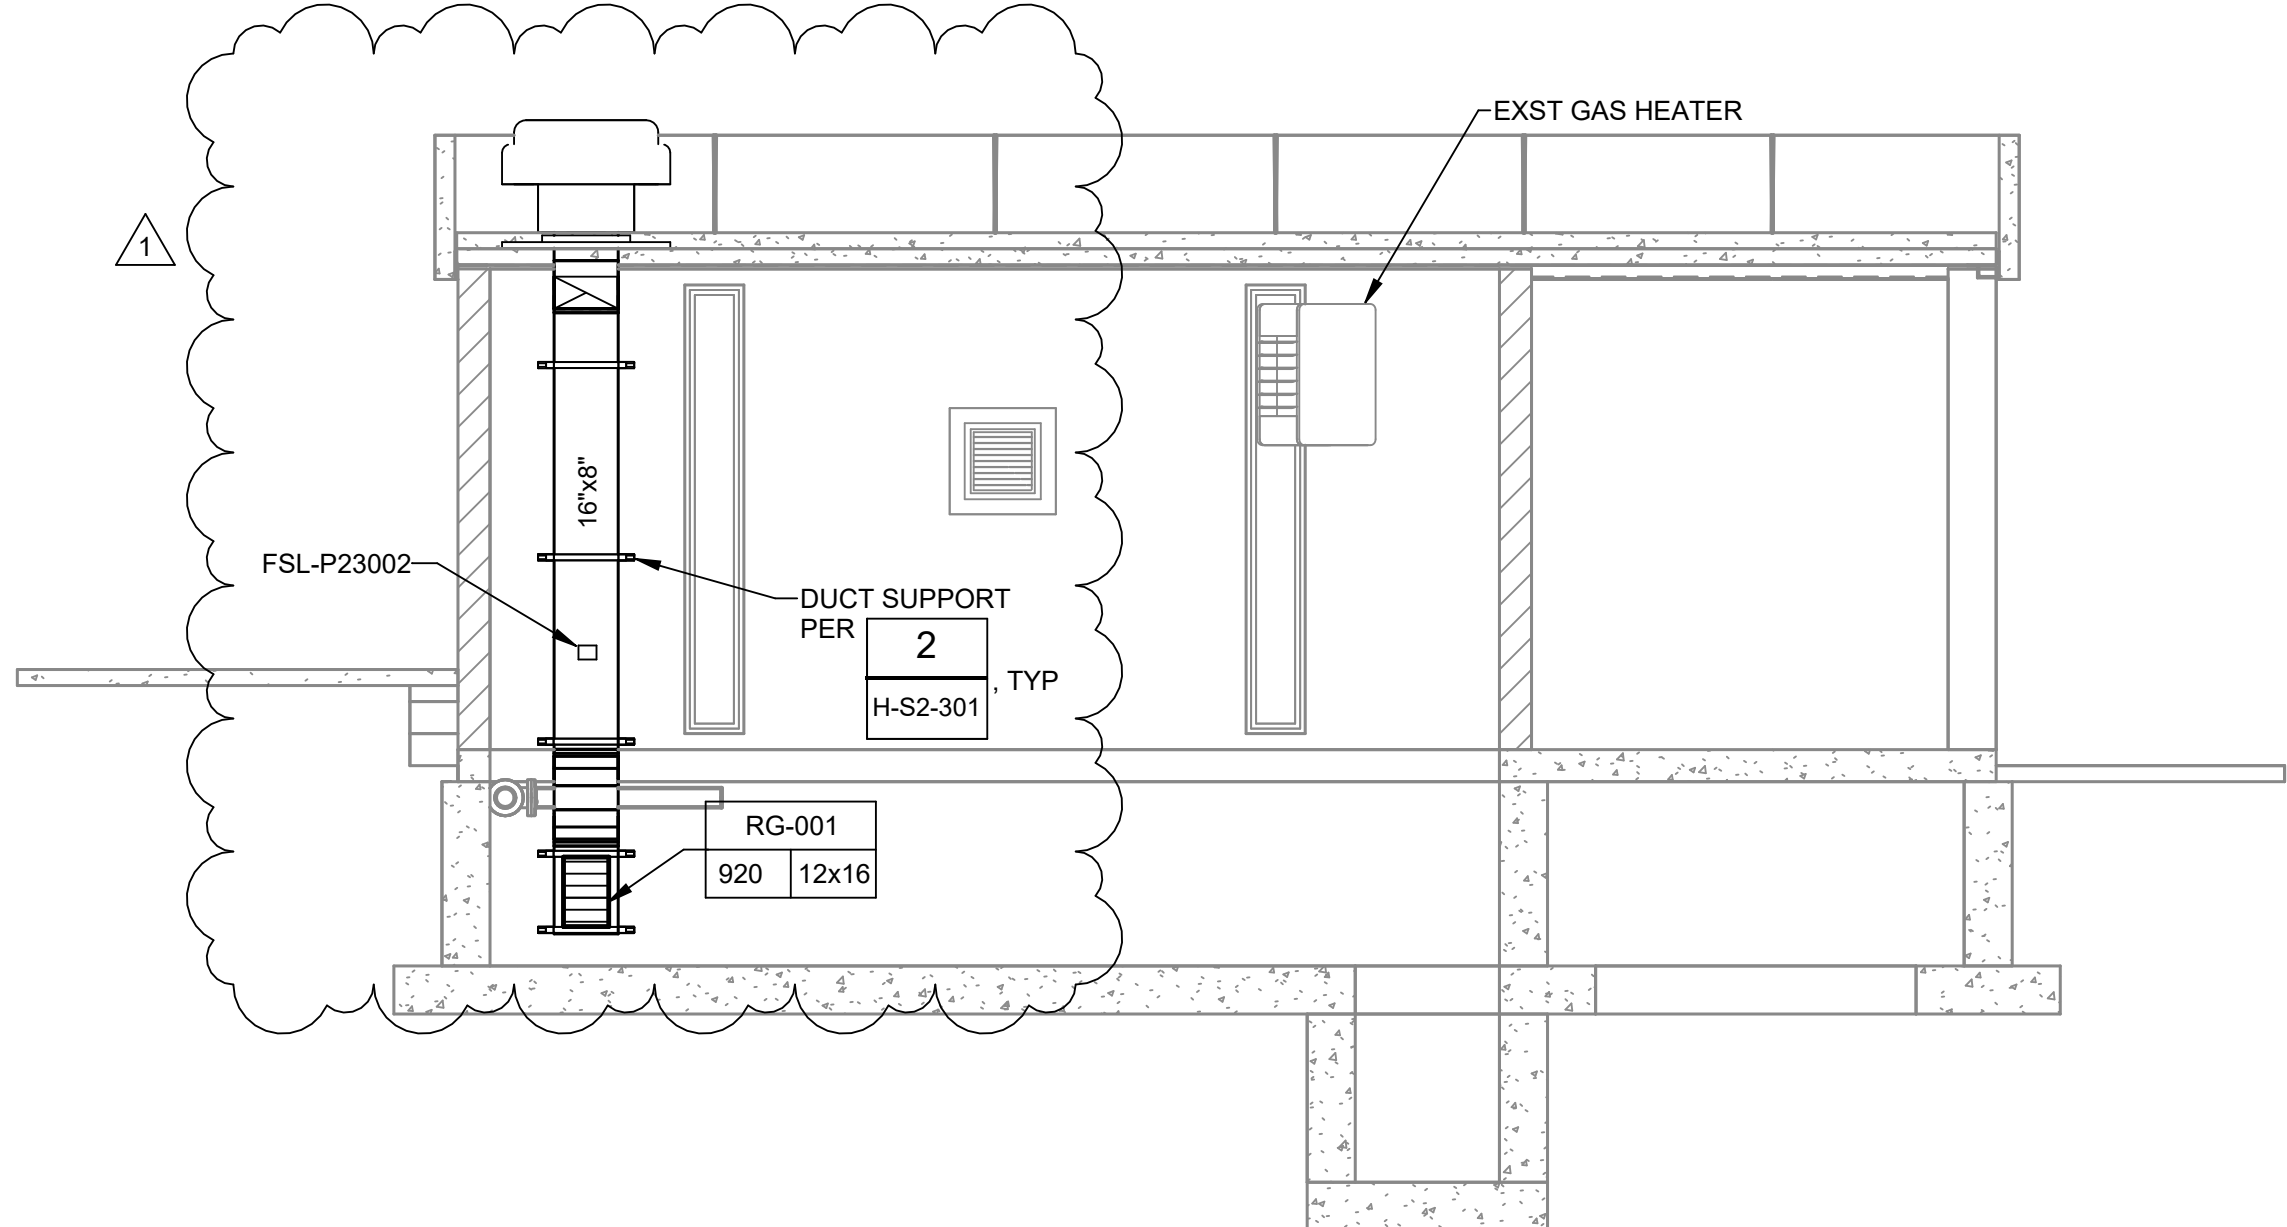

B SECTION
H-S2-101 1/4" = 1'-0"

- NOTES:
1. THE DIMENSIONS AND ELEVATIONS DEPICTED ARE DERIVED FROM THE RECORD DRAWINGS; THE CONTRACTOR IS RESPONSIBLE FOR ON-SITE VERIFICATION OF ELEVATIONS AND DIMENSIONS.
 2. SECURE THE CURB TO THE ROOF AND INTEGRATE IT WITH THE EXISTING ROOFING SYSTEM USING FLASHING AND SEALANT. APPLY NEW ROOFING MATERIALS AROUND THE CURB, PROPERLY SEAL ALL EDGES, AND ENSURE PROPER DRAINAGE TO PREVENT LEAKS.

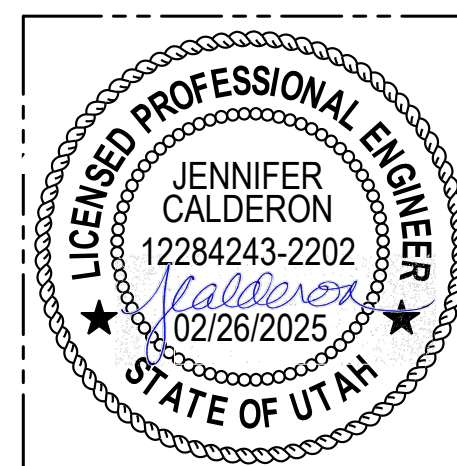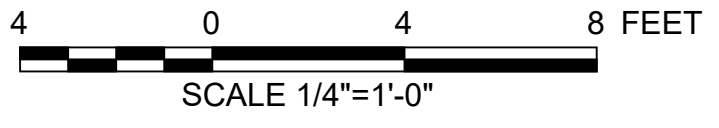

NO.	DATE	REVISION	BY	APVD
1	2/26/24	CHANGES AFTER 90% DESIGN	-	-

VERIFY SCALE
BAR IS ONE INCH ON ORIGINAL DRAWING. 0" NOT ONE INCH. 1" THIS SHEET, ADJUST SCALES ACCORDINGLY.

DESIGN
MC
DRAWN
DS
CHECKED
MC
APPROVED
JHM


WATERWORKS
ENGINEERS

provo
WELCOME HOME

PROVO CITY
PUBLIC WORKS DEPT
PROVO WRF
PHASE 1, ELEC. UPGRADES
PACKAGE A - S2 RE-FEED


HVAC
PRIMARY SLUDGE
PUMP STATION NO. 2
SECTIONS

DATE
FEBRUARY 2025
PROJECT NUMBER
19-002
DRAWING NUMBER
H-S2-201
SHEET: OF

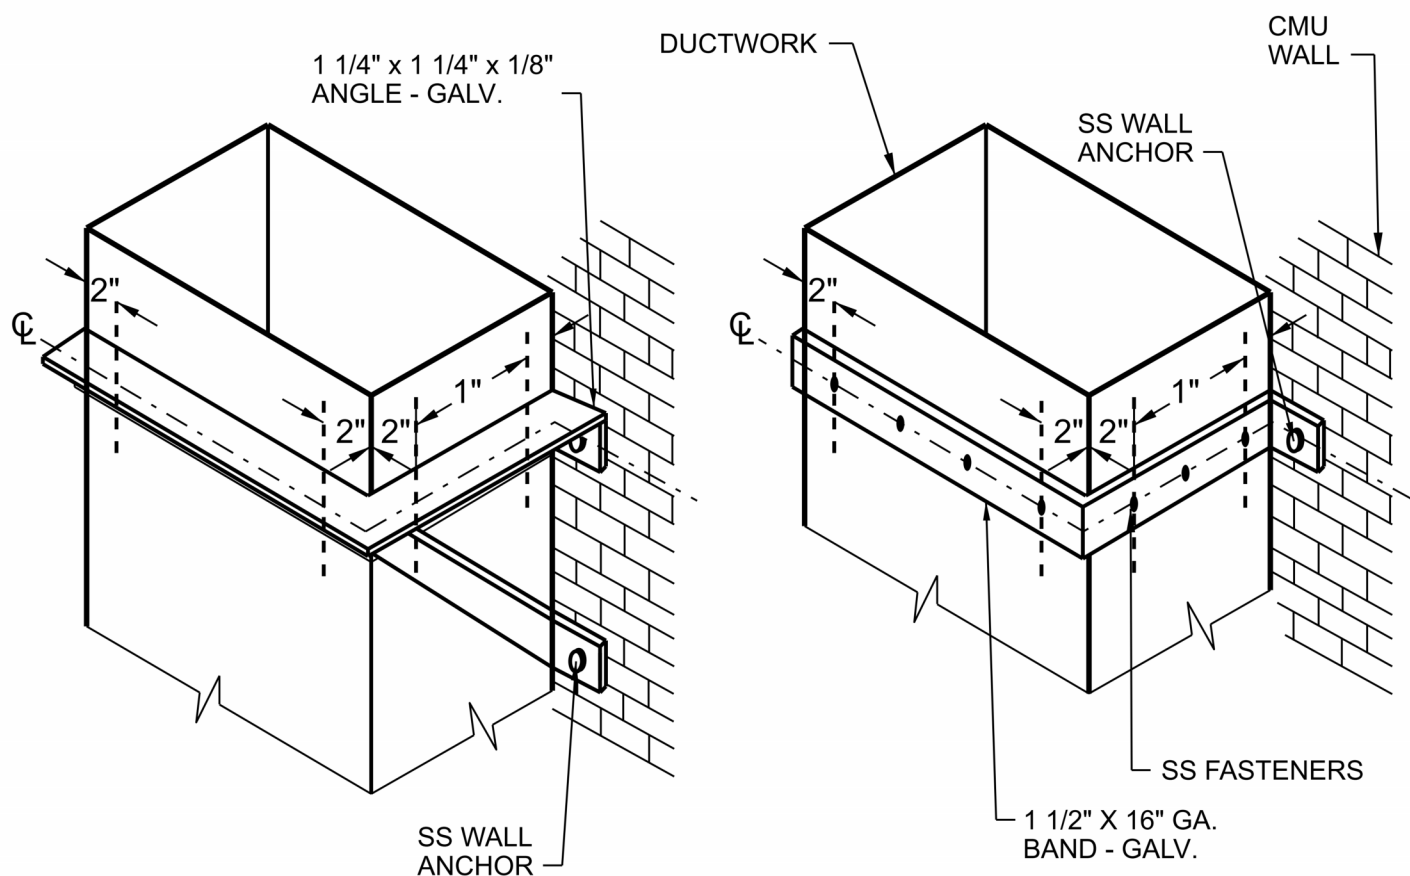


NOTES:

1. MINIMUM NUMBER OF FASTENERS OF 3 ON 24\"/>

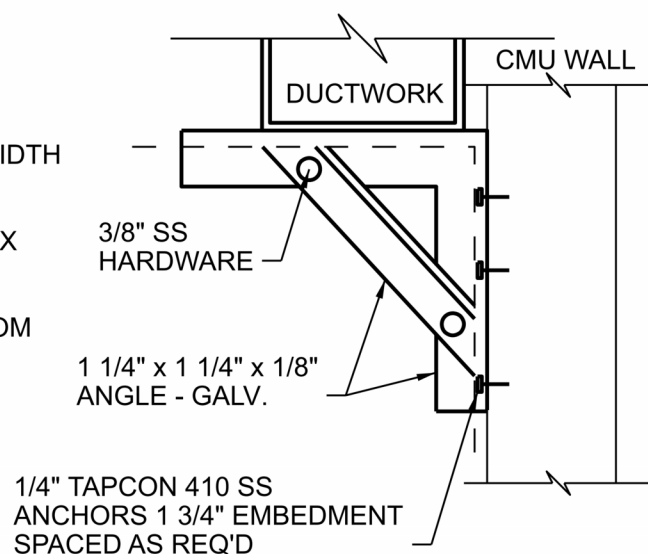

HVAC WALL DUCT
SUPPORT

2
H-S2-201 NTS

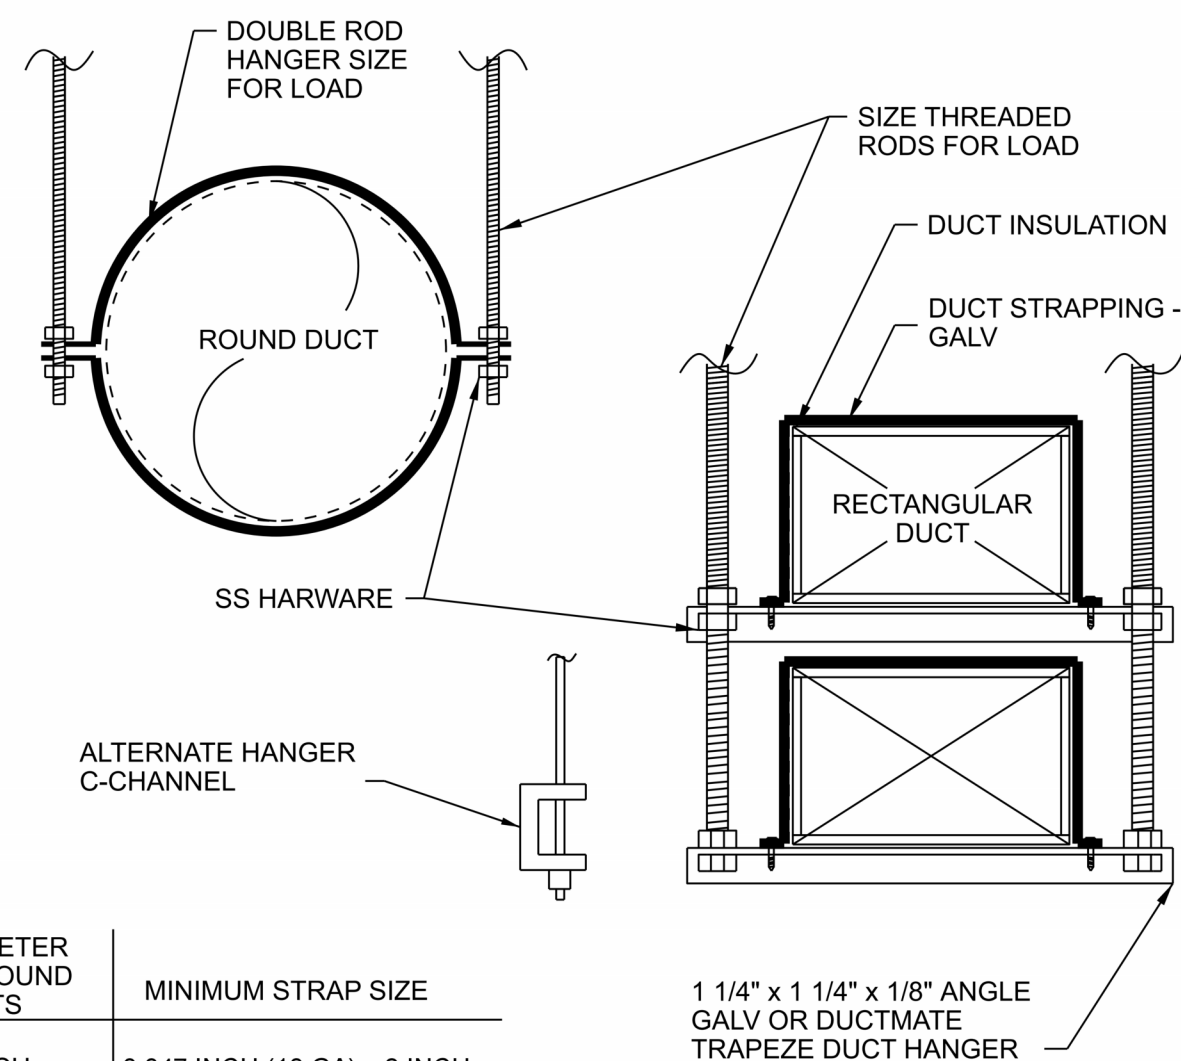


MAX DIAMETER OF ROUND DUCTS	MINIMUM STRAP SIZE
10 INCH	0.047 INCH (18 GA) x 2 INCH WIDTH
20 INCH	0.058 INCH (16 GA) x 2 INCH WDT
40 INCH	1/8 STEEL x 1-1/2 INCH WIDT
60 INCH	1/8 INCH STEEL x 2 INCH WIDTH
>60 INCH	3/16 INCH STEEL x 2 INCH WIDTH

NOTES:

1. RECTANGULAR DUCT HANGERS CAN BE
FABRICATED FROM UNISTRUT-GALV.
2. TRAPEZE MEMBERS ARE NOT TO EXCEED
MANUFACTURER'S RECOMMENDED LOADS.
3. REFERENCE: SMACNA SEISMIC RESTRAINT
MANUAL FOR ADDITIONAL REINFORCEMENT
REQUIRED BY PROJECT.
4. REFERENCE: SMACNA HVAC DUCT
CONSTRUCTION STANDARDS METAL AND
FLEXIBLE FIGURE 4-4.

DUCT SUPPORT

3
H-S2-201 NTS

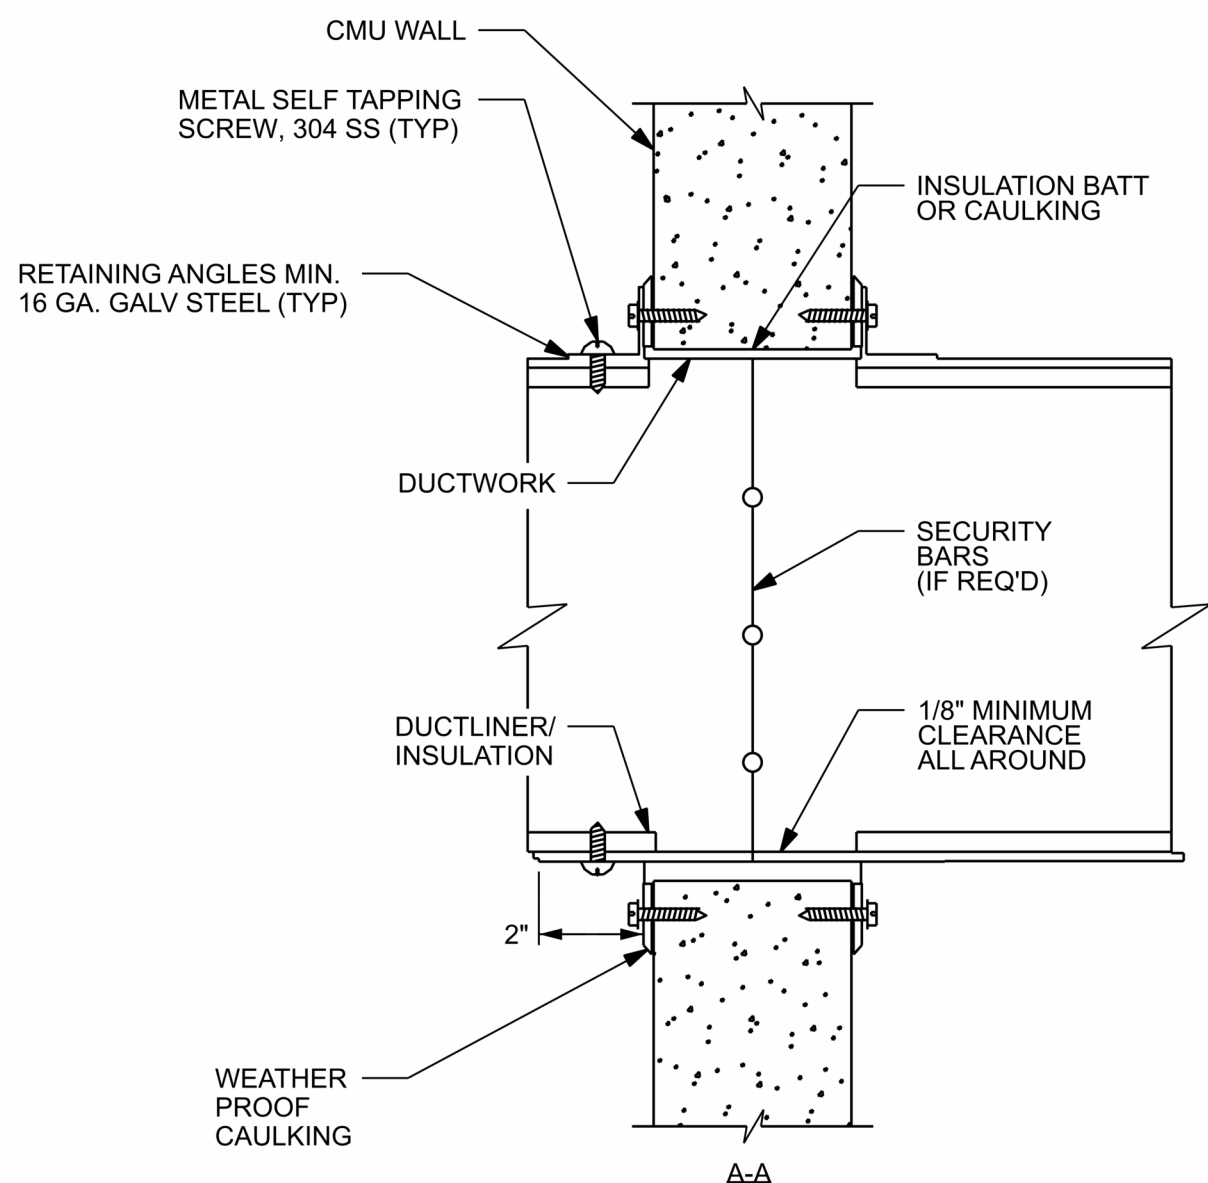


NOTES:

1. PROVIDE TAPCON SS ANCHOR MIN 1/4\", SIZED AS RECOMMENDED.
2. RETAINING ANGLES SIZED TO LAP DUCT A MIN OF 1-1/2\"/>

DUCT THRU WALL

4
H-S2-201 NTS

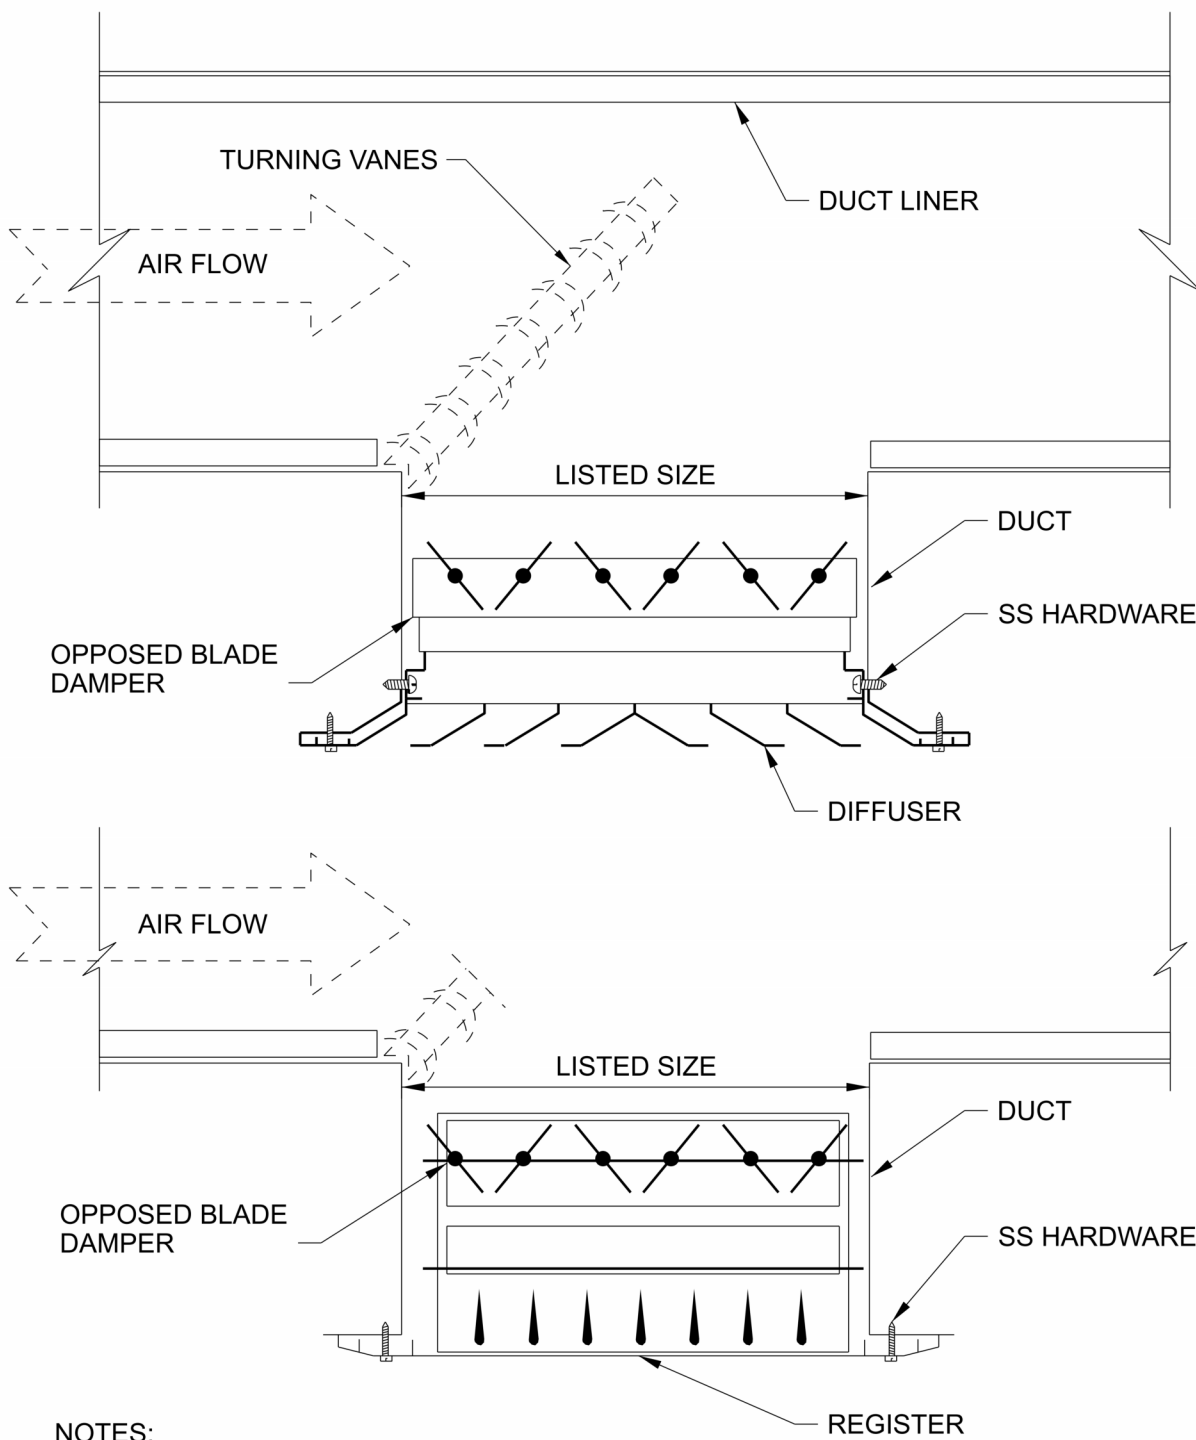


NOTES:

1. PROVIDE SPACING AS REQUIRED FOR DIFFUSER OR REGISTER / GRILLE.
2. PROVIDE TURNING VANES UNLESS OTHERWISE NOTED.


DUCT MOUNTED
DIFFUSER/ REGISTER

5
H-S2-101 NTS

NO.	DATE	REVISION	BY	APVD
-	-	-	-	-
-	-	-	-	-

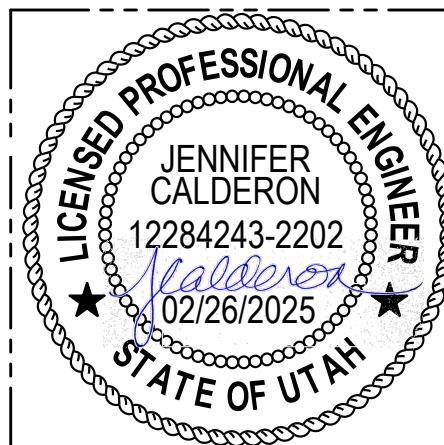


DATE
FEBRUARY 2025
PROJECT NUMBER
19-002
DRAWING NUMBER
H-S2-301
SHEET: OF

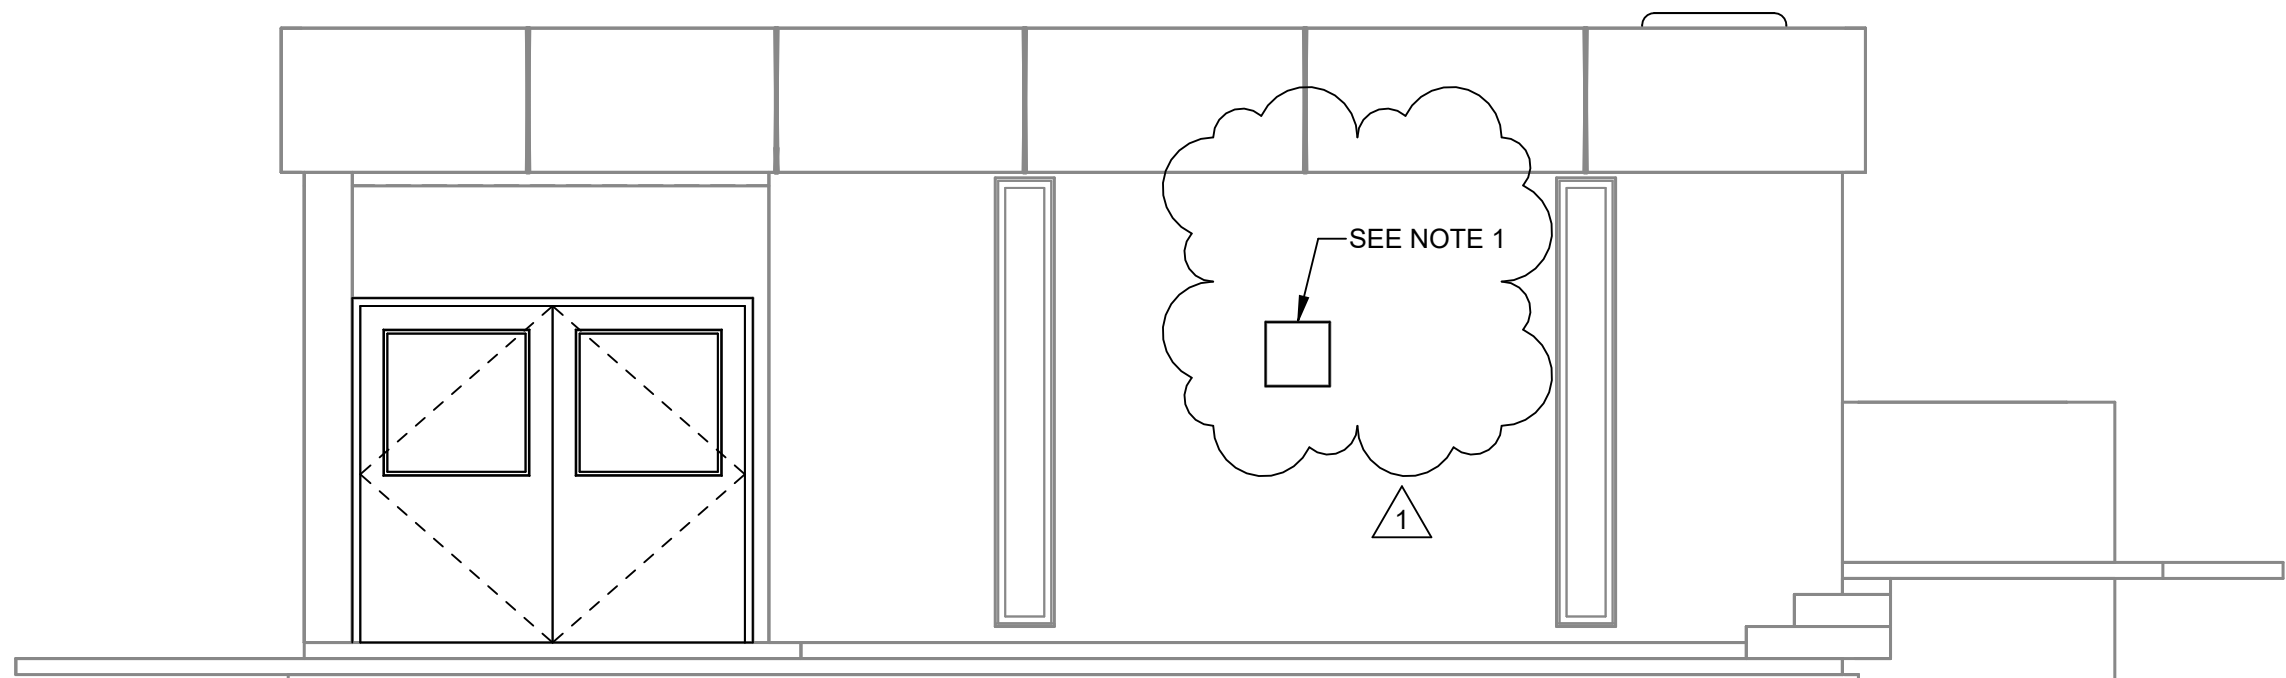

WEST ELEVATION

1/4" = 1'-0"

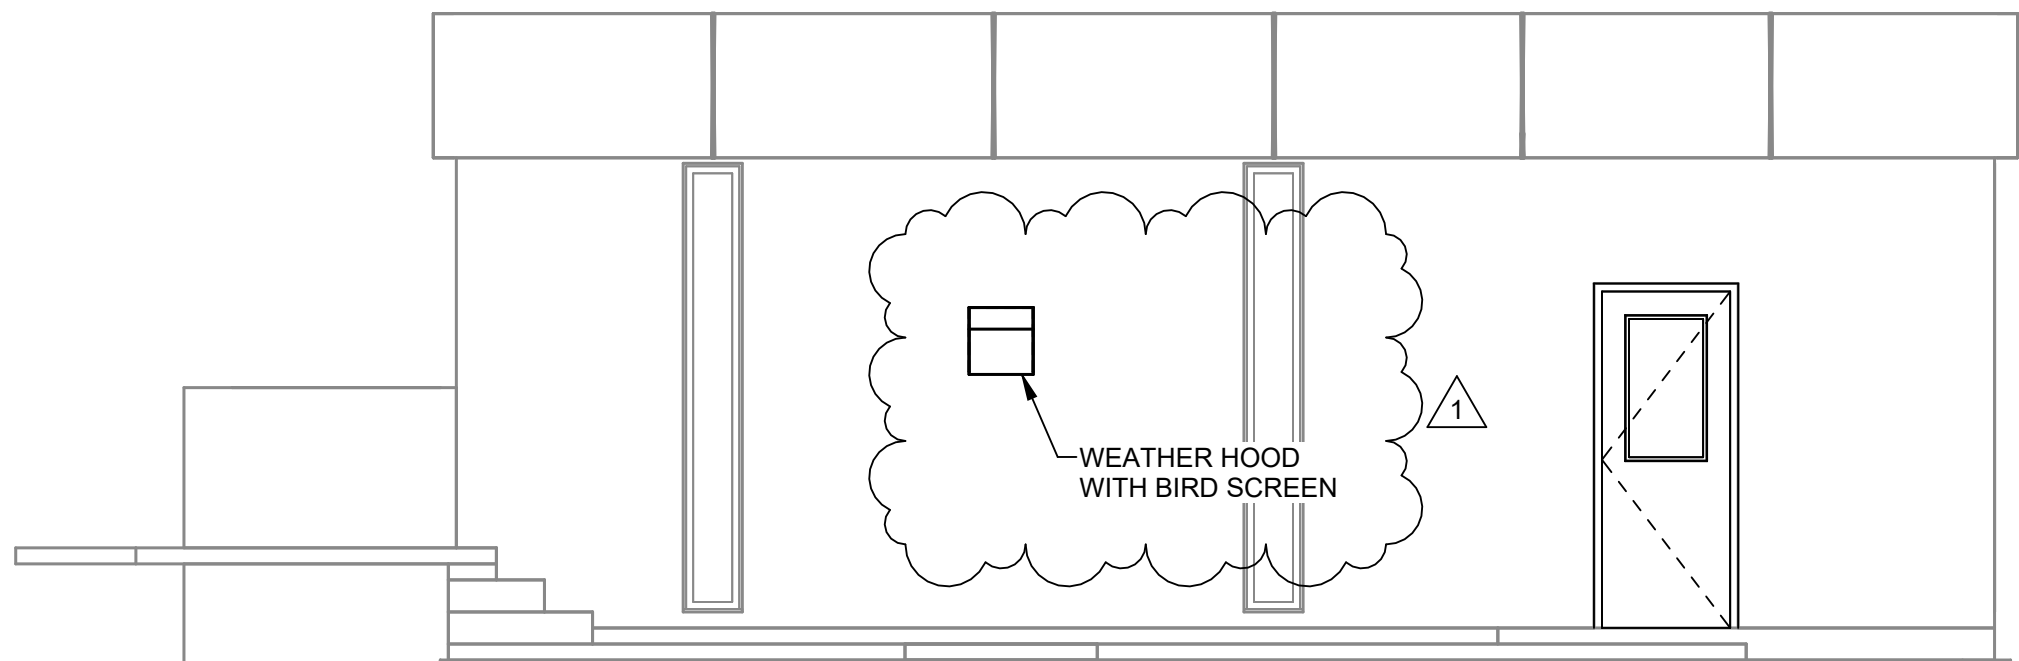

EAST ELEVATION

1/4" = 1'-0"

NOTES:

1. INSTALL A METAL PLATE, CUT TO APPROPRIATE SIZE, ENSURING IT EXTENDS AT LEAST 1 INCH BEYOND THE OPENING ON ALL SIDES. SECURE IT WITH MECHANICAL FASTENERS AND SEAL THE EDGS WITH AN APPROPRIATE SEALANT TO PREVENT AIR AND WATER PENETRATION.

VERIFY SCALE
BAR IS ONE INCH ON
ORIGINAL DRAWING.
DO NOT SCALE 1"
THIS SHEET, ADJUST
SCALES
ACCORDINGLY.

DESIGN
MC
DRAWN
DS
CHECKED
MC
APPROVED
JHM



WATERWORKS
ENGINEERS



PROVO CITY
PUBLIC WORKS DEPT
PROVO WRF
PHASE 1, ELEC. UPGRADES
PACKAGE A - S2 RE-FEED

HVAC
PRIMARY SLUDGE
PUMP STATION NO. 2
ELEVATIONS

DATE
FEBRUARY 2025
PROJECT NUMBER
19-002
DRAWING NUMBER
H-S2-401
SHEET: OF

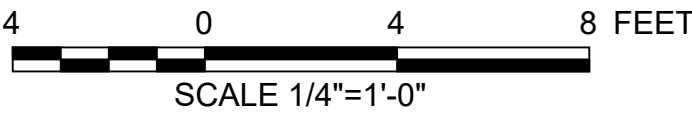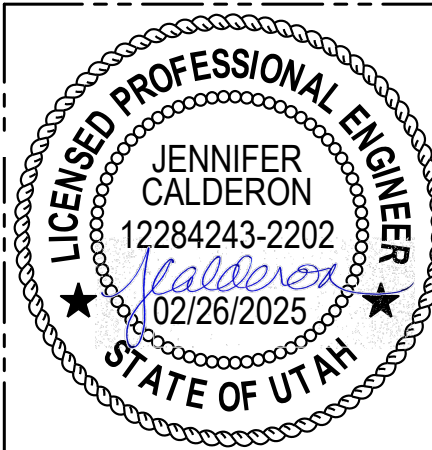

NO.	DATE	REVISION	BY	APVD
1	2/26/24	CHANGES AFTER 90% DESIGN	-	-

SINGLE LINE & CONTROL DIAGRAM SYMBOLS																	
PUSH BUTTONS			SELECTOR SWITCHES			FLOW & LEVEL SWITCHES			TIMERS			MISCELLANEOUS DEVICES (CONT)			CONDUITS & CONDUCTORS (CONT)		
NORMALLY OPEN (NO)	NORMALLY CLOSED (NC)	DESCRIPTION:	NORMALLY OPEN (NO)	NORMALLY CLOSED (NC)	DESCRIPTION:	NORMALLY OPEN (NO)	NORMALLY CLOSED (NC)	DESCRIPTION:	NORMALLY OPEN (NO)	NORMALLY CLOSED (NC)	DESCRIPTION:	SINGLE LINE / CONTROL DIAGRAM	DESCRIPTION:	SINGLE LINE / CONTROL DIAGRAM	DESCRIPTION:		
		EMERGENCY STOP PUSH BUTTON WITH RED MUSHROOM HEAD OPERATOR (MAINTAINED CONTACT)			FOUR (4) POSITION, FOUR (4) POLE SELECTOR SWITCH			LIQUID LEVEL (FLOAT) NO: CLOSURES ON RISING LEVEL NC: OPENS ON RISING LEVEL			ON DELAY NOTC: NORMALLY OPEN TIMED CLOSING, WHEN ENERGIZED NCTO: NORMALLY CLOSED TIMED OPENING, WHEN ENERGIZED			FIXED RESISTOR		CHASSIS GROUND	
		PUSH BUTTON, MOMENTARY CONTACT, SPRING RETURN						FLOW SWITCH (AIR, WATER, ETC.) NO: CLOSURES ON INCREASED FLOW NC: OPENS ON INCREASED FLOW			OFF DELAY NOTO: NORMALLY OPEN, TIMED OPENING WHEN DEENERGIZED NCTC: NORMALLY CLOSED, TIMED CLOSING WHEN DEENERGIZED			VARIABLE RESISTOR		NEUTRAL	
		START/STOP PUSH BUTTON CONTROL STATION, MAINTAINED CONTACT WITH LOCKOUT DEVICE ON STOP														SEPARABLE CONNECTOR SIFICATION SHOWN.	
PILOT LIGHTS			RELAYS			OTHER SWITCHES			TERMINALS & CONNECTORS						MOTOR		
		PUSH TO TEST, 110V S6 LAMP UNLESS NOTED. LETTER IS LENS COLOR: R = RED G = GREEN A = AMBER Y = YELLOW B = BLUE W = WHITE C = CLEAR			RELAY CONTACT: NORMALLY OPEN (NO) NORMALLY CLOSED (NC)			AUXILIARY SWITCH CONTACT			TOGGLE SWITCH			DOT		MOTOR STARTER COIL	
SELECTOR SWITCHES					CONTROL RELAY COIL NUMBER AS INDICATED			FOOT SWITCH			PROXY SWITCH			SQUARE		MOTOR	
		TWO (2) POSITION SELECTOR SWITCH			LATCH RELAY COIL			PULL CORD			A-PLUG			HEXAGON		OVERLOAD	
		TWO (2) POSITION, TWO (2) POLE SELECTOR SWITCH			UNLATCH RELAY COIL			PHOTO EYE			SINGLE POLE DOUBLE THROW (SPDT) MAINTAIN			DIAMOND		RESISTOR OR RESISTIVE ELEMENT	
		TWO (2) POSITION, THREE (3) POLE SELECTOR SWITCH	LIMIT SWITCHES					SINGLE POLE DOUBLE THROW (SPDT) RETURN FROM DOWN			SINGLE POLE DOUBLE THROW (SPDT) RETURN FROM UP			TRIANGLE		STRIP HEATER OR HEATING ELEMENT	
		THREE (3) POSITION SELECTOR SWITCH			POSITION (LIMIT) SWITCH NO: HELD CLOSED NC: HELD OPEN			SINGLE POLE DOUBLE THROW (SPDT) RETURN FROM BOTH						POWER DISTRIBUTION BOX		HIGH VOLTAGE, GROUP OPERATED, AIR BREAK SWITCH * CONTINUOUS AMPERE RATING	
		THREE (3) POSITION, THREE (3) POLE SELECTOR SWITCH			TORQUE SWITCH NO: CLOSURES ON HIGH TORQUE NC: OPENS ON HIGH TORQUE									PLUG / JACK		MOTOR CONTACT: NORMALLY OPEN (NO) NORMALLY CLOSED (NC)	
		FOUR (4) POSITION SELECTOR SWITCH	PRESSURE & TEMPERATURE SWITCHES											JACK / PLUG		KVAR CAP	
					PRESSURE SWITCH NO: CLOSURES ON RISING PRESSURE NC: OPENS ON RISING PRESSURE									PLUG RIGHT OR UP		THREE PHASE KVAR	
					VACUUM SWITCH NO: CLOSURES ON RISING PRESSURE NC: OPENS ON RISING PRESSURE									JACK LEFT OR DOWN			
					DIFFERENTIAL PRESSURE SWITCH NO: CLOSURES ON RISING DIFFERENTIAL PRESSURE NC: OPENS ON RISING DIFFERENTIAL PRESSURE									IN LEFT TOP			
					TEMPERATURE SWITCH NO: CLOSURES ON RISING TEMPERATURE NC: OPENS ON RISING TEMPERATURE									IN BOTH TOP			
														OUT RIGHT TOP			
														OUT BOTH TOP			
						TIMERS			MISCELLANEOUS DEVICES			CONDUITS & CONDUCTORS					
								ON DELAY COIL			BELL			CONDUCTORS NOT CONNECTED		CONDUCTORS CONNECTED	
								ON DELAY MOTOR			BUZZER			CONDUCTOR SHIELD		CONDUCTOR SHIELD TWISTED PAIR	
								OFF DELAY MOTOR			HORN			FIELD CONDUCTOR SHIELD		FIELD CONDUCTOR SHIELD TWISTED PAIR	
											VOLT METER			EARTH GROUND			
											AMP METER						
											BATTERY						

VERIFY SCALE

BARS ONE INCH ON ORIGINAL DRAWING.

0 1" IF NOT ONE INCH ON THIS SHEET, ADJUST SCALES ACCORDINGLY.

DESIGN

TCA

DRAWN

TCA

CHECKED

BGY

APPROVED

UJHM

WATERWORKS

ENGINEERS

PROVO CITY

PUBLIC WORKS DEPT

PROVO WRF

PHASE 1, ELEC. UPGRADES

PACKAGE A - S2 RE-FEED

ELECTRICAL

LEGEND 1

DATE

FEBRUARY 2025

PROJECT NUMBER

19-002

DRAWING NUMBER

E-GN-001

SHEET

OF

BRIAN G. YOUNG

























NO. 8841511

02/26/2025

STATE OF UTAH

LICENSED PROFESSIONAL ENGINEER

 PLAN VIEW SYMBOLS

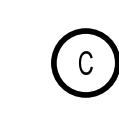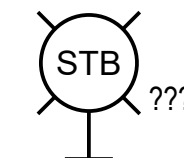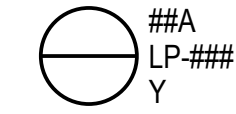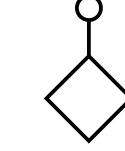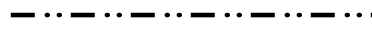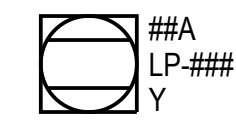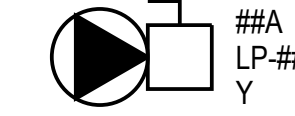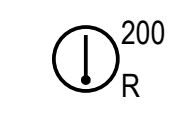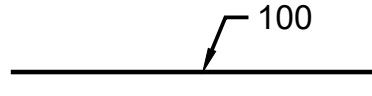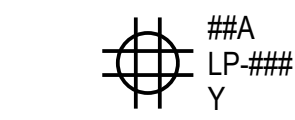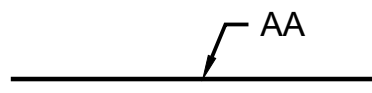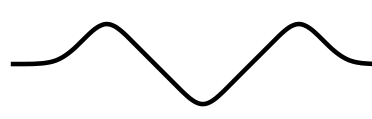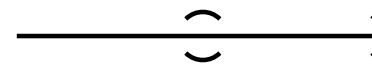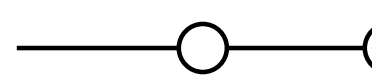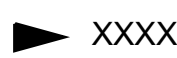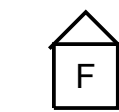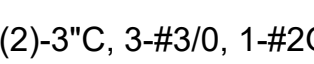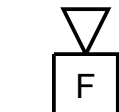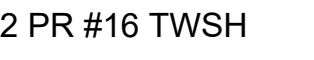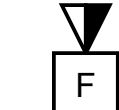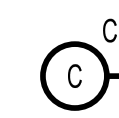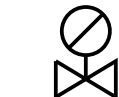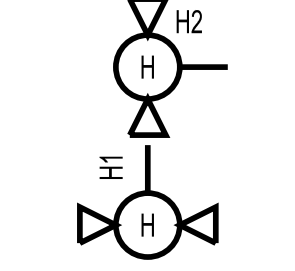CONDUIT		POWER RECEPTACLES		TELECOMMUNICATION SYSTEM (CONT)		FIRE ALARM / LIFE SAFETY (CONT)		AREA CLASSIFICATION	
PLAN VIEW	DESCRIPTION:	PLAN VIEW	DESCRIPTION:	PLAN VIEW	DESCRIPTION:	PLAN VIEW	DESCRIPTION:	PLAN VIEW	DESCRIPTION:
	EXPOSED CONDUIT		208V, 3P, 4W, RECEPTACLE ##A = AMPERE RATING AS NOTED LP-##= PANEL BOARD NUMBER Y= CIRCUIT NUMBER		C2 PAGING SPEAKER, FLUSH MOUNTED CEILING TYPE		STB ??? WEATHERPROOF HIGH DENSITY FIRE ALARM STROBE LIGHT		INDICATES THAT ALL ELECTRICAL EQUIPMENT AND MATERIALS INSTALLED WITHIN THE ROOM OR AREA IN WHICH THIS NOTATION APPEARS SHALL BE OF NEMA 12 CONSTRUCTION (OR GASKETED AND SUITABLE FOR USE IS A WET LOCATION WHERE NEMA STANDARDS DO NOT APPLY) UNLESS OTHERWISE NOTED.
	HIDDEN / CONCEALED CONDUIT		240V, 20, 3W, RECEPTACLE ##A = AMPERE RATING AS NOTED LP-##= PANEL BOARD NUMBER Y= CIRCUIT NUMBER		S PAGING STATION, SURFACE MOUNTED		SPRINKLER FLOW ALARM SWITCH		
	UNDERGROUND CONDUIT		##A LP-## Y FLOOR OUTLET BOX WITH TYPE OUTLET INDICATED		VC REMOTE WALL MOUNTED VOLUME CONTROL. FOR CEILING SPEAKER (MOUNT UP 5'-0" AFF UNO)		CM ADDRESSABLE CONTROL MODULE		INDICATES THAT ALL ELECTRICAL EQUIPMENT AND MATERIALS INSTALLED WITHIN THE ROOM OR AREA IN WHICH THIS NOTATION APPEARS SHALL BE OF NEMA 4X CONSTRUCTION (OR GASKETED AND SUITABLE FOR USE IN A WET LOCATION WHERE NEMA STANDARDS DO NOT APPLY) UNLESS OTHERWISE NOTED.
	DUCT BANK		480V, 3P, 4W RECEPTACLE AND DISCONNECT SWITCH ##A = AMPERE RATING AS NOTED X = PANEL BOARD NUMBER Y = CIRCUIT NUMBER		A PAGING SPEAKER AMPLIFIER ASSEMBLY		MM ADDRESSABLE MONITOR MODULE		
	OVERHEAD POWER LINES			FIRE ALARM / LIFE SAFETY					
	GROUNDING CONDUCTOR		DUPLEX RECEPTACLE, 20A, 120V, 2P, 3W UNLESS OTHERWISE NOTED * =C - MOUNTED ABOVE COUNTERTOP GF - GROUND FAULT INTERRUPTER TYPE WP - WEATHERPROOF T - TRANSIENT VOLTAGE SURGE SUPPRESSER X= PANEL BOARD NUMBER Y= CIRCUIT NUMBER		200 R FIRE ALARM HEAT DETECTOR 135Y FIXED TEMPERATURE UNLESS OTHER- WISE NOTED. "200" DENOTES 200YF TYPE "R" DENOTES FIXED TEMPERATURE RATE-OF-RISE TYPE.		SD SMOKE DETECTOR		INDICATES THAT ALL ELECTRICAL EQUIPMENT AND MATERIALS INSTALLED WITHIN THE ROOM OR AREA IN WHICH THIS NOTATION APPEARS SHALL BE OF NEMA 4X CONSTRUCTION (OR GASKETED AND SUITABLE FOR USE IN A WET LOCATION WHERE NEMA STANDARDS DO NOT APPLY) UNLESS OTHERWISE NOTED.
	CONDUITS IDENTIFIED BY A NUMBER SHALL BE LISTED IN THE CONDUIT BLOCK DIAGRAM		##A LP-## Y QUAD RECEPTACLE, 20A, 120V, 2P, 3W UNLESS OTHERWISE NOTED NOTATION SAME AS ABOVE		I DSD FIRE ALARM DUCT SMOKE DETECTOR PHOTOCELL TYPE UNLESS OTHERWISE NOTED. "I" DENOTES IONIZATION TYPE.		2 DSD FIRE ALARM DUCT SMOKE DETECTOR		INDICATES THAT ALL ELECTRICAL EQUIPMENT AND MATERIALS INSTALLED WITHIN THE ROOM OR AREA IN WHICH THIS NOTATION APPEARS SHALL CONFORM TO N.E.C. REQUIREMENTS FOR THE HAZARDOUS AREA CLASSIFICATION SHOWN.
	CONDUITS IDENTIFIED BY LETTERS SHALL CONFORM TO THE TABLES IN THE LEGEND			SECURITY SYSTEM					
	CONDUIT STUBBED OUT AND CAPPED		KP SECURITY SYSTEM KEY PAD		FACP-#### FIRE ALARM CONTROL PANEL				
	FLEXIBLE CONDUIT OR MANUFACTURER'S CABLE(S)		CR SECURITY SYSTEM CARD ACCESS READER		FAVP-#### FIRE ALARM VENTILATION PANEL (WITH GRAPHIC PANEL)				
	CONDUIT TURNED DOWN		MD SECURITY ALARM MOTION DETECTOR		FARAP-#### FIRE ALARM REMOTE ANNUNCIATOR				
	CONDUIT TURNED UP		CCTV CLOSED CIRCUIT TV CAMERA		M WP FIRE ALARM MANUAL PULL STATION, MOUNT UP 4'-0" WP DENOTES WEATHERPROOF COVER				
	INDICATES LIMITS OF EQUIPMENT OR WIRING ENCLOSURE			TELECOMMUNICATION SYSTEM					
	CONDUIT HOME RUN. XXX DENOTES DESTINATION CONTRACTOR SHALL FIELD ROUTE FROM EQUIPMENT TO DESIGNATED LOCATION		TTB TELEPHONE TERMINAL BOARD 4FT X 8FT X 3/4 INCH UNLESS NOTED OTHERWISE		F OUTDOOR WEATHERPROOF FIRE ALARM MASTER BOX				
	DENOTES A QUANTITY OF TWO (2) 3-INCH CONDUITS EACH CONTAINING THREE NO. 3/0 AWG CONDUCTORS AND 1 NO. 2 AWG GROUND CONDUCTOR		TELEPHONE OUTLET, WALL TYPE (MOUNT 1'-6" AFF UNO)		F WP FIRE ALARM SPEAKER, MOUNT UP 7'-8"				
	DENOTES A QUANTITY OF TWO INSTRUMENT CABLES. EACH CABLE TO CONSIST OF TWO NO. 16 AWG CONDUCTORS TWISTED TOGETHER AND COVERED WITH A METALLIC SHIELD AND AN OVERALL PROTECTIVE JACKET. REFER TO THE SPECIFICATIONS FOR THE EXACT CABLE TO BE PROVIDED.		TELEPHONE OUTLET AND FLOOR BOX		S FIRE ALARM STROBE, WALL MOUNT UP 6'-8" OR AT CEILING				
	SAME AS ABOVE EXCEPT CABLE TO CONSIST OF THREE NO. 16 AWG CONDUCTORS TWISTED, SHIELDED AND COVERED WITH AN OVERALL PROTECTIVE JACKET. REFER TO THE SPECIFICATIONS FOR THE EXACT CABLE TO BE PROVIDED.		TELEPHONE/ DATA OUTLET, WALL TYPE (MOUNT 1'-6" AFF UNO)		F FIRE ALARM HORN AND STROBE LIGHT COMBINATION, MOUNT UP 6'-8"				
	DENOTES A QUANTITY OF TWO INSTRUMENT CABLES. EACH CABLE TO CONSIST OF TWO NO. 16 AWG CONDUCTORS TWISTED TOGETHER AND AN OVERALL PROTECTIVE JACKET. REFER TO THE SPECIFICATIONS FOR THE EXACT CABLE TO BE PROVIDED.		TELEPHONE/ DATA OUTLET AND FLOOR BOX		F FIRE ALARM HORN AND STROBE LIGHT COMBINATION, CEILING MOUNT				
	THREE 4-INCH CONDUITS		C1 PAGING SPEAKER, WALL MOUNTED "H1" AND "C1" DENOTES TYPE. H=HORNC=CONE		SPRINKLER VALVE SUPERVISORY SWITCH				
			H2 PAGING SPEAKER, WALL MOUNTED, BIDIRECTIONAL NOTATIONS SAME AS ABOVE		F FIRE ALARM BELL				


[illegible]




A PACKAGE A - S2 RE-FEED

DATE	
FEBRUARY 2025	
PROJECT NUMBER	
19-002	
DRAWING NUMBER	
E-GN-019	
SHEET	OF

NO.	DATE	REVISION	BY	APVD

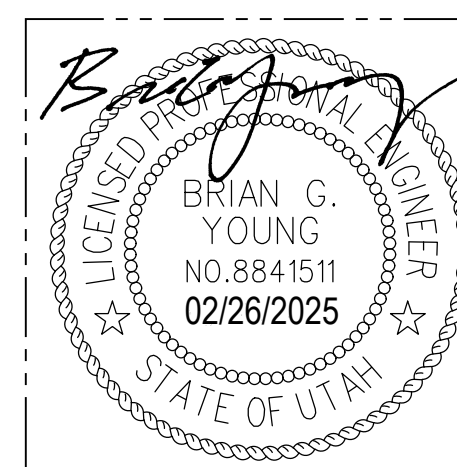


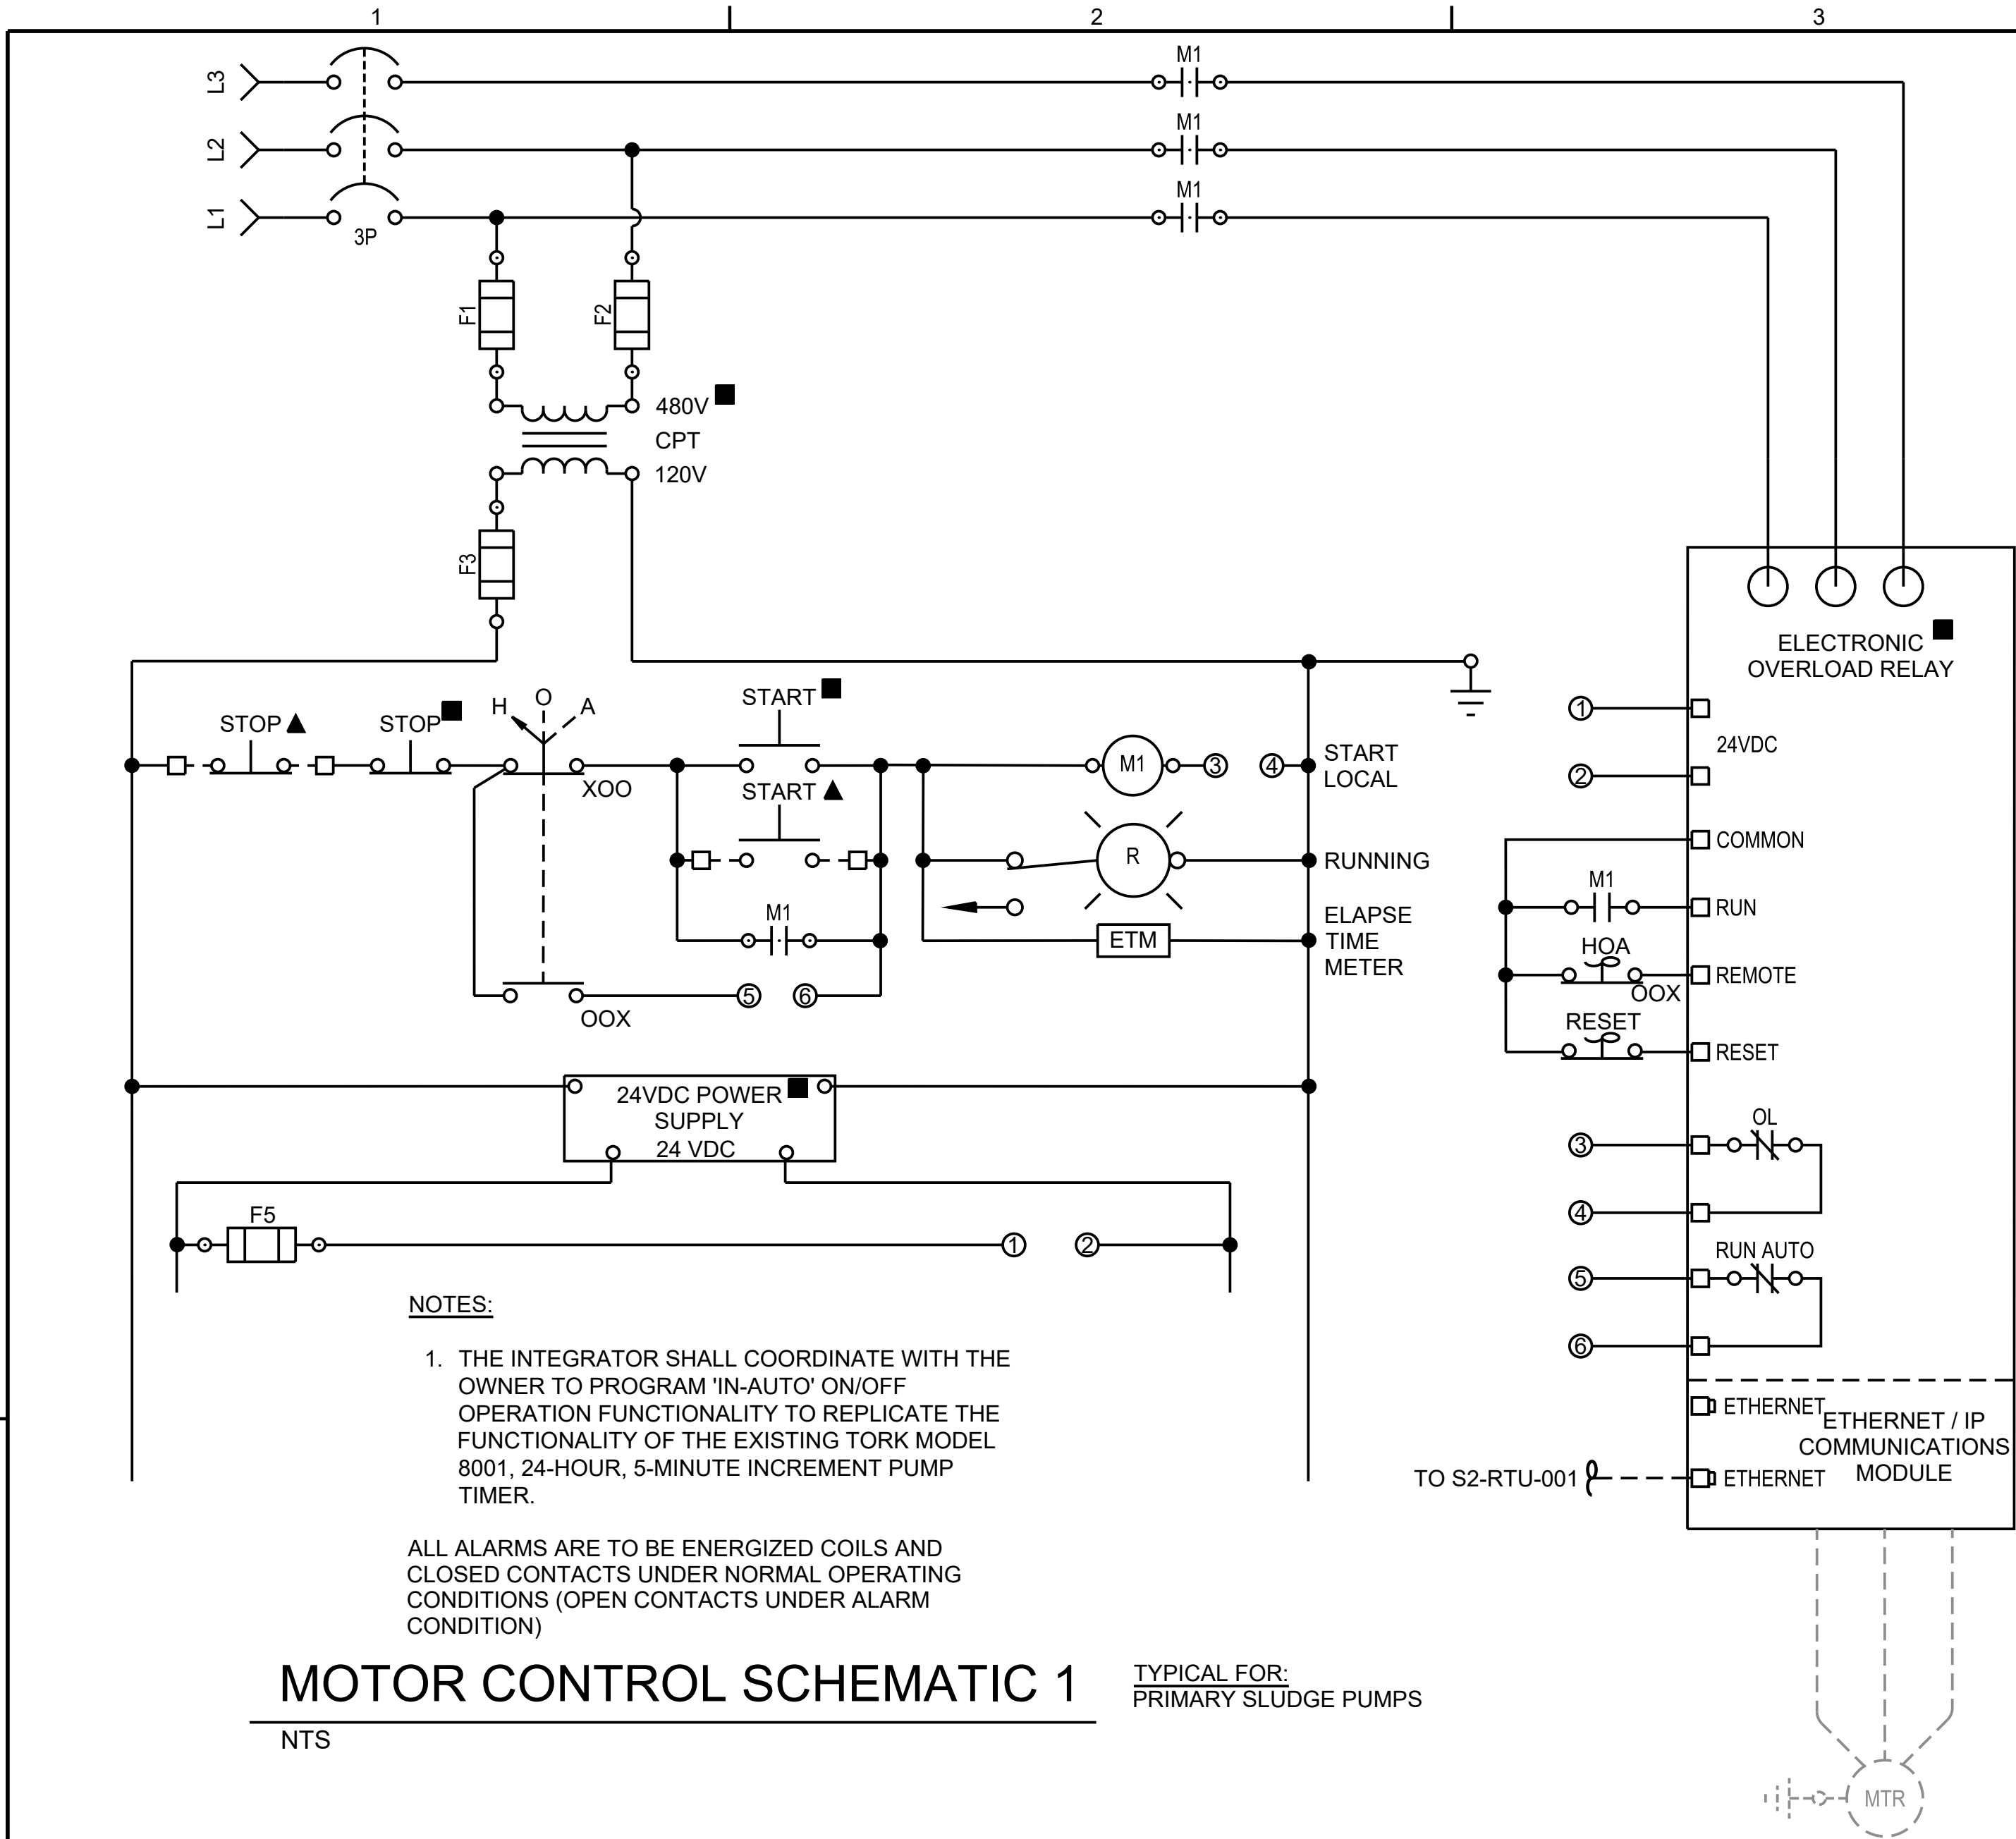

MOTOR CONTROL SCHEMATIC 1

TYPICAL FOR:
PRIMARY SLUDGE PUMPS



NTS

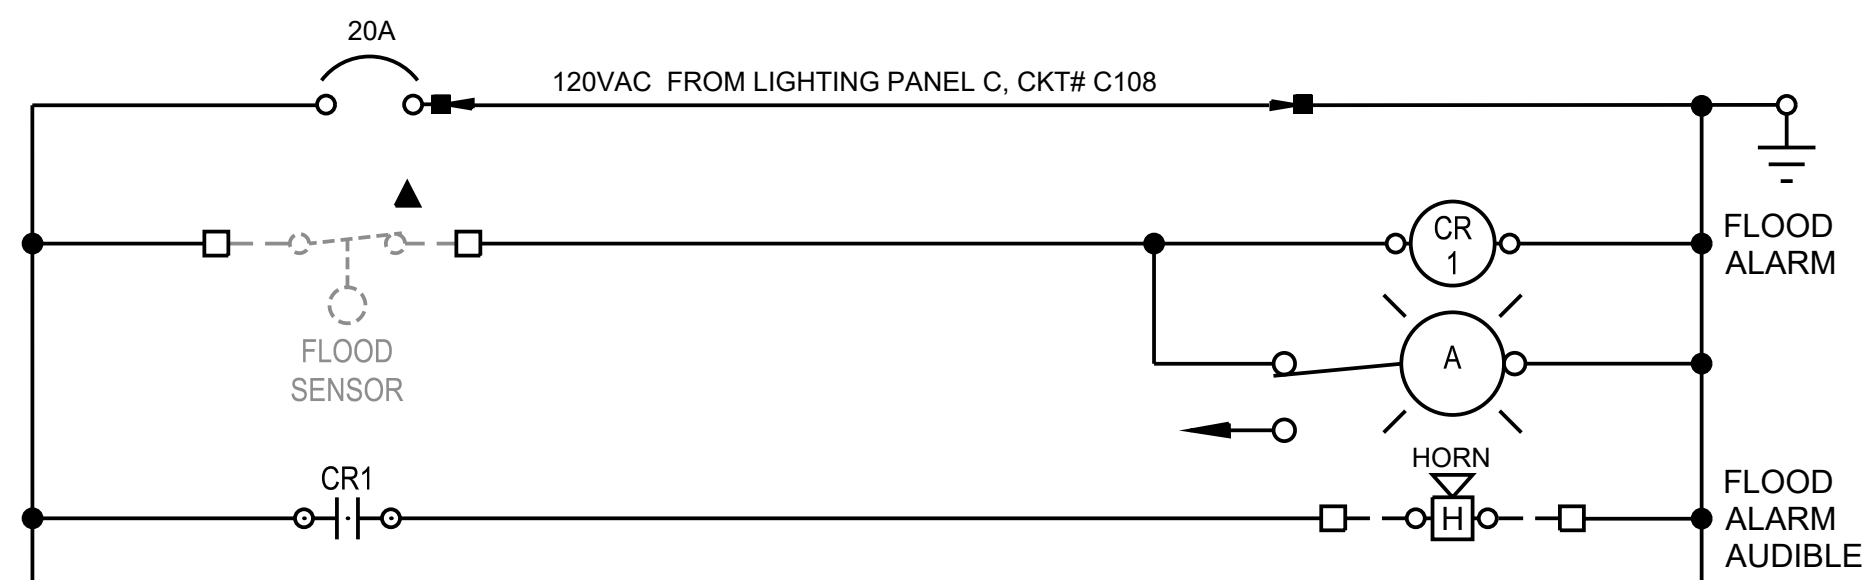

12"X16"X8" FLOOD ALARM CONTROL PANEL

S2-FLD-001 FLOOD ALARM
CONTROL PANEL SCHEMATIC

NTS

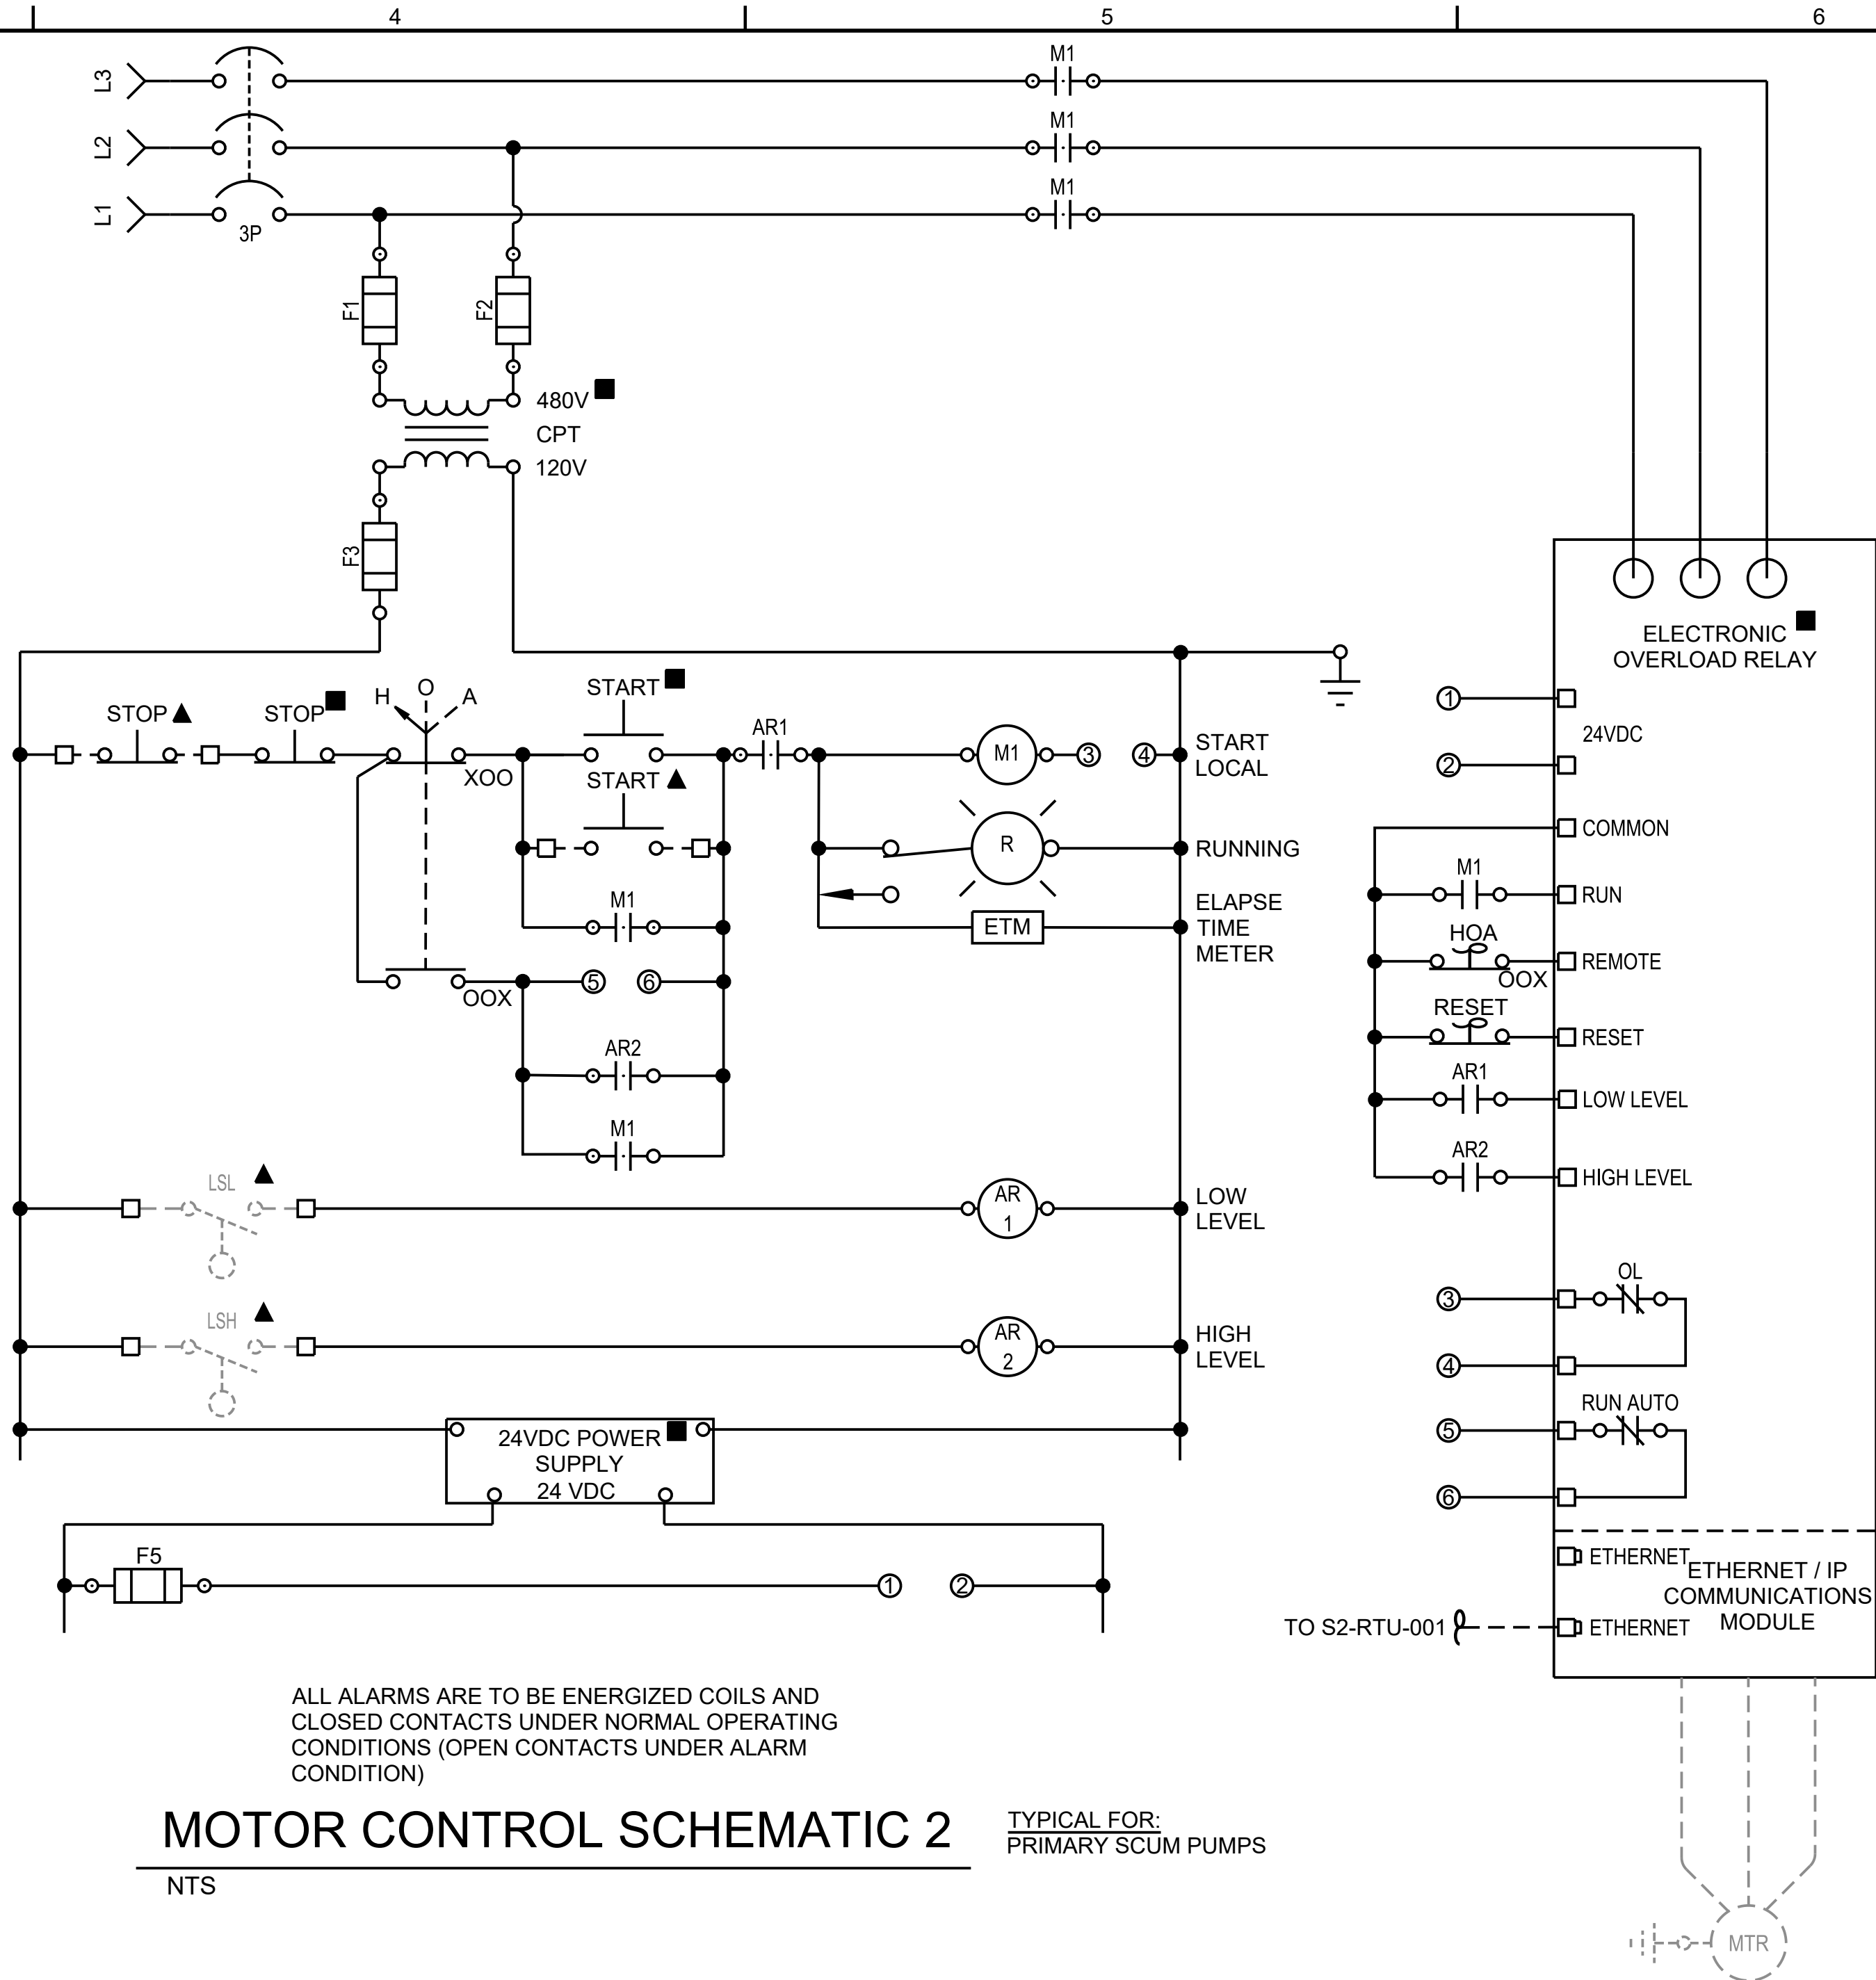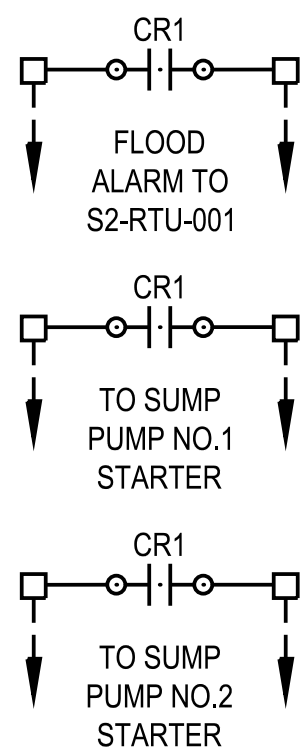

MOTOR CONTROL SCHEMATIC 2

TYPICAL FOR:
PRIMARY SCUM PUMPS


NTS

NOTES:

- THE CONTRACTOR SHALL BE ALLOWED TO COMBINE LIKE CIRCUITS WHERE APPROPRIATE WITH ENGINEERS APPROVAL.
- REFER TO ONE LINE DIAGRAMS.


SYMBOLS

- ON VFD
- LOCATED AT MCC BUCKET
- LOCAL TO PLC
- DEVICE TERMINAL
- LOCATED AT LOCAL CONTROL STATION (LCS)

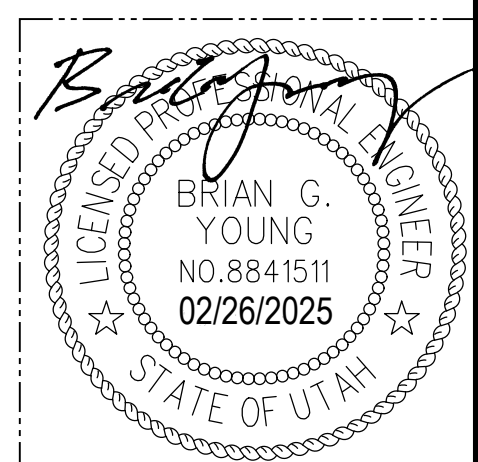

NO.	DATE	REVISION	BY	APVD


VERIFY SCALE	DESIGN	DESIGN	DESIGN	DESIGN	DESIGN
BAR IS ONE INCH ON ORIGINAL DRAWING.	TCA	TCA	TCA	TCA	TCA
IF NOT ONE INCH ON THIS SHEET, ADJUST SCALES ACCORDINGLY.	0	1	2	3	4
1"	0	1	2	3	4
0	1	2	3	4	5
1	2	3	4	5	6
2	3	4	5	6	7
205	206	207	208	209	210

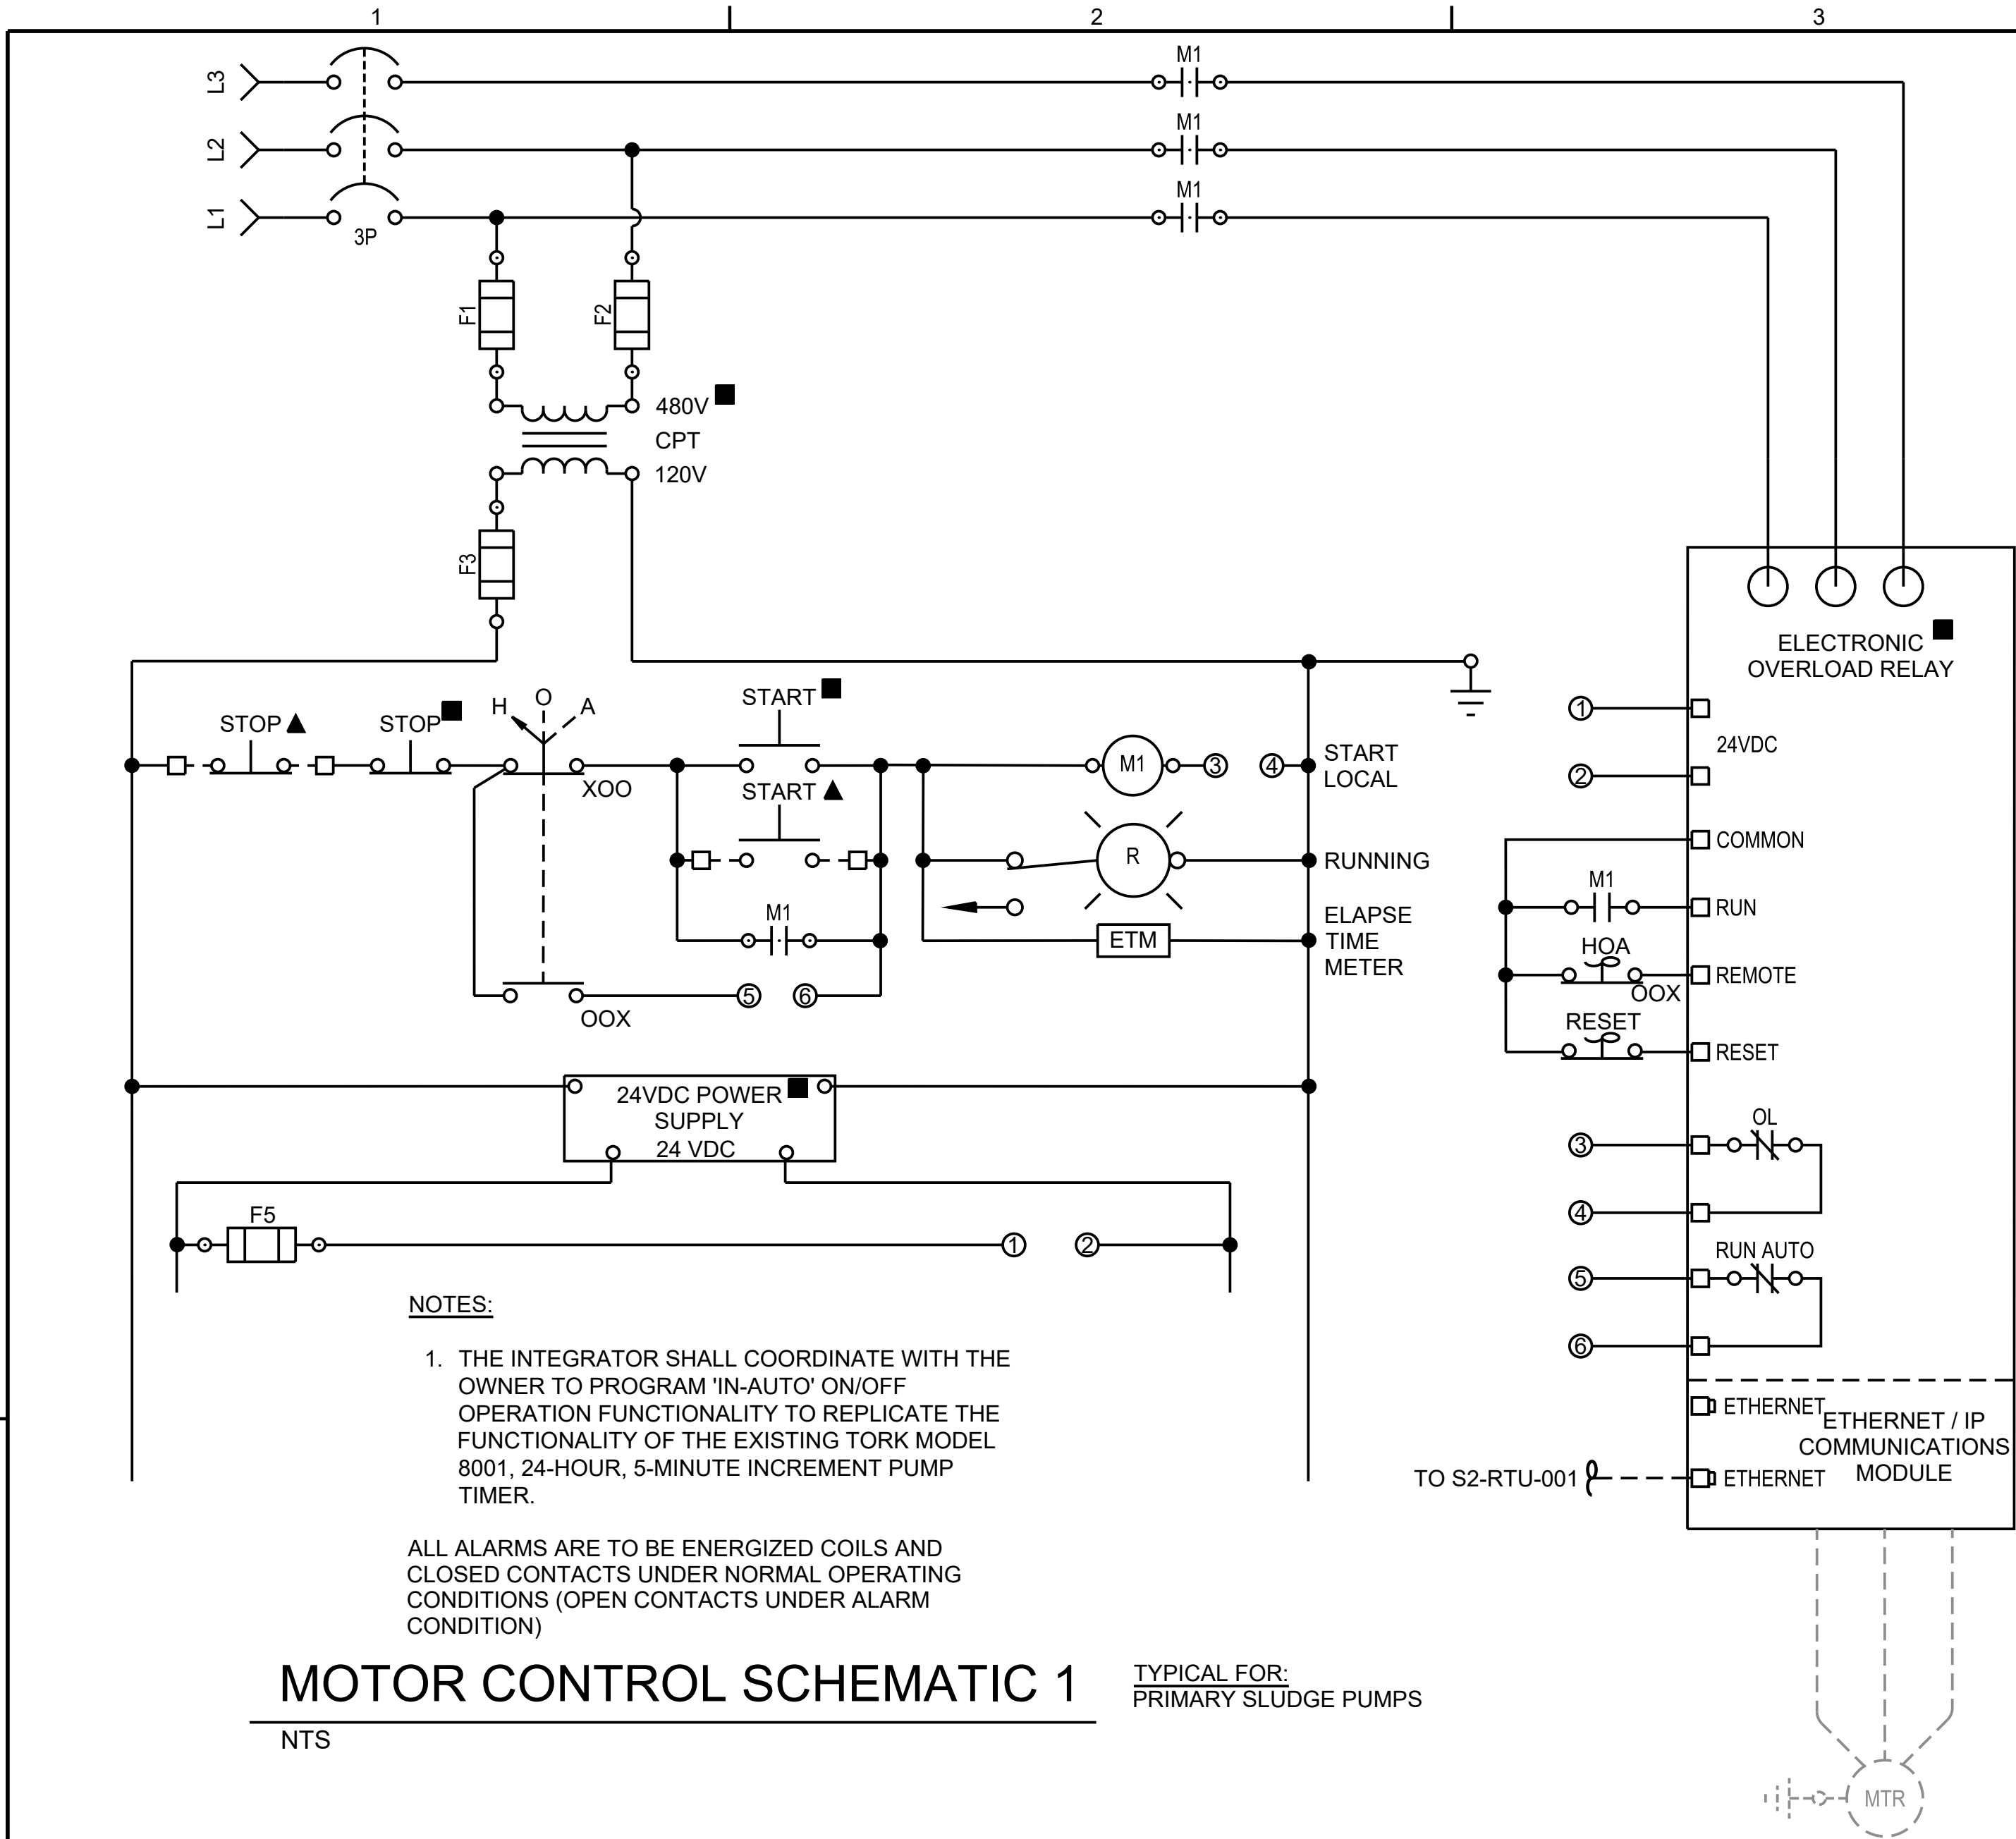

MOTOR CONTROL SCHEMATIC 1

NTS

TYPICAL FOR:
PRIMARY SLUDGE PUMPS

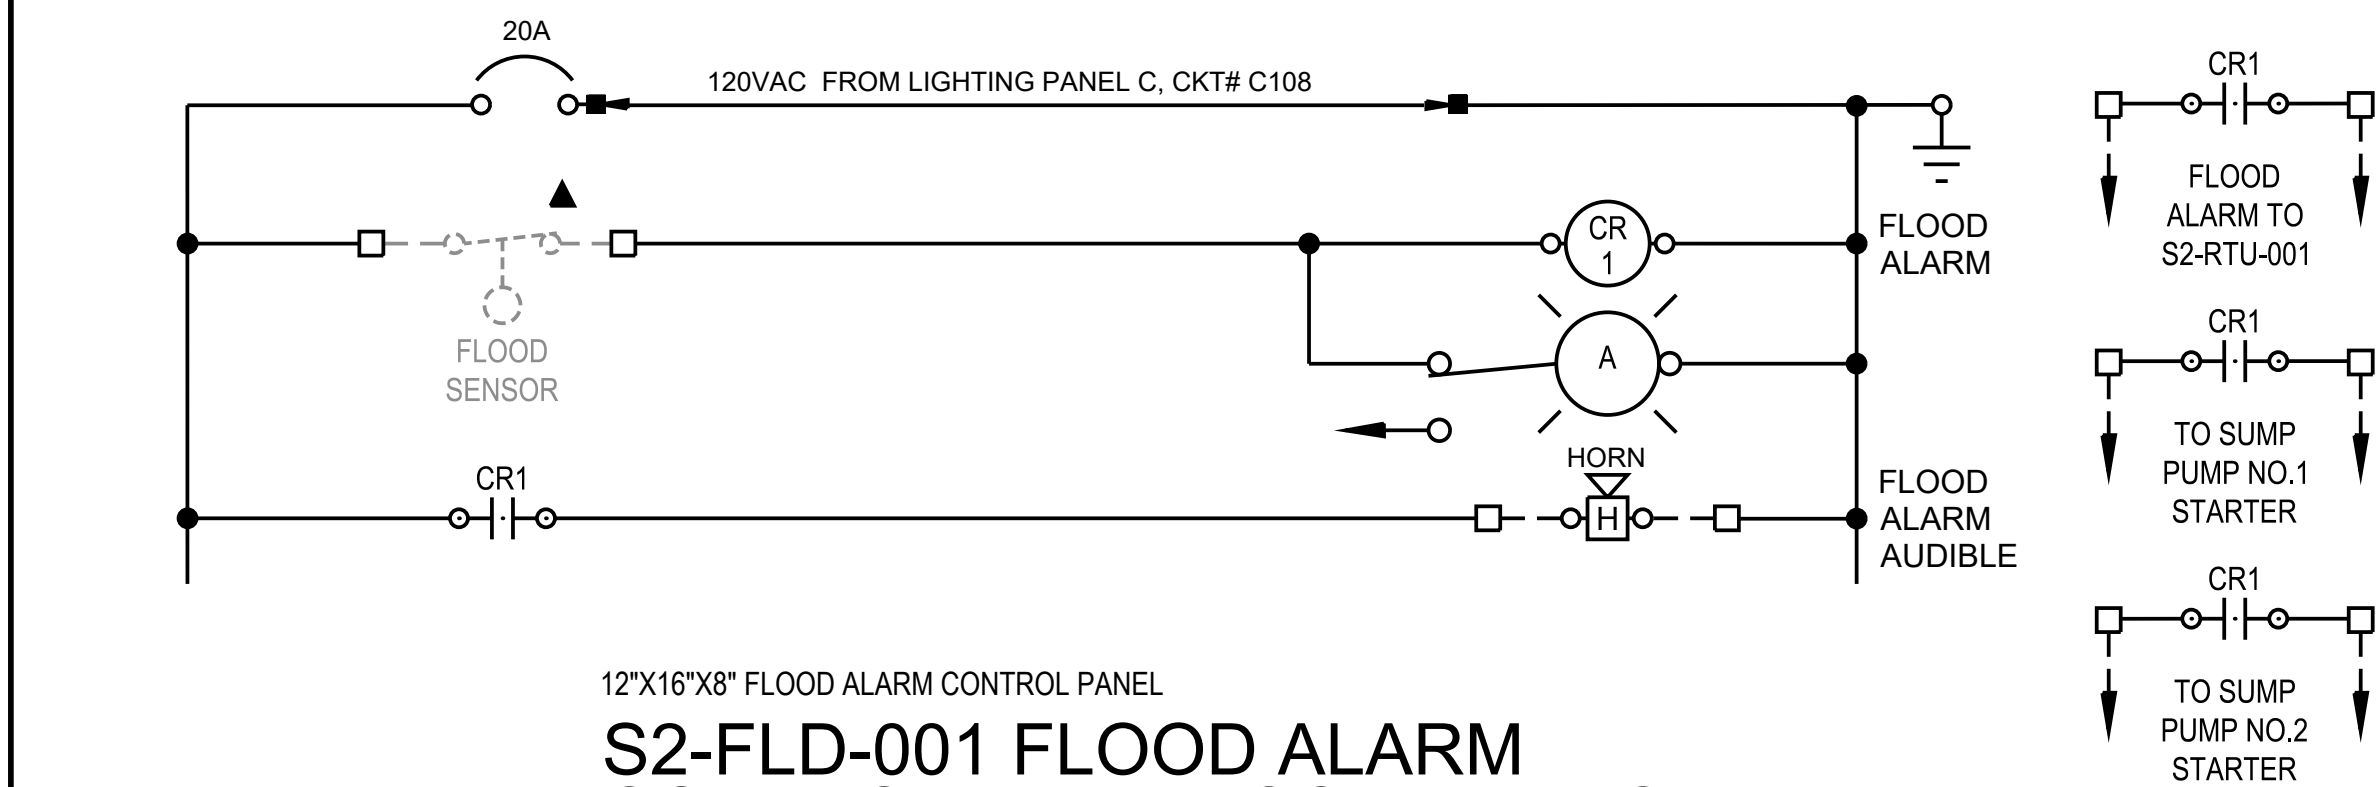


12"X16"X8" FLOOD ALARM CONTROL PANEL

S2-FLD-001 FLOOD ALARM CONTROL PANEL SCHEMATIC

NTS

NO.	DATE	REVISION	BY	APVD

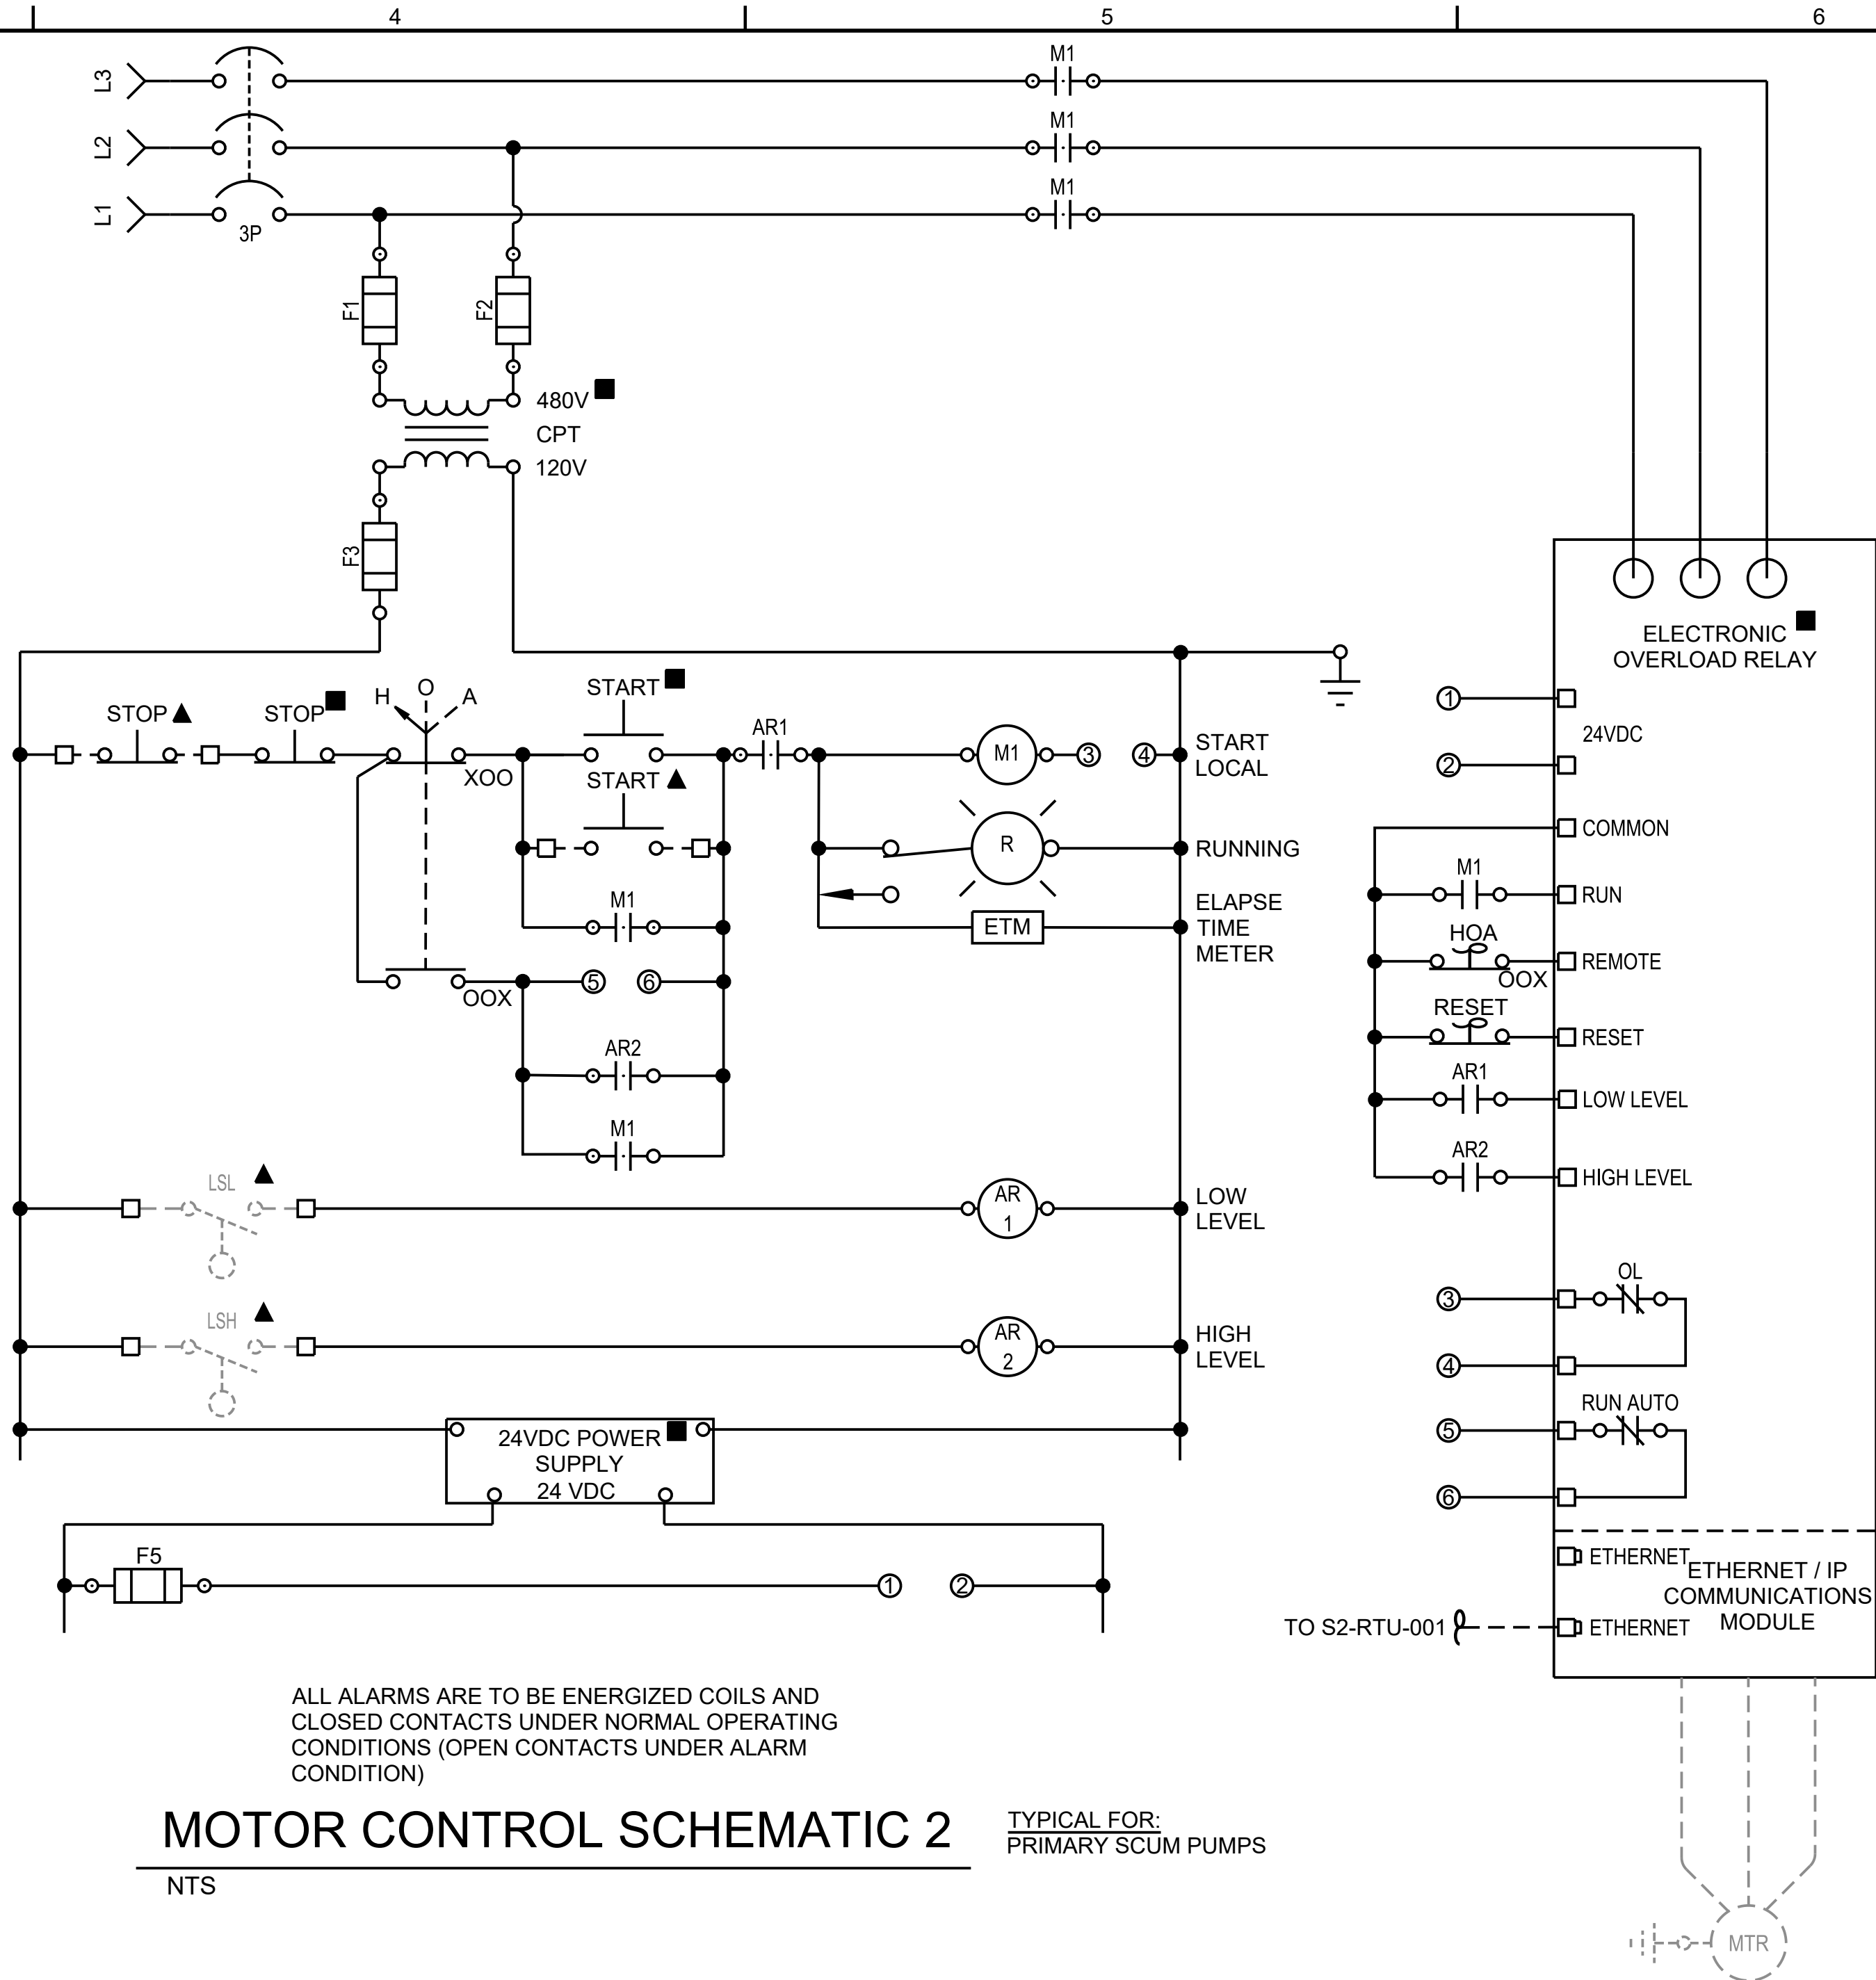

MOTOR CONTROL SCHEMATIC 2

NTS


TYPICAL FOR:
PRIMARY SCUM PUMPS

NOTES:


- THE CONTRACTOR SHALL BE ALLOWED TO COMBINE LIKE CIRCUITS WHERE APPROPRIATE WITH ENGINEERS APPROVAL.
- REFER TO ONE LINE DIAGRAMS.

SYMBOLS

- ON VFD
- LOCATED AT MCC BUCKET
- LOCAL TO PLC
- DEVICE TERMINAL
- LOCATED AT LOCAL CONTROL STATION (LCS)

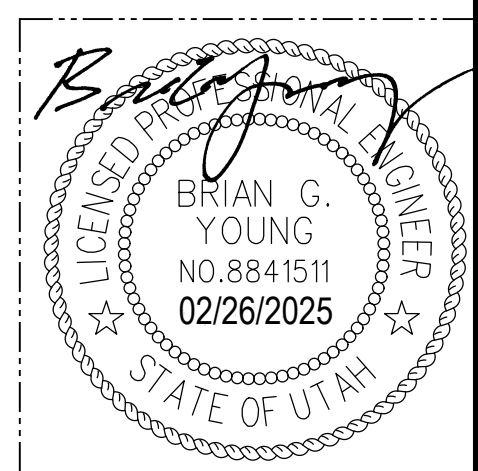

VERIFY SCALE	DESIGN	DRAWN	CHECKED	APPROVED	JHM
BAR IS ONE INCH ON ORIGINAL DRAWING. IF NOT ONE INCH ON THIS SHEET, ADJUST SCALES ACCORDINGLY.	TCA	TCA	BGY	JHM	JHM
WATERWORKS ENGINEERS	PROVO CITY PUBLIC WORKS DEPT	PROVO WRF	PHASE 1, ELEC. UPGRADES	PACKAGE A - S2 RE-FEED	SCHEMATICS 1
ELECTRICAL	DATE	PROJECT NUMBER	DRAWING NUMBER	SHEET	OF
	FEBRUARY 2025	19-002	E-GN-521		

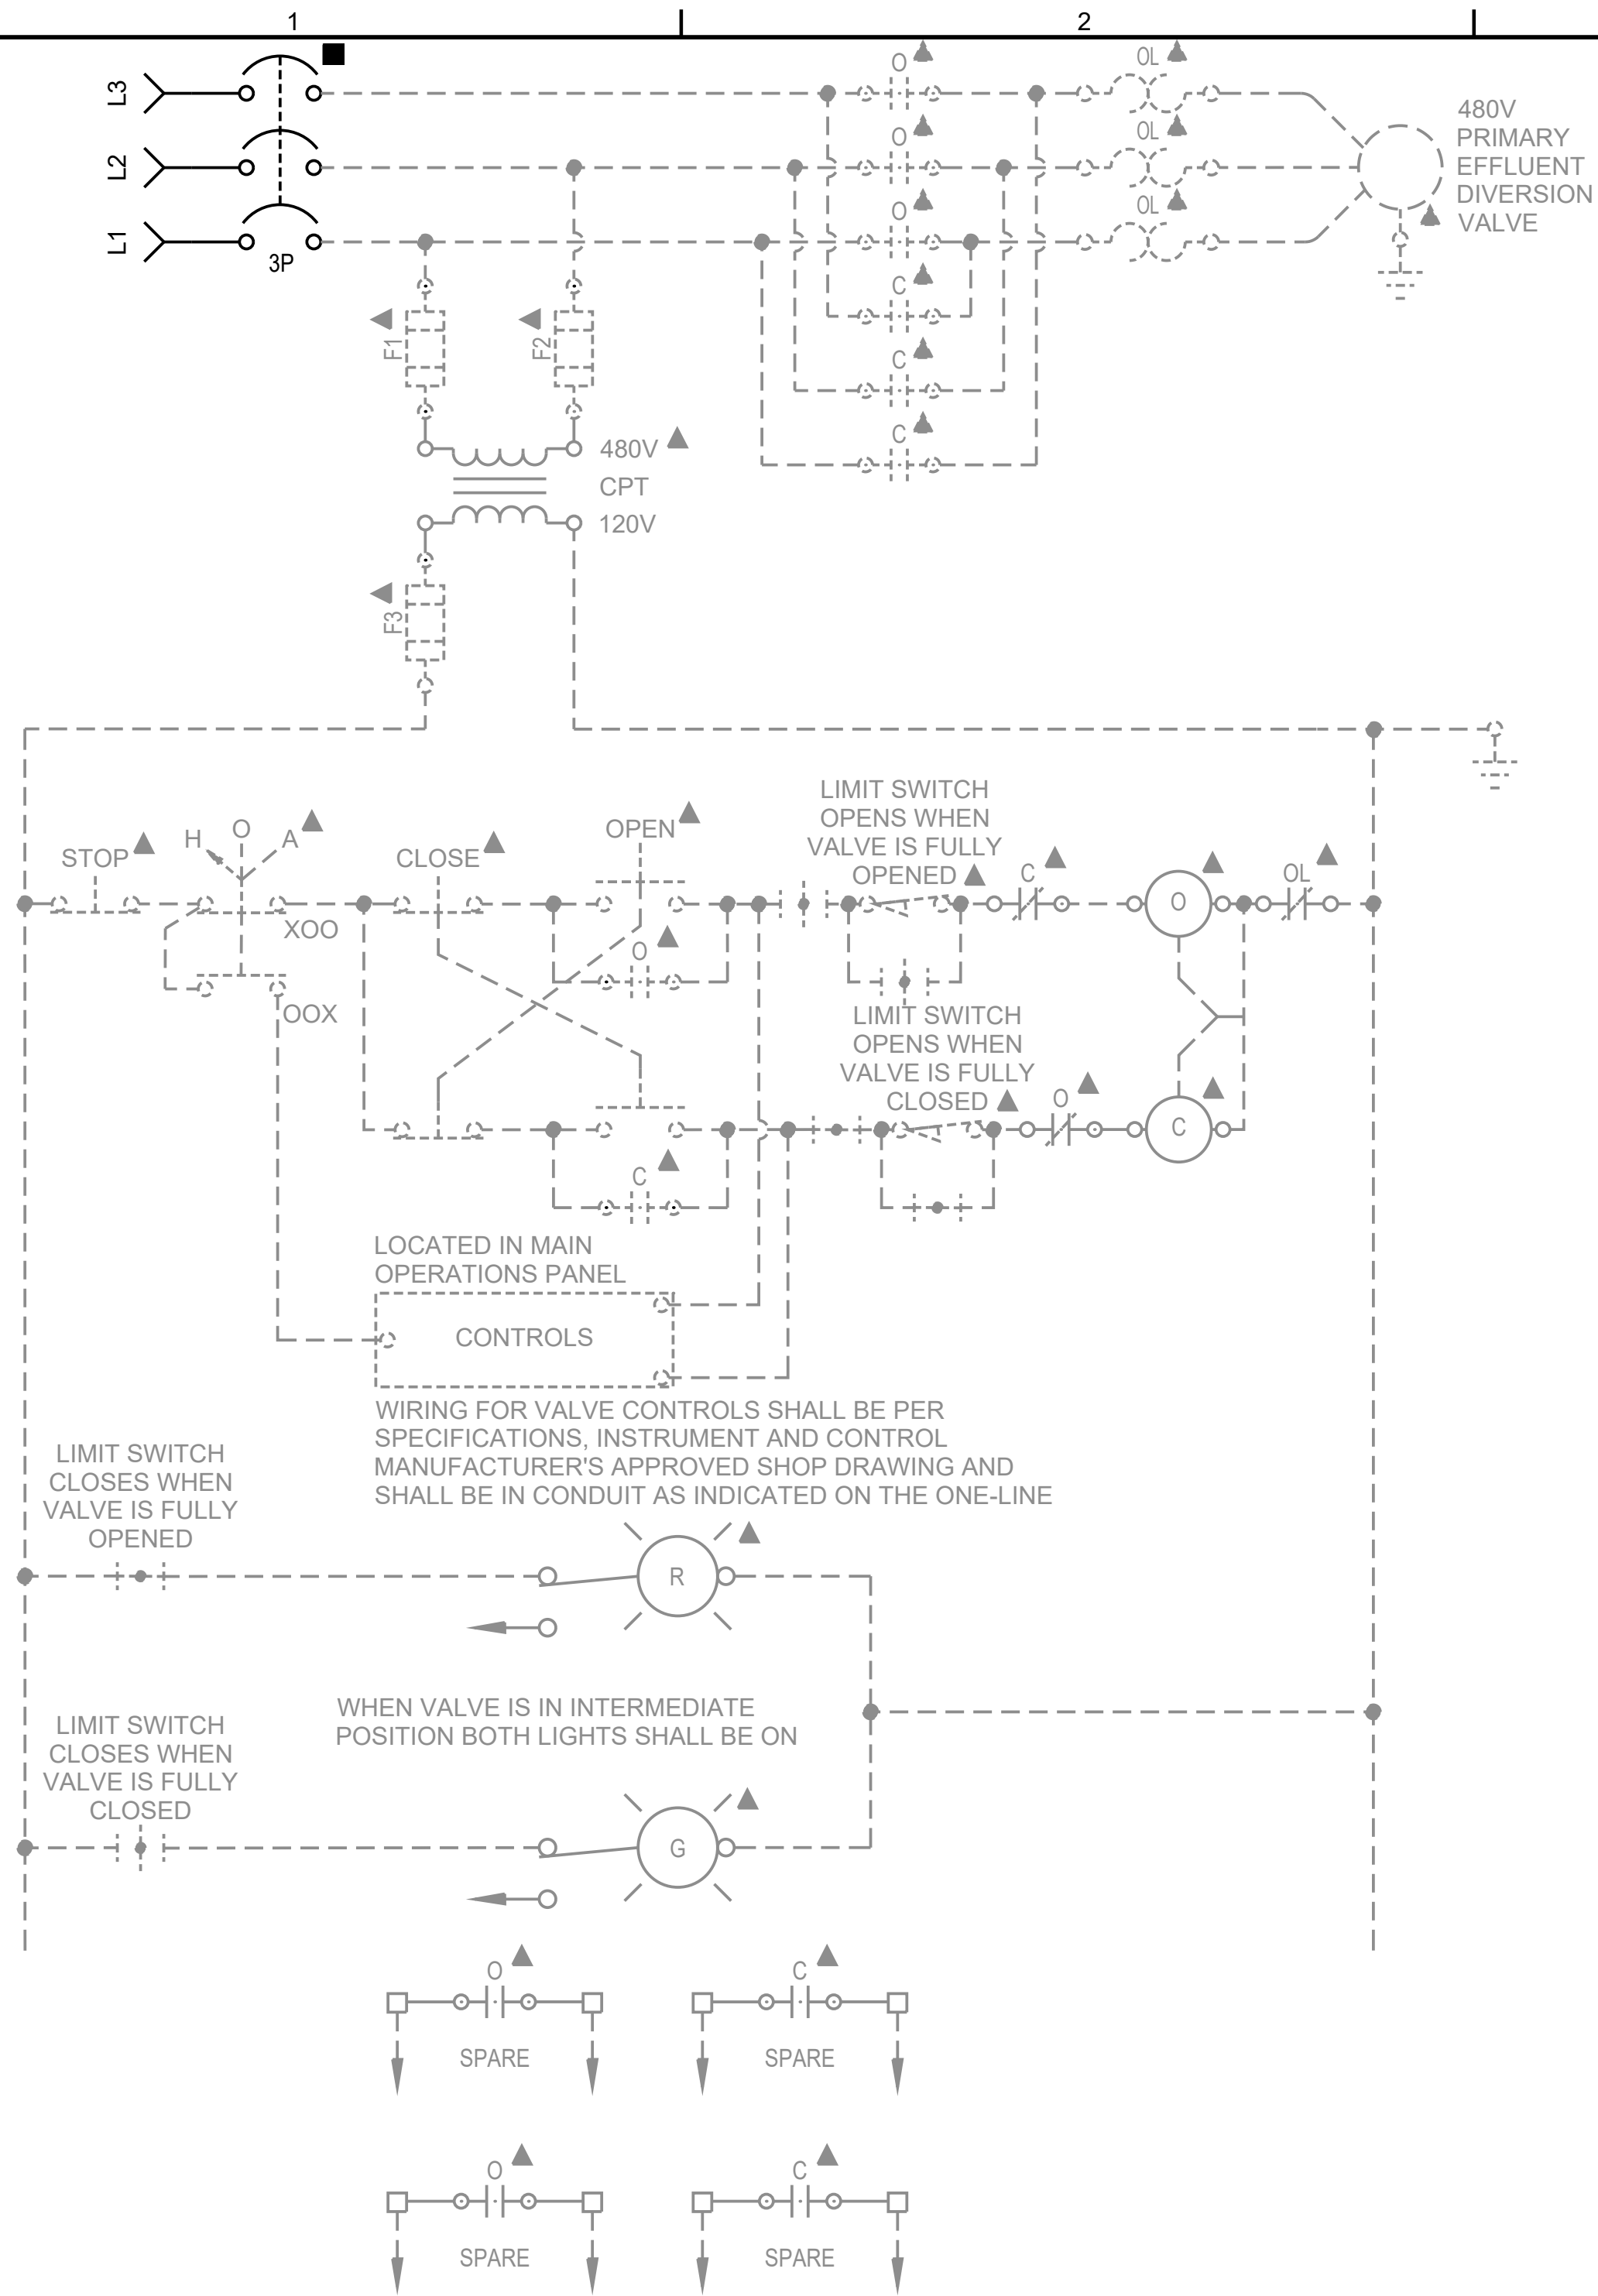

MOTOR CONTROL SCHEMATIC 5
NTS

TYPICAL FOR:
PRIMARY EFFLUENT DIVERSION
VALVE



NOTES:

- THE CONTRACTOR SHALL BE ALLOWED TO COMBINE LIKE CIRCUITS WHERE APPROPRIATE WITH ENGINEERS APPROVAL.
- REFER TO ONE LINE DIAGRAMS.

SYMBOLS

- ON VFD
- LOCATED AT MCC BUCKET
- ◇ LOCAL TO PLC
- DEVICE TERMINAL
- ▲ LOCATED AT LOCAL CONTROL STATION (LCS)


VENTILATION FAIL PANEL S2-VFP-001
SCHEMATIC DIAGRAM
NTS

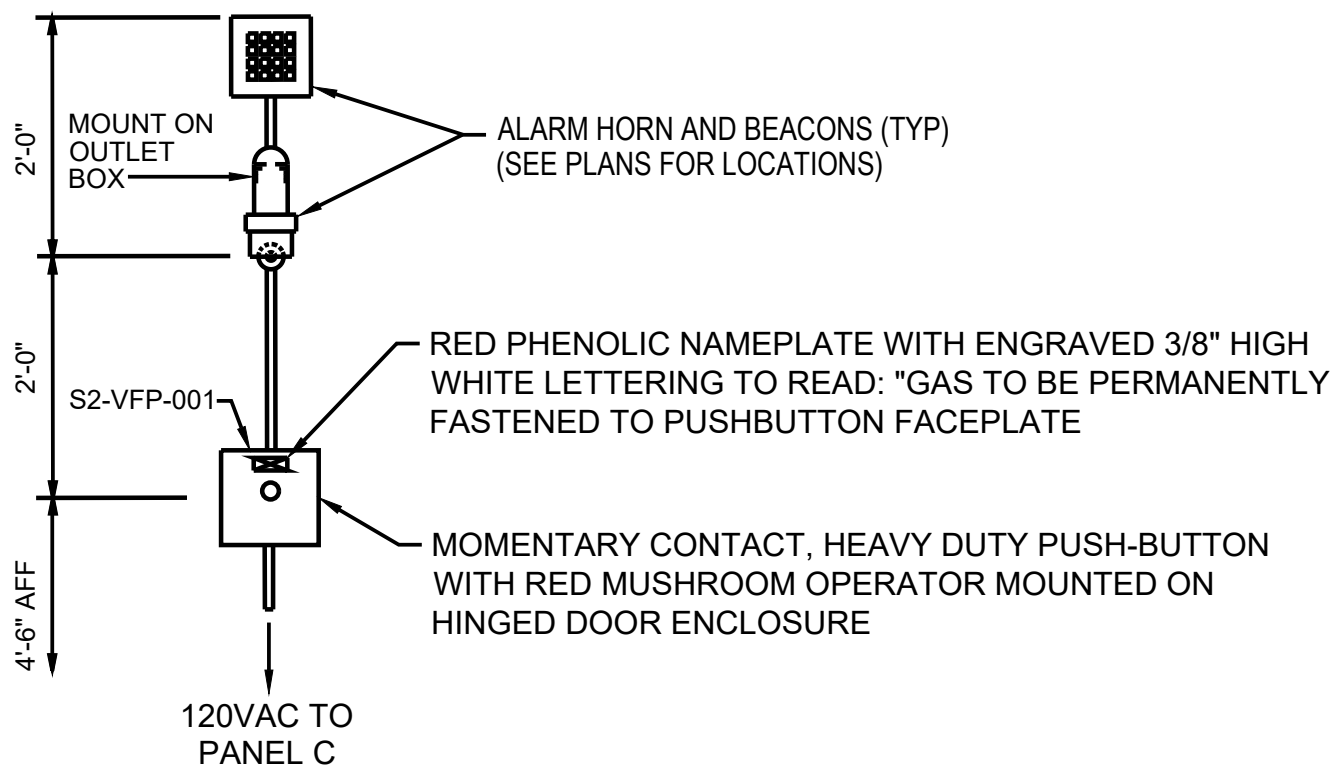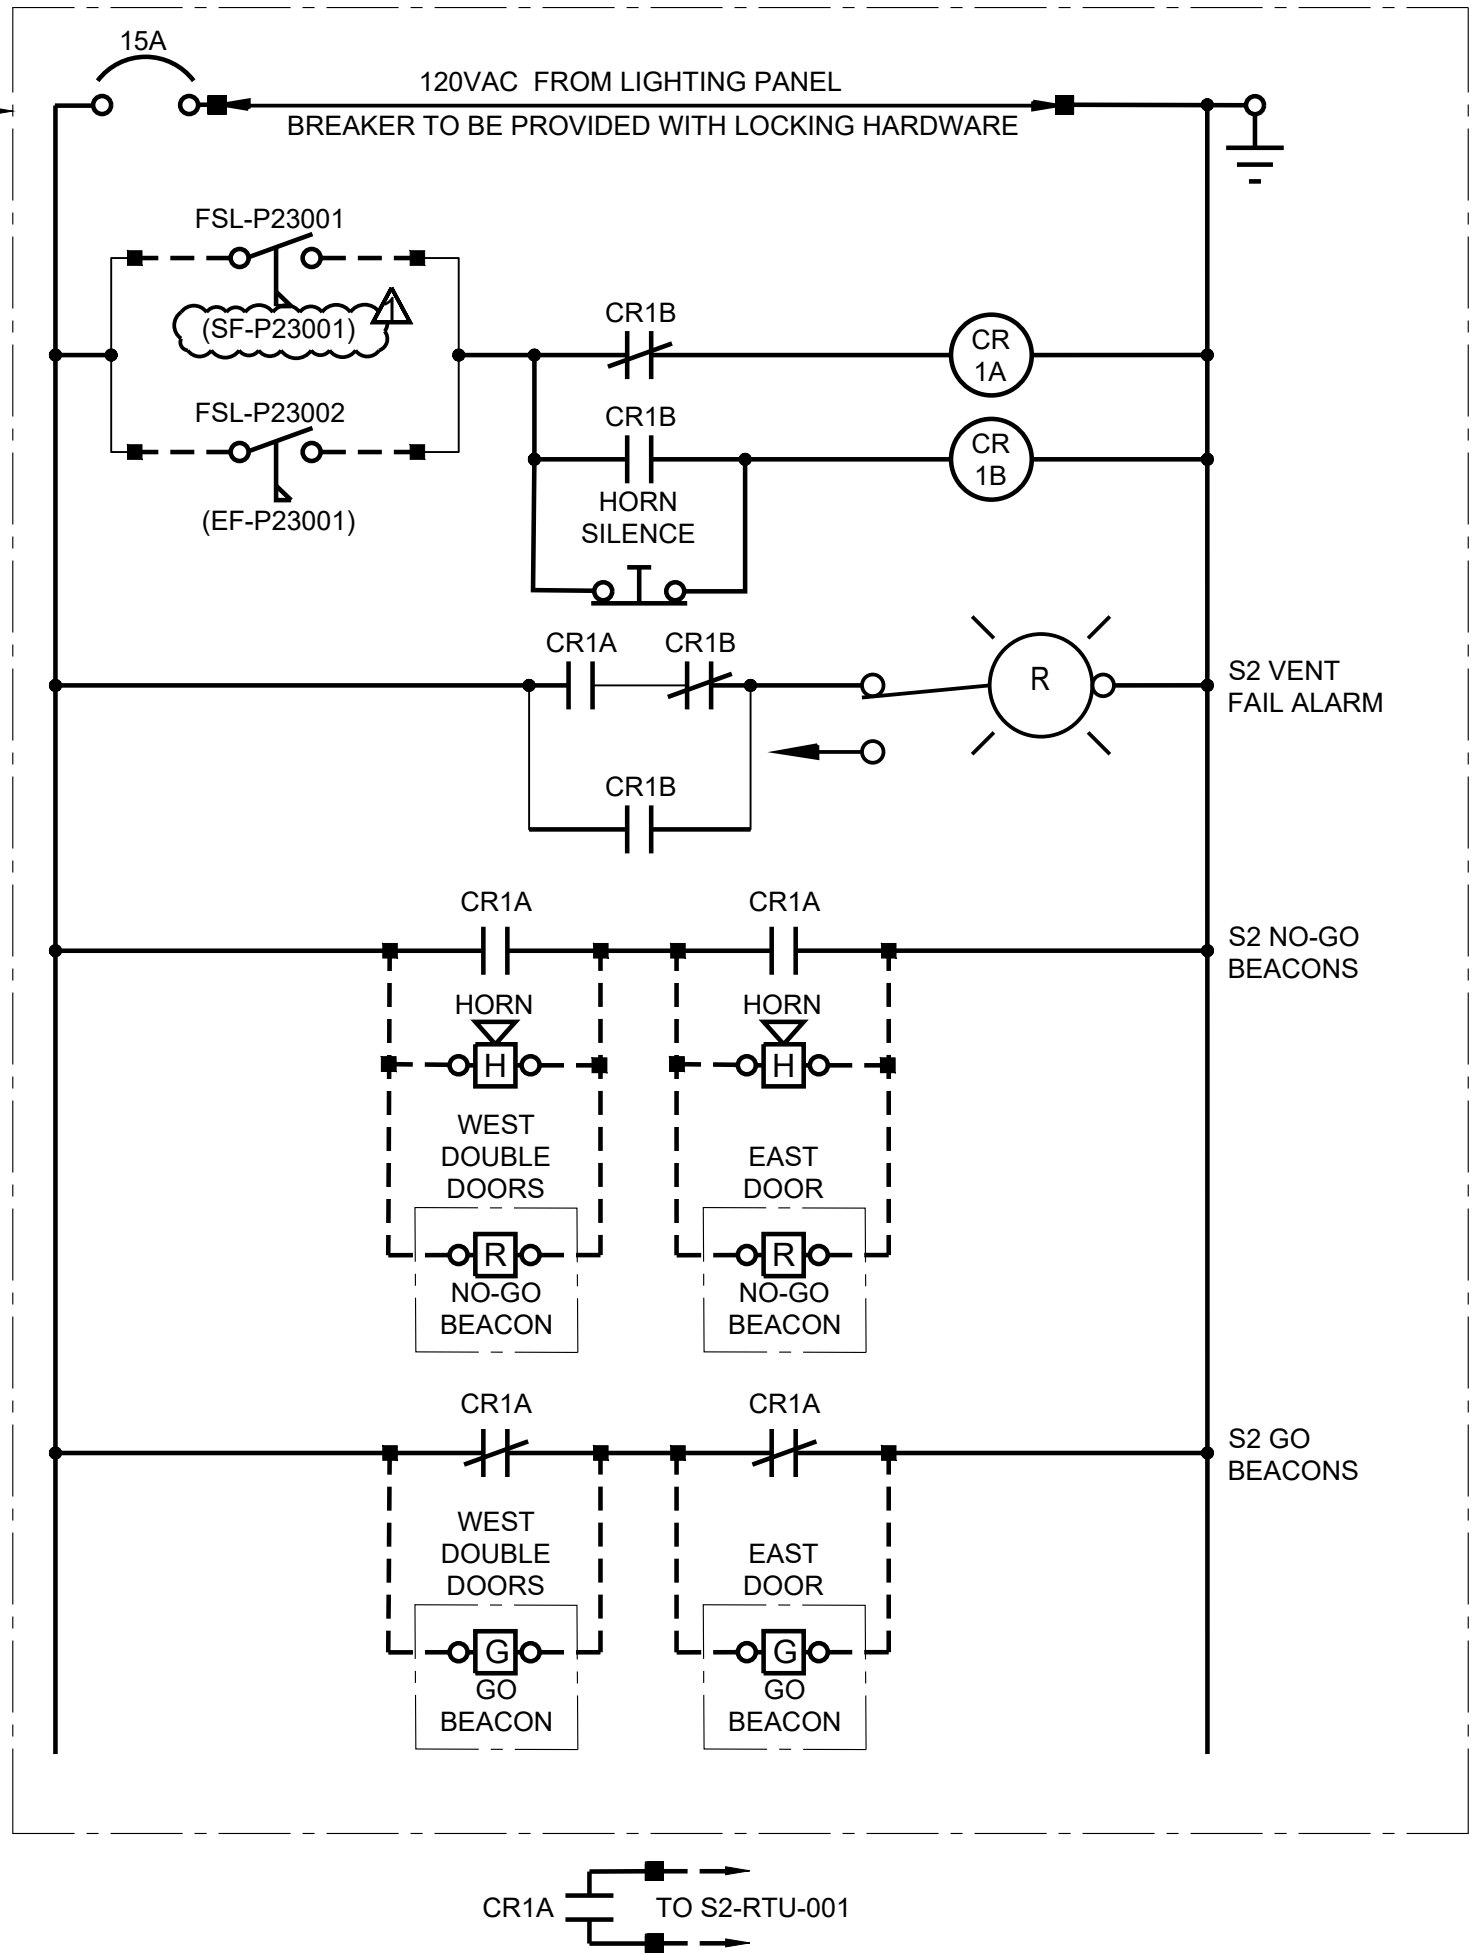


NOTE: ALL EXPOSED SURFACES OF COMPONENTS SHALL HAVE A YELLOW ENAMEL FINISH, INCLUDING CONDUIT (WITHIN A 10'-0" RADIUS OF THE STATION), BOXES, ENCLOSURES & HORN GRILLE.

VENTILATION FAIL PANEL
ASSEMBLY DETAIL
NTS

NO.	DATE	CHANGES AFTER 90% DESIGN	REVISION	TCA	BGY
1	2/25/25	CHANGES AFTER 90% DESIGN	REVISION	TCA	BGY

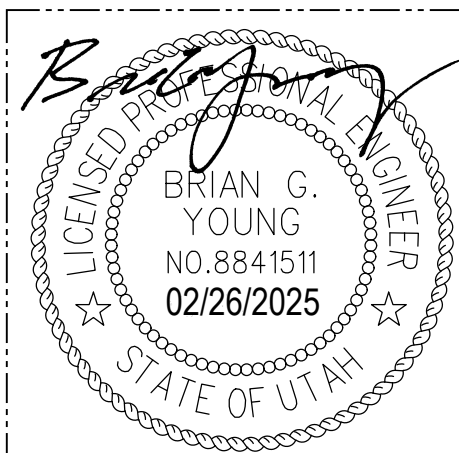

VERIFY SCALE	BAR IS ONE INCH ON ORIGINAL DRAWING. IF NOT ONE INCH ON THIS SHEET, ADJUST SCALES ACCORDINGLY.
DESIGN	TCA
DRAWN	TCA
CHECKED	BGY
APPROVED	JHM
WATERWORKS ENGINEERS	
PROVO CITY PUBLIC WORKS DEPT PROVO WRF PHASE 1, ELEC. UPGRADES PACKAGE A - S2 RE-FEED	
ELECTRICAL	
SCHEMATICS 3	
DATE	FEBRUARY 2025
PROJECT NUMBER	19-002
DRAWING NUMBER	E-GN-523
SHEET	OF

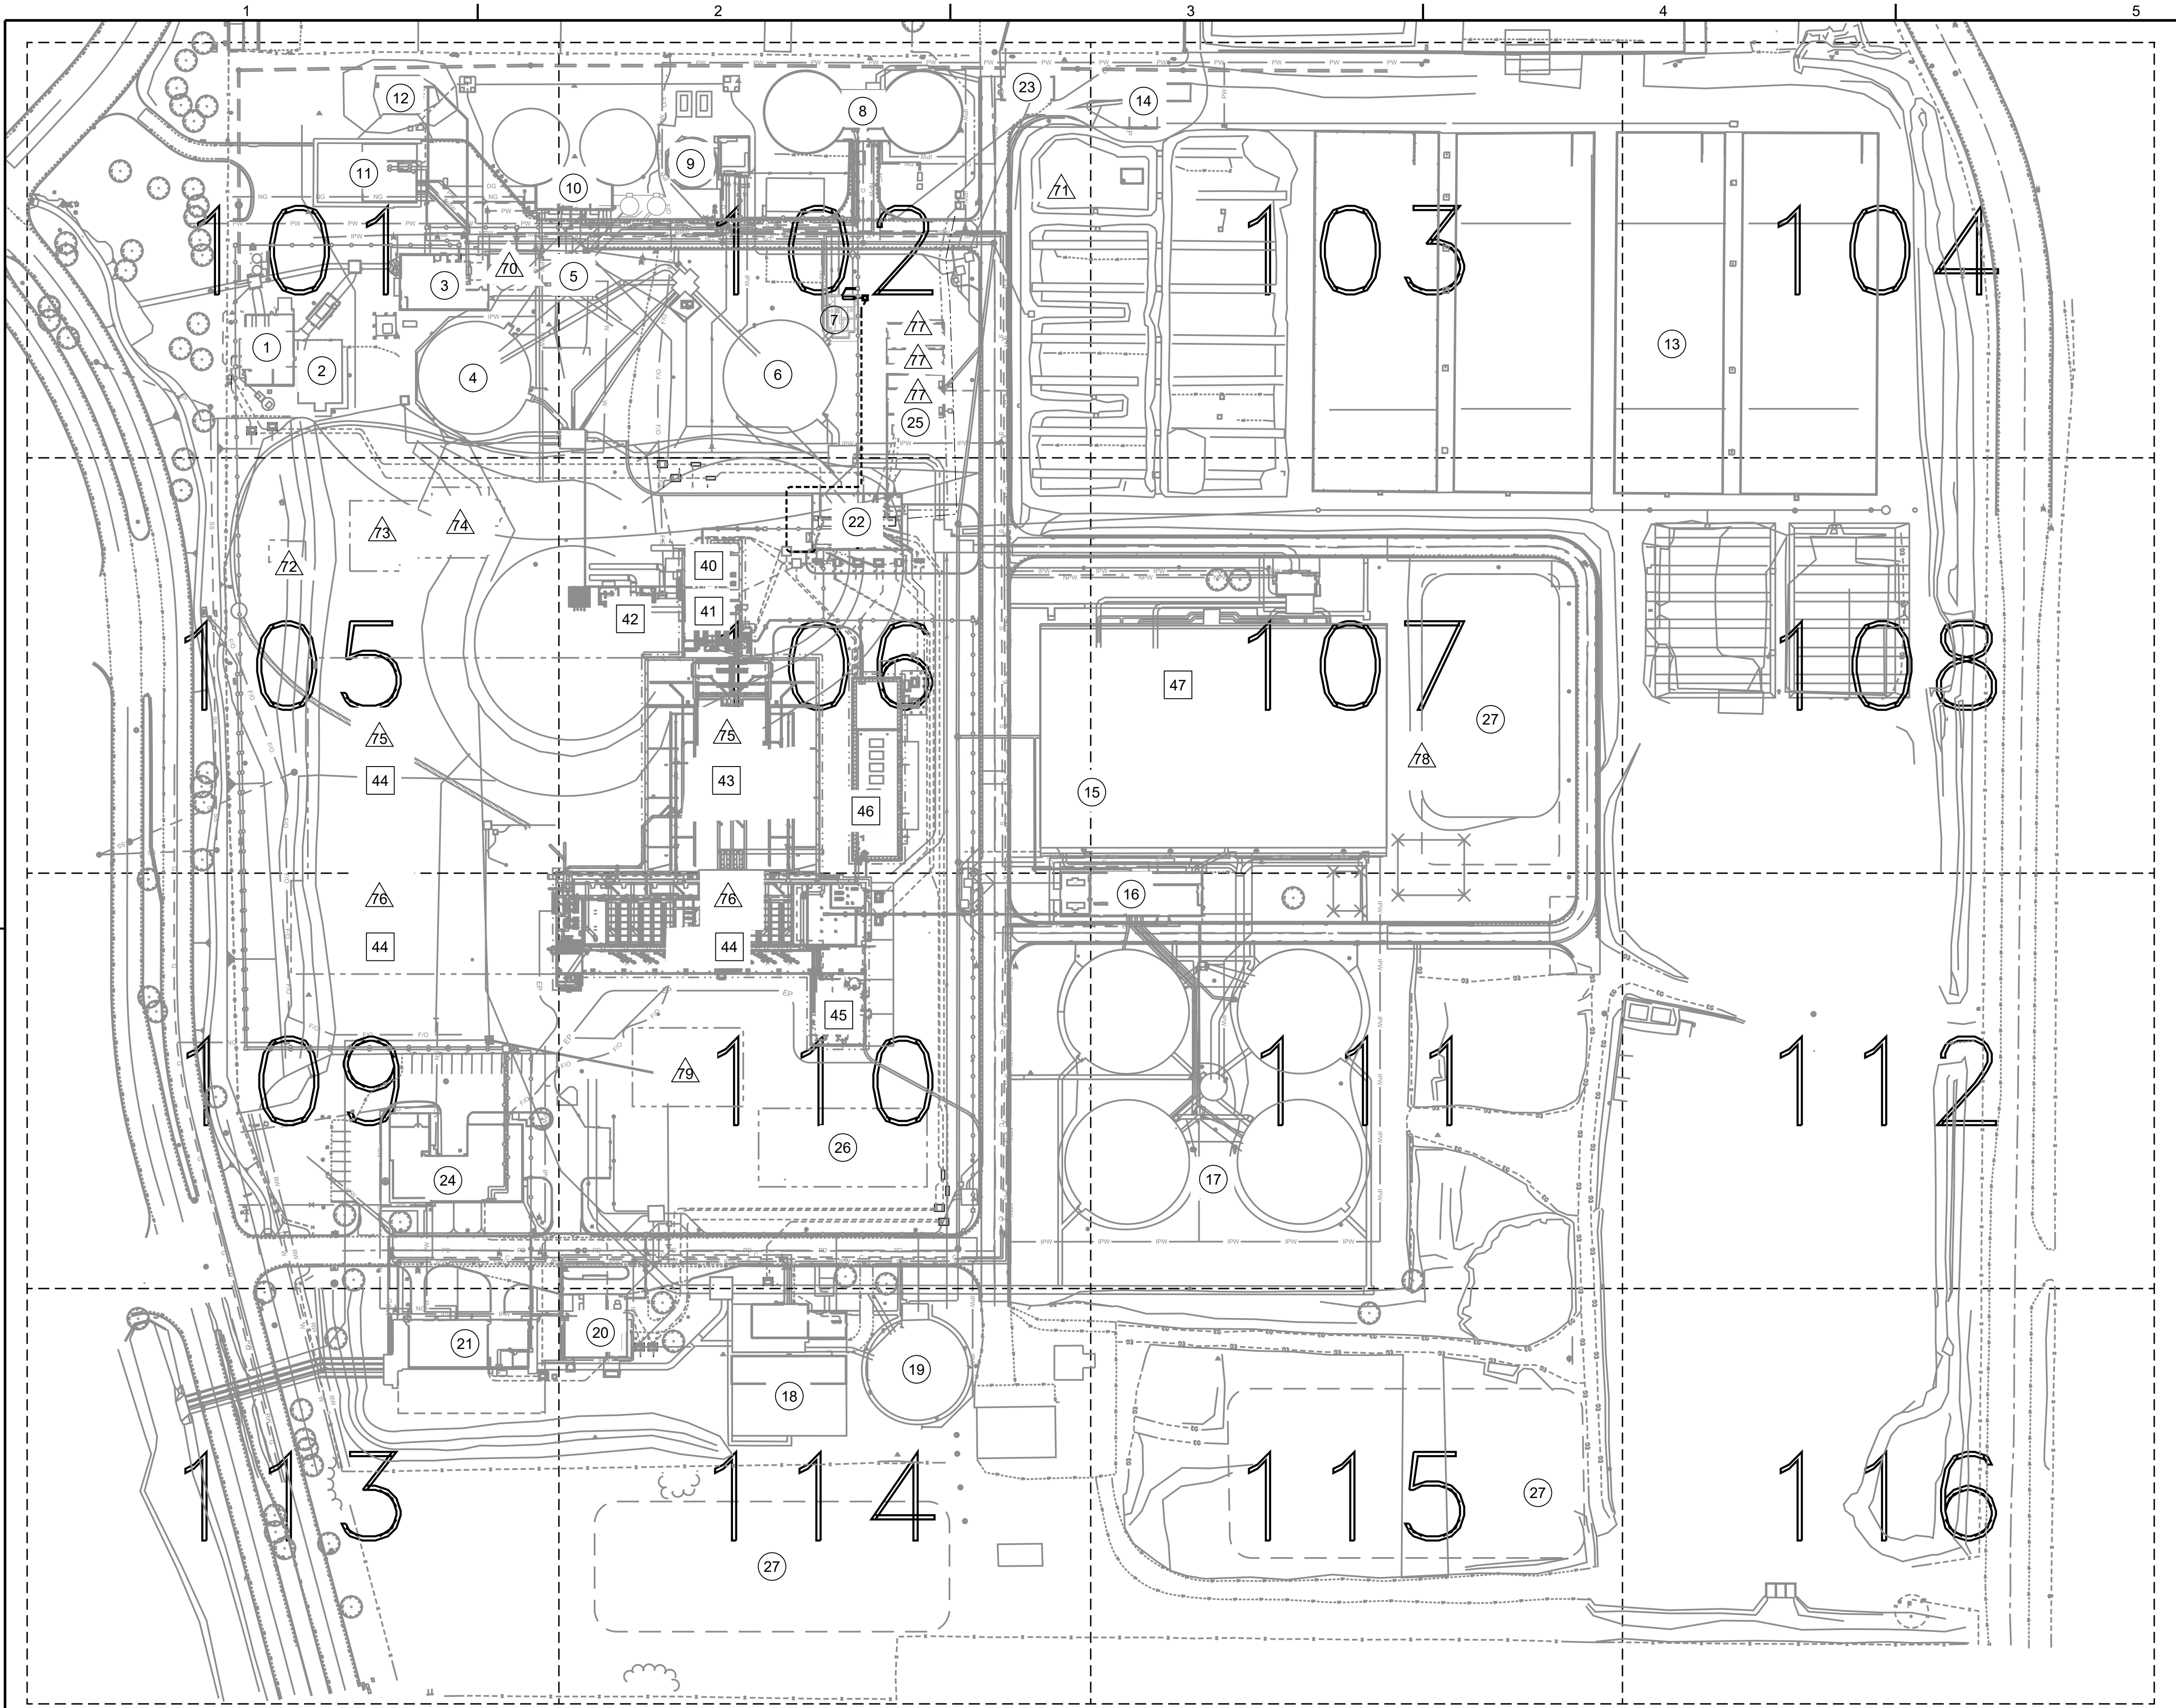

NO.	DATE	REVISION	BY	APVD

EXISTING STRUCTURES


1. COARSE SCREENS
2. GRIT BASINS
3. INFLUENT PUMP STATION
4. PRIMARY CLARIFIER NO. 1
5. PRIMARY P.S NO. 1
6. PRIMARY CLARIFIER NO. 2
7. PRIMARY P.S NO. 2
8. PRIMARY DIGESTERS
9. DAF
10. SECONDARY DIGESTERS
11. DEWATERING BUILDING
12. CENTRATE EQUALIZATION BASIN
13. DRYING BEDS
14. FERRIC DOSING FACILITY
15. AERATION BASINS
16. BLOWER BUILDING
17. FINAL CLARIFIERS
18. FILTER BUILDING
19. BACKWASH TANK
20. CHLORINE BUILDING
21. UV BUILDING
22. POWER DISTRIBUTION BUILDING
23. PLANT POWER BUILDING
24. OPERATIONS BUILDING
25. STANDBY GENERATORS
26. CONTRACTOR AND ENGINEERING OFFICE TRAILER
27. STAGING AREA

PACKAGE 2 STRUCTURES


40. FINE SCREEN PUMP STATION
41. FINE SCREEN BUILDING
42. ODOR CONTROL
43. BIOREACTORS
44. MEMBRANE BUILDING
45. CHEMICAL STORAGE
46. BLOWER BUILDING
47. EQUALIZATION AND SURGE

FUTURE STRUCTURES

70. NORTH LOAD CENTER
71. WASTE GAS BURNER
72. PLANT LIFT STATION
73. COARSE SCREENS
74. GRIT BASINS
75. BIOREACTORS
76. MEMBRANE BUILDING
77. STANDBY GENERATORS
78. SURGE BASINS
79. OPERATIONS BUILDING
- XX. SURGE BASINS

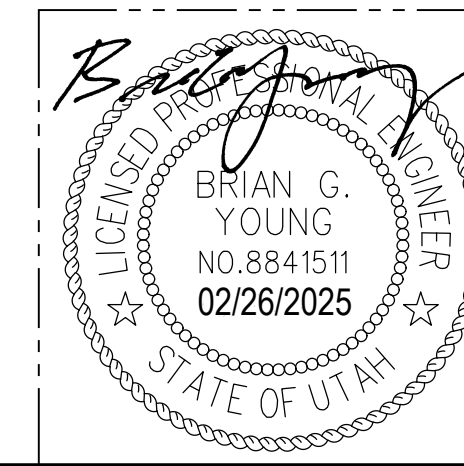

DESIGN TCA	DRAWN TCA	CHECKED BGY	APPROVED JHM	VERIFY SCALE BAR IS ONE INCH ON ORIGINAL DRAWING. 0 1' IF NOT ONE INCH ON THIS SHEET, ADJUST SCALES ACCORDINGLY.
WATERWORKS ENGINEERS				
PRVO CITY PUBLIC WORKS DEPT PRVO WRF PHASE 1, ELEC. UPGRADES PACKAGE A - S2 RE-FEED				
ELECTRICAL SITE ELECTRICAL KEY PLAN				
DATE FEBRUARY 2025				
PROJECT NUMBER 19-002				
DRAWING NUMBER E-SE-100				
SHEET OF				

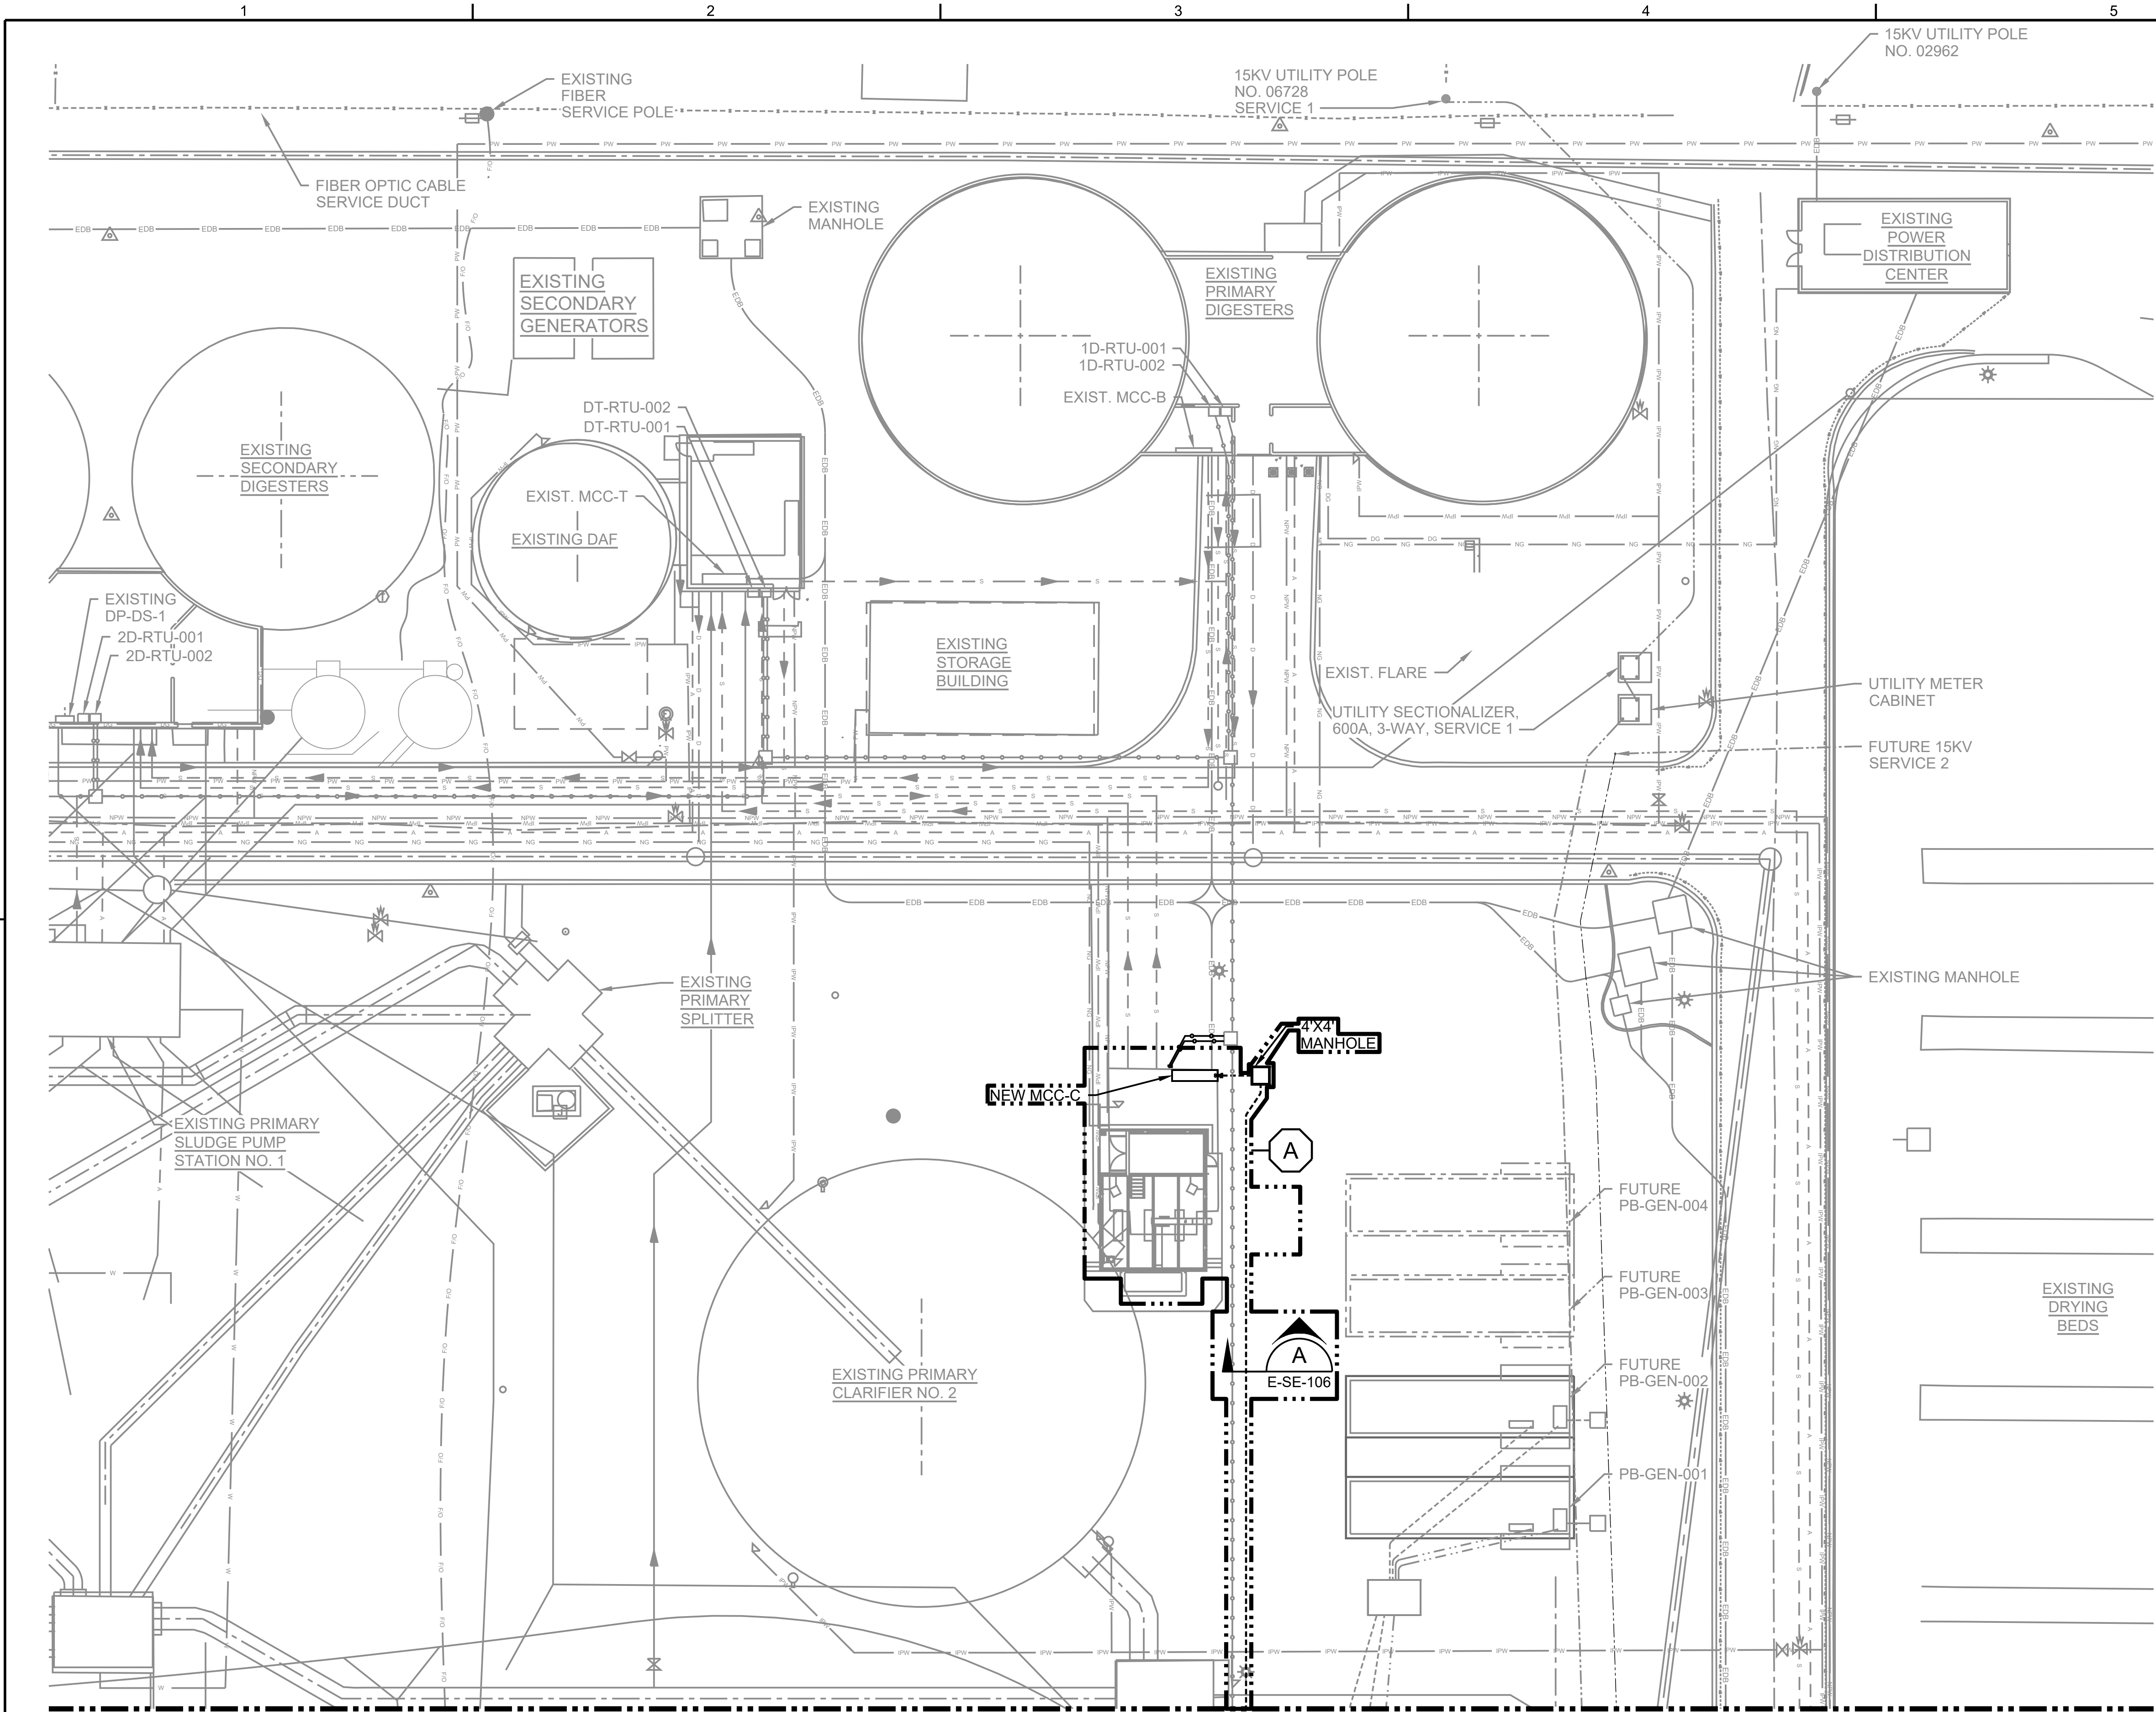

SCOPE OF WORK KEY NOTES:

A PACKAGE A - S2 RE-FEED


101	THIS SHEET	103	104
105	106	107	108
109	110	111	112
113	114	115	116

KEY MAP

1"=500'




20 0 20 40 FEET
SCALE 1"=20'

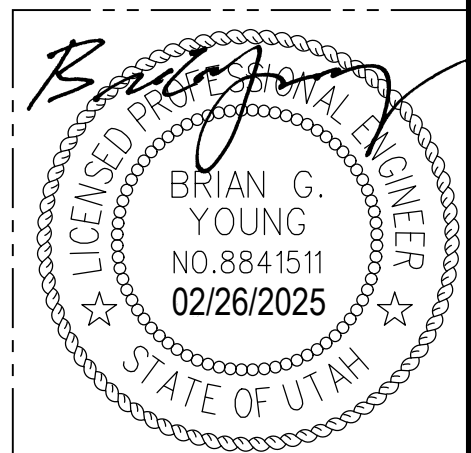

NO.	DATE	REVISION	BY	APVD

VERIFY SCALE BAR IS ONE INCH ON ORIGINAL DRAWING. 0 1" IF NOT ONE INCH ON THIS SHEET, ADJUST SCALES ACCORDINGLY.	DESIGN TCA	DRAWN TCA	CHECKED BGY	APPROVED JHM	A
WATERWORKS ENGINEERS					B
					C
PROVO CITY PUBLIC WORKS DEPT PROVO WRF PHASE 1, ELEC. UPGRADES PACKAGE A - S2 RE-FEED					D
ELECTRICAL SITE ELECTRICAL AREA 102 PLAN					
DATE FEBRUARY 2025					
PROJECT NUMBER 19-002					
DRAWING NUMBER E-SE-102					
SHEET OF					



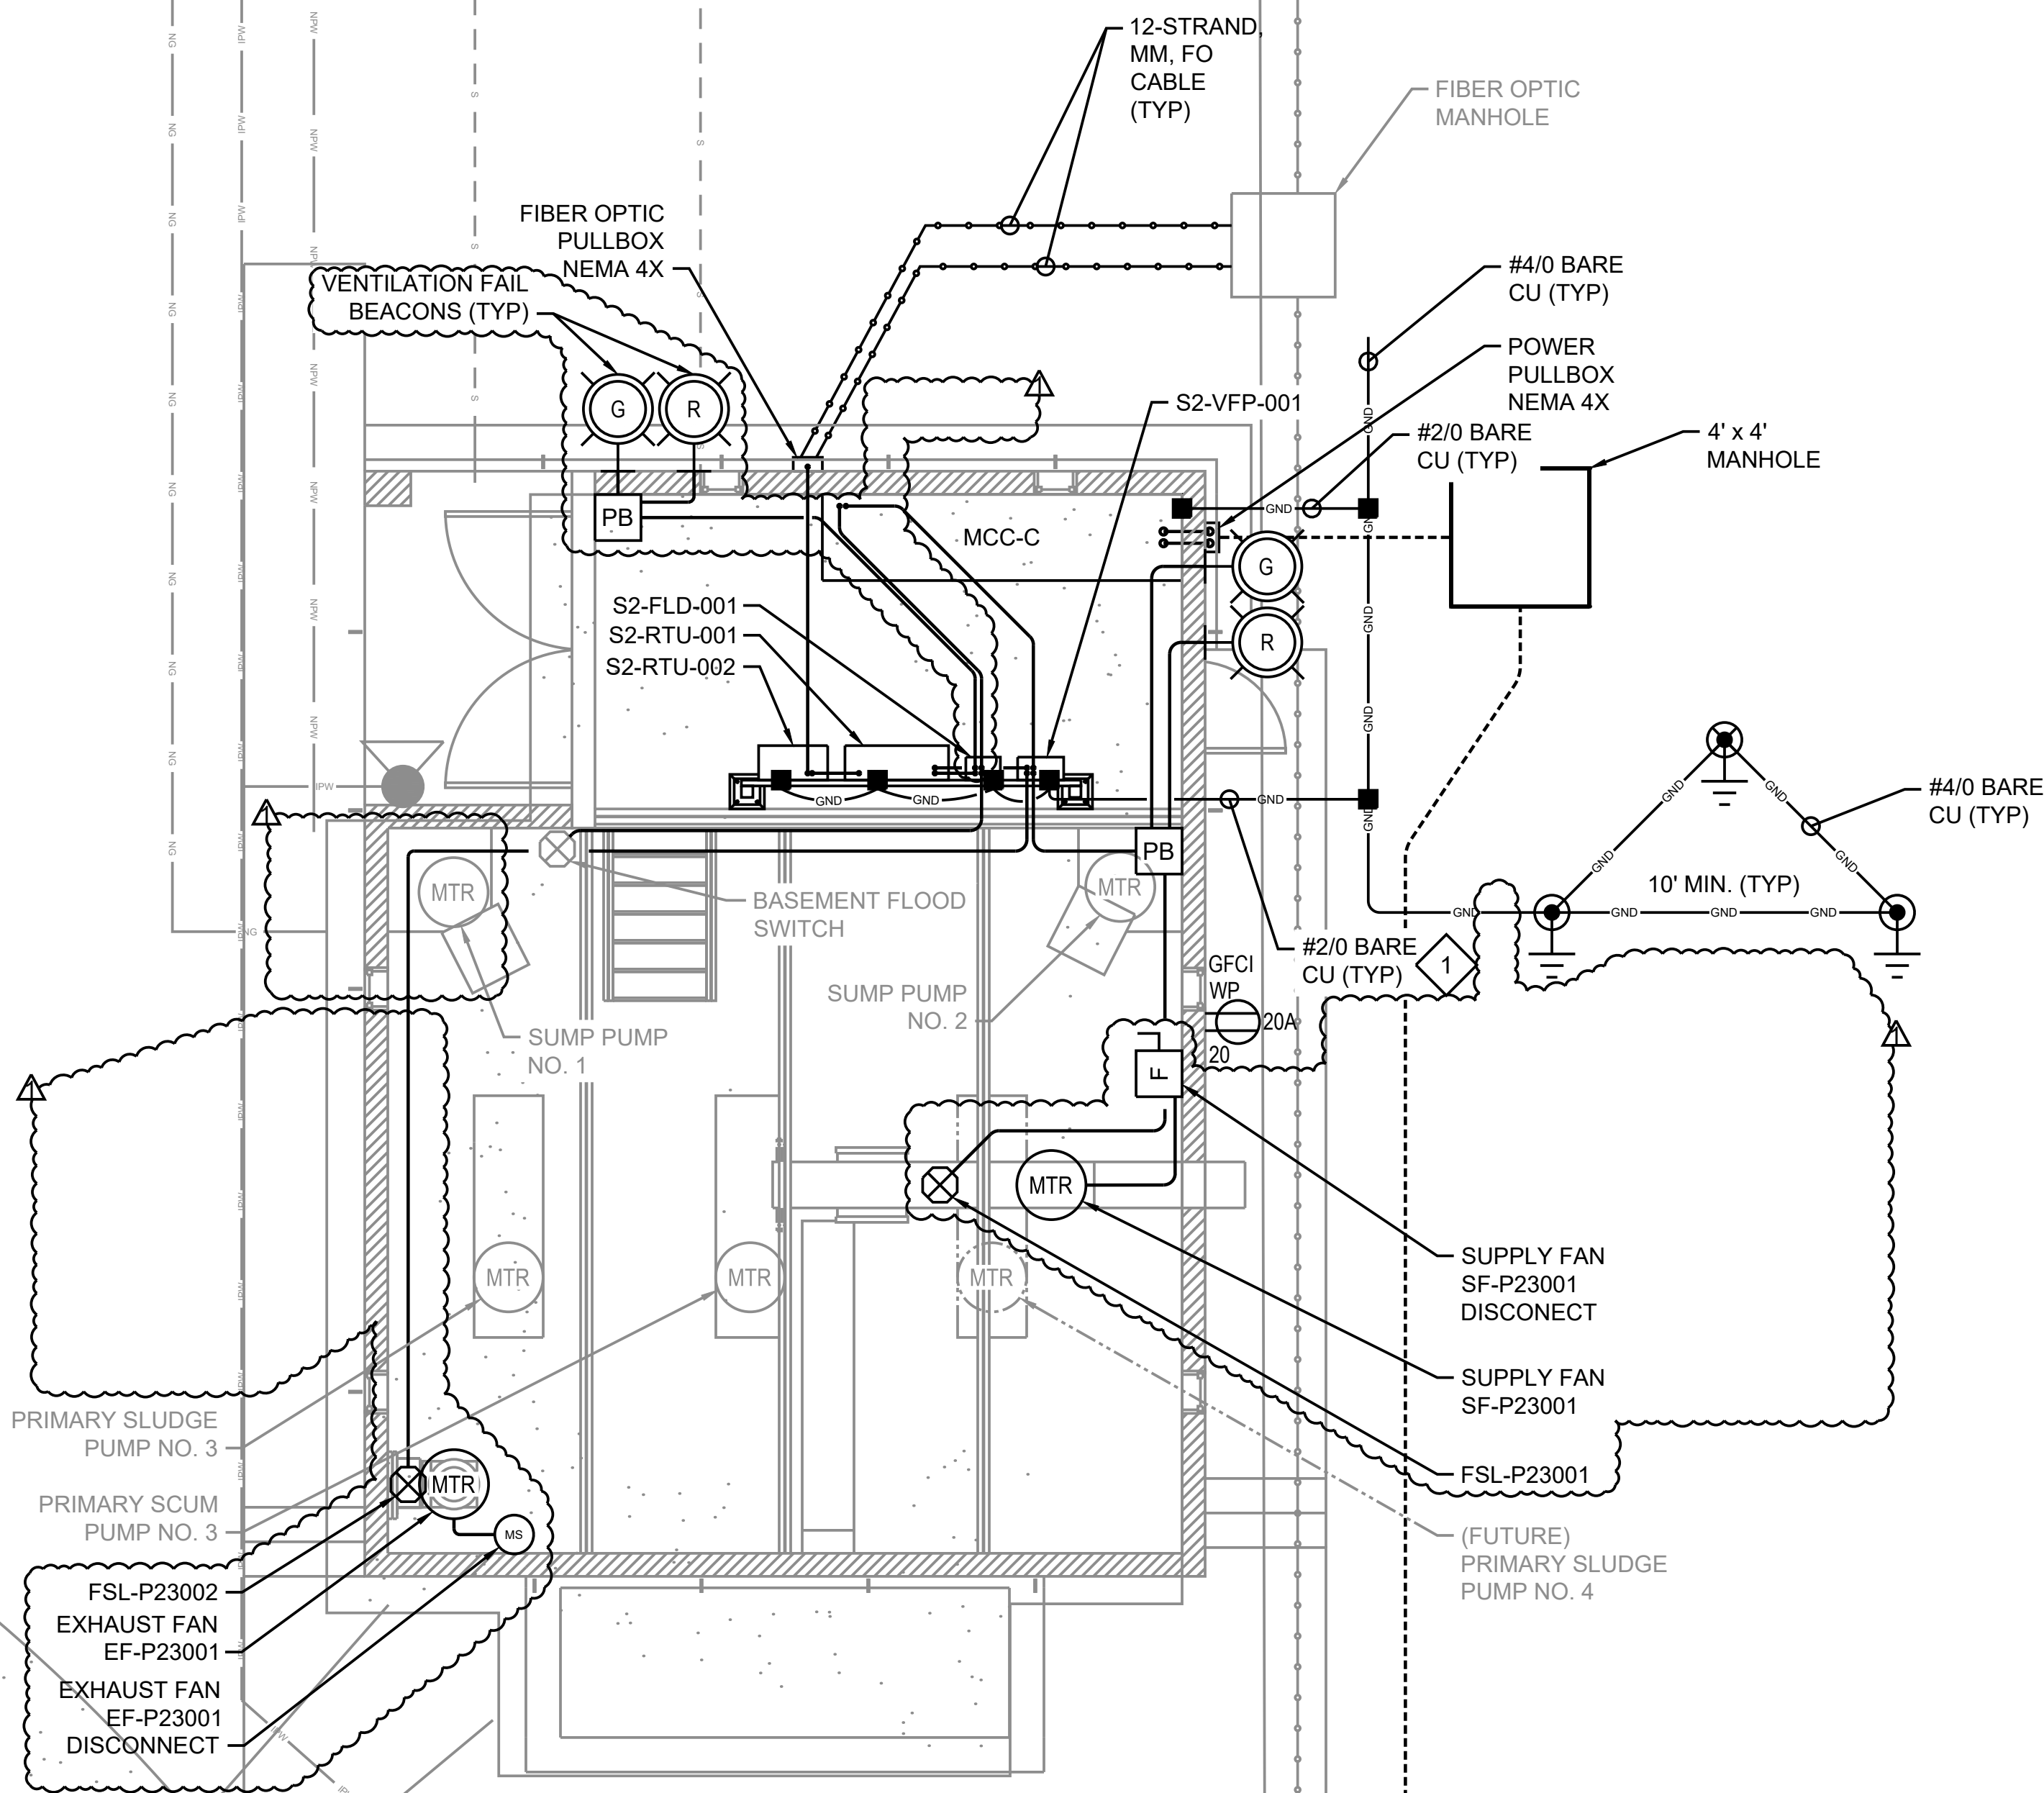

NOTES:

1. REFER TO ONE-LINES, PANEL SCHEDULES, BLOCK DIAGRAMS AND SCHEMATICS FOR CONDUIT AND WIRE AND ADDITIONAL REQUIREMENTS.

KEY NOTES:


1

BOND GEC TO EXISTING CAST IRON PIPE AND BUILDING STEEL IN ADDITION TO THE EQUIPMENT INDICATED ON THIS DRAWING.

VERIFY SCALE
BAR IS ONE INCH ON
ORIGINAL DRAWING.
0  1"
IF NOT ONE INCH ON
THIS SHEET, ADJUST
SCALES ACCORDINGLY.

DESIGN TCA
DRAWN TCA
CHECKED BGY
APPROVED JHM

WATERWORKS
ENGINEERS

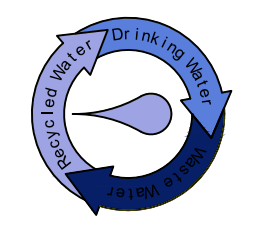

PROVO CITY
PUBLIC WORKS DEPT
PROVO WRF
PHASE 1, ELEC. UPGRADES
PACKAGE A - S2 RE-FEED

ELECTRICAL	PRIMARY SLUDGE PUMP STATION NO. 2 POWER PLAN
------------	--



DATE	FEBRUARY 2025
PROJECT NUMBER	19-002
DRAWING NUMBER	E-S2-101
SHEET	OF


A	2/25/25	CHANGES AFTER 90% DESIGN	TCA	BGY	
NO.	DATE	REVISION	BY	APVD	


PRIMARY SLUDGE PUMP
STATION NO. 2 POWER PLAN

SCALE: 1/4" = 1'-0"

REFER TO
ELECTRICAL SITE
PLAN E-SE-102 FOR
CONTINUATION

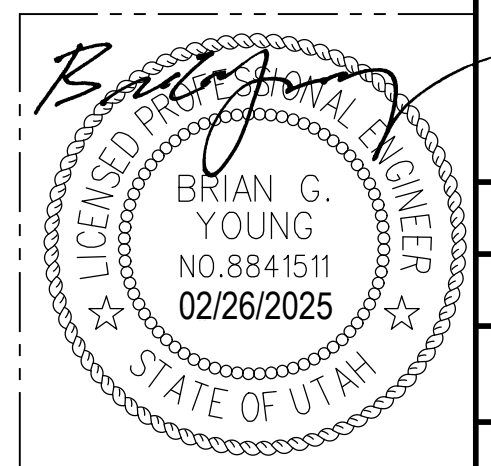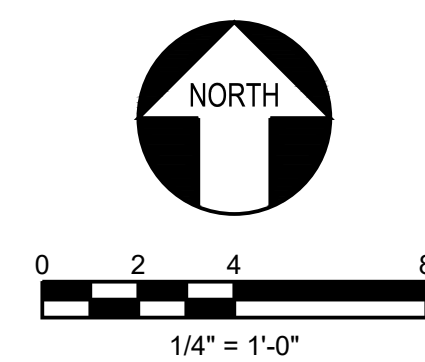

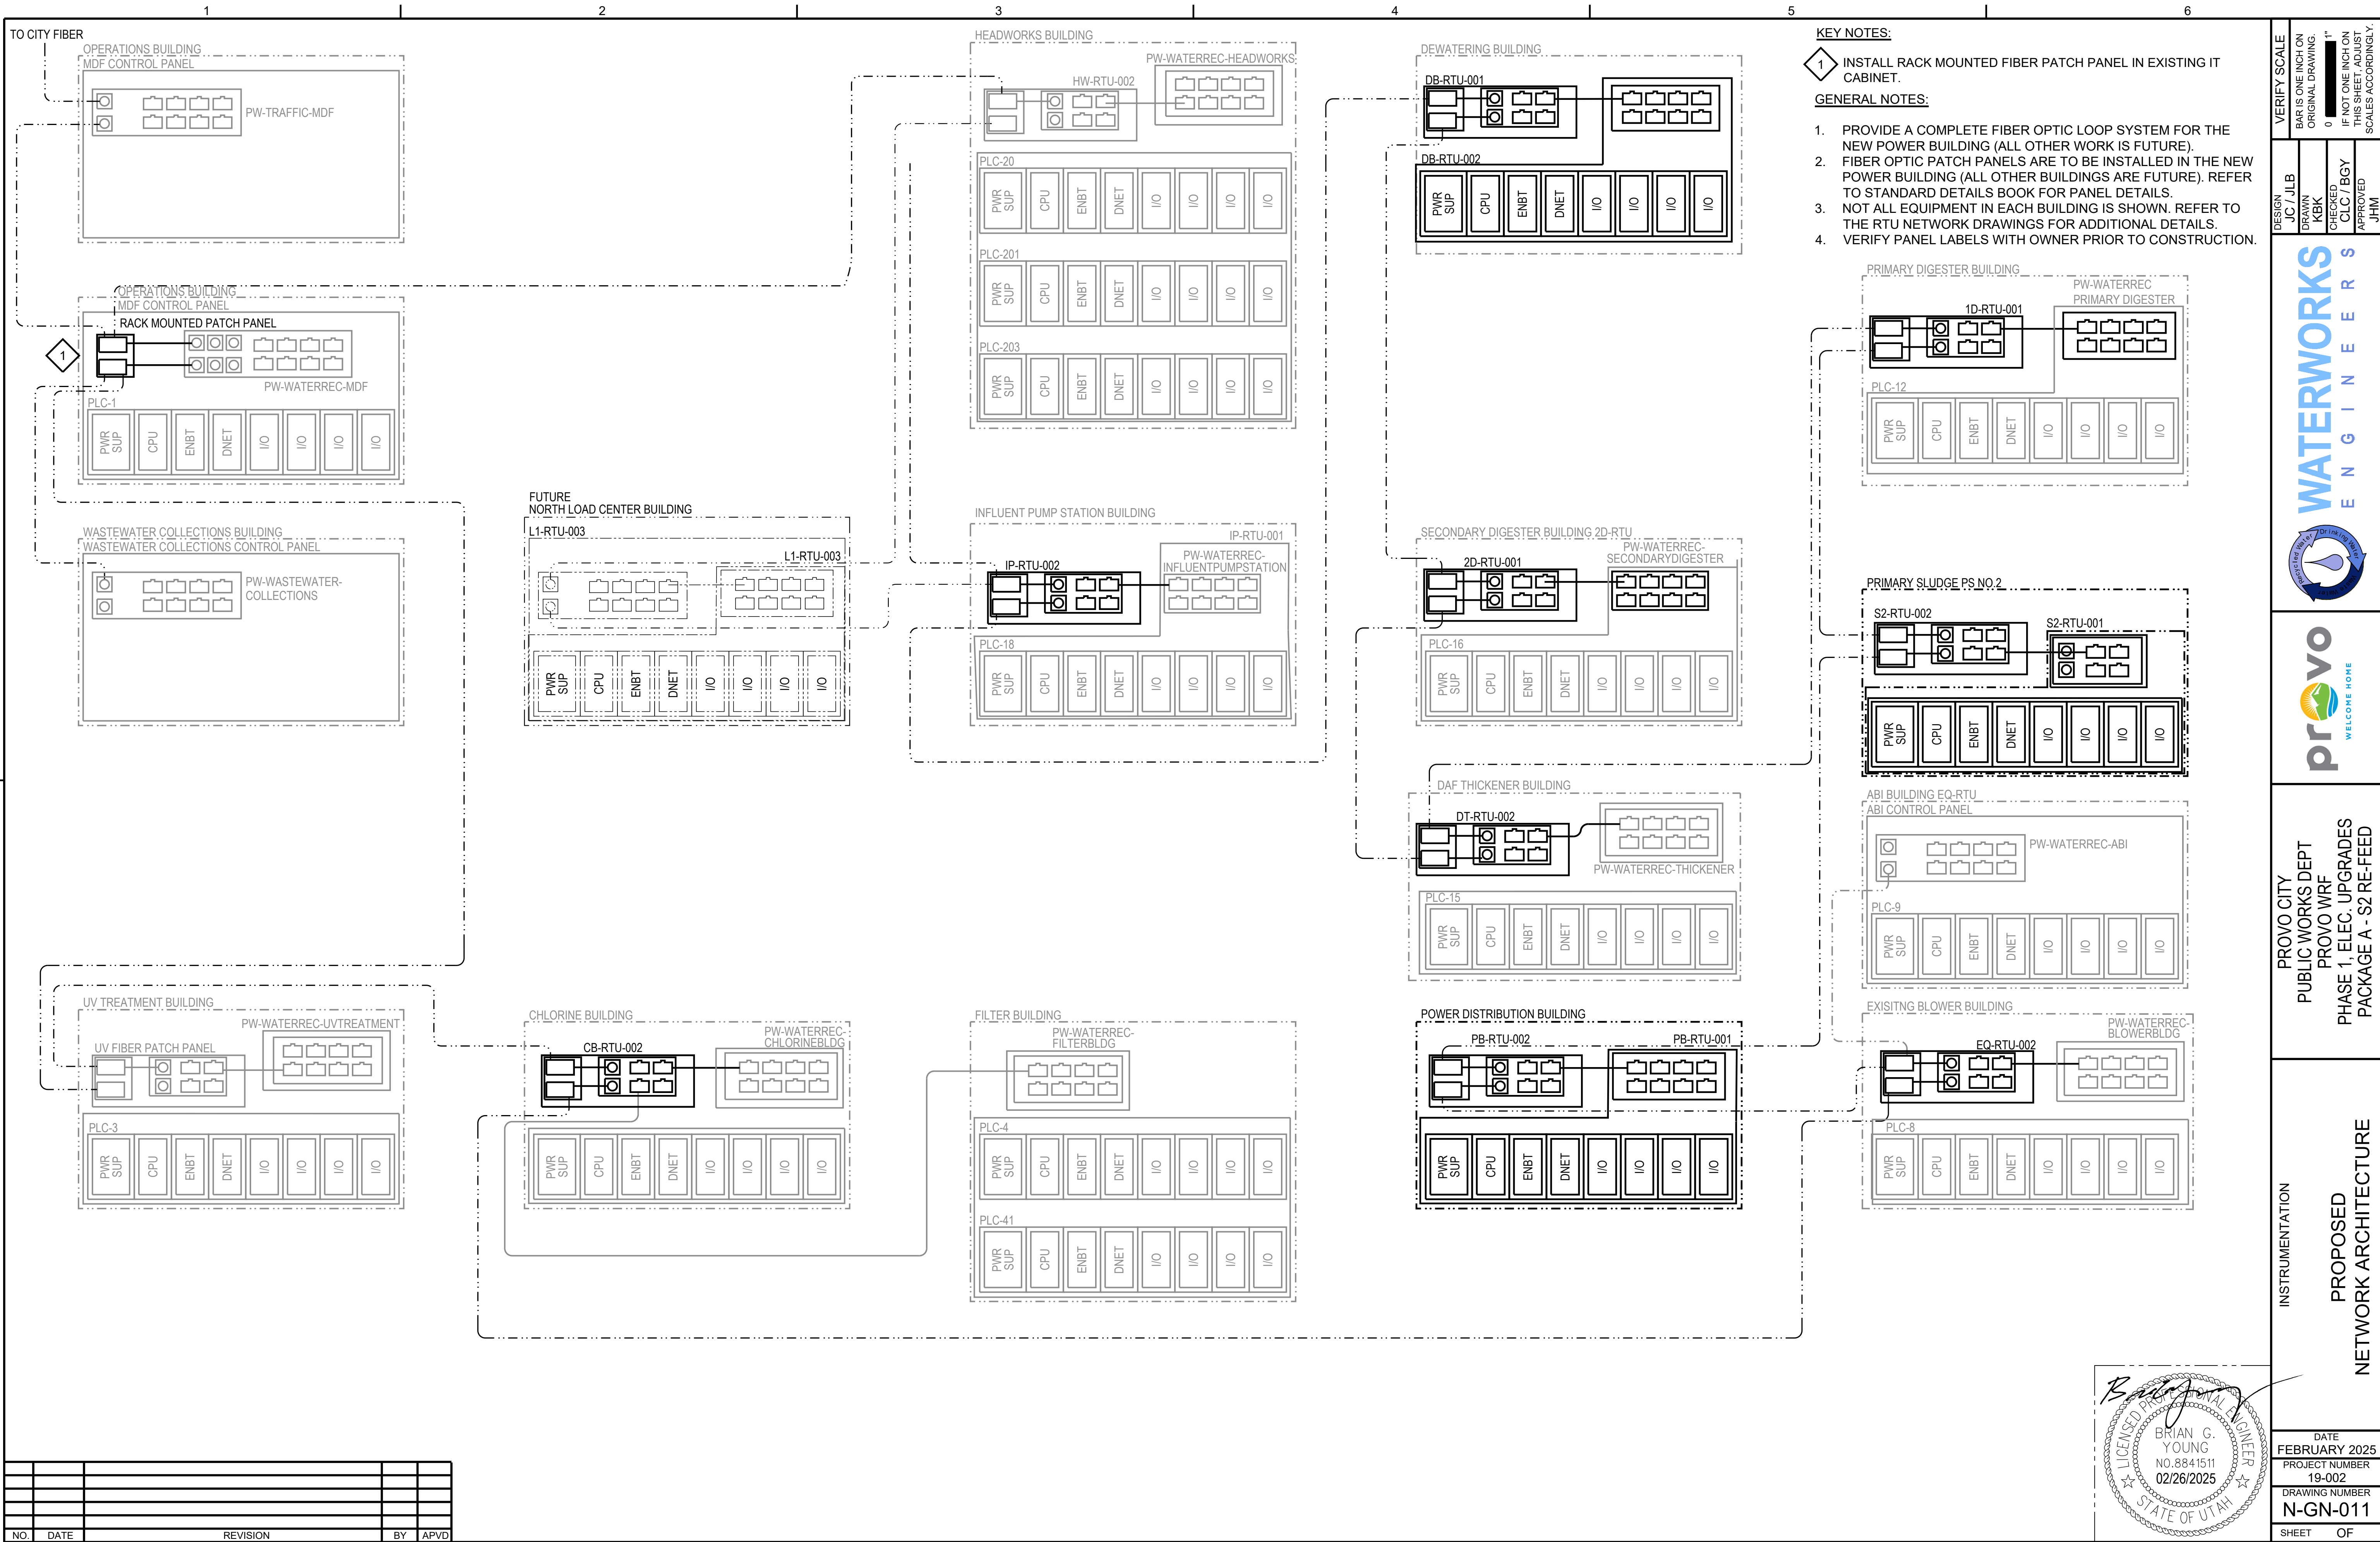

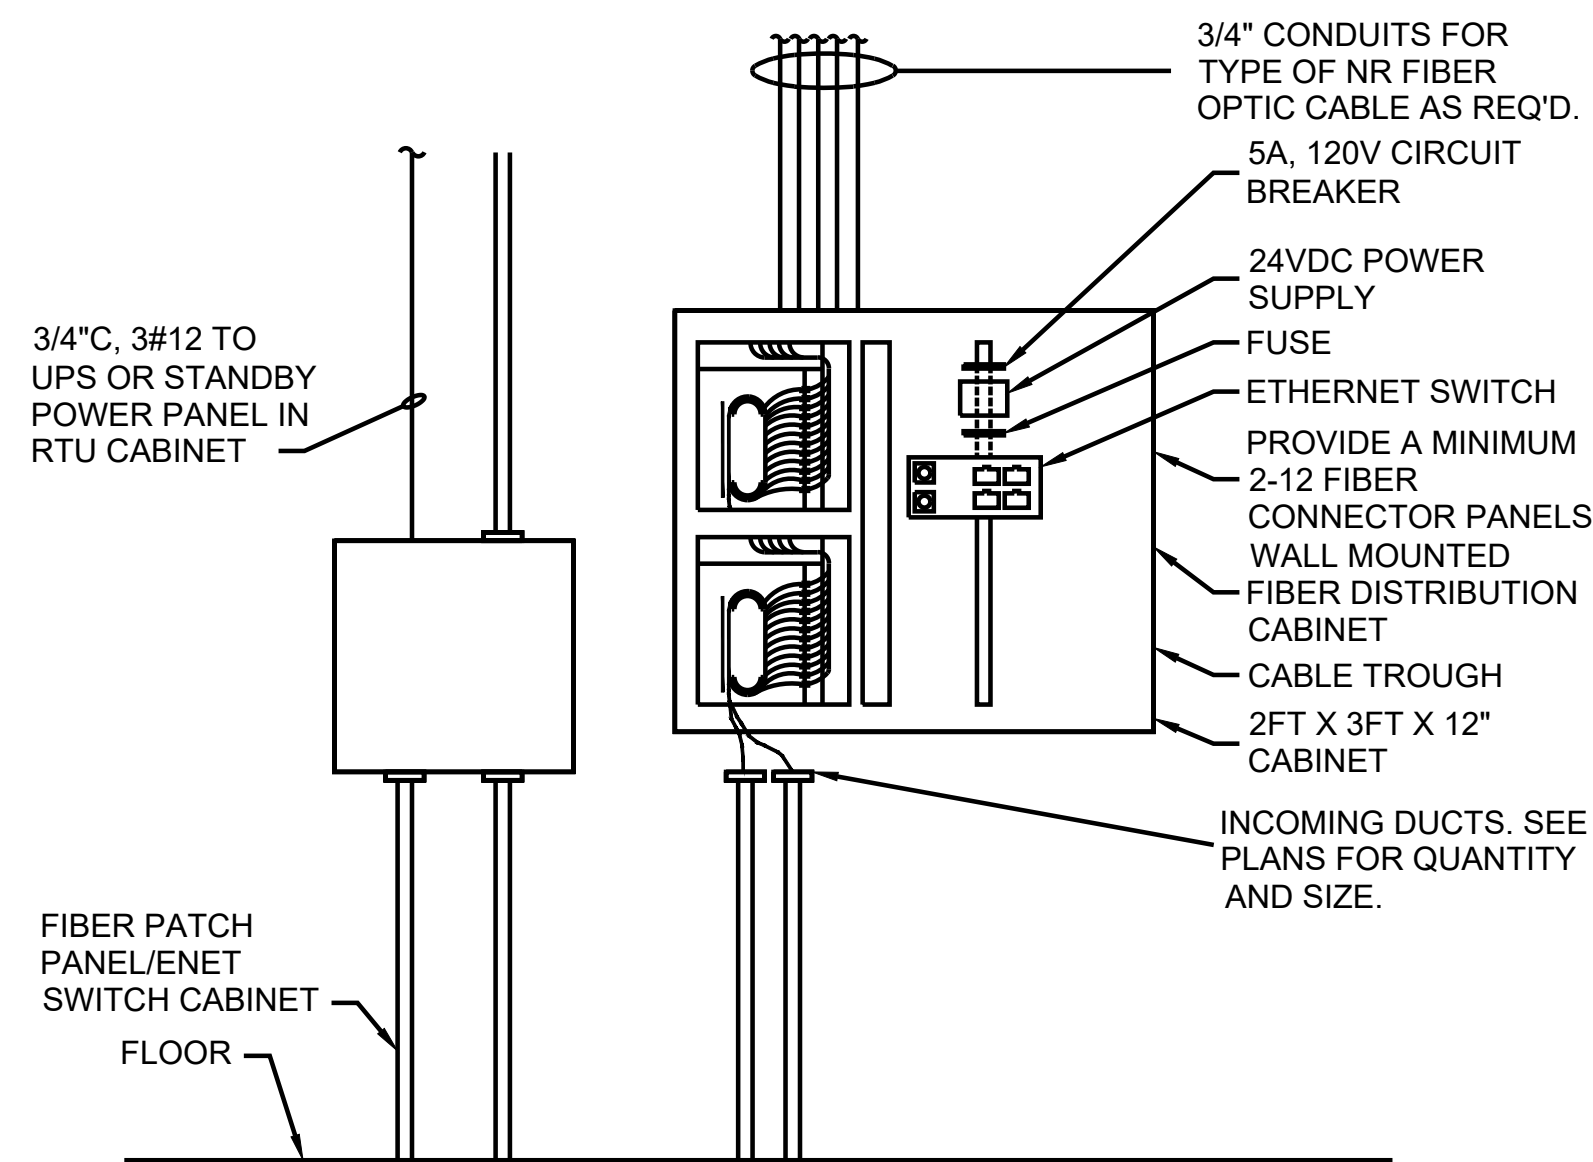


TYPICAL FIBER OPTIC DISTRIBUTION CABINET

NTS


NOTES:

1. PROVIDE FAN OUT KITS FOR ARMORED MULTI-FIBER UNDERGROUND CABLES.
 2. ONLY TOP AND BOTTOM CONDUIT ENTRY INTO PANEL ALLOWED.
 3. ALL CABLE AND WIRE ENTERING FOPP MUST BE TERMINATED WITHIN PANEL.
- NO PASS-THRU WIRE OR CABLE ALLOWED.

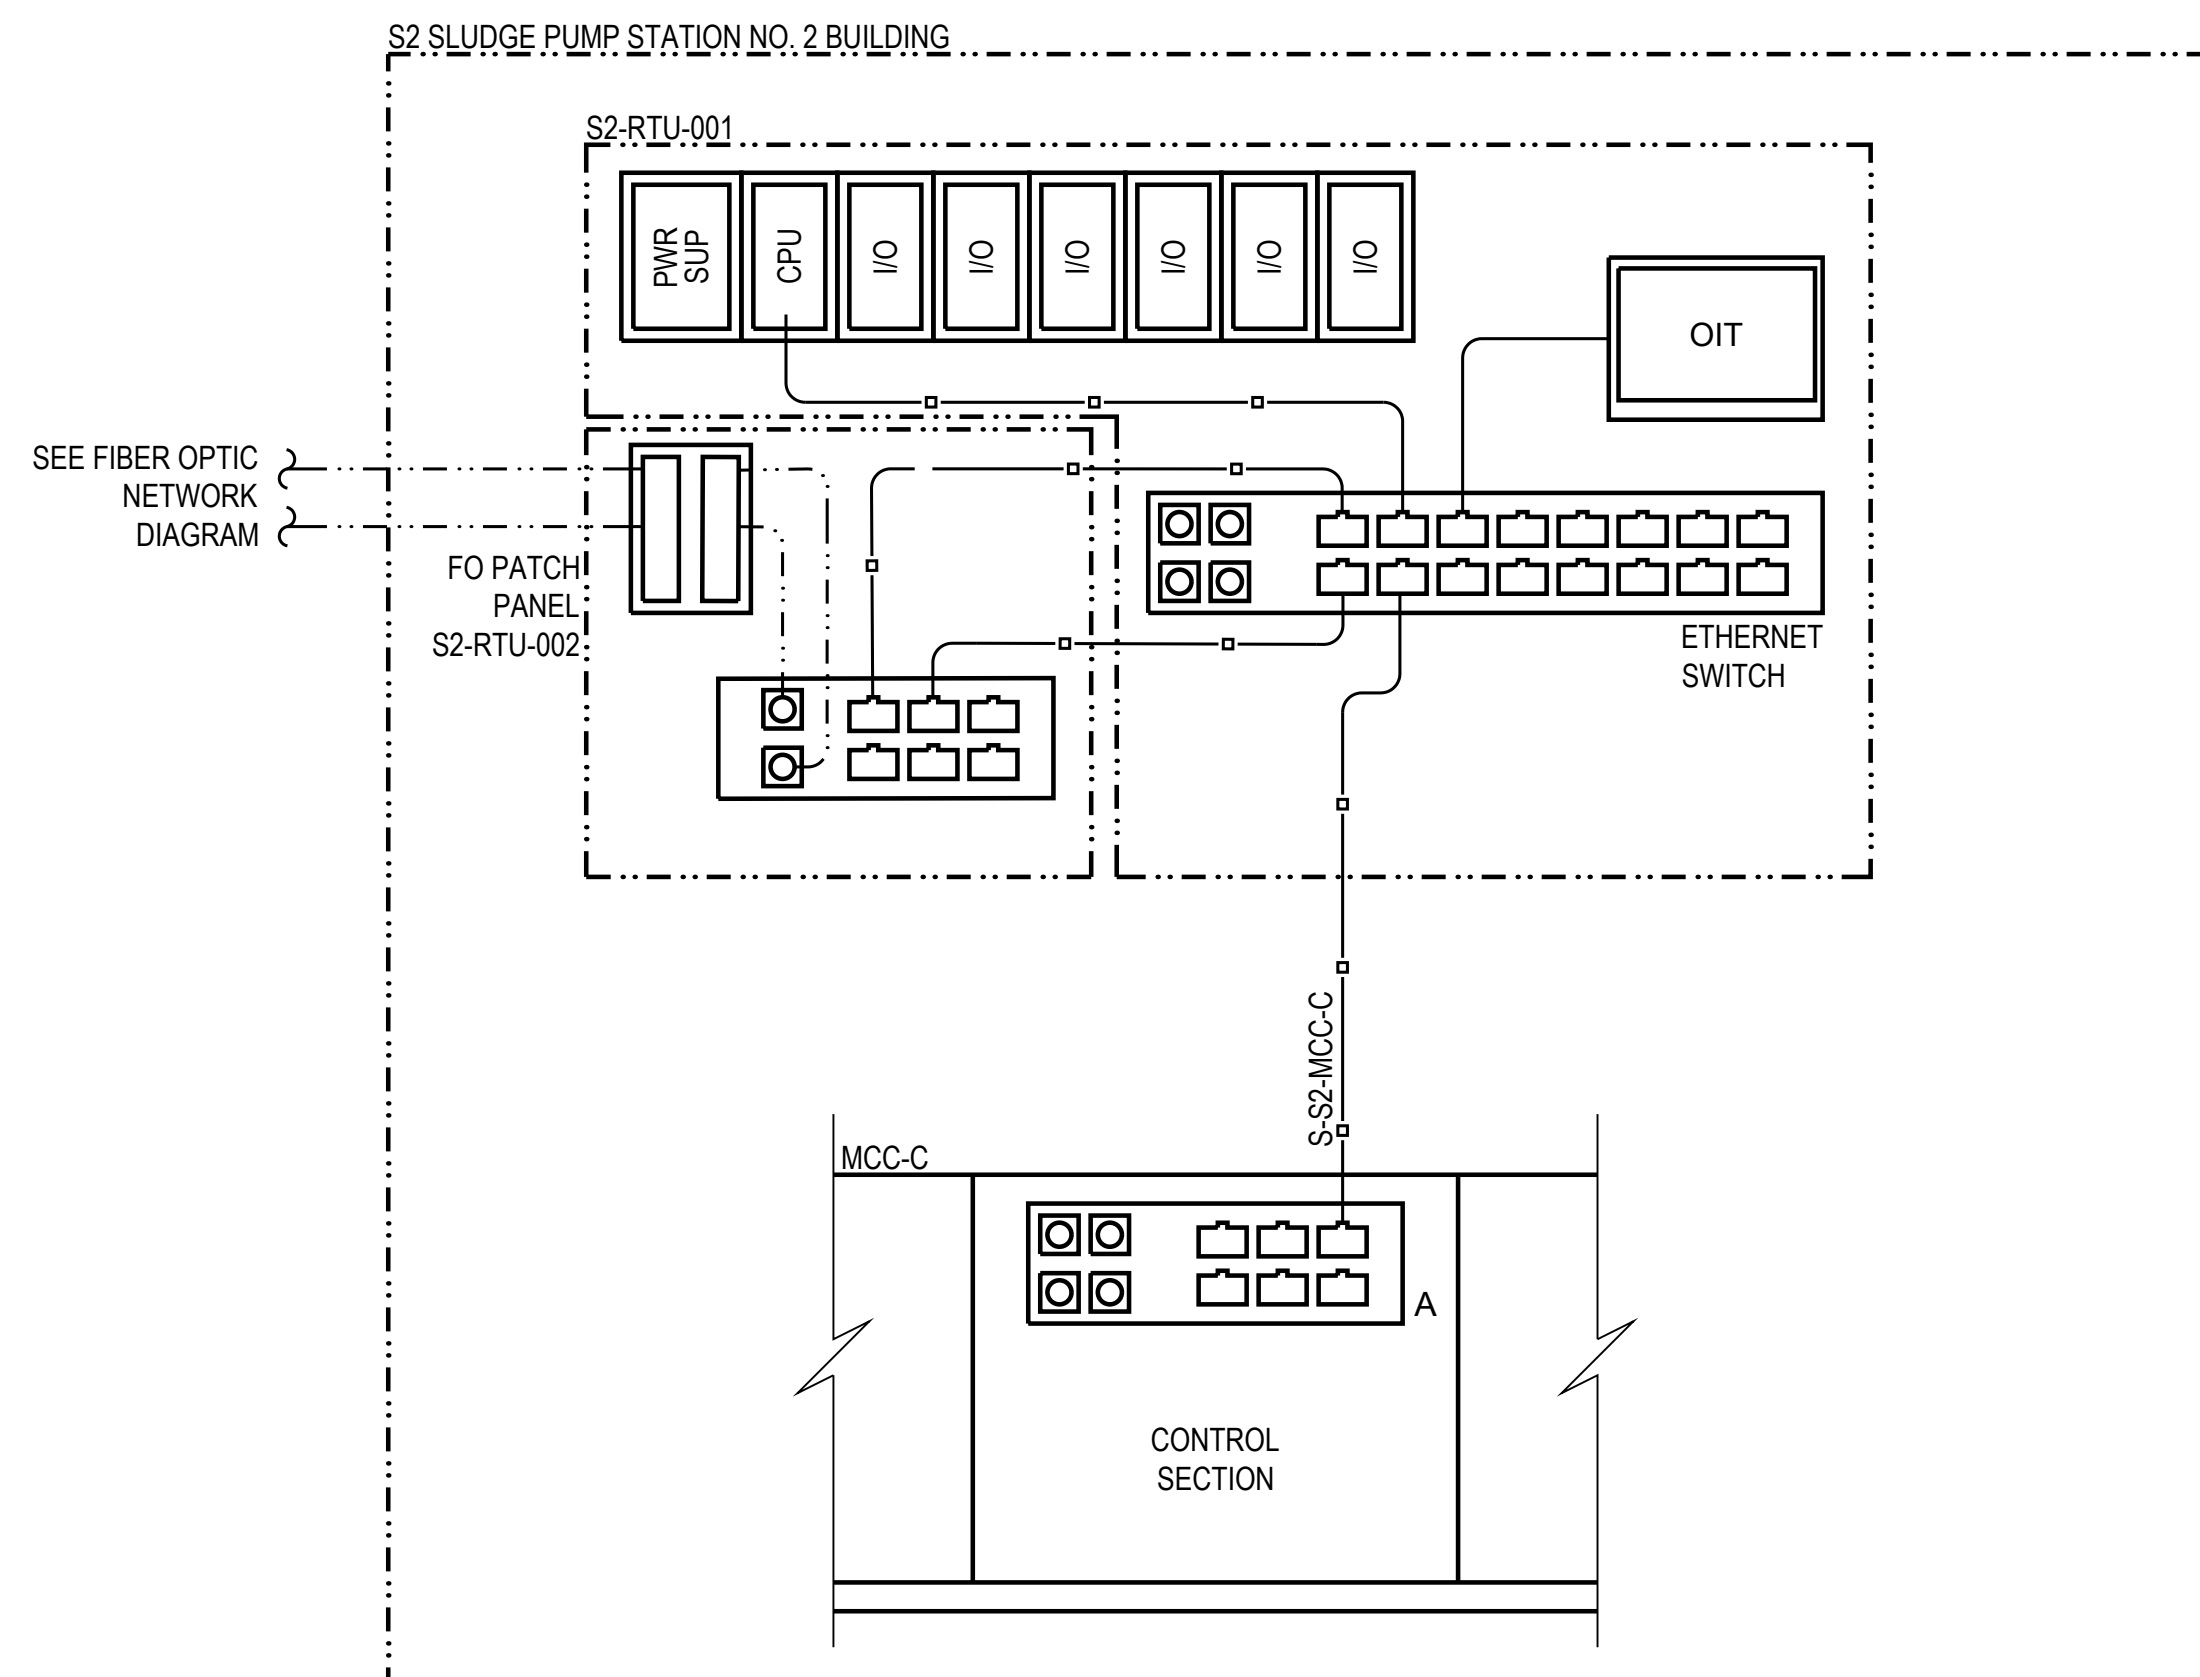

S2-RTU-001 NETWORK DIAGRAM

SCALE: NONE

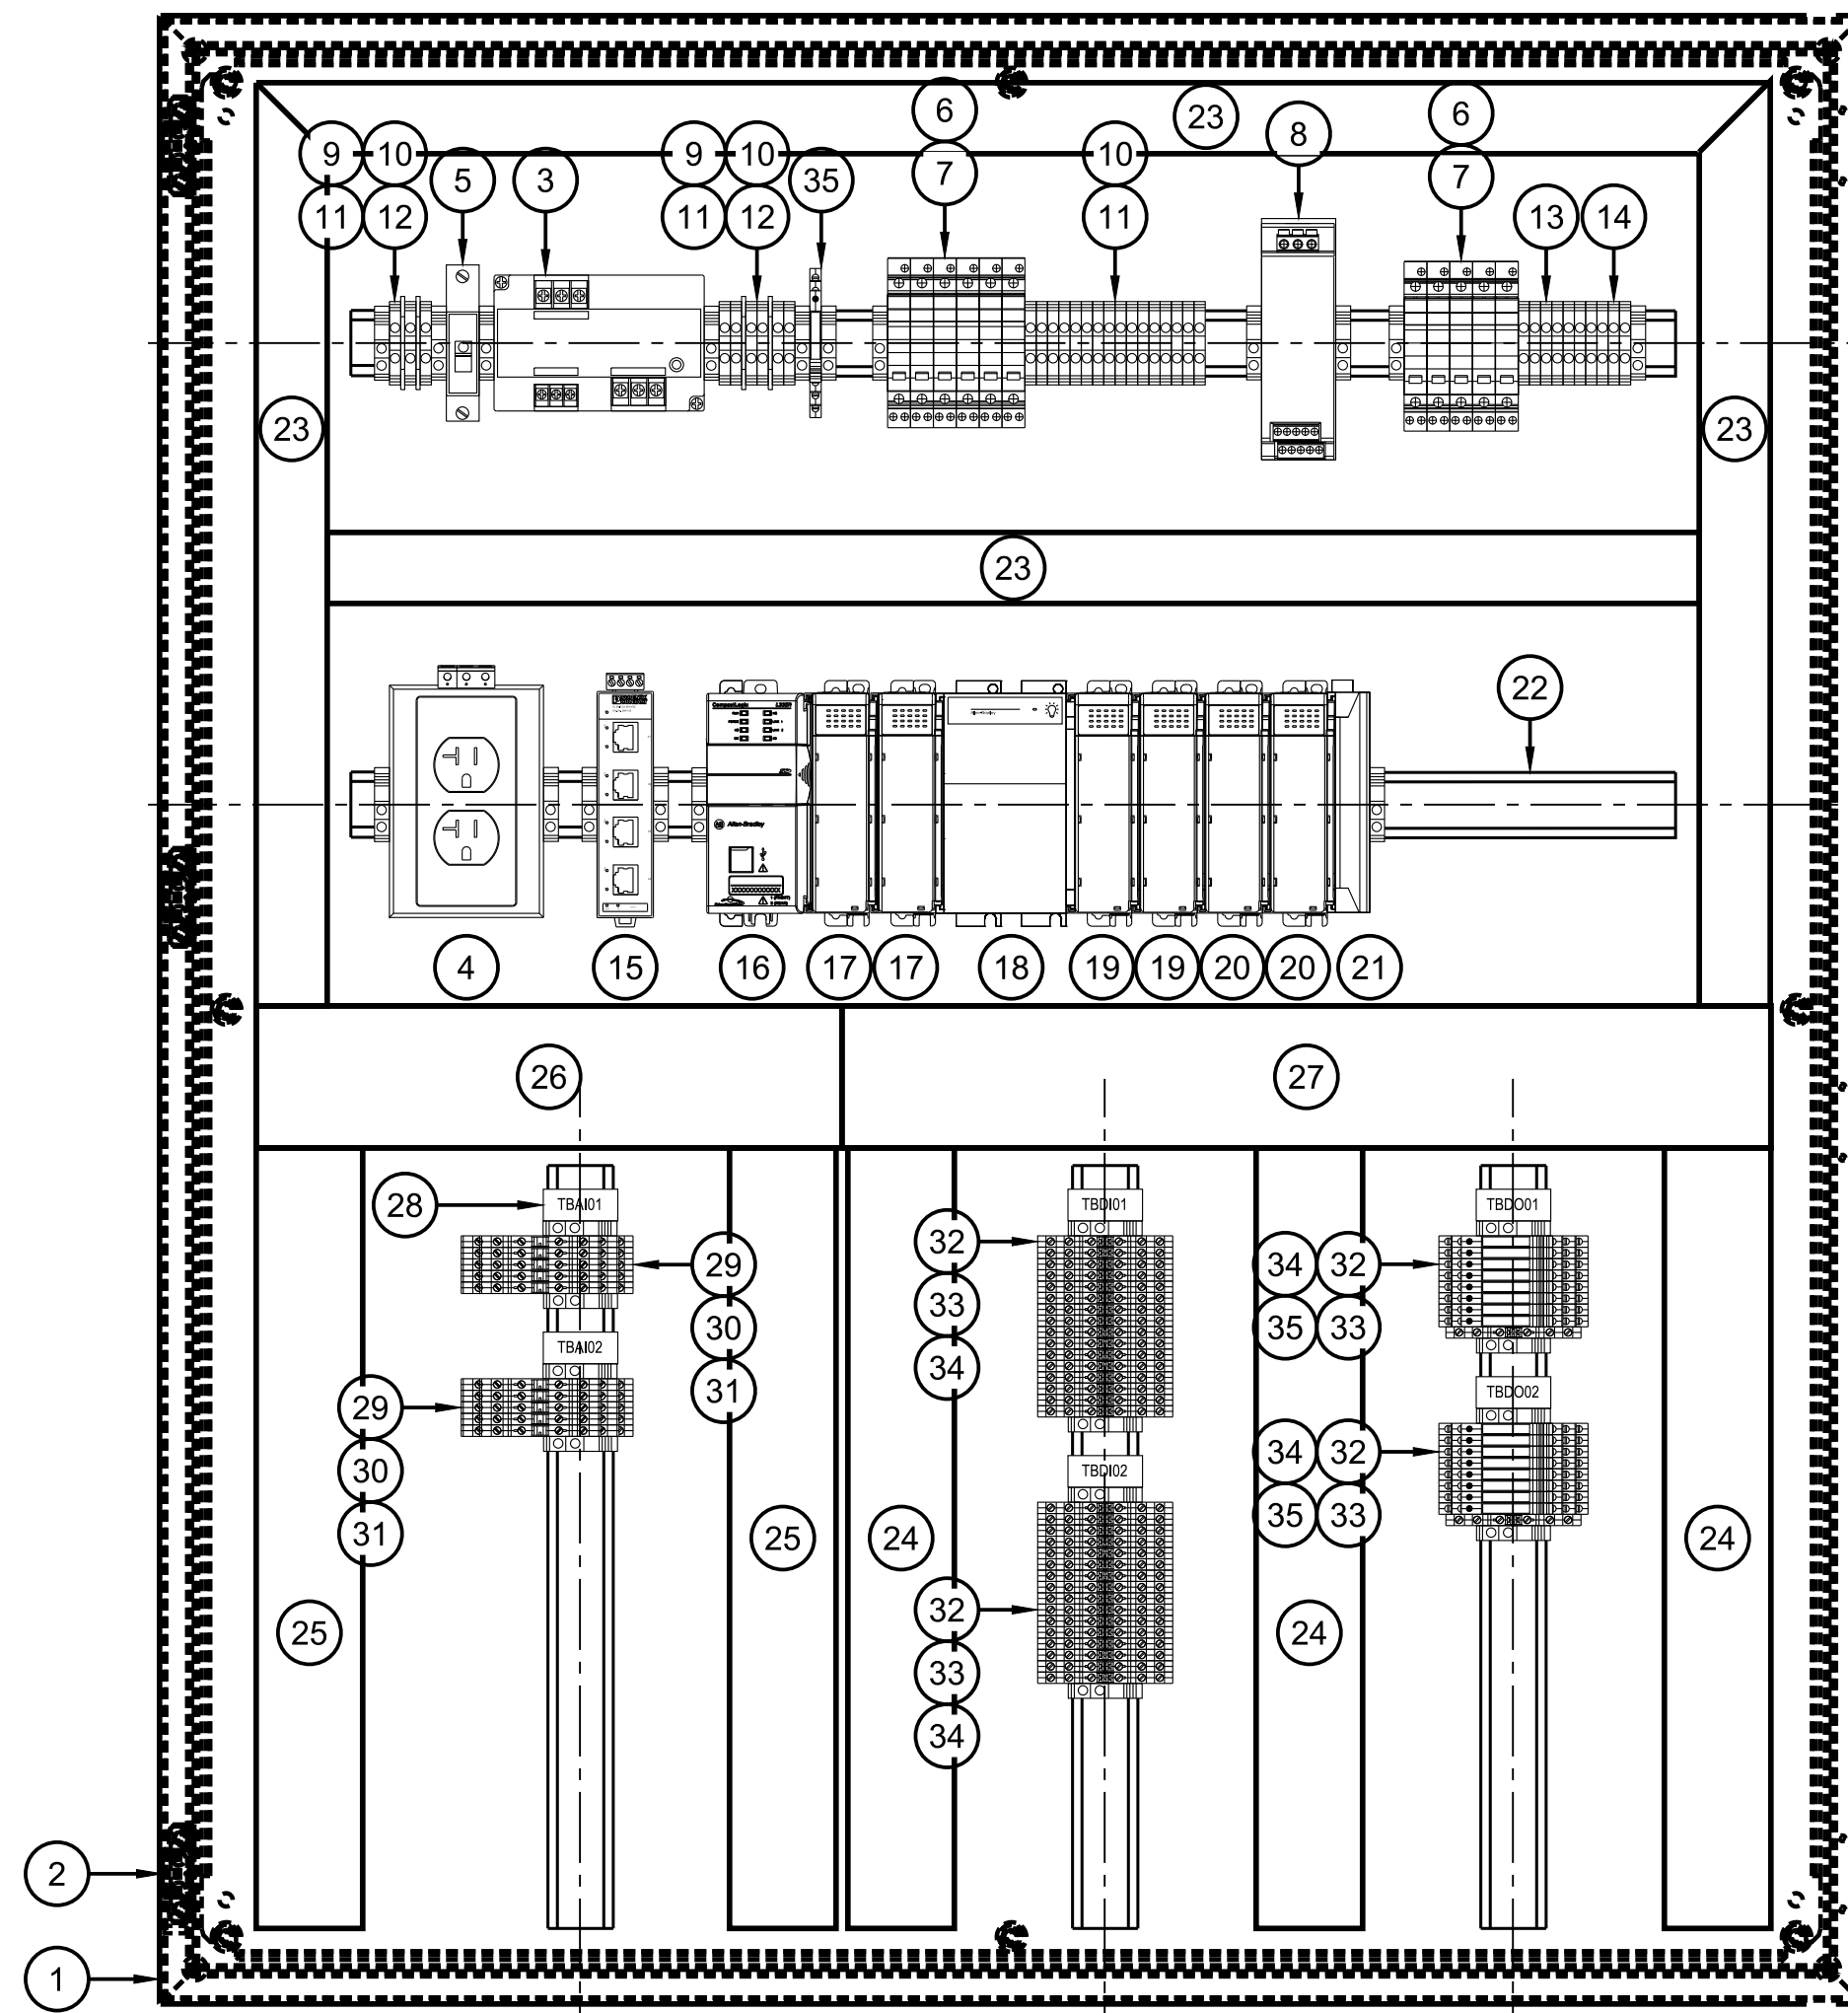

TYPICAL WALL-MOUNTED RTU CABINET

SCALE: NONE

BILL OF MATERIAL			
ITEM	QTY	PART NUMBER	DESCRIPTION
1	1	CSD423B12	HOFFMAN CONCEPT STEEL ENCLOSURE 42 X 36 X 12
2	1	CP4236	HOFFMAN 42 X 36 CONCEPT STEEL BACKPLANE
3	1	ADPH12015	EATON AEGIS POWERLINE FILTER, HYBRID, 120 VAC, 15A, WITH LED
4	1	5600525	PHOENIX CONTACT DIN MOUNT DUPLEX POWER OUTLET, 20 AMP
5	1	MG17406	SQUARE D 15 AMP THERMOMAGNETIC DIN MOUNT CIRCUIT BREAKER
6	11	2801305	PHOENIX CONTACT THERMOMAGNETIC BREAKER BASE ELEMENT
7	11	2800387	PHOENIX CONTACT THERMOMAGNETIC 2 AMP BREAKER
8	1	2866750	PHOENIX CONTACT QUINT POWER SUPPLY, 5 AMP 24 VDC
9	3	3044102	PHOENIX CONTACT 6.2mm, 41A, UT MODULAR TERMINAL BLOCK GREY
10	11	3045130	PHOENIX CONTACT 6.2mm, 41A, UT MODULAR TERMINAL BLOCK WHITE
11	11	3044128	PHOENIX CONTACT 6.2mm, UT GROUND TERMINAL BLOCK
12	4	3047167	PHOENIX CONTACT 2.2mm, PARTITION PLATE
13	10	3045143	PHOENIX CONTACT 6.2mm, 41A, UT MODULAR TERMINAL BLOCK BLACK
14	23	0800886	PHOENIX CONTACT END STOP
15	1	2891152	PHOENIX CONTACT FL ETHERNET SWITCH
16	1	5069-1320E	ALLEN BRADLEY COMPACTLOGIX PROCESSOR MODULE
17	2	1769-IF4	ALLEN BRADLEY COMPACTLOGIX 4 CHANNEL ANALOG INPUT MODULE
18	1	1769-PA4	ALLEN BRADLEY COMPACTLOGIX P4A POWER SUPPLY
19	2	1769-IA16	ALLEN BRADLEY COMPACTLOGIX 16 CHANNEL 120 VAC INPUT MODULE
20	2	1769-OW8I	ALLEN BRADLEY COMPACTLOGIX 8 CHANNEL RELAY OUTPUT MODULE
21	1	1769-ECR	ALLEN BRADLEY COMPACTLOGIX RIGHT END CAP
22	2	OMEGA3AF	IBOCO DIN RAIL DEEP STANDARD PUNCHED, 8FT
23	2	1TIE-1540G	IBOCO WIRE DUCT, 1.5" WIDE, 4" HIGH, 6FT, GREY
24	1	1TIE-2240G	IBOCO WIRE DUCT, 2.2" WIDE, 4" HIGH, 6FT, GREY
25	1	1TIE-2240W	IBOCO WIRE DUCT, 2.2" WIDE, 4" HIGH, 6FT, WHITE
26	1	1TIE-3040W	IBOCO WIRE DUCT, 3" WIDE, 4" HIGH, 6FT, WHITE
27	1	1TIE-3040G	IBOCO WIRE DUCT, 3" WIDE, 4" HIGH, 6FT, GREY
28	6	0800307	PHOENIX CONTACT TERMINAL STRIP MARKER
29	10	3011067	PHOENIX CONTACT SENSOR ACTUATOR TB WITH GROUND
30	10	0921037	PHOENIX CONTACT LED FUSING PLUG, 24 VDC
31	20	GGM112	FERRAZ SHAWMUT FAST-ACTING 112 AMP 5X20 FUSE
32	35	2774237	PHOENIX CONTACT SENSOR ACTUATOR TERMINAL BLOCK
33	35	0921053	PHOENIX CONTACT LED FUSE PLUG, 250 VAC
34	40	GSC2	FERRAZ SHAWMUT SLOW-BLOW 2 AMP 5X20 FUSE
35	17	2966197	PHOENIX CONTACT PLC RELAY 120 VAC, 6 AMP
36			
37			
38			
39			
40			

NOTES:

1. THIS ELEVATION AND BILL OF MATERIAL IS TYPICAL FOR WALL-MOUNTED RTU CABINETS. ACTUAL LAYOUT AND MATERIAL SHALL BE DESIGNED BY THE INTEGRATOR PER THE SPECIFICATIONS.

A	2/25/25	CHANGES AFTER 90% DESIGN	TCA	BGY	
NO.	DATE	REVISION	BY	APVD	

